


# SKETCH 1

WEI  
8-3-16

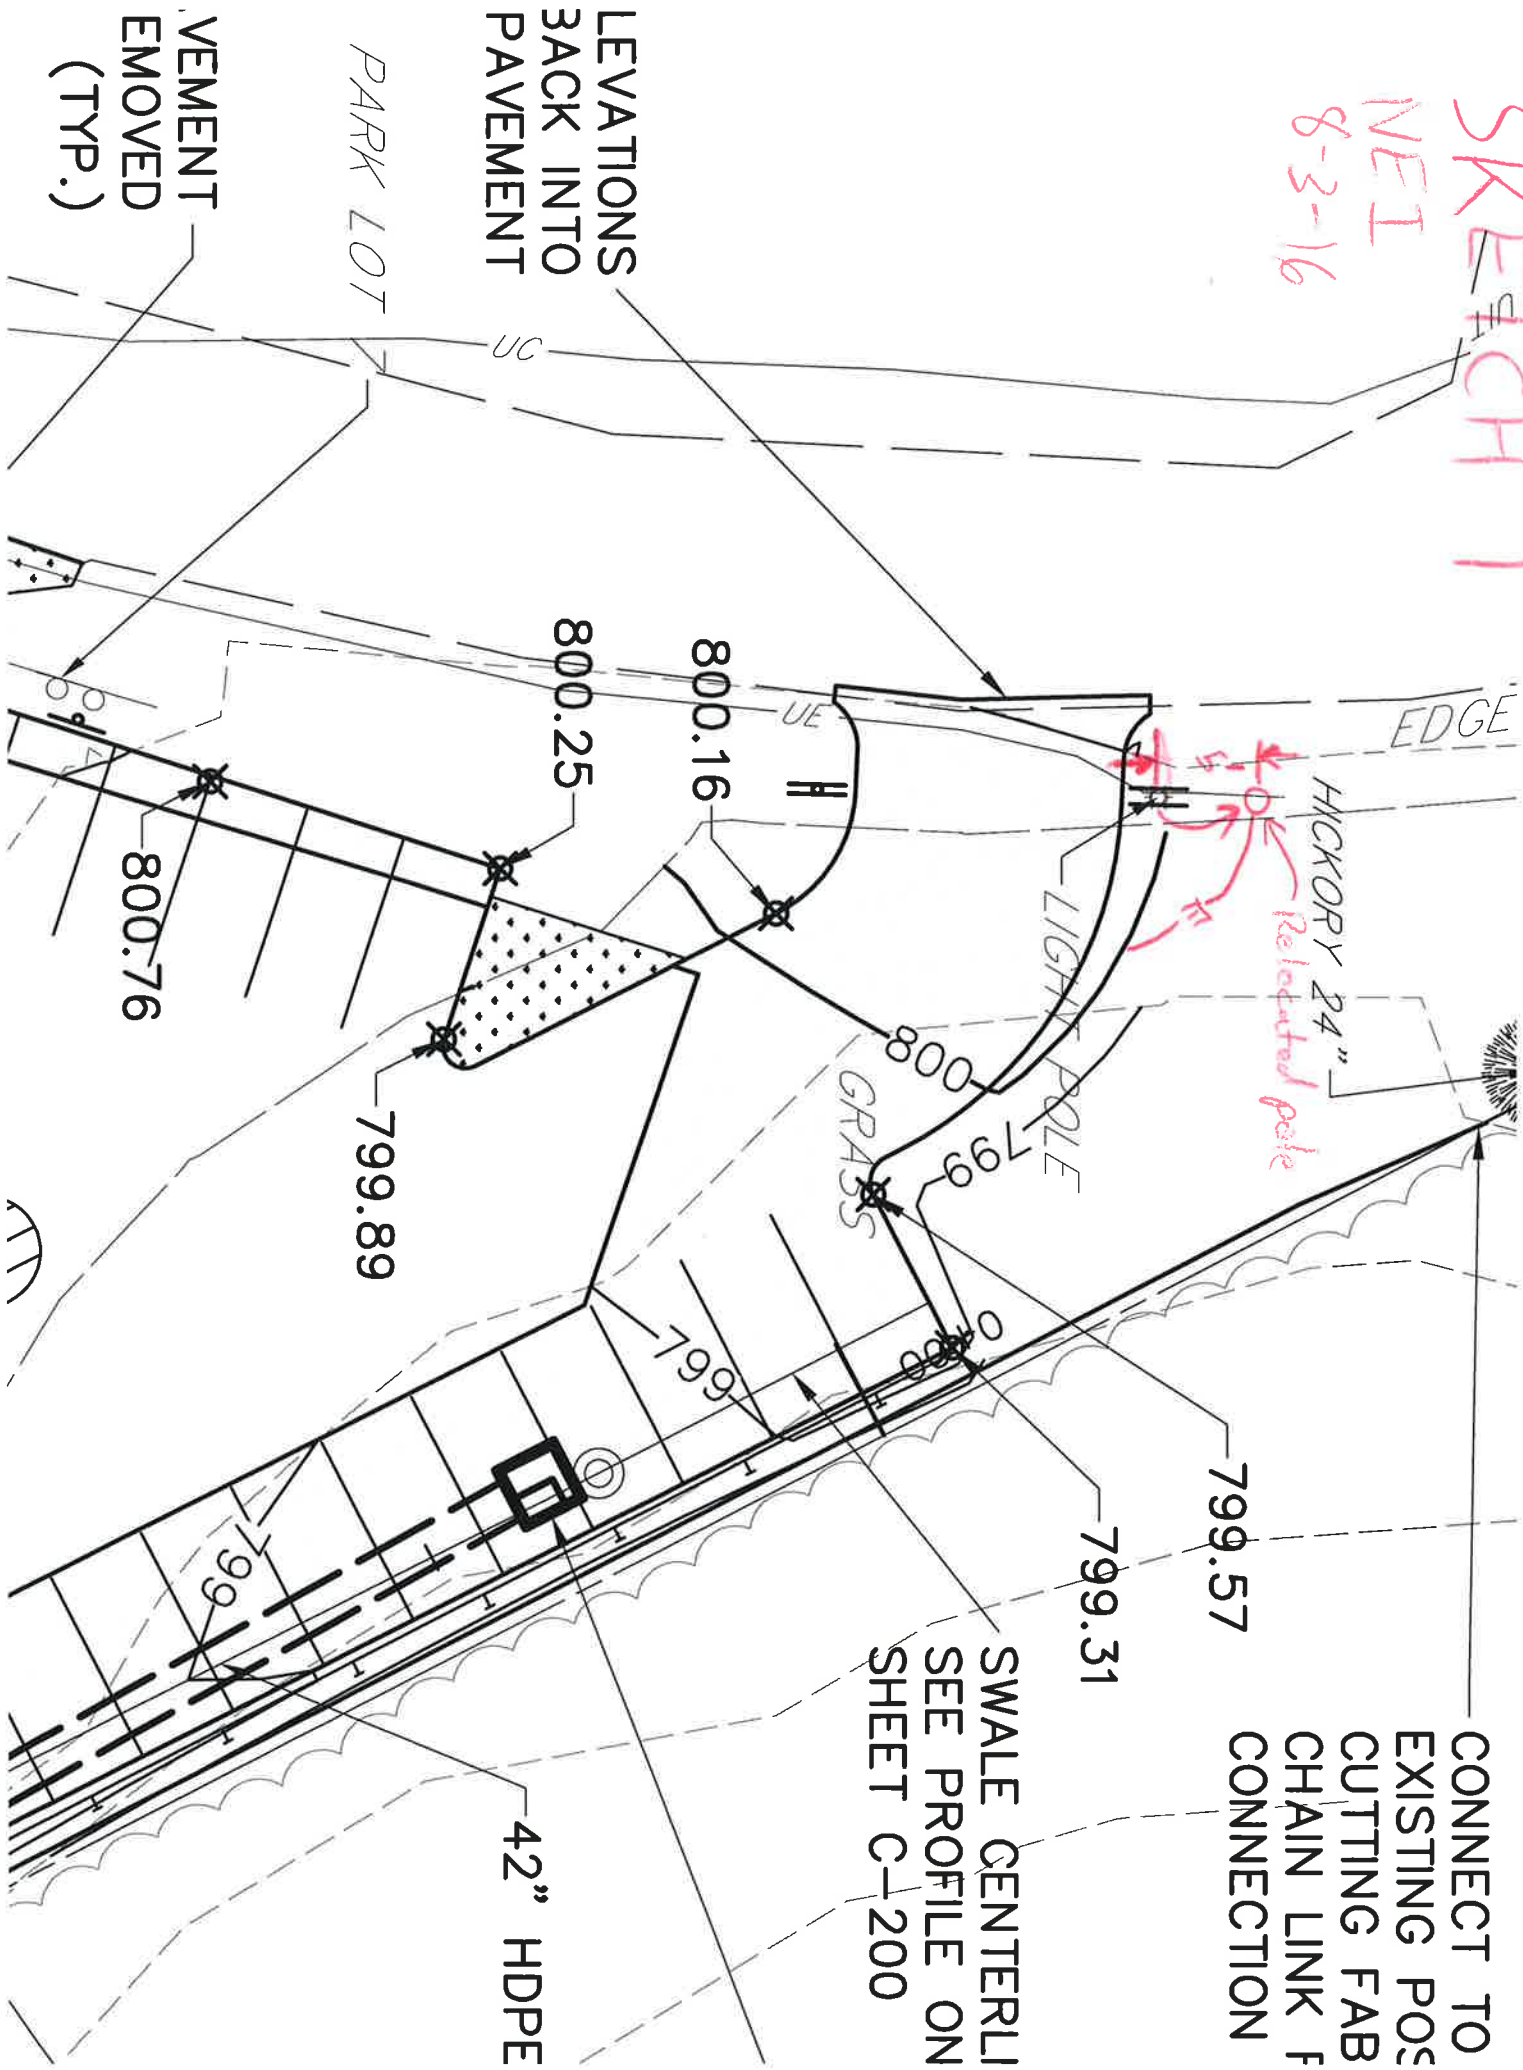

8315

~~NO.~~

