


All noted PD's & CR's on this page were either added, removed, clarified or relocated per RFI 04695

REFER TO THE FOLLOWING SKETCH FOR CHANGES:
SK-8-4-NJ 2A1003

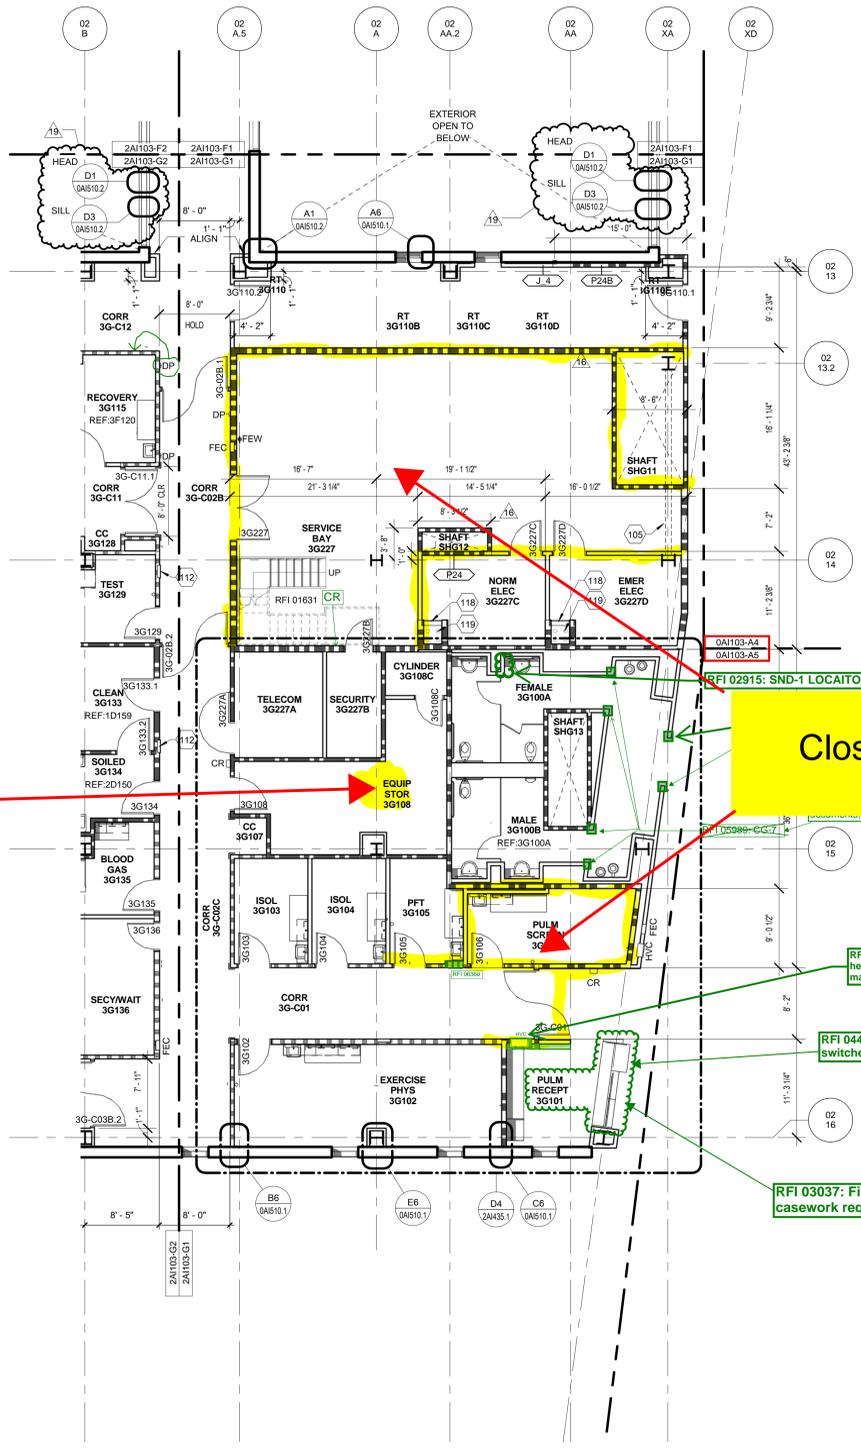


1 BLDG 2 THIRD FLOOR PLAN - AREA G1
SCALE: 1/8" = 1'-0"

INTERIOR BACK-UP WALL, OPENINGS, SOFFITS, ETC AROUND PERIMETER OF BUILDING REVISED TO COORDINATE W/ EWP OR SKIN COST REDUCTIONS. NEW AND/OR REVISED PLAN/SECTION/RCP DETAILS AS INDICATED ON PLANS AND REFLECTED CEILING PLANS.

FLOOR PLAN LEGEND	
NOT ALL SYMBOLS/NOTES APPEAR ON EVERY SHEET	
WHERE SYMBOL REFERENCES ANOTHER DRAWING SERIES, SYMBOL IS SHOWN FOR DESIGN/DIMENSIONAL COORDINATION ONLY. REFERENCE THE ENGINEERING DRAWINGS FOR FULL SCOPE OF DEVICE LOCATIONS & ASSOCIATED SPECIFICATIONS.	
GENERAL FLOOR PLAN ANNOTATION	
1D123	ROOM NUMBER
REF:XXXX	REFERENCE ROOM NUMBER
	REFERENCE ROOM NUMBER INDICATES ROOM TO REFERENCE FOR TYPICAL MEDICAL EQUIPMENT LAYOUT, INTERIOR ELEVATION TAGS, GENERAL ANNOTATION AND DIMENSIONS UNLESS OTHERWISE NOTED.
INTERIOR ELEVATION REFERENCE:	
A	INTERIOR ELEVATION CALLOUT
B	SHEET ON WHICH ELEVATION IS DRAWN
XA110X	MATCHLINE REFERENCE
XA110Y	MATCHLINE REFERENCE
CL	CENTERLINE TAG
EL: +10'-0"	SPOT ELEVATION
XXXX	PARTITION TYPE TAG - REF PARTITION SCHEDULE SHT 0A002
(1X)	RELITE TAG - REF FRAME SCHEDULE SHEET 0A000
XXXXX	DOOR TAG - REF DOOR SCHEDULES A1000 SERIES
FLOOR SYMBOLS	
FD	FLOOR DRAIN - REF PLUMBING DWGS
	WHERE DRAIN IS NOT SET IN DEPRESSIONED SLAB/SLOPED FLOOR SYSTEM, SET DRAIN 1/2" BELOW FINISH FLOOR LEVEL, AND TAPER CONC. AND FLOORING TO FLUSH W/ DRAIN STRAINER IN A 2' RADIUS FROM CENTER OF DRAIN
FCO	FLOOR CLEAN OUT - REF PLUMBING DWGS
	NOTE: CMP TO COORD REVISIONS TO SERVICE BAY FDS & FCO'S (QTY & LOCATIONS) W/ APPROVED AHJ RE-DESIGN SHOP DWGS
FO	FLOOR OUTLET - REF ELECTRICAL DWGS
WALL DEVICE/CABINET SYMBOLS	
CR	CARD READER - REF LOW VOLTAGE DWGS
DP	DOOR PUSH PLATE - REF LOW VOLTAGE DWGS
PB	PANIC ALARM BUTTON - REF LOW VOLTAGE DWGS
IA	INFORMATION ASSIST CALL BOX - REF LOW VOLTAGE DWGS
FAPFS	FIRE ALARM PULL STATION - REF FIRE ALARM DWGS
FEC	RECESSED CABINET SIZED TO HOLD 10# ABC EXTINGUISHER
FEC-20	RECESSED CABINET SIZED TO HOLD 20# CO2 EXTINGUISHER
FEW	WALL MOUNTED EXTINGUISHER LOCATION
HVC	FIRE DEPARTMENT HOSE VALVE CABINET - REF FIRE PROT. DWGS
MISCELLANEOUS	
EXX-X	07.95.13 - INTERIOR EXPANSION JOINT COVER ASSEMBLY - "XX" LETTER DESIGNATION INDICATES COVER TYPE PER SHEET 0A157. REFERENCE FIRE/SMOKE RATED CONDITIONS AS INDICATED BY ASSOCIATED PTN TYPES ON THE FLOOR PLANS.
LKR-XX	LOCKERS: "XX" DESIGNATION INDICATES TYPE: 2A - 10 51 13 - DBL TIER METAL LOCKERS, SLOPED TOP 12"W X 15"D X 60"H LOCKERS PAINTED TO MATCH ADJ WALL REF DTL E20A0532 2A-1 - 10 51 13 - DBL TIER METAL LOCKERS, SLOPED TOP 12"W X 15"D X 60"H LOCKERS PAINTED TO MATCH ADJ WALL REF DTL E20A0532 2B - 10 51 23 - DBL TIER "Z" PLAM LOCKERS, W/ PLAM SOFFIT 12"W X 15"D X 80"H FINISH: PLAM-10 REF DTL E20A0532 TOPS OF LOCKERS TO ALIGN AT 7'-0" AFF.
	FOR REFERENCE ONLY - GENERAL LOCATION OF OPEN OFFICE FURNITURE - SEE FURNITURE DWGS FOR EXACT TYPES AND LOCATIONS.
SHIELDING	
(LEAD)	LEAD SHIELDING
(RF)	RADIOFREQUENCY SHIELDING
(EMI)	ELECTROMAGNETIC INTERFERENCE SHIELDING
(MAG)	MAGNETIC SHIELDING
MEDICAL EQUIPMENT/OFFICE EQUIPMENT	
XX1234	DASHED OBJECTS WITH EQUIPMENT TAG INDICATE MEDICAL/OFFICE EQUIPMENT. REFERENCE EQUIPMENT ACTIVATION REPORT - SEE SPECIFICATIONS SECTION 01 11 10 FOR LOCATION OF REPORT.
X1234	DASHED OBJECTS WITH EQUIPMENT TAG INDICATE MEDICAL/OFFICE EQUIPMENT. REFERENCE EQUIPMENT ACTIVATION REPORT - SEE SPECIFICATIONS SECTION 01 11 10 FOR LOCATION OF REPORT.
TOILET GRAB BAR CONFIGURATIONS	
(Symbol)	TOILET WITH WALL MOUNTED GRAB BARS 10 28 00 SEE SHEET 0A0201 FOR GRAB BAR MOUNTING HEIGHTS AND DIMENSIONAL LAYOUT
(Symbol)	TOILET WITH WALL MOUNTED UP-SWING GRAB BARS 10 28 00 SEE SHEET 0A0201 FOR GRAB BAR MOUNTING HEIGHTS AND DIMENSIONAL LAYOUT

GENERAL FLOOR PLAN NOTES	
1.	REFER TO SHEET 0A002 FOR PARTITION SCHEDULE AND GENERAL PARTITION TYPE NOTES.
2.	REFER TO A1000 SERIES FOR ENLARGED FLOOR PLAN VIEWS INCLUDING MEDICAL EQUIPMENT NOT SHOWN IN A1100 SERIES PLANS.
3.	REFER TO LIFESAFETY DRAWINGS (LS SERIES) FOR CAMPUS-WIDE SCOPE OF RATED WALL CONSTRUCTION, SMOKE PARTITIONS, SUITE DESIGNATIONS AND EXIT DISCHARGE INFORMATION.
4.	PARTITION TYPES AS NOTED BY THE SYMBOL CONTINUE BETWEEN ROOM/SPACE CORNERS OR ANY INTERSECTING PARTITION.
5.	DIFFERING PARTITION TYPES SHALL ALIGN SO THAT WALL PLANES CONTINUE UNBROKEN WITHIN CROSS ROOMS AND/OR SPACES, UNLESS OTHERWISE NOTED. DIMENSIONS ARE TO FINISH FACE.
6.	REFER TO A1000 SERIES DRAWINGS FOR DOOR & RELITE SCHEDULES.
7.	DISTANCE FROM HINGE SIDE OF DOOR TO INTERSECTING STUD WALL SHALL BE 4" UNLESS NOTED OR DETAILED OTHERWISE (MEASURED FROM OUTSIDE OF FRAME).
8.	CONTRACTOR SHALL VERIFY ALL DIMENSIONS NOTED AS "CLEAR" OR "MIN" DIMENSIONS NOTED AS "HOLD" ARE CRITICAL TO COORDINATE OTHER WORK (E.G. CEILING GRIDS, LIGHTING, FINISHES).
9.	CONTRACTOR SHALL VERIFY ALL DIMENSIONS PRIOR TO INITIATING CONSTRUCTION AND REPORT DISCREPANCIES TO ARCHITECT PRIOR TO COMMENCING WORK.
10.	CONTRACTOR SHALL PROVIDE ALL BLOCKING REQUIRED TO ANCHOR ALL WALL AND CEILING MOUNTED ITEMS, INCLUDING BUT NOT LIMITED TO TOILET ROOM ACCESSORIES, MILLWORK, CASEWORK, HANDRAILS, DOOR STOPS ETC. ...
11.	FIRE STOPPING SYSTEMS - REFER TO SPEC SECTION 07 94 00 FOR INFO REGARDING PENETRATIONS OF ALL RATED ASSEMBLIES (BOTH SINGLE AND DOUBLE MEMBRANE PENETRATIONS) INCLUDING BUT NOT LIMITED TO PENETRATIONS FOR DUCTWORK, CONDUIT, PIPING AND SUPPORT FOR WALL MOUNTED EQUIPMENT, CABINETS AND COUNTERTOPS.
12.	UP-SWING GRAB BARS IN WALL SUPPORT - SEE DTL S AND A3 SHEET 0A1006 FOR TUBE STEEL BACKING AT ALL UP-SWING GRAB BARS. SEE DETAIL A30A1516 FOR COLUMN BASE WATERPROOFING AT EXPOSED COLUMNS IN SERVICE BAYS & MECHANICAL ROOMS.
13.	SHIELDING REQUIREMENTS - VERIFY ALL SHIELDING REQUIREMENTS WITH FINAL EQUIPMENT SELECTIONS AND A VA APPROVED REGISTERED PHYSICIST PRIOR TO COMMENCING WORK IN SHIELDED-ROOM AREAS.
14.	HOUSEKEEPING AND COPY ROOMS - ALL PARTITIONS TO BE FULL HEIGHT TO UNDERSIDE OF DECK/INTERSTITIAL ABOVE. SEE PARTITION TYPE NOTES SHEET 0A002.
15.	AT PARTIAL HEIGHT CMU PARTITIONS WITH GYPSUM WALLBOARD ABOVE TO STRUCTURE ALIGN FACE OF GWB AND CMU AT SIDE OF MAJOR CORRIDORS. ALL OTHER LOCATIONS CENTER GWB ON CMU WALL UNLESS NOTED OTHERWISE.

FLOOR PLAN SHEET NOTES	
FLOOR PLAN SHEET NOTE SERIES BEGINS WITH NOTE 100	
NOT ALL SHEET NOTES APPEAR ON EVERY SHEET	
100.	SLAB OPENING - REF STRUCTURAL DWGS
101.	ALIGN PARTITIONS
102.	LINE OF CURTAIN WALL SILL - REF EXTERIOR SERIES DWGS.
103.	LINE OF HOISTWAY BELOW
104.	AIR HANDLER UNIT - REF MECHANICAL DWGS
105.	STEEL BRACING - REF STRUCTURAL DWGS
106.	CONCRETE HOUSEKEEPING PAD - REF STRUCTURAL DWGS
107.	ACCORDIAN FIRE DOOR - REF DOOR SCHEDULE
108.	NOT USED
109.	08 31 13 FLOOR VAULT DOOR - 36" X 36" - REF DTL E10A1516
110.	ROOF/OVERFLOW DRAIN LEADER - REF PLUMBING DWGS
111.	ELECTRICAL PANEL - REF ELECTRICAL DWGS
112.	MEDICAL GAS ZONE VALVE BOX/MEDICAL GAS ALARM PANEL - REF MED GAS DWGS
113.	SLOPE FLOORING IN SHOWER/TOILET ROOM TO FLOOR DRAIN
114.	SLAB RECESS FOR HIGH DENSITY SHELVING TRACK. VFY RECESS DIMENSION W/ SHELVING MANUFACTURER.
115.	14 91 34 TRASHLINE CHUTE & STATION: SEE DETAILS E60A0507
116.	14 91 34 TRASHLINE CHUTE: NO LOADING STATION
117.	14 91 34 TRASHLINE CHUTE: PROVIDE SLEEVES @ LEVEL 01 FLOOR
118.	SLAB PENETRATION - SEE DETAILS E60A0507
119.	08 31 13 3-HOUR FIRE RATED ACCESS PANEL - 24" X 48"
120.	ELECTRICAL RISERS - SEE PLAN DETS ON F50A1512 - REF ELEC DWGS
121.	CONCRETE ENCASED ELECTRICAL FEEDERS ABOVE - REF STRUCTURAL & ELEC DWGS
122.	36" O.D. UON.
123.	BOLD DASHED LINE INDICATES ROUTE OF STRUCTURAL EXPANSION JOINT - REF STRUCTURAL DWGS. REFERENCE FLOOR PLAN LEGEND FOR INTERIOR EXPANSION JOINT COVER ASSEMBLY INFORMATION.
124.	10 11 00 MARKER BOARD REF INTERIOR ELEV SHEET NOTE 207.
125.	10 28 00 FOLD-DOWN BENCH
126.	10 28 00 FOLD-DOWN SHOWER SEAT
127.	SLAB RECESS FOR WALK-OFF GRILLE. VFY RECESS DIMENSION W/ GRILLE MANUFACTURER. SEE FLOOR FINISH PLANS FOR EXTENTS.
128.	PLUMBING ROUGH-IN FOR FUTURE SINK - REF PLUMBING DWGS.
129.	BENT PLATE W/ TRAFFIC COATING WRAP @ WALL BASE - REF E30A0516
130.	LINE OF 2-HR RATED SHAFT ABOVE. REF DETAILS E1 & E3 SH1 0A1507
131.	05 05 00 ACCESS LADDER
132.	10 33 13 WIRE MESH PARTITION
133.	05 23 13 PIPE AND TUBE RAILING
134.	11 13 00 MANUAL DOCK LEVELER AND BUMPERS
135.	13 44 00 MODULAR MEZZANINES INCL. STAIRS & WIRE MESH PTNS.
136.	05 50 00 METAL GRATE CATWALK
137.	WALL MOUNTED HAND SINK - REF PLUMBING DWGS
138.	RECESSED EMERGENCY SHOWER AND EXPOSED STAINLESS STEEL SHOWER HEAD - REF PLUMBING DWGS
139.	08 38 19 FLOOD BARRIERS; FLOOD PLANK SYSTEM - REF D50A1511
140.	CONC. WALLS @ L 01 ELEV SHAFTS - REF STRUCT DWGS & DTL E20A0507
141.	BENT PLATE W/ PEDESTRIAN TRAFFIC COATING WRAP - REF C30A1516
142.	PLENUM SYSTEM - SEE EXTERIOR DRAWINGS
143.	CENTER PARTITION ON GRIDLINE
144.	CENTER PARTITION ON MULLION
145.	10 21 13 TOILET PARTITIONS
146.	TOP OF SHAFT LID ASSEMBLY - REF DETAIL B40A1507
147.	CONC CURB W/ PEDESTRIAN TRAFFIC COATING WRAP - REF D30A1516
148.	LIGHTING INVERTER CABINET - REF ELEC DWGS
149.	ELEVATOR SUMP PUMP CONTROL PANEL - REF PLUMB DWGS
150.	ALIGN GYPSUM WALL ABOVE WITH THIS FACE OF CMU

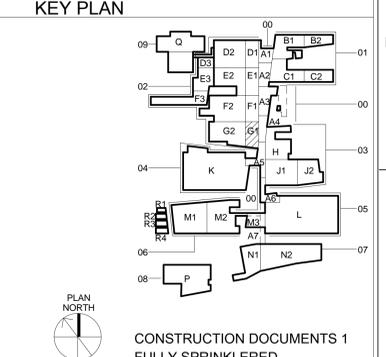

REVISIONS:	DATE
19 BULL 015C - VE	10/15/2013
16 BULL 015B - VE	08/30/2013
15 BULL 015B - PRE-AWARD	08/30/2013

CONSULTANTS:
 DESMAN ASSOCIATES / PARKING
 CODE CONSULTANTS, INC. / CODE CONSULTANT
 THE SEXTANT GROUP / AV & ACOUSTICAL
 HAMMER DESIGN ASSOCIATES / FOOD SERVICE
 PYBURN & ODOM / ABATEMENT
 TATA & HOWARD / TANK CONSULTANT
 I.S.C. GROUP, INC. / IRRIGATION
 DAN EUSER WATER ARCHITECTURE, INC. / WATER FEATURE

ARCHITECT/ENGINEERS:
 studio **NOVA**
 SCHRENK & PETERSON CONSULTING ENGINEERS / CIVIL
 KORDA/NEMETH ENGINEERING / STRUCTURAL
 BR+A CONSULTING ENGINEERS / MECH, ELECT, PLUMBING, LOW VOLTAGE
 ARCHITECTURAL ENGINEERING / PLUMBING
 SCALES ASSOCIATES / FIRE PROTECTION

DRAWING TITLE
 BLDG 2 THIRD FLOOR PLAN - AREA G1

APPROVED: PROJECT DIRECTOR

PROJECT TITLE
 SLV/HCS REPLACEMENT MEDICAL CENTER PROJECT

LOCATION
 NEW ORLEANS, LOUISIANA

DATE
 February 29, 2012

CHECKED
 ML

DRAWN
 AG/DMK

PROJECT NUMBER
 629-HS2-401

BUILDING NUMBER
 02

DOCUMENT SET PACKAGE
 WP_08

DRAWING NUMBER
 2A103-G1

CONSTRUCTION DOCUMENTS 1
 FULLY SPRINKLERED

OFFICE OF
 CONSTRUCTION
 AND FACILITIES
 MANAGEMENT

Department of
 Veterans Affairs