


All noted PD's & CR's on this page were either added, removed, clarified or relocated per RFI 04695

REFER TO SKETCH: SK-8-1-NJ-2-AI-103-G2-1

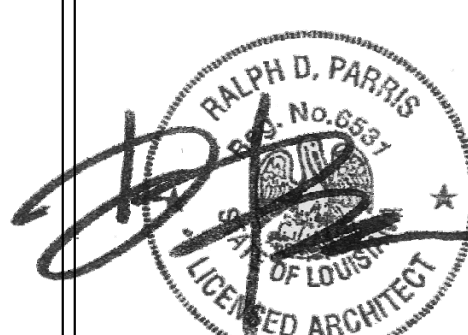

ARCHITECT/ENGINEERS:

studio **NOVA**

SCHRENK & PETERSON CONSULTING ENGINEERS / CIVIL
KORDA/NEMETH ENGINEERING / STRUCTURAL
BR+A CONSULTING ENGINEERS / MECH. ELECT. PLUMBING, LOW VOLTAGE
ARCHITECTURAL ENGINEERING / PLUMBING
SCALES ASSOCIATES / FIRE PROTECTION

DRAWING TITLE
BLDG 2 THIRD FLOOR PLAN - AREA G2

APPROVED: PROJECT DIRECTOR

PROJECT TITLE
SLVHCS REPLACEMENT MEDICAL
CENTER PROJECT

LOCATION
NEW ORLEANS, LOUISIANA

DATE
February 29, 2012

CHECKED
ML

DRAWN
AG/DMK

PROJECT NUMBER
629-HS2-401

02

DOCUMENT SET PACKAGE
WP_08

DRAWING NUMBER

2A103-G2

OFFICE OF
CONSTRUCTION
AND FACILITIES
MANAGEMENT




GENERAL FLOOR PLAN NOTES

- REFER TO SHEET 0A102 FOR PARTITION SCHEDULE AND GENERAL PARTITION TYPE NOTES.
- REFER TO A100 SERIES FOR ENLARGED FLOOR PLAN VIEWS INCLUDING MEDICAL EQUIPMENT NOT SHOWN IN A100 SERIES PLANS.
- REFER TO LIFESAFETY DRAWINGS (LS SERIES) FOR CAMPUS-WIDE SCOPE OF RATED WALL CONSTRUCTION, SMOKE PARTITIONS, SUITE DESIGNATIONS AND EXIT DISCHARGE INFORMATION.
- PARTITION TYPES AS NOTED BY THE SYMBOL CONTINUE BETWEEN ROOM/SPACE CORNERS OR ANY INTERSECTING PARTITION.
- DIFFERING PARTITION TYPES SHALL ALIGN SO THAT WALL PLANES CONTINUE UNBROKEN WITHIN ROOMS AND/OR SPACES.
- UNLESS OTHERWISE NOTED, DIMENSIONS ARE TO FINISH FACE.
- REFER TO A100 SERIES DRAWINGS FOR DOOR & REITTE SCHEDULES.
- DISTANCE FROM HINGE SIDE OF DOOR TO INTERSECTING STUD WALL SHALL BE 4" UNLESS NOTED OR DETAILED OTHERWISE (MEASURED FROM OUTSIDE OF FRAME).
- CONTRACTOR SHALL VERIFY ALL DIMENSIONS NOTED AS "CLEAR" OR "MIN". DIMENSIONS NOTED AS "HOLD" ARE CRITICAL TO COORDINATE OTHER WORK (E.G. CEILING GRIDS, LIGHTING, FINISHES).
- CONTRACTOR SHALL VERIFY ALL DIMENSIONS PRIOR TO INITIATING CONSTRUCTION AND REPORT DISCREPANCIES TO ARCHITECT PRIOR TO COMMENCING WORK.
- CONTRACTOR SHALL PROVIDE ALL BLOCKING REQUIRED TO ANCHOR ALL WALL AND CLS MOUNTED ITEMS, INCLUDING BUT NOT LIMITED TO TOILET ROOM ACCESSORIES, MILLWORK, CASEWORK, HANDRAILS, DOOR STOPS ETC.
- FIRE STOPPING SYSTEMS - REFER TO SPEC SECTION 07 94 00 FOR INFO REGARDING PENETRATIONS OF ALL RATED ASSEMBLIES (BOTH SINGLE AND DOUBLE MEMBRANE PENETRATIONS) INCLUDING BUT NOT LIMITED TO PENETRATIONS FOR DUCTWORK, CONDUIT, PIPING AND SUPPORT FOR WALL MOUNTED EQUIPMENT, CABINETS AND COUNTERTOPS.
- UP-SWING GRAB BARS/WALL SUPPORT - SEE DTL 8 C3 AND A3 SHEET 0A106 FOR TUBE STEEL BACKING AT ALL UP-SWING GRAB BARS.
- SEE DETAIL A3/0A156 FOR COLUMN BASE WATERPROOFING AT EXPOSED COLUMNS IN SERVICE BAYS & MECHANICAL ROOMS.
- SHIELDING REQUIREMENTS - VERIFY ALL SHIELDING REQUIREMENTS WITH FINAL EQUIPMENT SELECTIONS AND A VA APPROVED REGISTERED PHYSICIST PRIOR TO COMMENCING WORK IN SHIELDED-ROOM AREAS.
- HOUSEKEEPING AND COPY ROOMS - ALL PARTITIONS TO BE FULL HEIGHT TO UNDERSIDE OF DECK/INTERSTIAL ABOVE. SEE PARTITION TYPE NOTES SHEET 0A102.
- AT PARTIAL HEIGHT CMU PARTITIONS WITH GYPSUM WALLBOARD ABOVE TO STRUCTURE ALIGN FACE OF GWB AND CMU AT SIDE OF MAJOR CORRIDORS. ALL OTHER LOCATIONS CENTER GWB ON CMU WALL UNLESS NOTED OTHERWISE.

FLOOR PLAN SHEET NOTES

- FLOOR PLAN SHEET NOTE SERIES BEGINS WITH NOTE 100
NOT ALL SHEET NOTES APPEAR ON EVERY SHEET
- SLAB OPENING - REF STRUCTURAL DWGS
 - ALIGN PARTITIONS
 - LINE OF CURTAIN WALL SILL - REF EXTERIOR SERIES DWGS
 - LINE OF HOISTWAY BELOW
 - AIR HANDLER UNIT - REF MECHANICAL DWGS
 - STEEL BRACING - REF STRUCTURAL DWGS
 - CONCRETE HOUSEKEEPING PAD - REF STRUCTURAL DWGS
 - ACCORDIAN FIRE DOOR - REF DOOR SCHEDULE
 - NOT USED
 - 08 31 13 FLOOR VAULT DOOR - 36" X 36" - REF DTL 01A0156
 - ROOF/OVERFLOW DRAIN LEADER - REF PLUMBING DWGS
 - ELECTRICAL PANEL - REF ELECTRICAL DWGS
 - MEDICAL GAS ZONE VALVE BOX/MEDICAL GAS ALARM PANEL - REF MED GAS DWGS
 - SLOPE FLOORING IN SHOWER/TOILET ROOM TO DRAIN
 - SLAB RECESS FOR HIGH DENSITY SHELVING TRACK. VY RECESS DIMENSION W/ SHELVING MANUFACTURER.
 - 14 91 34 TRASHLINE CHUTE & STATION: SEE DETAIL S E6/0A1507
 - 14 91 34 TRASHLINE CHUTE: NO LOADING STATION
 - 14 91 34 TRASHLINE CHUTE: PROVIDE SLEEVES @ LEVEL 01 FLOOR
 - SLAB PENETRATION - SEE DETAILS E6/0A1507
 - 08 31 13 3-HOUR FIRE RATED ACCESS PANEL - 24" X 48"
 - ELECTRICAL RISERS - SEE PLAN DETS ON F5/0A1512 - REF ELEC DWGS
 - CONCRETE ENCASED ELECTRICAL FEEDERS ABOVE - REF STRUCTURAL & ELEC DWGS
 - 20 12 02 GLASS FIBER REINFORCED GYPSUM COLUMN COVER - 36" O.D. UON
 - BOLD DASHED LINE INDICATES ROUTE OF STRUCTURAL EXPANSION JOINT - REF STRUCTURAL DWGS. REFERENCE FLOOR PLAN LEGEND FOR INTERIOR EXPANSION JOINT COVER ASSEMBLY INFORMATION.
 - 10 11 00 MARKER BOARD REF INTERIOR ELEV SHEET NOTE 207.
 - 10 11 00 TACK BOARD REF INTERIOR ELEV SHEET NOTE 208.
 - 10 28 00 FOLD-DOWN BENCH
 - 10 28 00 FOLD-DOWN SHOWER SEAT
 - SLAB RECESS FOR WALK-OFF GRILLE. VY RECESS DIMENSION W/ GRILLE MANUFACTURER. SEE FLOOR FINISH PLANS FOR EXTENTS.
 - PLUMBING ROUGH-IN FOR FUTURE SINK - REF PLUMBING DWGS.
 - BENT PLATE W/ TRAFFIC COATING WRAP @ WALL BASE - REF E3/0A1516
 - LINE OF 2-HR RATED SHAFT ABOVE. REF DETAILS E1 & E3 SHT 0A1507
 - 05 05 00 ACCESS LADDER
 - 10 33 13 WIRE MESH PARTITION
 - 05 52 13 PIPE AND TUBING
 - 11 13 00 MANUAL DOCK LEVELER AND BUMPERS
 - 13 44 00 MODULAR MEZZANINES INCL. STAIRS & WIRE MESH PTNS.
 - 05 50 00 METAL GRATE CATWALK
 - WALL MOUNTED HAND SINK - REF PLUMBING DWGS
 - RECESSED EMERGENCY SHOWER AND EXPOSED STAINLESS STEEL SHOWER HEAD - REF PLUMBING DWGS
 - 08 39 19 FLOOD BARRIERS: FLOOD PLANK SYSTEM - REF D5/0A1511
 - CONC. WALLS @ L 01 ELEV SHAFTS - REF STRUCT DWGS & DTL 02/0A1507
 - BENT PLATE W/ PEDESTRIAN TRAFFIC COATING WRAP - REF C3/0A1516
 - PLENUM SYSTEM - SEE EXTERIOR DRAWINGS
 - CENTER PARTITION ON GRIDLINE
 - CENTER PARTITION ON WALL/LIN
 - 10 21 13 TOILET PARTITIONS
 - TOP OF SHAFT LID ASSEMBLY - REF DETAIL B4/0A1507
 - CONC CURB W/ PEDESTRIAN TRAFFIC COATING WRAP - REF D3/0A1516
 - LIGHTING INVERTER CABINET - REF ELEC DWGS
 - ELEVATOR SUMP PUMP CONTROL PANEL - REF PLUMB DWGS
 - ALIGN GYPSUM WALL ABOVE WITH THIS FACE OF CMU

KEY PLAN

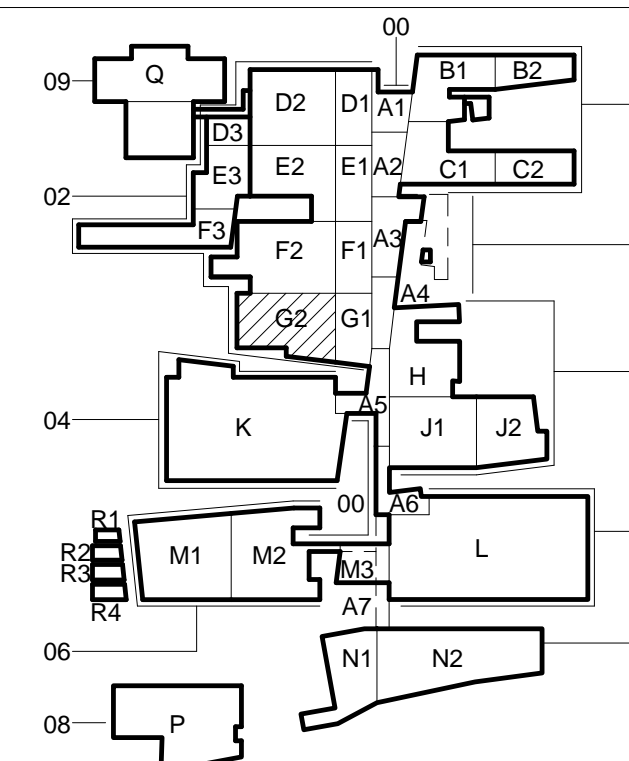

CONSTRUCTION DOCUMENTS 1
FULLY SPRINKLERED

CONSULTANTS:

DESMAN ASSOCIATES / PARKING
CODE CONSULTANTS, INC. / CODE CONSULTANT
THE SEXTANT GROUP / AV & ACOUSTICAL
HAMMER DESIGN ASSOCIATES / FOOD SERVICE
PYBURN & ODOM / ABATEMENT
TATA & HOWARD / TANK CONSULTANT
I.S.C. GROUP, INC. / IRRIGATION
DAN EUSER WATER ARCHITECTURE, INC. / WATER FEATURE

REVISIONS:	DATE
38 BULL 040	3/5/2015
35 BULL 032B	2/10/15
19 BULL 015C - VE	10/15/2013
16 BULL 015B - VE	08/30/2013
1 ADDENDUM 1	05/23/2012