




2 TYPICAL DENTAL EXAM ROOM  
A.302 12' x 10'

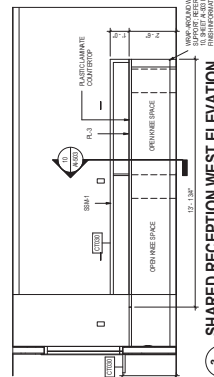

3 SHARED RECEPTION WEST ELEVATION  
A.302 38' x 10'

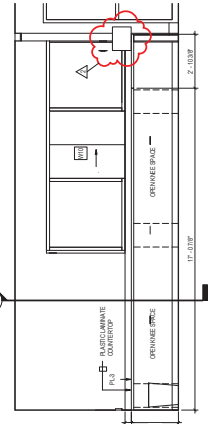


4 SHARED RECEPTION SOUTH ELEVATION  
A.302 38' x 10'

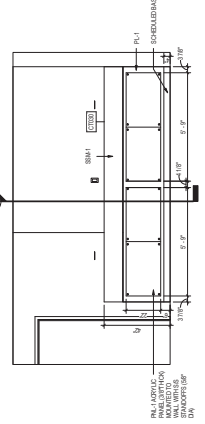

5 SHARED RECEPTION EAST ELEVATION  
A.302 38' x 10'

ENLARGED PLAN - DENTAL  
1 1/4" = 1'-0"

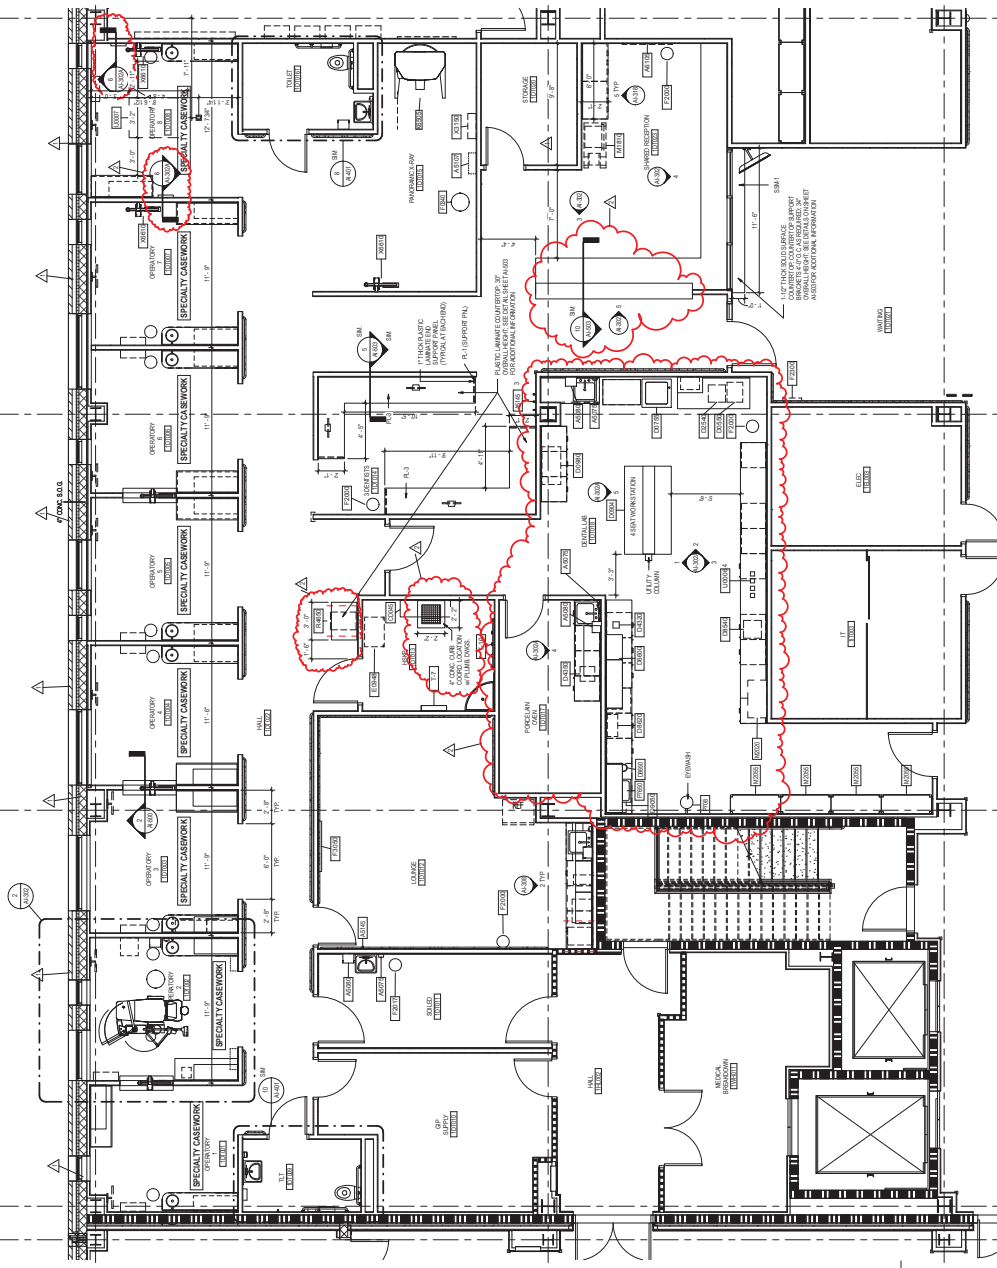

CASEWORK GENERAL NOTES:


JOINT SCHEDULE NUMBERS (JN)

