



## 8 FUNCTIONAL DIAGRAM

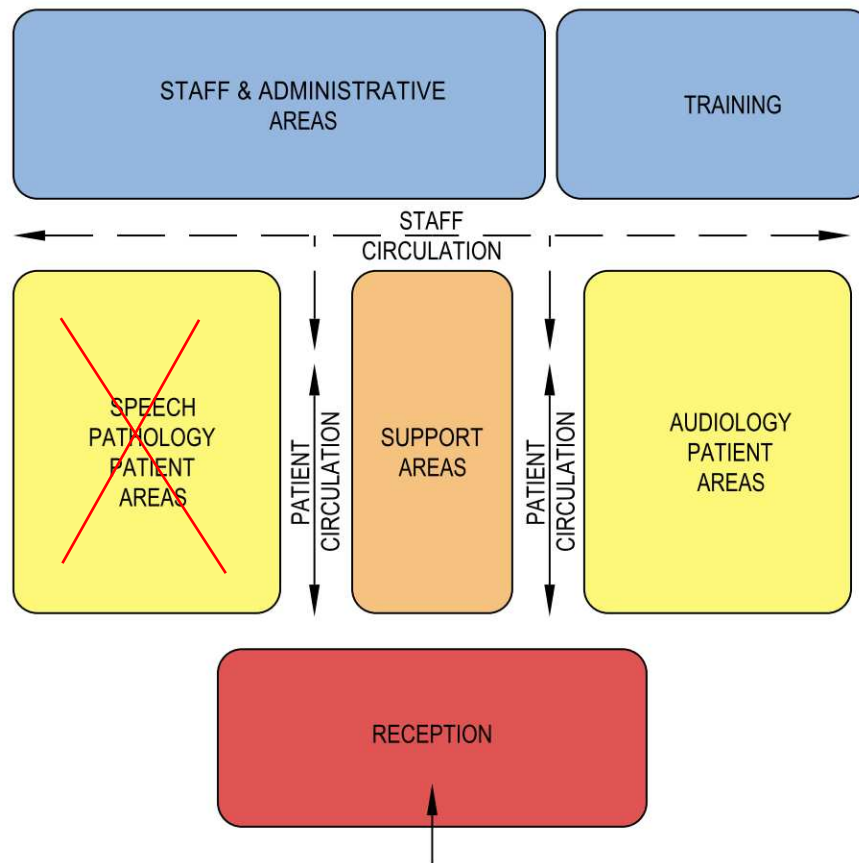

## 8 FUNCTIONAL DIAGRAM

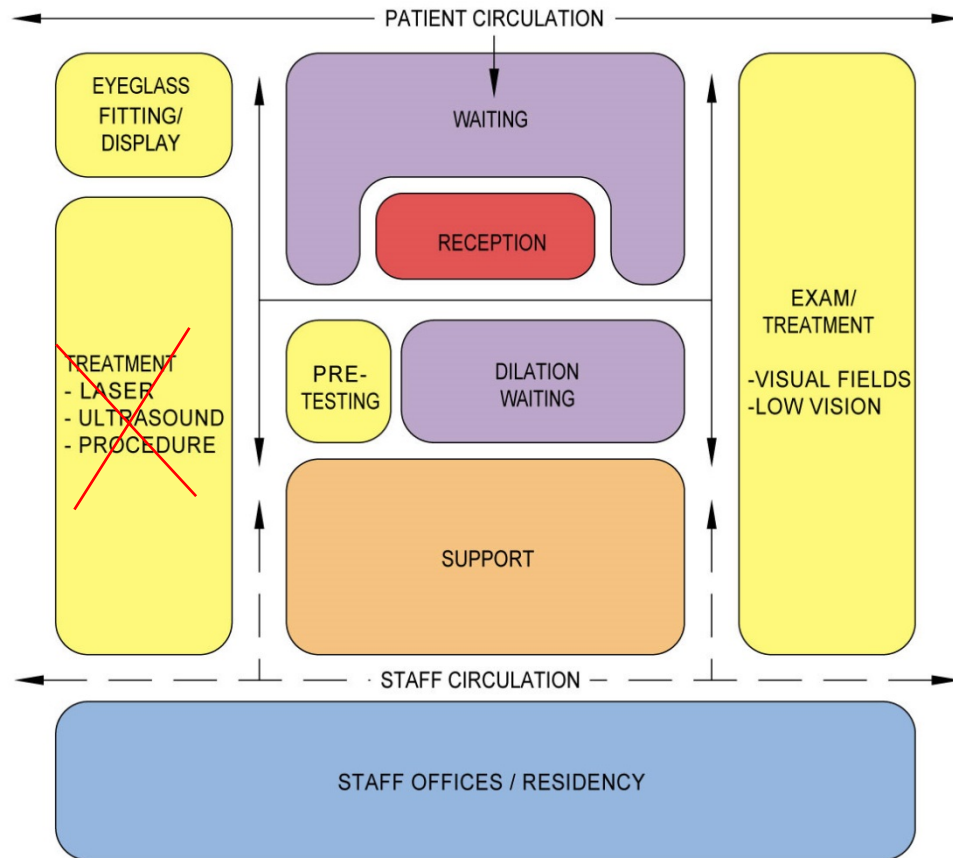

FUNCTIONAL DIAGRAM 1 - EYE CLINIC