



FIRST FLOOR PLAN

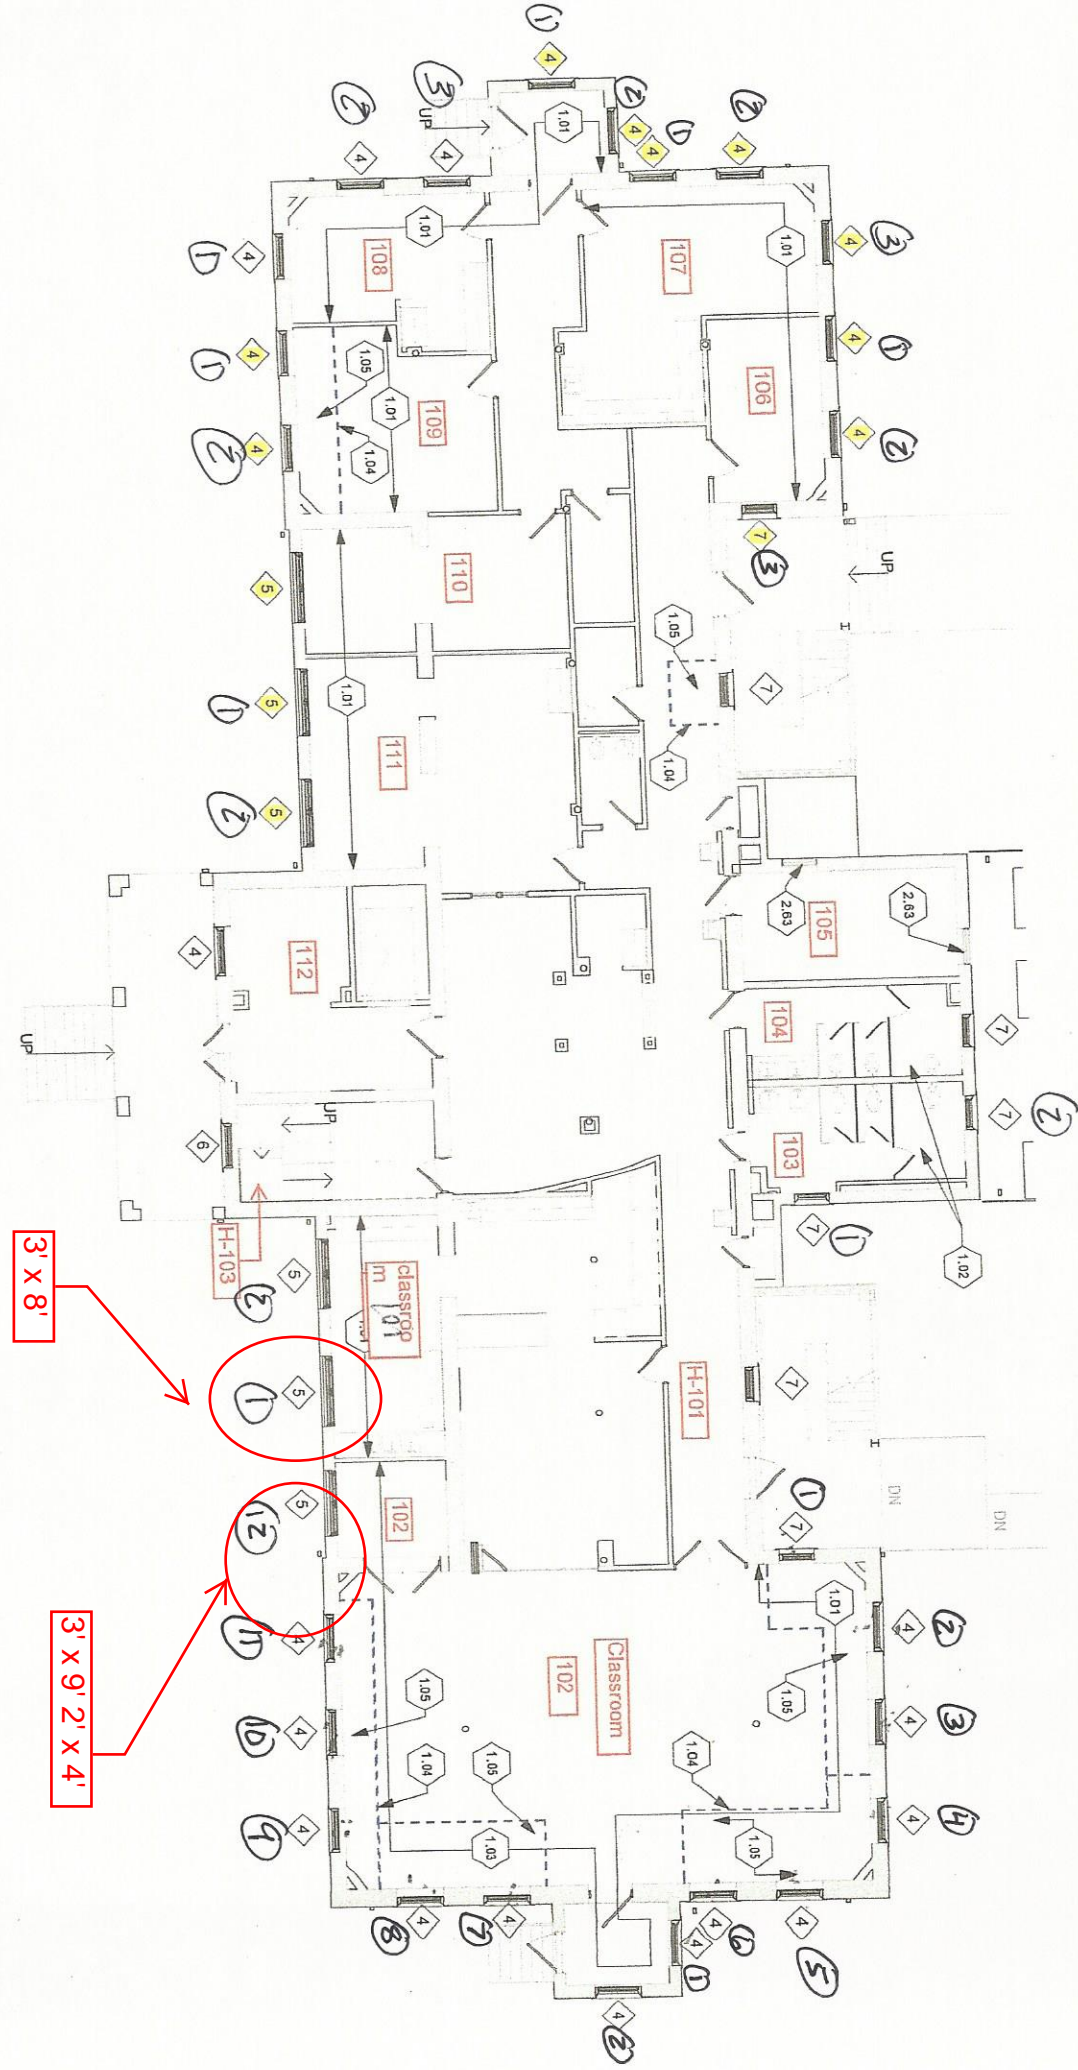

require
Windo
in acc
1.3 / H
Existin
Roof a
struct
Ancho
ralls.

1.05
2.63
2.64
5.01

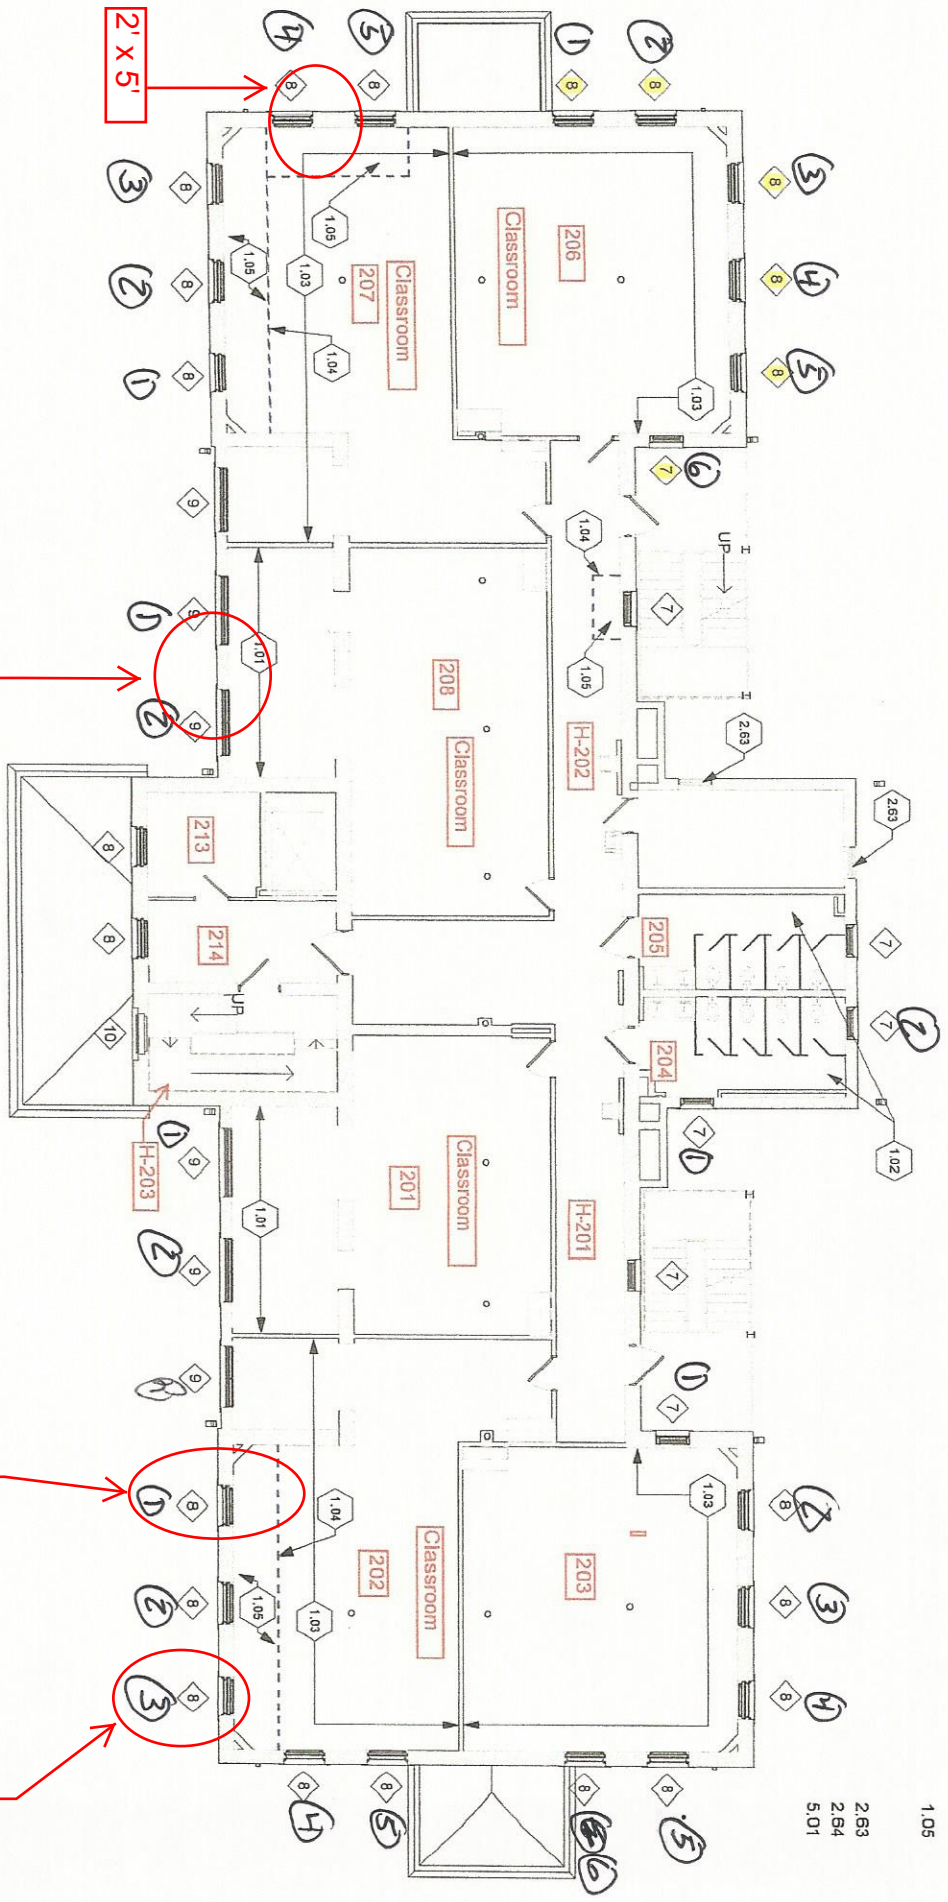

SECOND FLOOR PLAN

2' x 8'

4' x 9' 2' x 4'

1' x 6'

