

DEPARTMENT OF VETERANS AFFAIRS
 JESSE BROWN VA MEDICAL CENTER
 ENGINEERING SERVICE

= ZONE 500 = 6TH FL =

DRAWING AREA


ROOM
 NUMBER
 ZONES:
 30 = 100'S
 11A = 200'S
 11B = 300'S
 1A = 400'S
 1B = 500'S



SOUTH DAMEN AVENUE

FOUR DIGIT ROOM NUMBER
 FIRST DIGIT - FLOOR NUMBER
 SECOND DIGIT - ZONE NUMBER
 THIRD DIGIT - ROOM NUMBER
 FOURTH DIGIT - LOCATION

1234



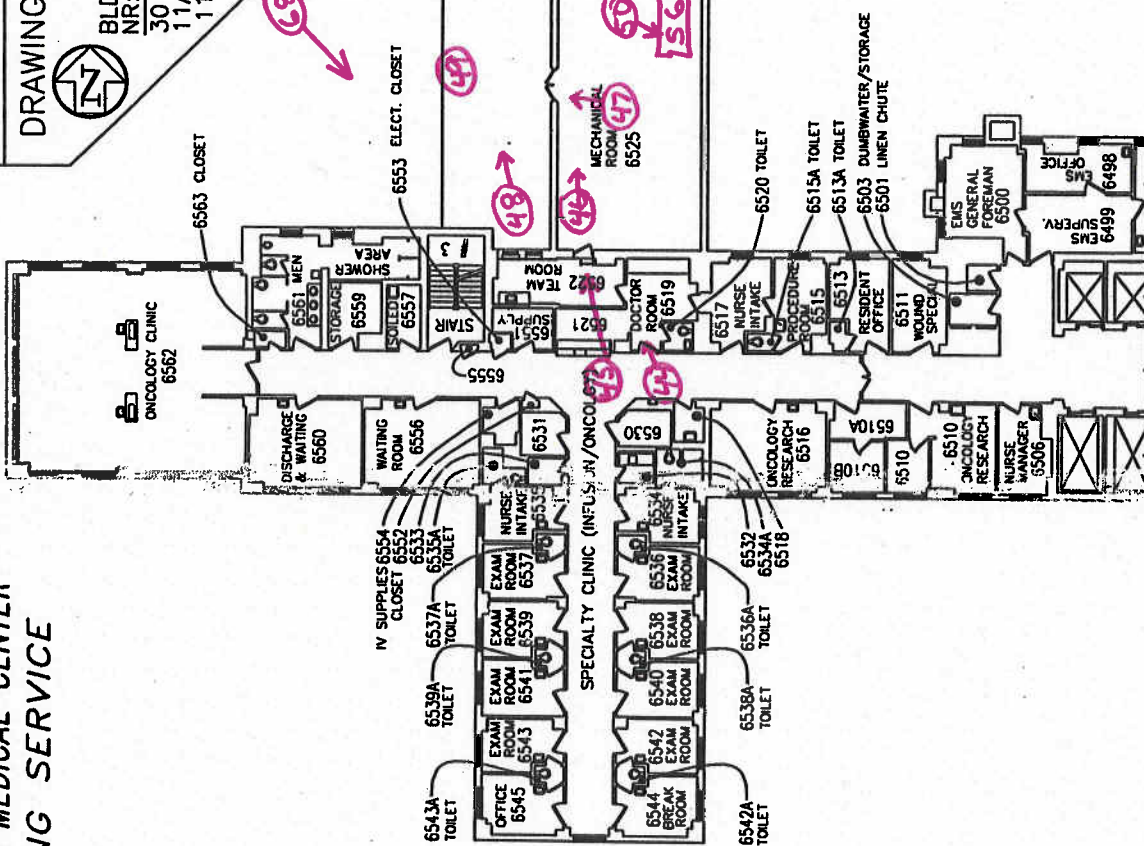


0 5' 10' 20' 30' 40' 50'
 DRAWING SCALE :

ZONE 500
 6TH FLOOR

DEPARTMENT OF VETERANS AFFAIRS
JESSE BROWN VA MEDICAL CENTER
ENGINEERING SERVICE

= ZONE 500 = 5TH FL =

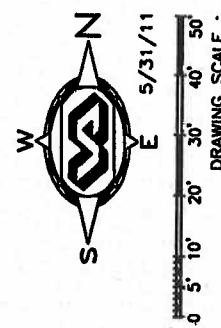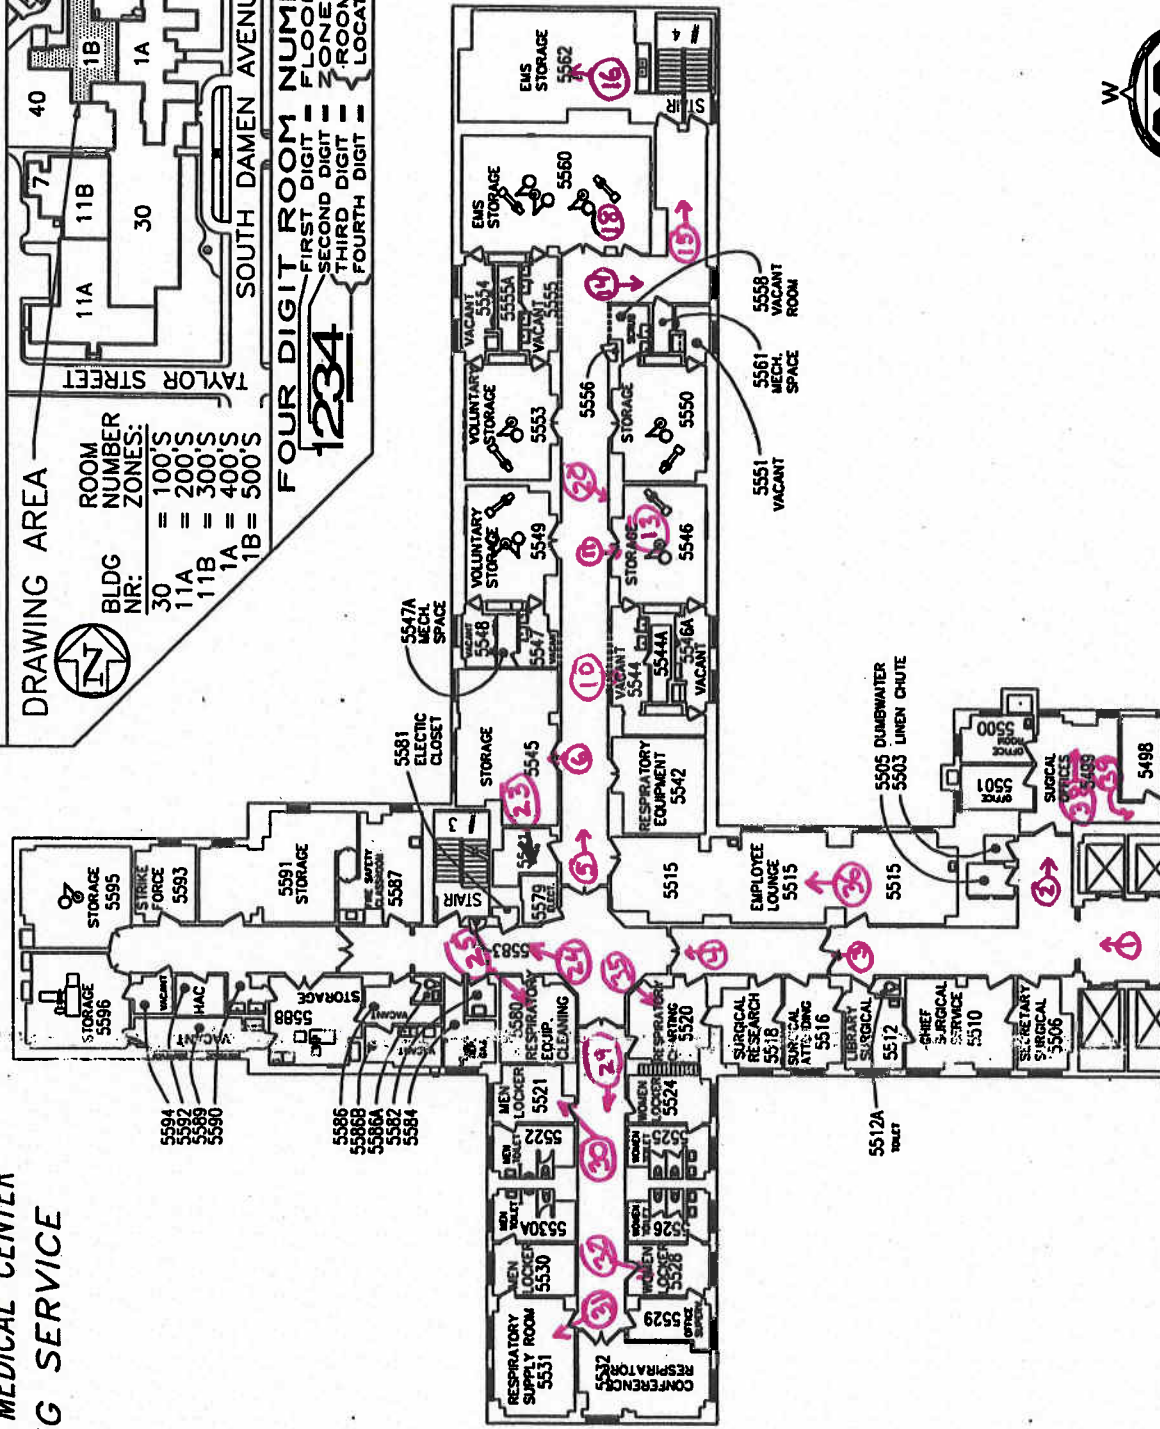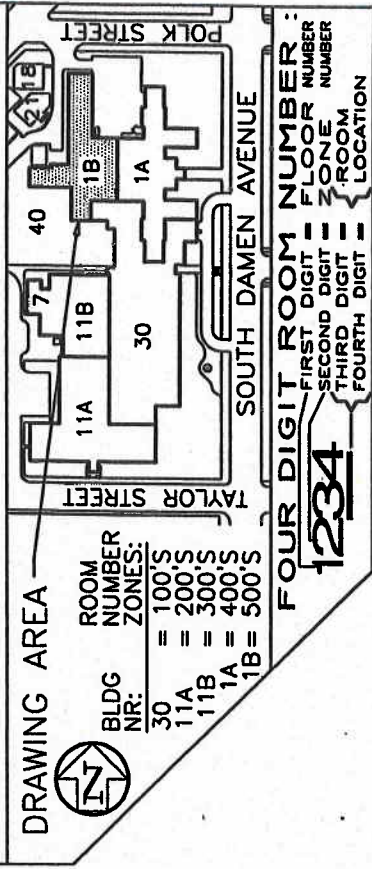

ZONE 500
5TH FLOOR