



(SOW)

689-11-210 (Electrical)

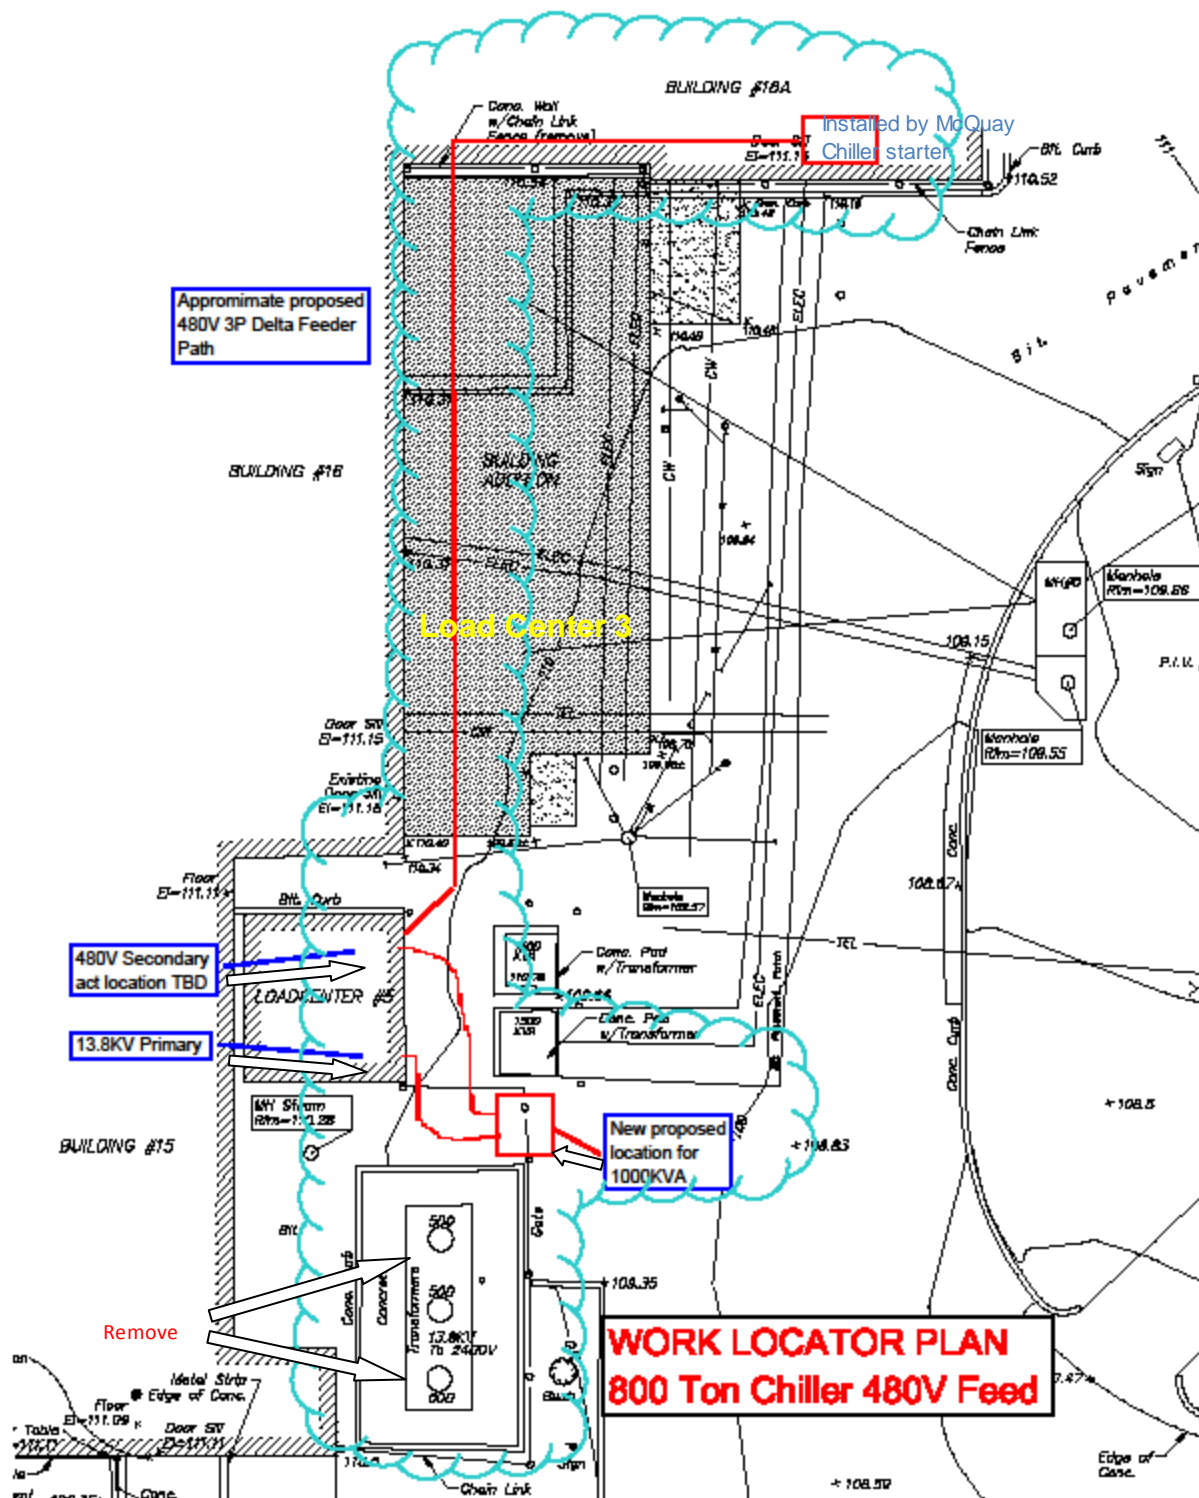



LOAD Center 3

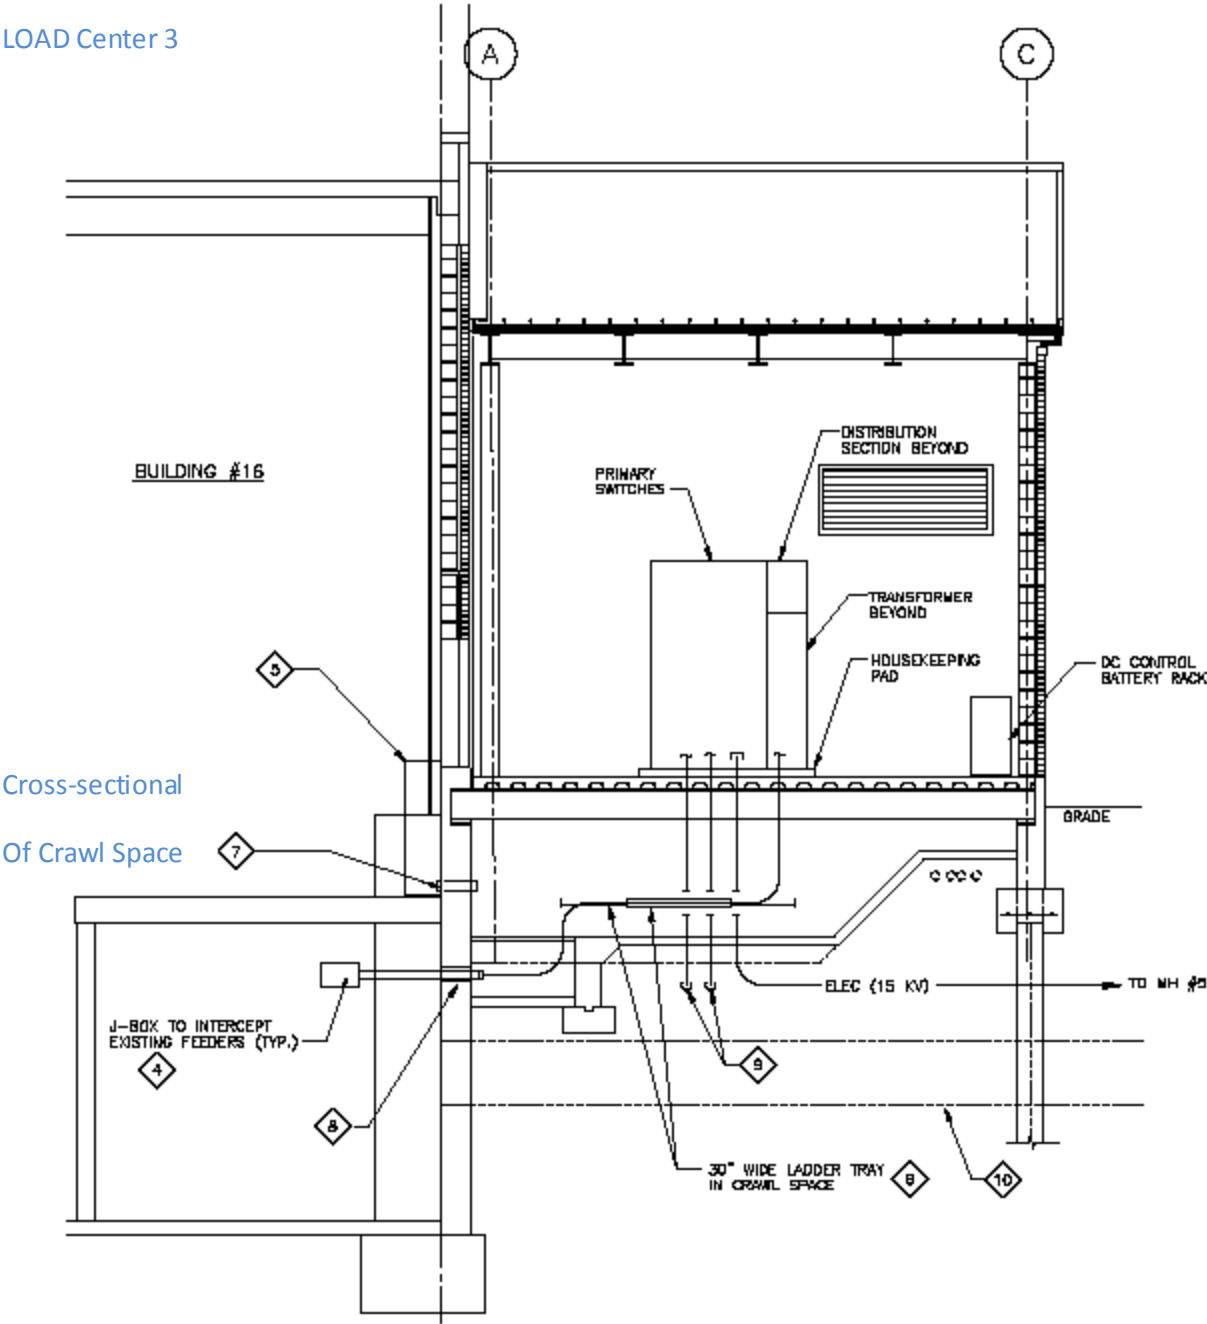

Load Center 3

Plan View of Crawl Space

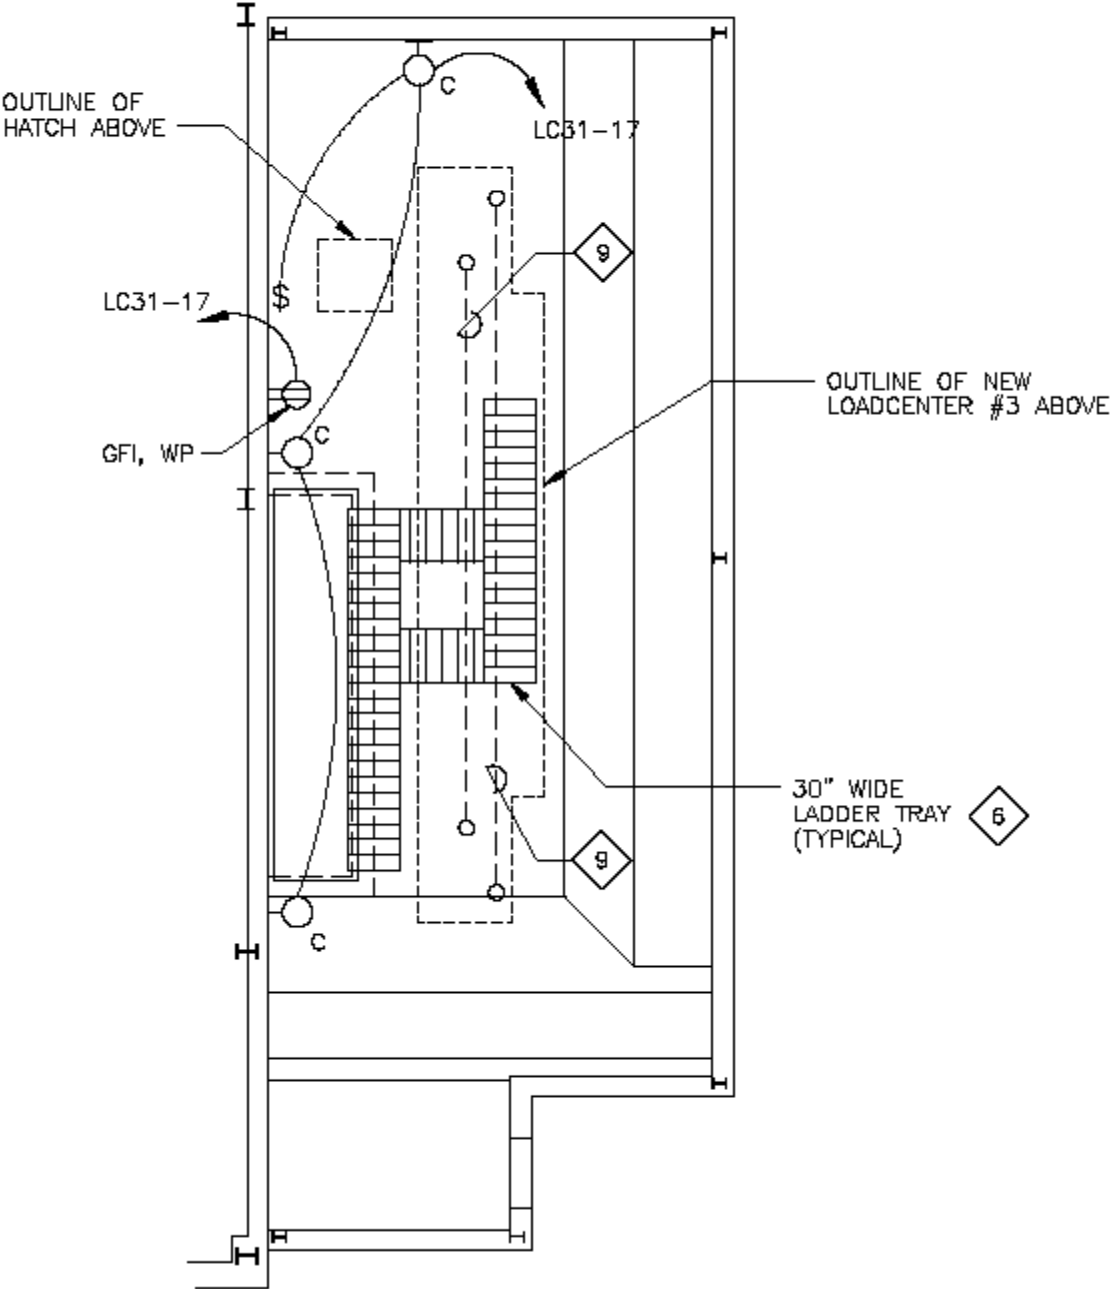

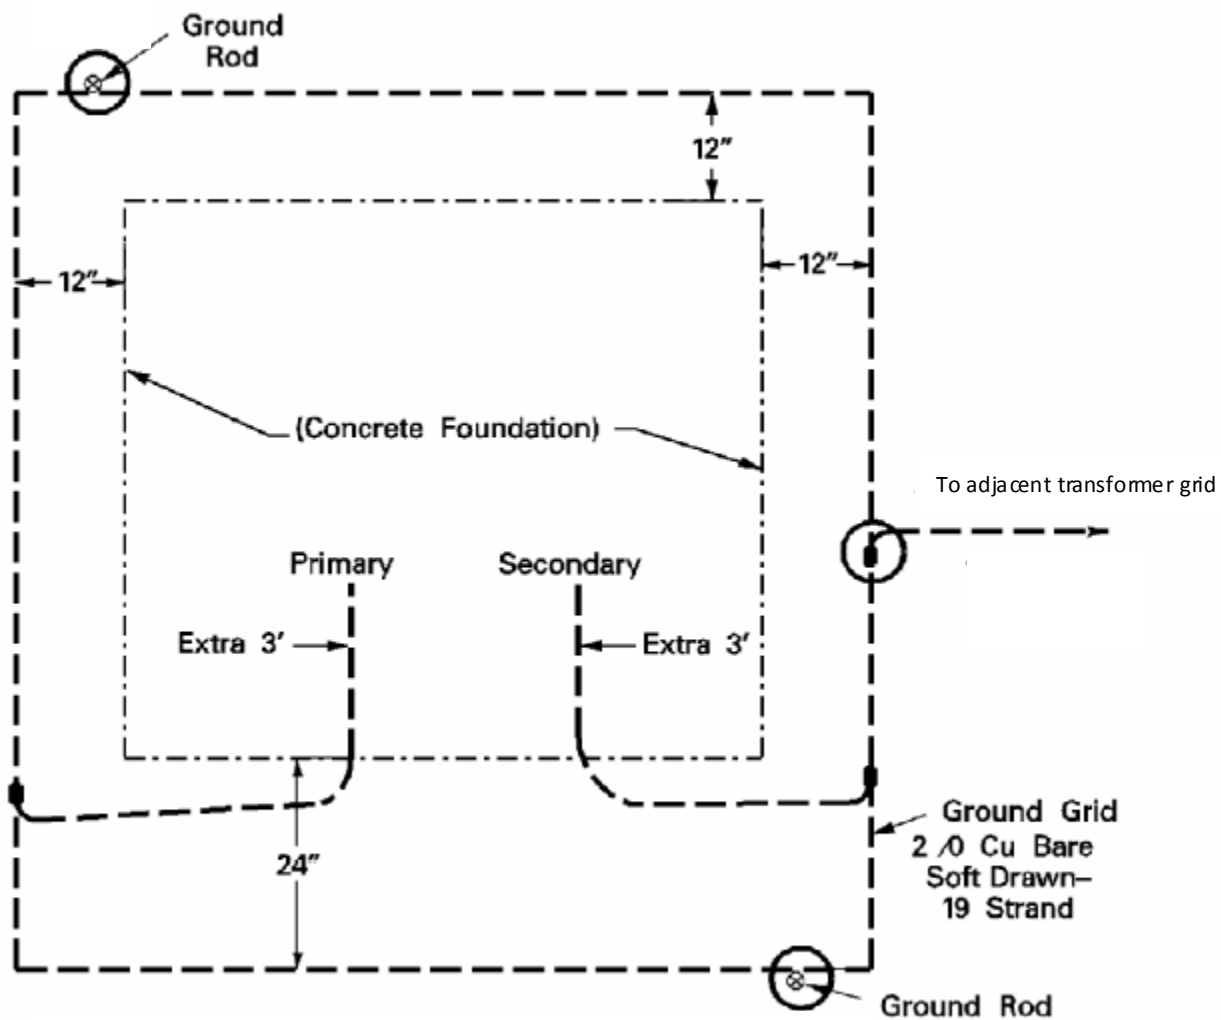

Copper weld (Exothermic weld) ground grid to ground rods and wire to primary and secondary enclosures.

A Ballard will be placed in front of new transformer to match existing.