


DALLAS VA MEDICAL CENTER  
LEARNING CENTER  
PROJ# 549-15-520  
RFI #4 SK-1 RESPONSE

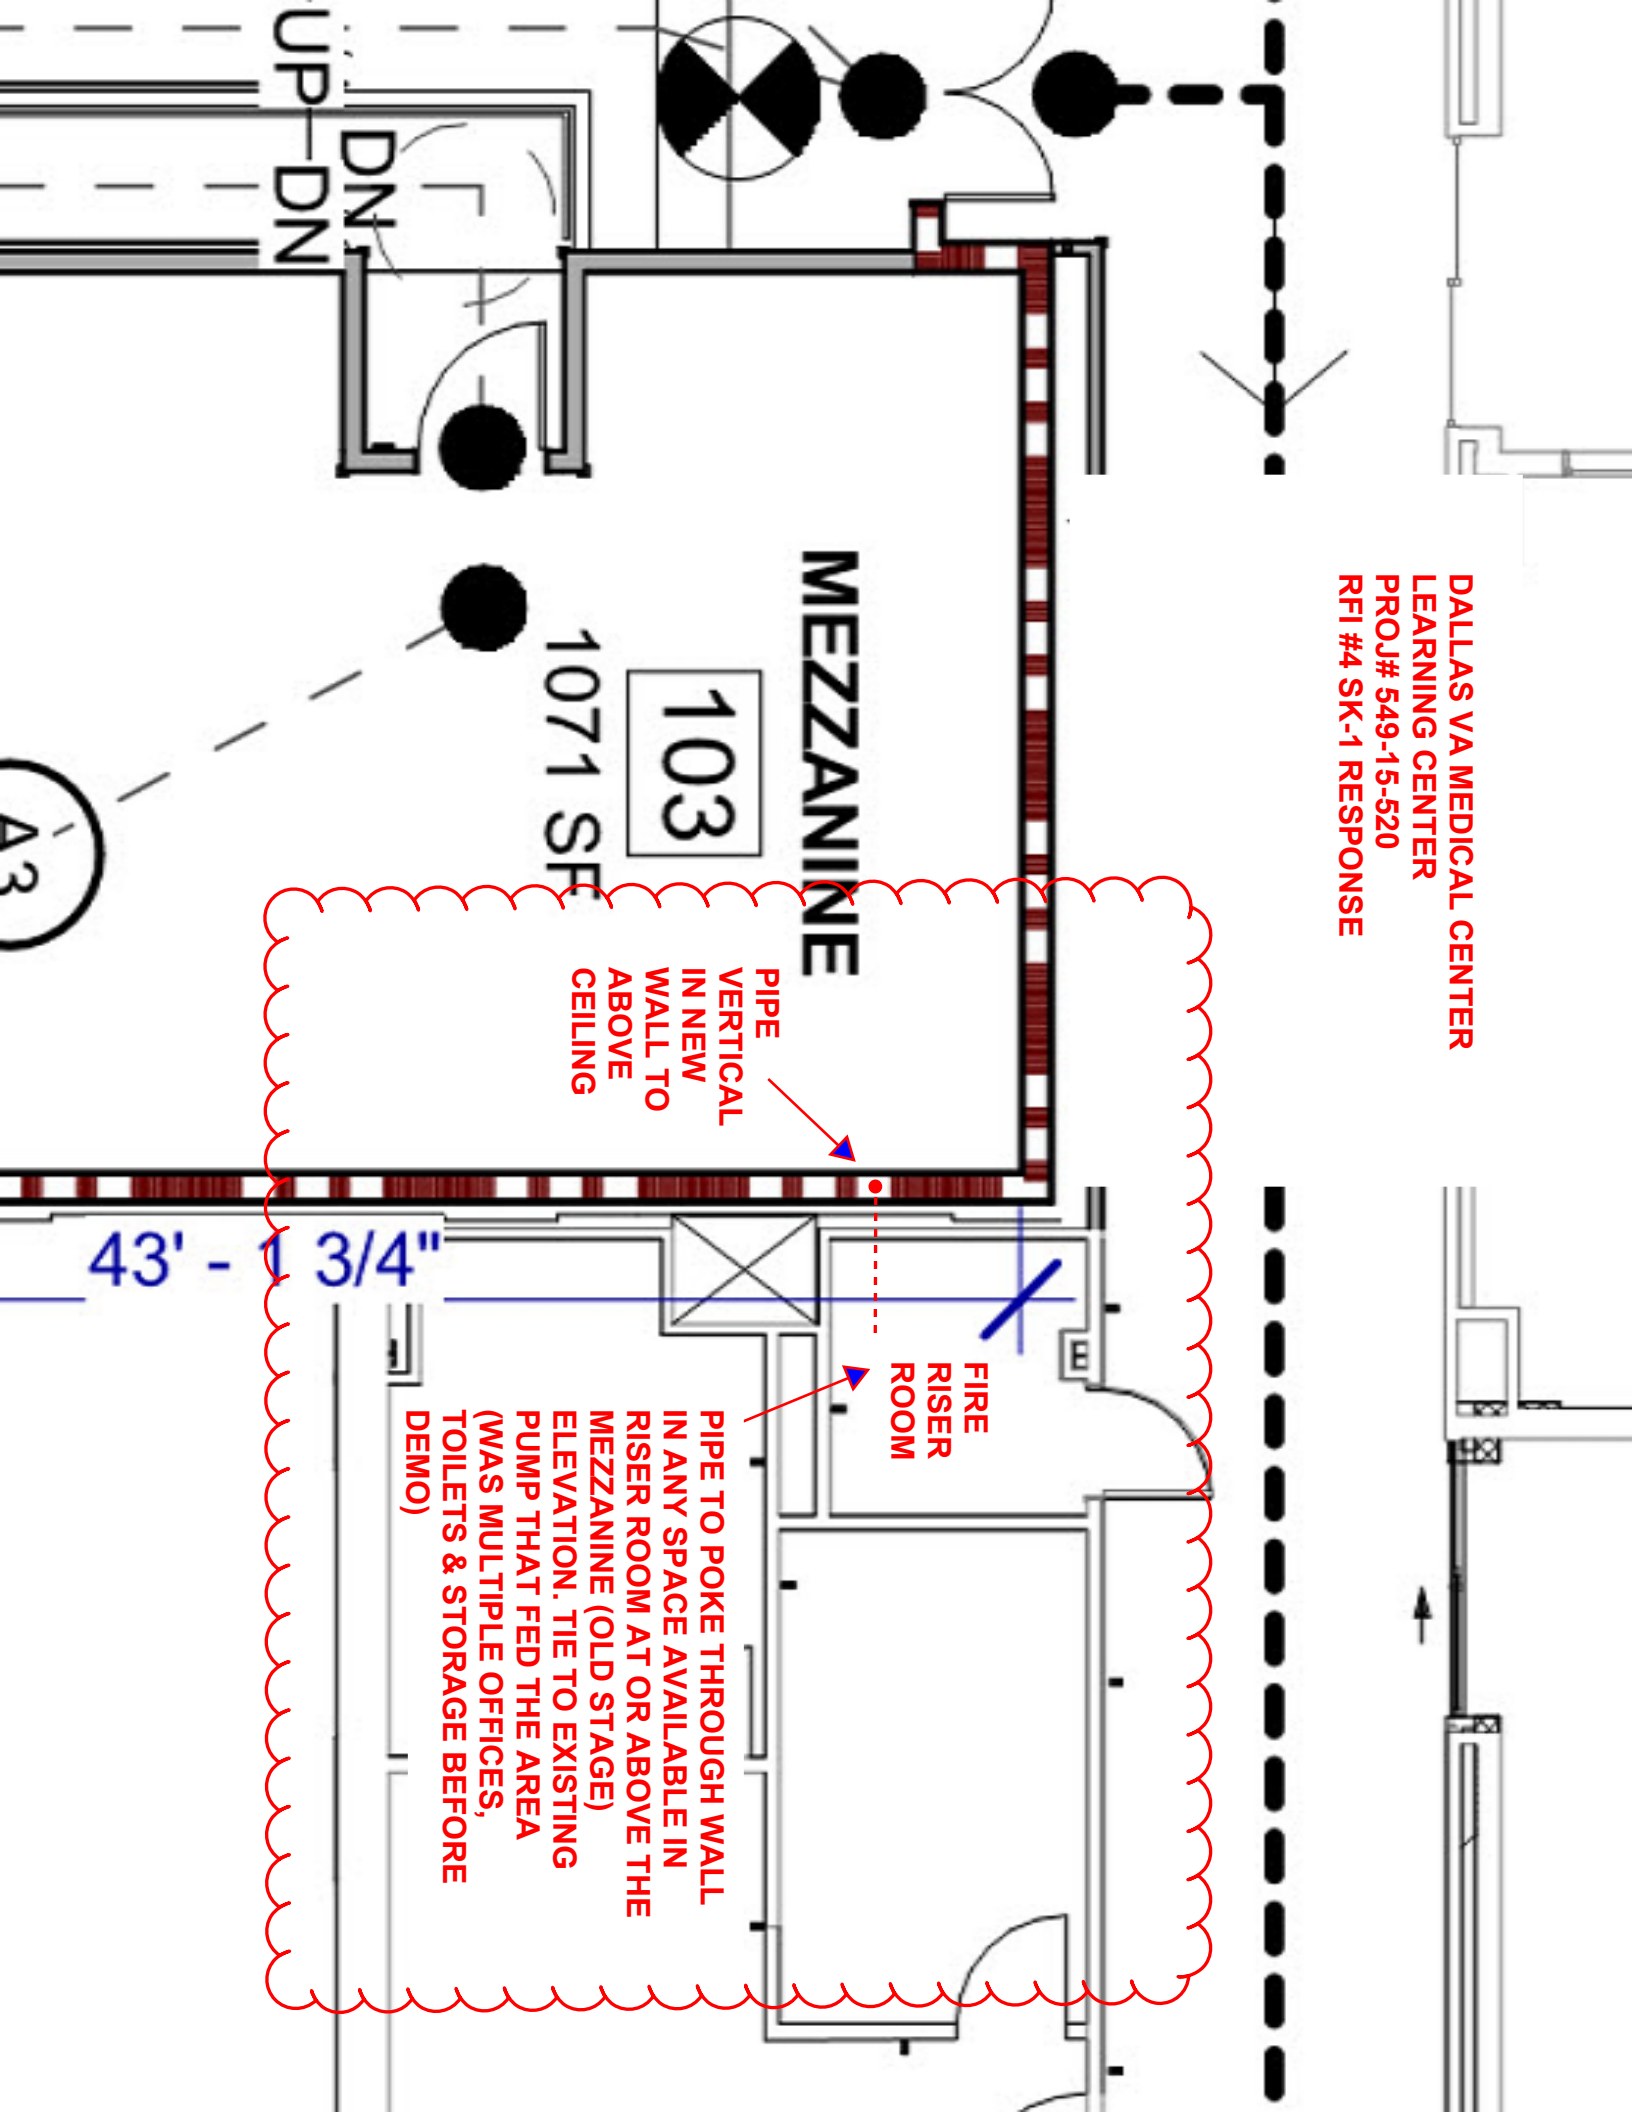

PIPE  
VERTICAL  
IN NEW  
WALL TO  
ABOVE  
CEILING

FIRE  
RISER  
ROOM

PIPE TO POKE THROUGH WALL  
IN ANY SPACE AVAILABLE IN  
RISER ROOM AT OR ABOVE THE  
MEZZANINE (OLD STAGE)  
ELEVATION. TIE TO EXISTING  
PUMP THAT FED THE AREA  
(WAS MULTIPLE OFFICES,  
TOILETS & STORAGE BEFORE  
DEMO)