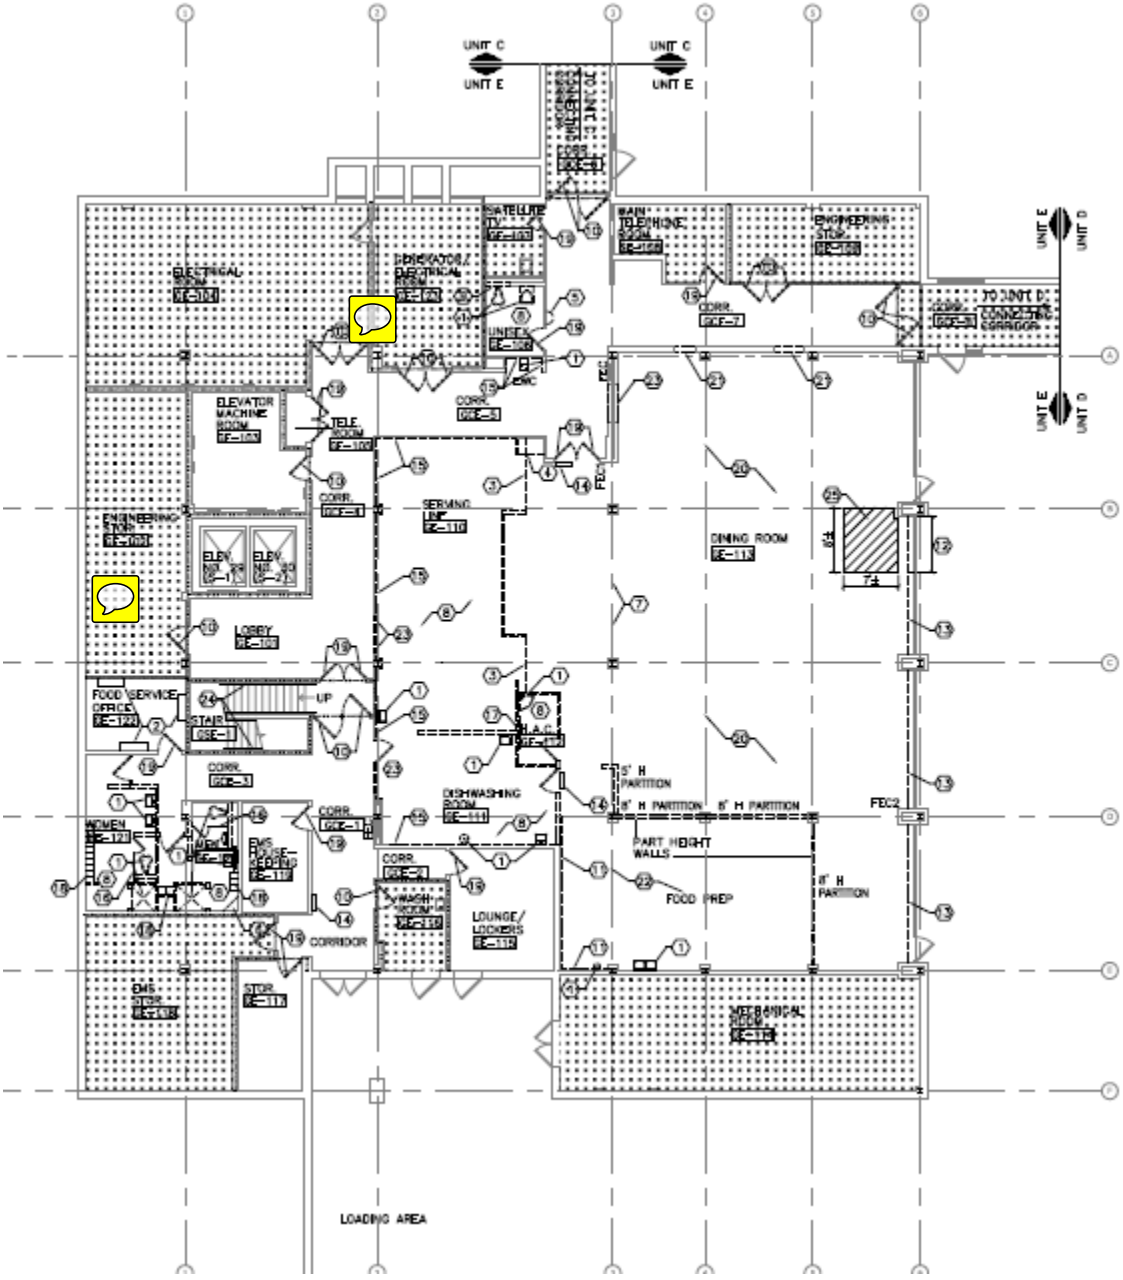Please open the two yellow notes for change in data floor penetration to 1st floor location