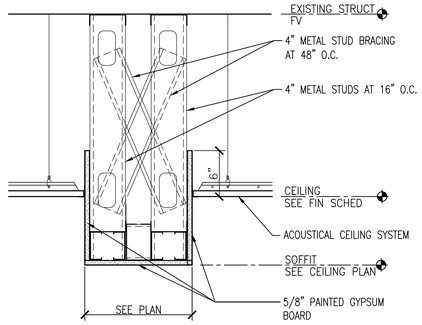

11 A503 TYPICAL BULKHEAD
1 1/2" = 1'-0"

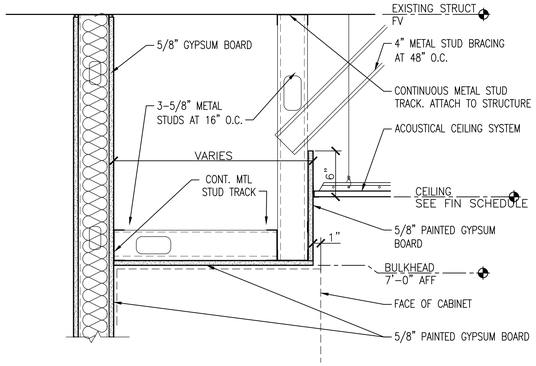

10 A503 SOFFIT DETAIL ABOVE WALL CABINET
1 1/2" = 1'-0"

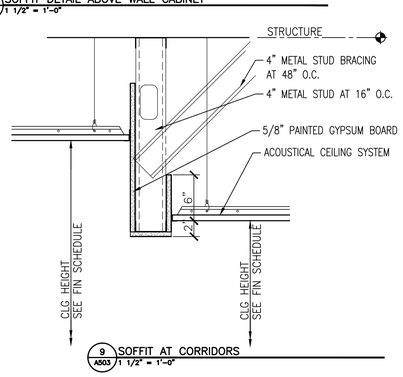

9 A503 SOFFIT AT CORRIDORS
1 1/2" = 1'-0"

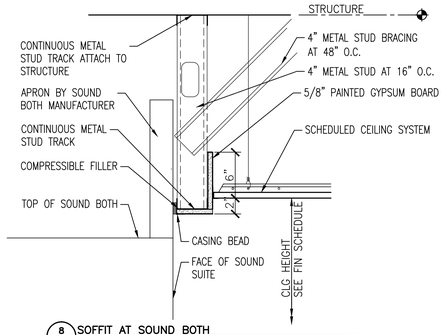

8 A503 SOFFIT AT SOUND BOTH
1 1/2" = 1'-0"

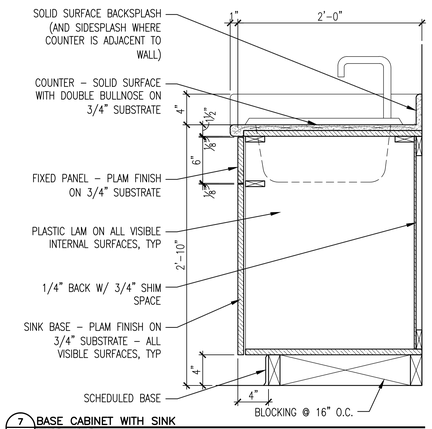

7 A503 BASE CABINET WITH SINK
1 1/2" = 1'-0"

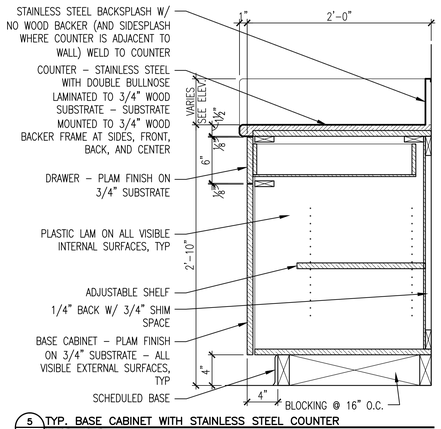

5 A503 TYP. BASE CABINET WITH STAINLESS STEEL COUNTER
1 1/2" = 1'-0"
SINK BASE SIMILAR

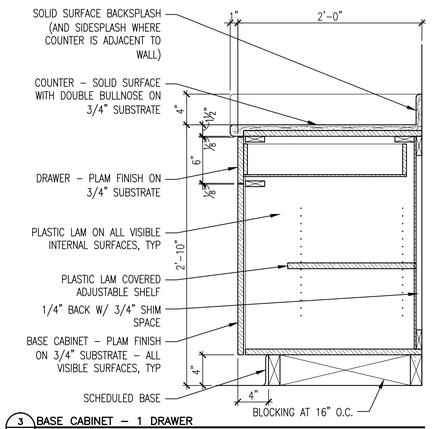

3 A503 BASE CABINET – 1 DRAWER
1 1/2" = 1'-0"

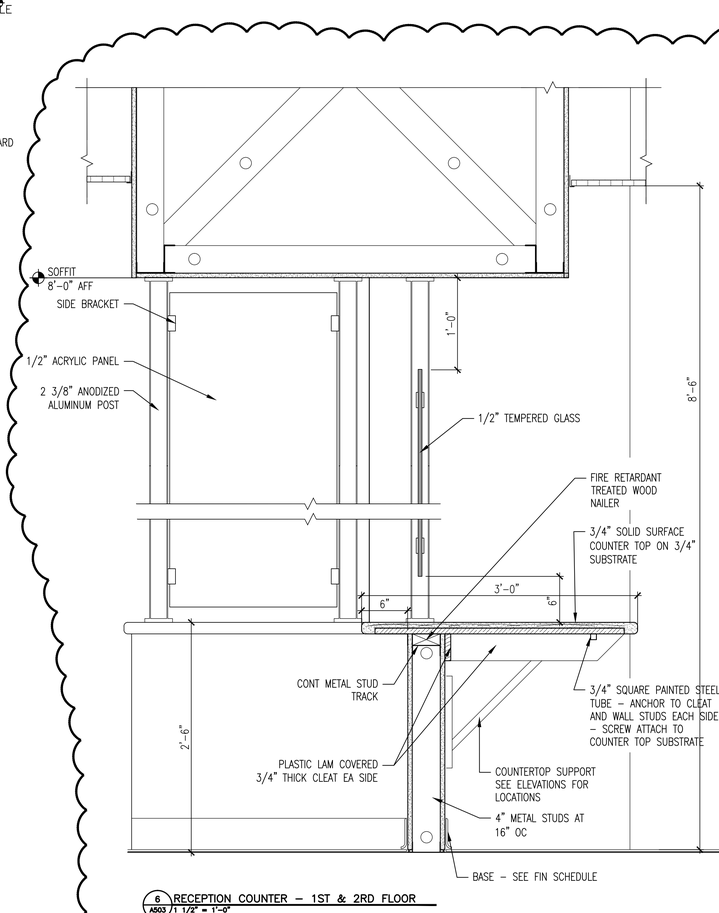

6 A503 RECEPTION COUNTER – 1ST & 2RD FLOOR
1 1/2" = 1'-0"

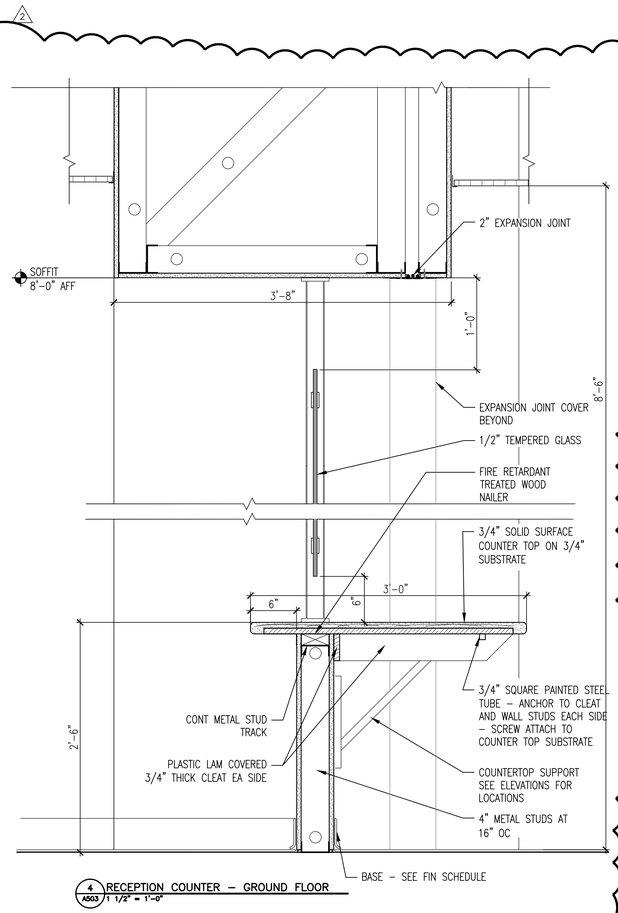

4 A503 RECEPTION COUNTER – GROUND FLOOR
1 1/2" = 1'-0"

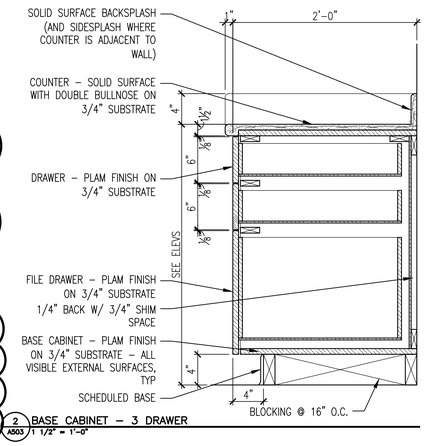

2 A503 BASE CABINET – 3 DRAWER
1 1/2" = 1'-0"

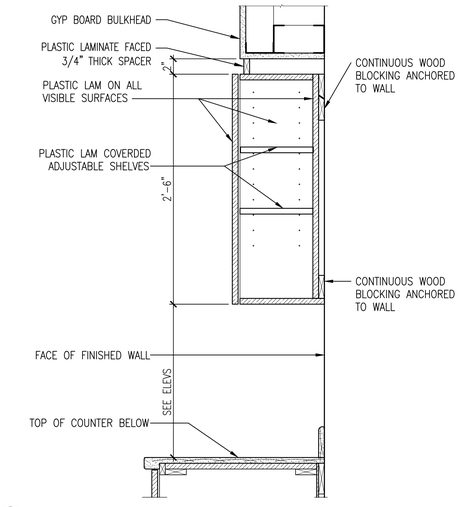

1 A503 TYP. WALL CABINET
1 1/2" = 1'-0"

ADDENDUM 2	8/19/2016
Revisions:	Date

CONSULTANTS:

ARCHITECT:

TOLAND MIZELL MOLNAR

590 Means Street, NW, Ste.200
Atlanta, GA 30318
404.214.9774

Drawing Title: CABINET DETAILS AND CEILING DETAILS

Approved: Chief Engineer

Project Title: EXPAND OUTPATIENT CLINIC SERVICES

Location: TUSCALOOSA AL.

Date: 01-22-2016 | Checked: DM | Drawn:

Project Number: 679-315

Building Number: 38

Drawing Number: A503

Dwg. 66 of 187

OFFICE OF CONSTRUCTION AND FACILITIES MANAGEMENT

Department of Veterans Affairs

01/22/2016 DOCUMENTS

VA FORM 08-6231

Plotted by: mcunningham
Plotted Date: Aug 18, 2016 - 3:25pm