
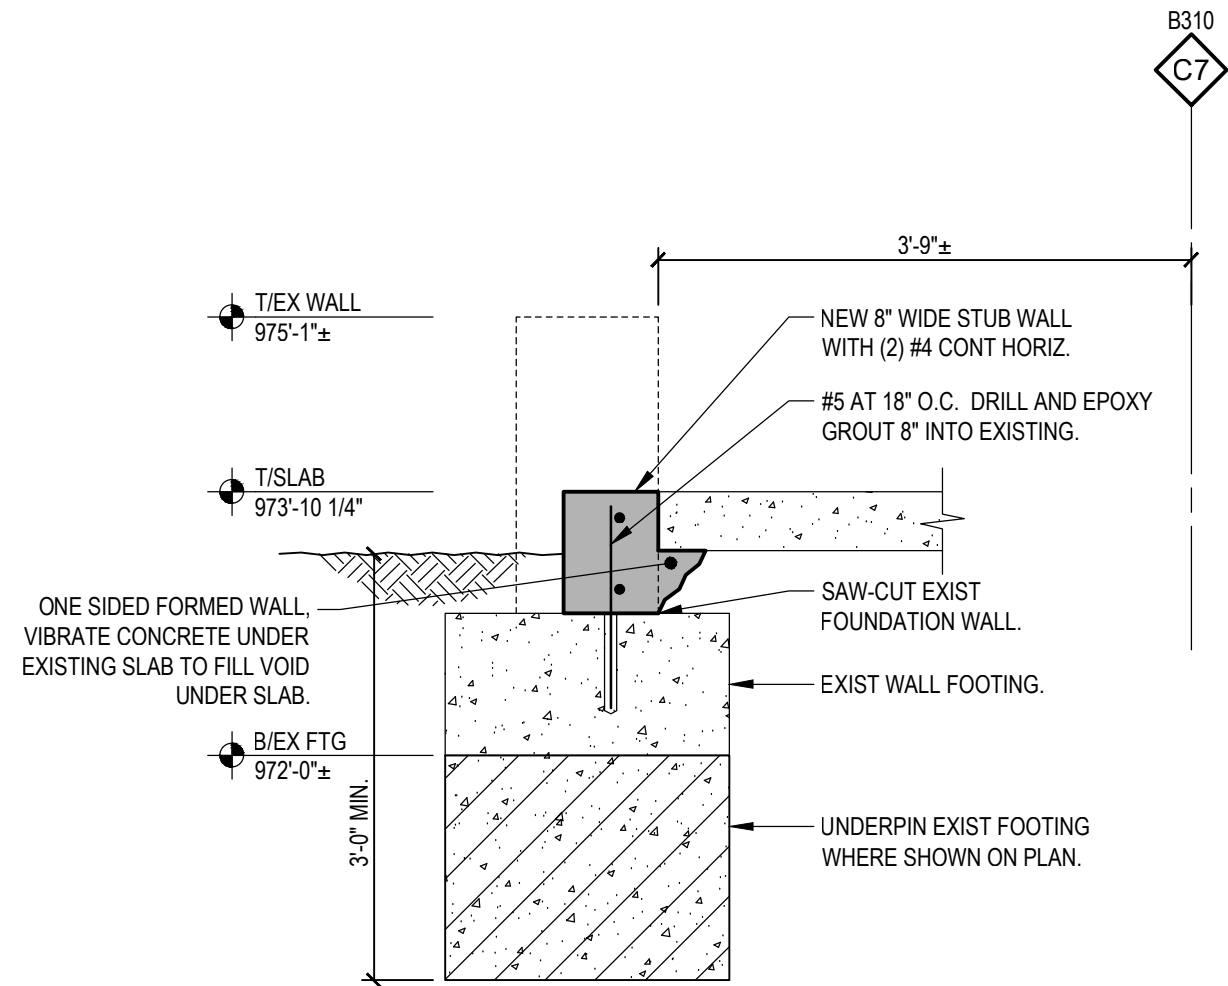


1 SECTION
307S201 3/4" = 1'-0"

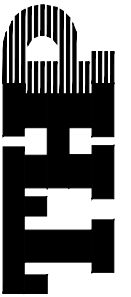

2 SECTION
307S201 3/4" = 1'-0"

 <p>THP Limited, Inc. 100 East Eighth Street Cincinnati, Ohio 45202 Phone: 513.241.3222 Fax: 513.241.2981 www.thpltd.com</p>	PROJECT VA DAYTON - RELOCATE PROSTHETICS AND PODIATRY CLINICS		DRAWING NUMBER
	TITLE SECTION 1/307S201 AND 2/307S201 REVISIONS		THP # 14416.02
	ISSUE		DATE 8/16/16
	BY FJE		SKS 01