





Detail 1: Demolish unit heater an all associated mechanical, electrical, and structural components.



Detail 2. Project Engineer believes panel LM-2 is fed through LM-1. Contractor to verify and submit.

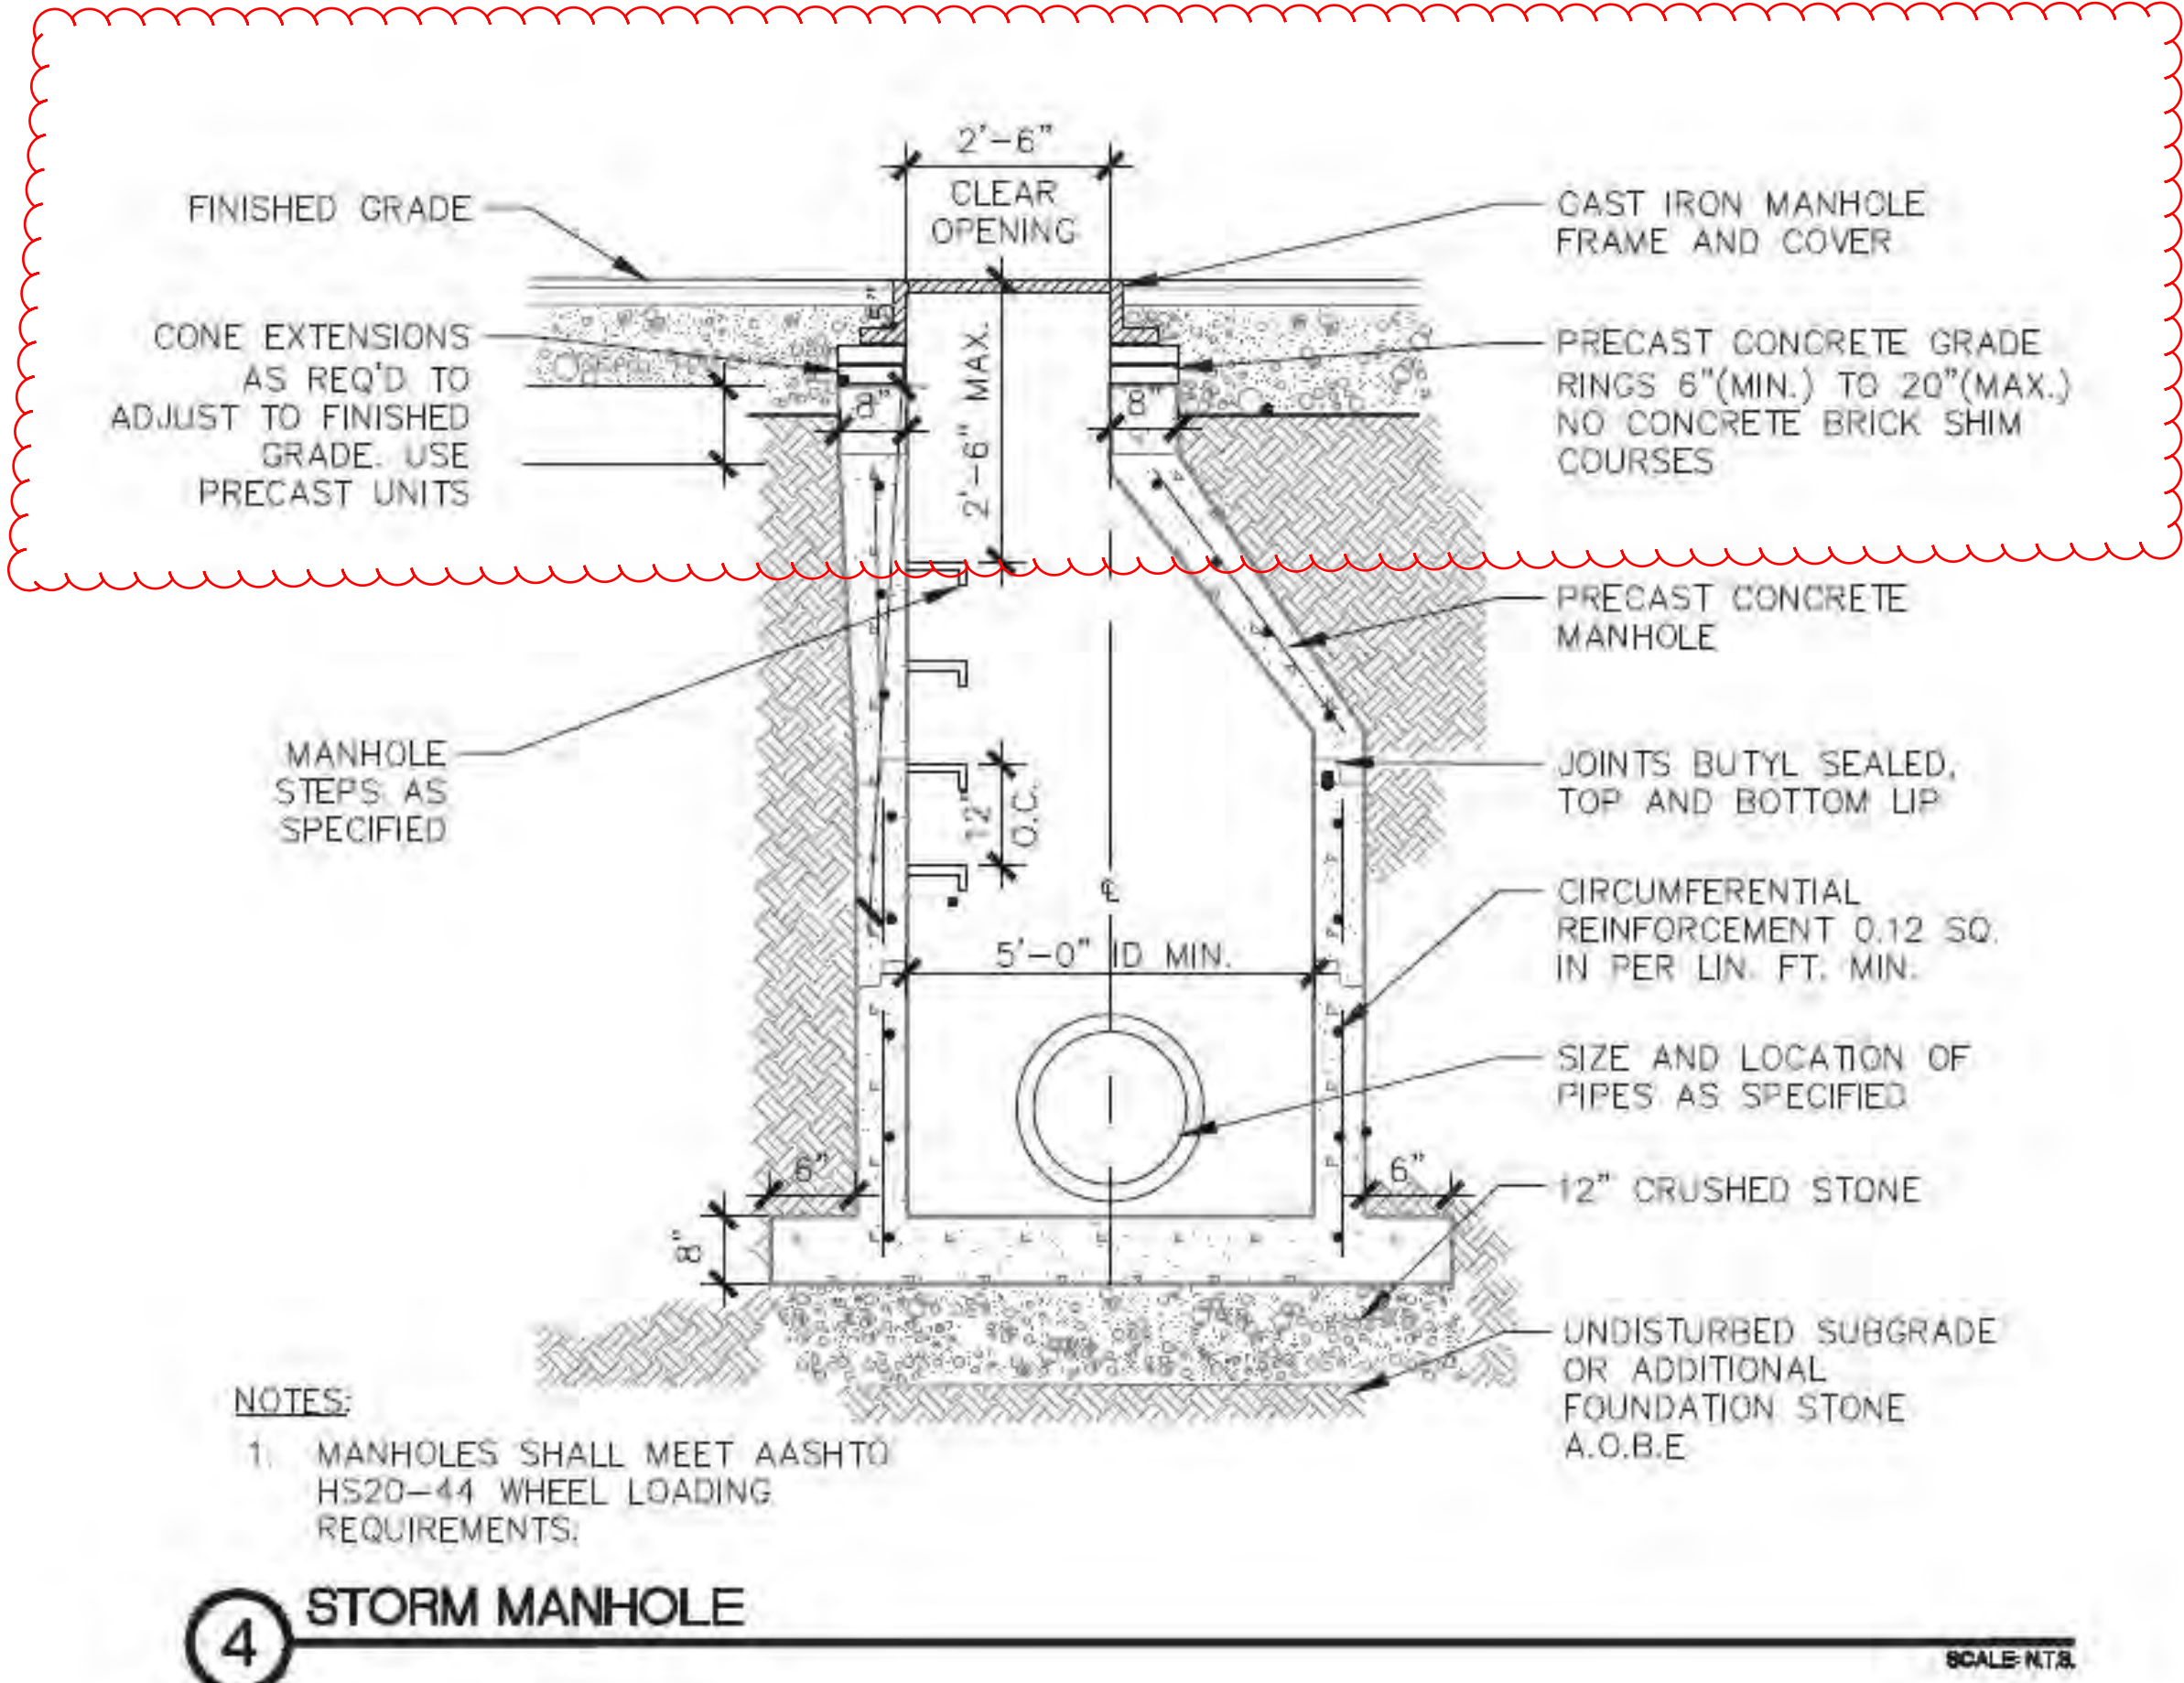

Detail 4 (above): Demolish failed manhole areas highlighted in red and replace with new. See specifications for more information. Note that precast concrete shall match the cast in place concrete specifications. Note also that existing manholes do not match this updated detail. Contractor shall bid for concrete and concrete block demolition work. New design build custom solution shall be enacted by the contractor which shall include a reinforced concrete solution per the design build detail.
Detail 4 (below picture): Note typical failure which involves excavation, some concrete removal, infill, manhole/inlet repair, and asphalt repairs.

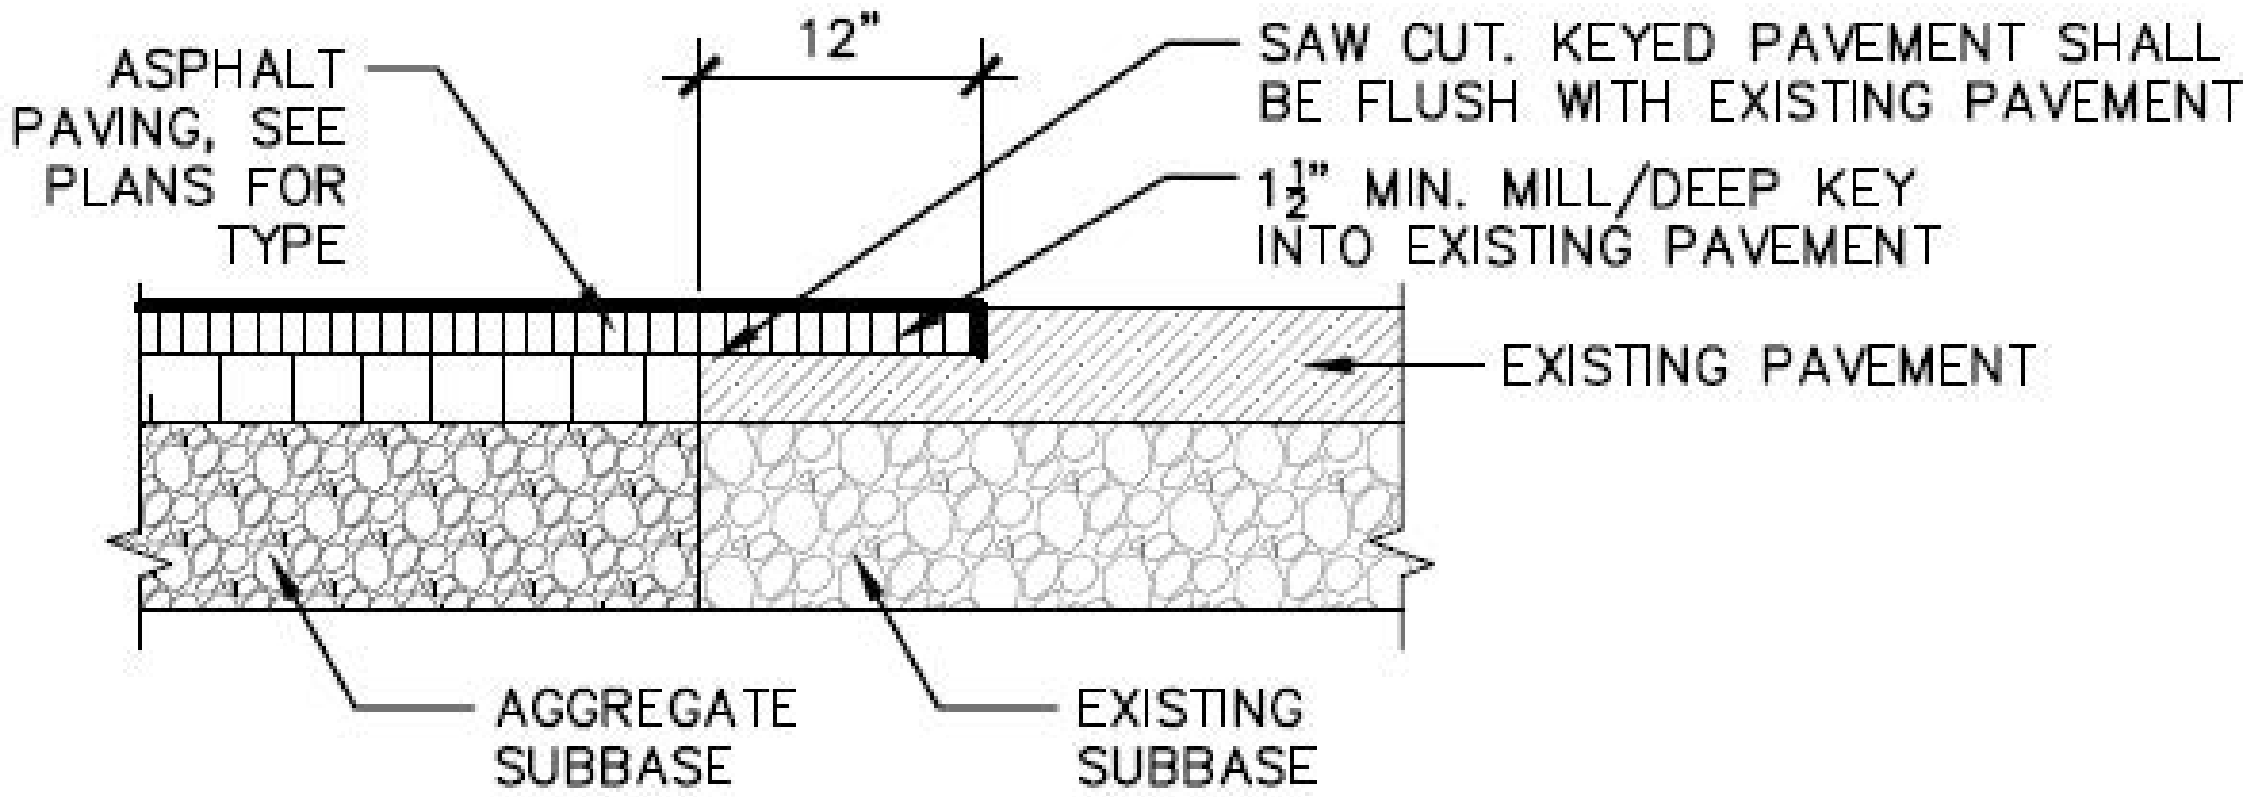



Detail 5: Install new asphalt which abuts existing asphalt following the above detail.





Detail 6: Demolish and remove two (2) trailers from the spoils area of the site.





Detail 3: Demolish spalled concrete seen here, and reinstall. Dowel #4 rebar with epoxy into existing. Match color of existing. Caulk to match existing.

					 <div>NATIONAL CEMETERY ADMINISTRATION</div>	Drawing Title		Project Title		Project Number		<div>Office of Facilities Management</div> <div> Department of Veterans Affairs</div>
						Approved: Project Director		Location		Building Number		
						Date		Checked	Drawn	Drawing Number		
										818-M&R16-03-001		


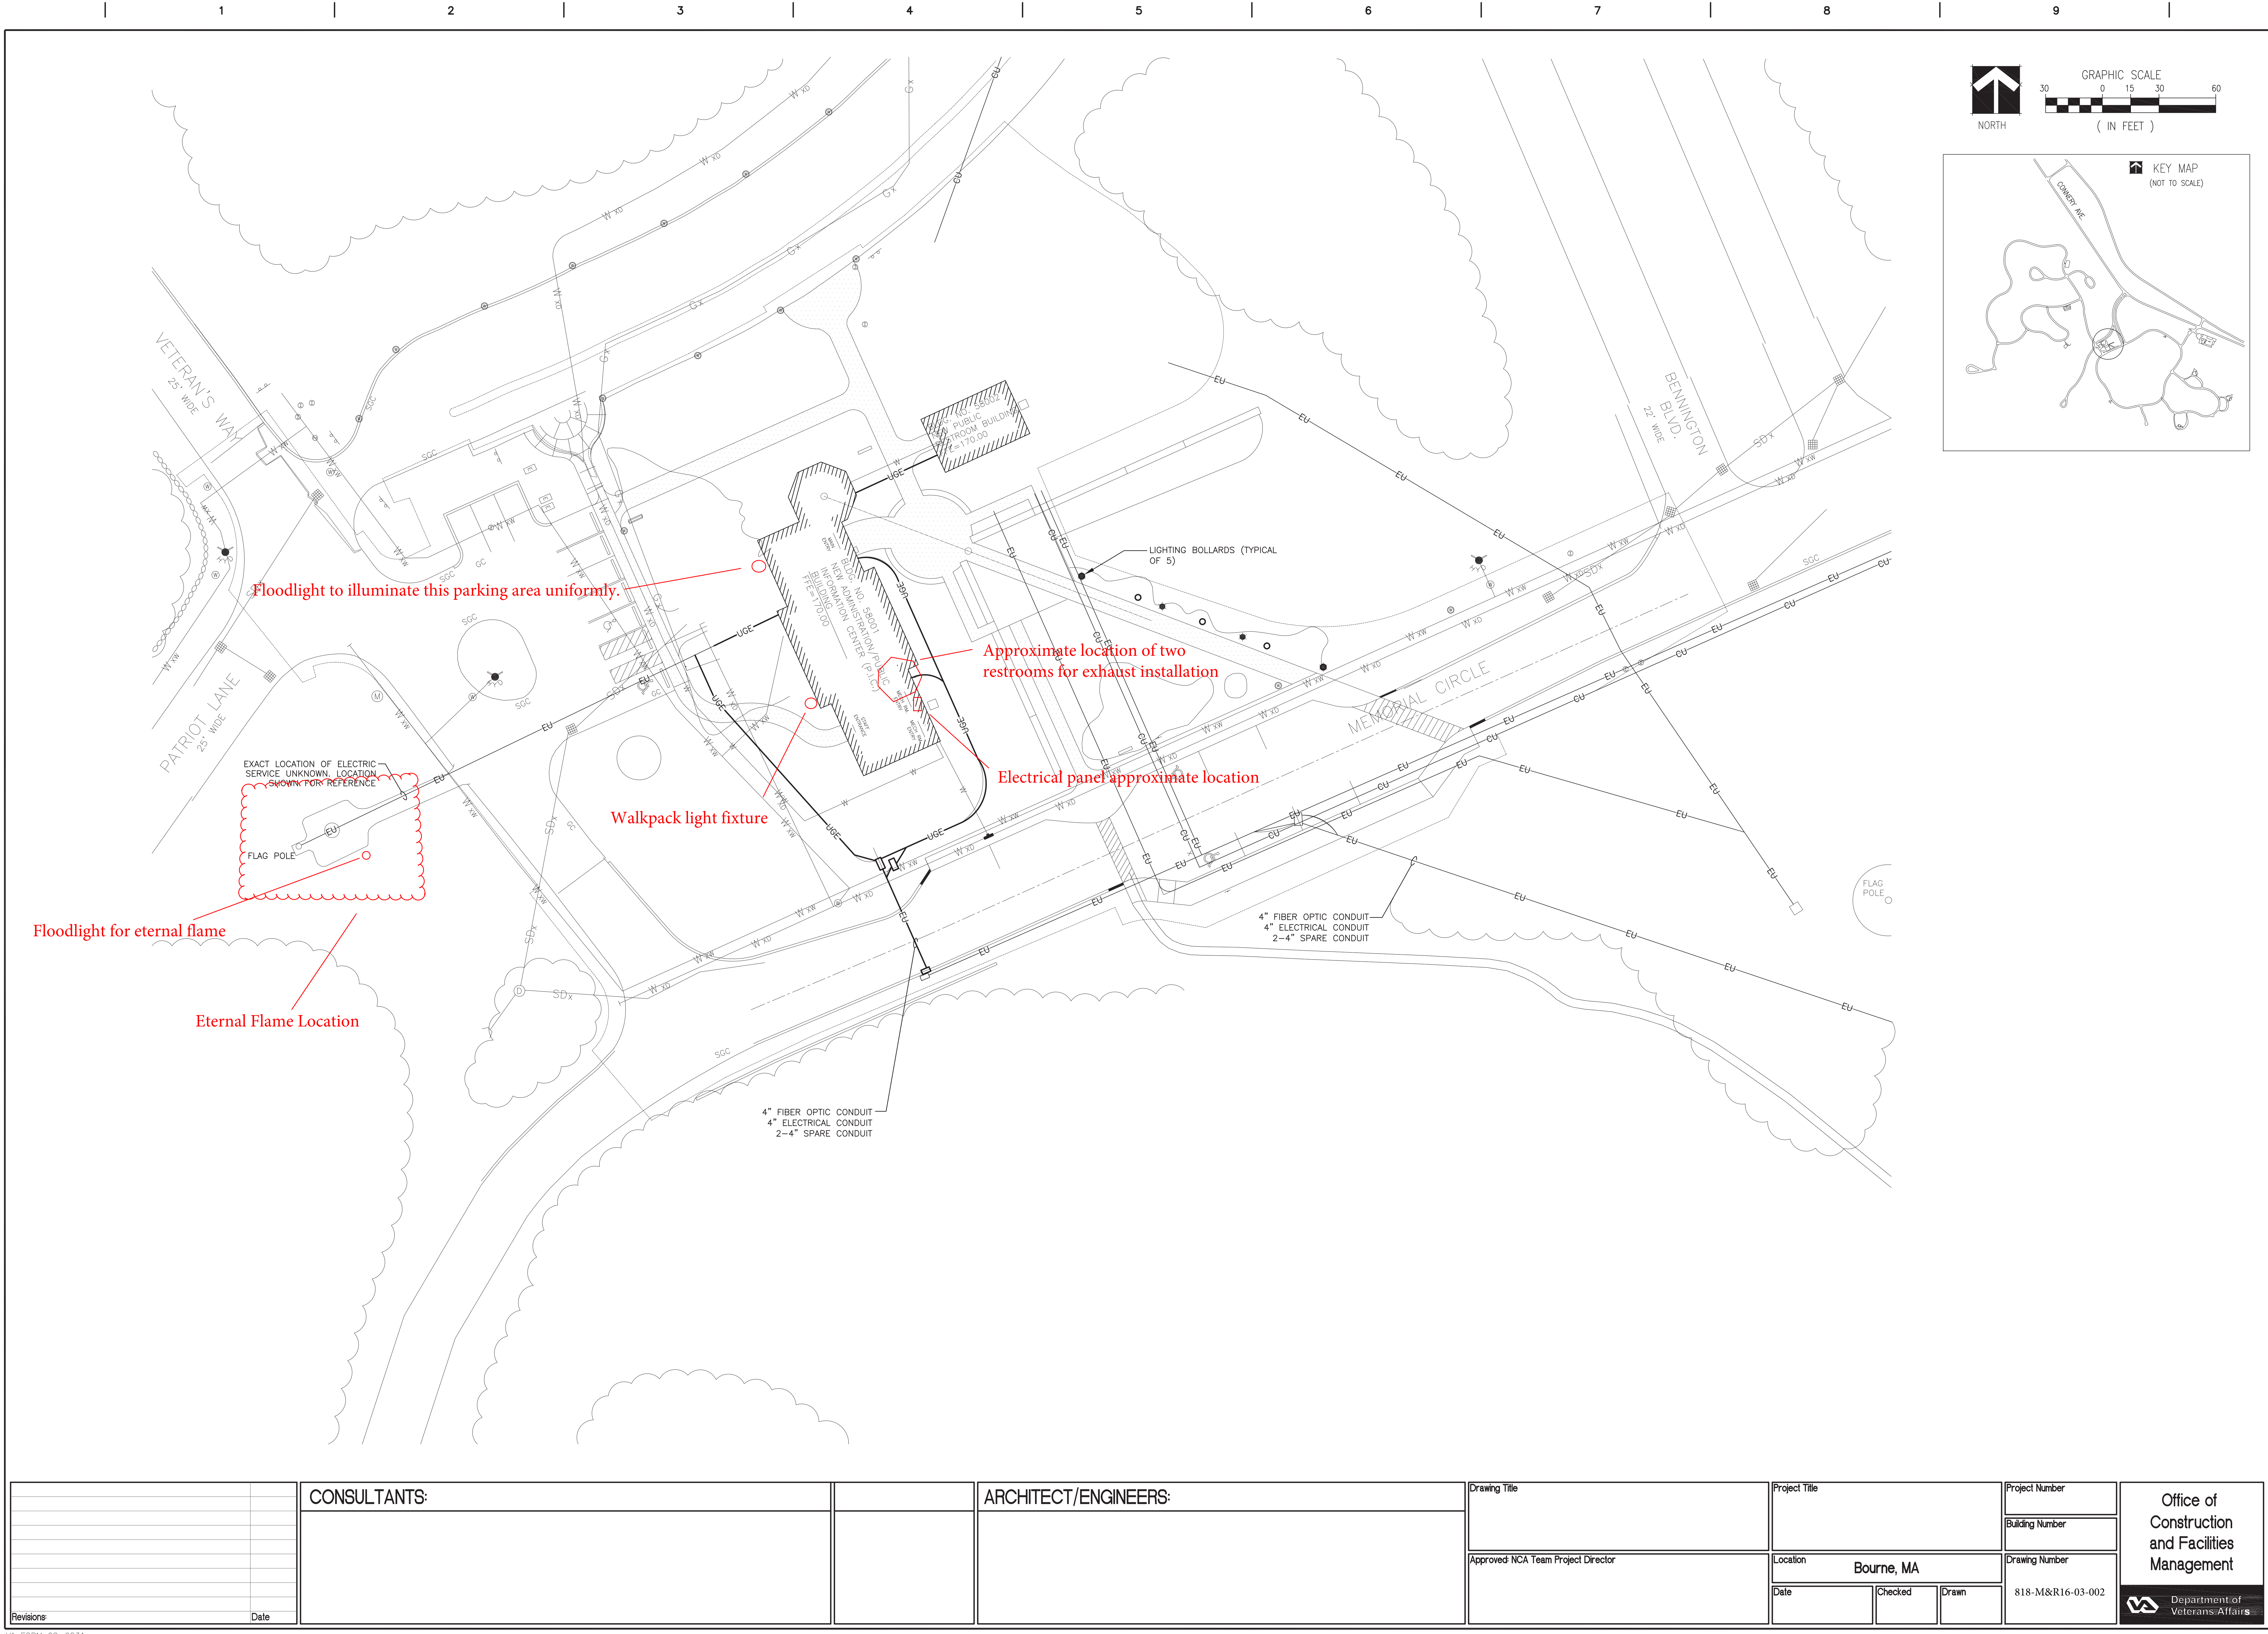


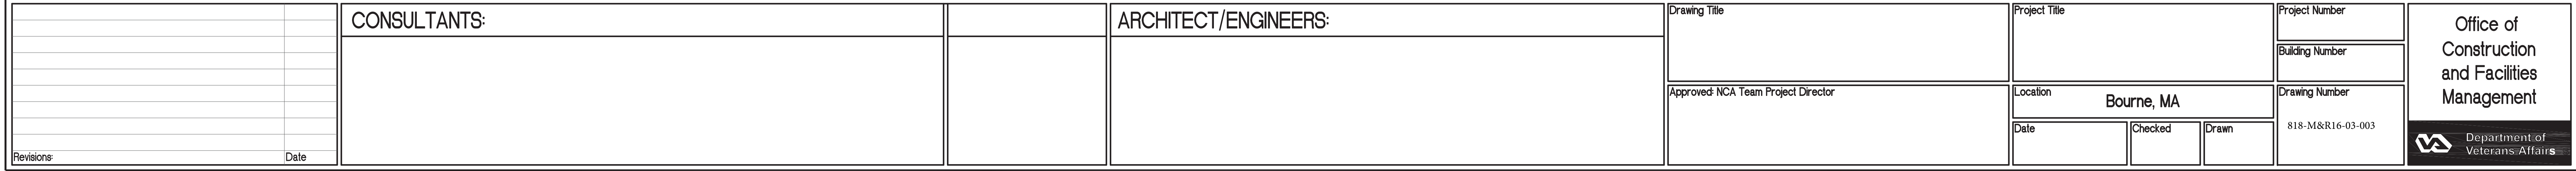

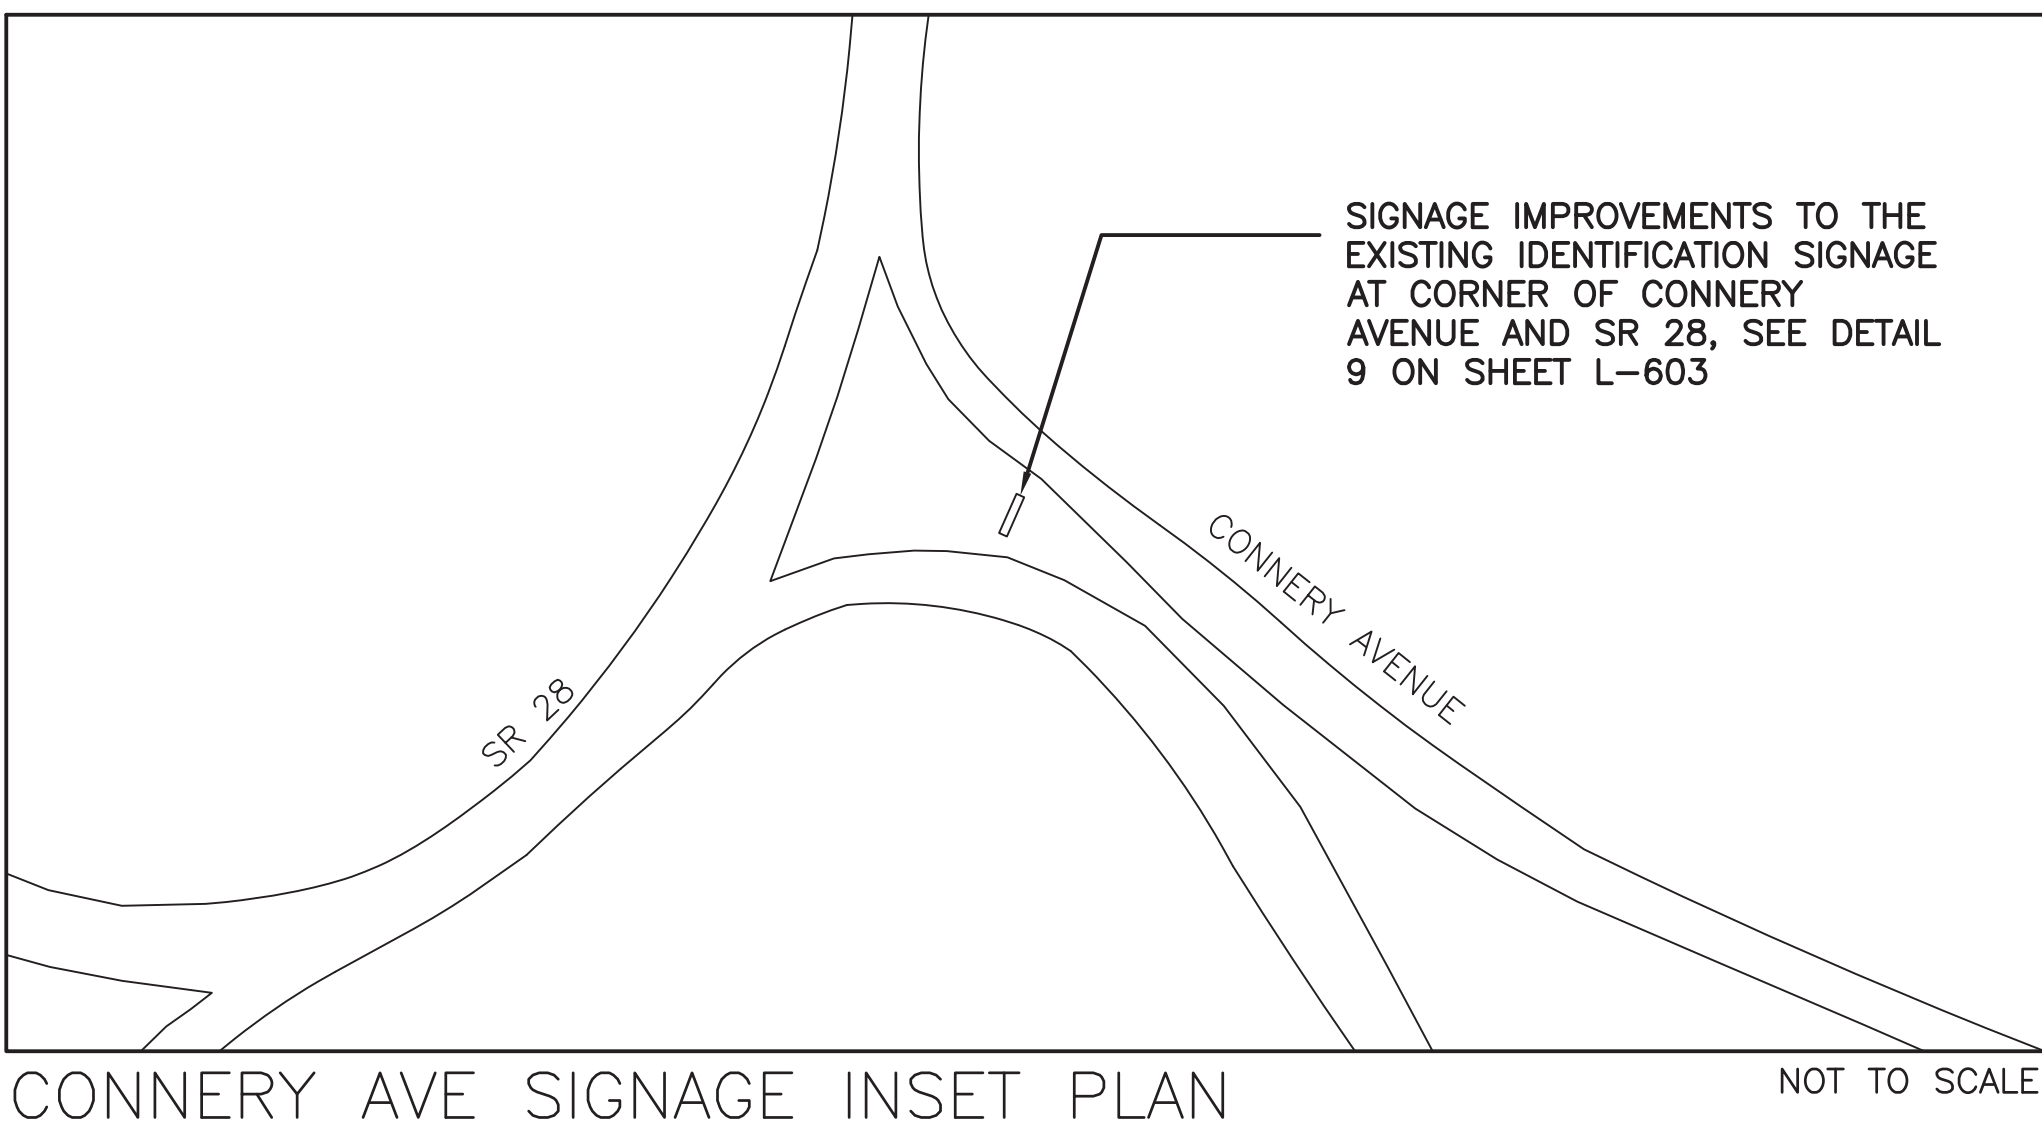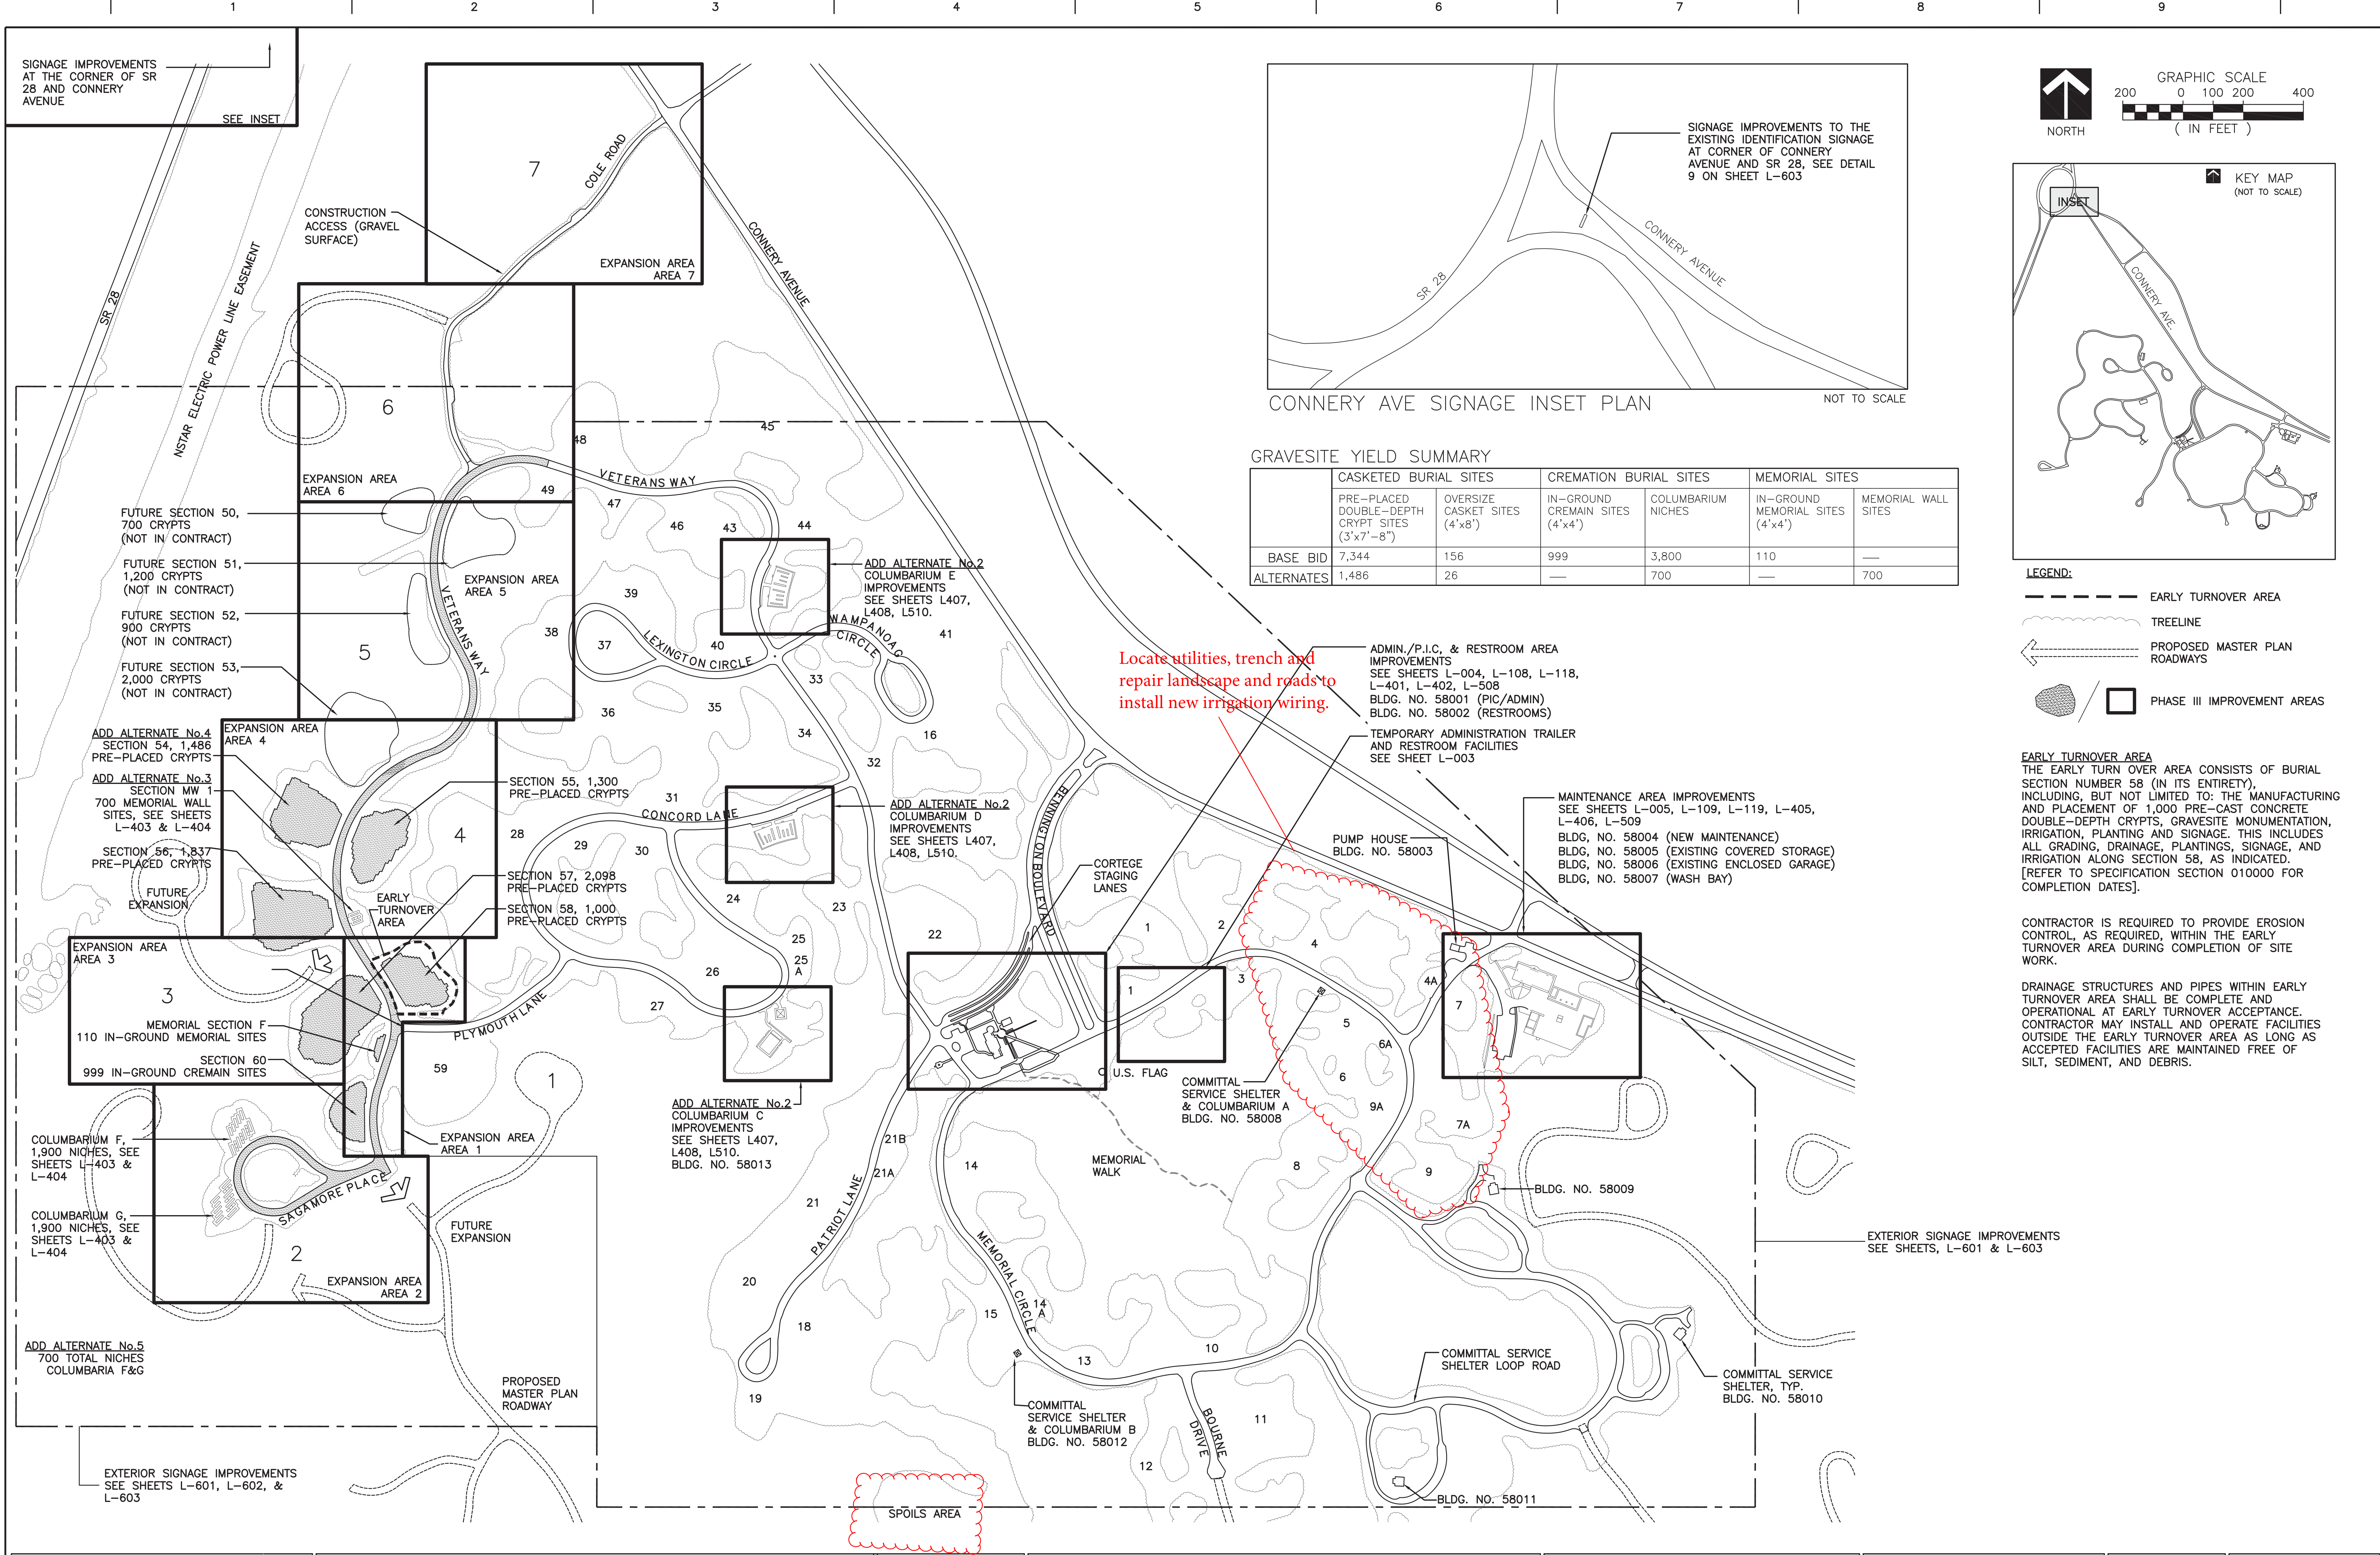

GRAVESITE YIELD SUMMARY

	CASKETED BURIAL SITES	CREMATION BURIAL SITES	MEMORIAL SITES
	PRE-PLACED DOUBLE-DEPTH CRYPT SITES (3'x7'-8")	OVERSIZE CASKET SITES (4'x8')	IN-GROUND CREMAIN SITES (4'x4')
BASE BID	7,344	156	999
ALTERNATES	1,486	26	700

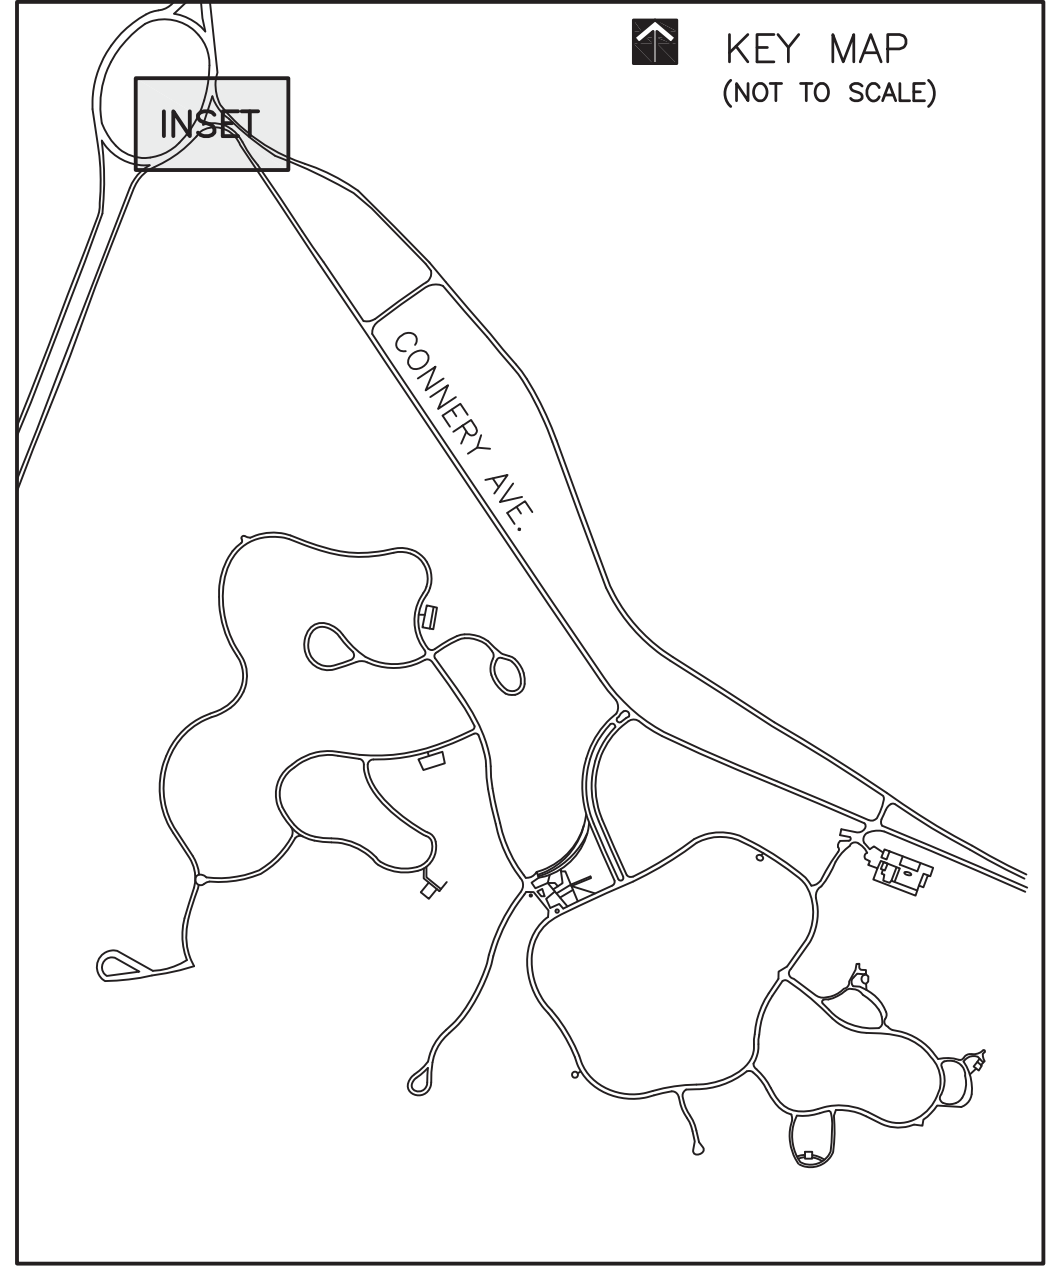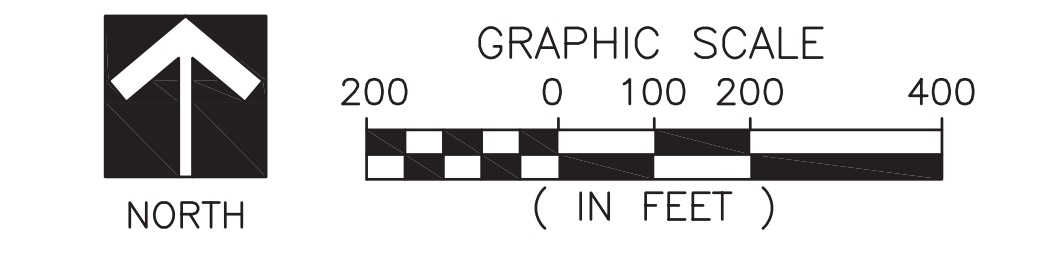

- LEGEND:
- EARLY TURNOVER AREA
 - TREELINE
 - PROPOSED MASTER PLAN ROADWAYS
 - PHASE III IMPROVEMENT AREAS

EARLY TURNOVER AREA
THE EARLY TURN OVER AREA CONSISTS OF BURIAL SECTION NUMBER 58 (IN ITS ENTIRETY), INCLUDING, BUT NOT LIMITED TO: THE MANUFACTURING AND PLACEMENT OF 1,000 PRE-CAST CONCRETE DOUBLE-DEPTH CRYPTS, GRAVESITE MONUMENTATION, IRRIGATION, PLANTING AND SIGNAGE. THIS INCLUDES ALL GRADING, DRAINAGE, PLANTINGS, SIGNAGE, AND IRRIGATION ALONG SECTION 58, AS INDICATED. [REFER TO SPECIFICATION SECTION 010000 FOR COMPLETION DATES].

CONTRACTOR IS REQUIRED TO PROVIDE EROSION CONTROL, AS REQUIRED, WITHIN THE EARLY TURNOVER AREA DURING COMPLETION OF SITE WORK.



DRAINAGE STRUCTURES AND PIPES WITHIN EARLY TURNOVER AREA SHALL BE COMPLETE AND OPERATIONAL AT EARLY TURNOVER ACCEPTANCE. CONTRACTOR MAY INSTALL AND OPERATE FACILITIES OUTSIDE THE EARLY TURNOVER AREA AS LONG AS ACCEPTED FACILITIES ARE MAINTAINED FREE OF SILT, SEDIMENT, AND DEBRIS.

<div>Revisions</div> <table><tr><td> </td><td> </td></tr><tr><td> </td><td> </td></tr><tr><td> </td><td> </td></tr><tr><td> </td><td> </td></tr></table>									CONSULTANTS:	ARCHITECT/ENGINEERS:	Drawing Title	Project Title	Project Number
			Approved: NCA Team Project Director	Location: Bourne, MA	Building Number								
				Date	Checked								
					Drawn								
					Drawing Number								
					818-M&R16-03-004								

Office of Construction and Facilities Management
Department of Veterans Affairs



Detail 1: Remove existing electrical box covers and turn over to VA. Install new covers per specifications.

				 <div>N ATIONAL C EMETERY A DMINISTRATION</div>	Drawing Title		Project Title		Project Number		<div>Office of Facilities Management</div> <div> Department of Veterans Affairs</div>
					Approved: Project Director		Location		Drawing Number		
					Date		Checked	Drawn	818-M&R16-03-005		



THE BURIAL SECTION LAYOUT AND THE OCCUPANCY SHOWN ON THIS PLAN ARE TAKEN FROM PLANS COLLECTED AT THE MEN'S SUPERVISORY CEMETERIES IN JULY 2015. THIS INFORMATION HAS NOT BEEN FIELD VERIFIED BY AMEC ENVIRONMENT & INFRASTRUCTURE INC.

Revisions

Date

SYMBOL LEGEND

0000	AVAILABLE GRAVESITE W/NUMBER
0000	RESERVED GRAVESITE W/NUMBER
0000	OCCUPIED GRAVESITE W/NUMBER
0000	FULLY OBSTRUCTED GRAVESITE W/NUMBER
0000	OCCUPIED PARTIALLY OBSTRUCTED GRAVESITE W/NUMBER
0000	AVAILABLE PARTIALLY OBSTRUCTED GRAVESITE W/NUMBER (FULL CASKET SITE AVAILABLE FOR CREMAINS ONLY)
0000	ROW GRAVESITE NUMBER

BLDG	EXISTING STRUCTURE WITH CLASSIFICATION NUMBER
BLDG	HEADSTONES IN THE HIGHLIGHTED BURIAL SECTION FACE IN THE DIRECTION OF THE ARROW
BLDG	PAVED ROAD W/CURB & GUTTER (C & G SHOWN BOTH SIDES)
BLDG	UNIMPROVED DIRT/GRAVEL ROAD


BLDG	CONTROL MARKER
BLDG	EXISTING STRUCTURE WITH CLASSIFICATION NUMBER
BLDG	HEADSTONES IN THE HIGHLIGHTED BURIAL SECTION FACE IN THE DIRECTION OF THE ARROW
BLDG	PAVED ROAD W/CURB & GUTTER (C & G SHOWN BOTH SIDES)
BLDG	UNIMPROVED DIRT/GRAVEL ROAD

BLDG	METAL PICKET FENCE
BLDG	CHAIN LINK FABRIC FENCE
BLDG	PROPERTY BOUNDARY LINE
BLDG	OVERHEAD ELECTRIC LINE AND POWER POLE
BLDG	UNDERGROUND ELECTRIC LINE
BLDG	SANITARY SEWER LINE
BLDG	STORM DRAIN LINE
BLDG	IRRIGATION LINE
BLDG	WATER LINE

DRAWING NOTES

- SHADING SHOWN IN A GRAVESITE INDICATES OCCUPIED STATUS, SUPERSEDING ANY OTHER MARKING THEREIN.
- GRAVESITE STATUS HAS BEEN POSTED ON THIS LAYOUT PLAN THROUGH 1/13/2015
- DRAWING SCALE IS ACCURATE ONLY ON FULL-SIZE (30-INCH HIGH BY 42-INCH WIDE) COPIES OF THIS DRAWING.

KEYMAP

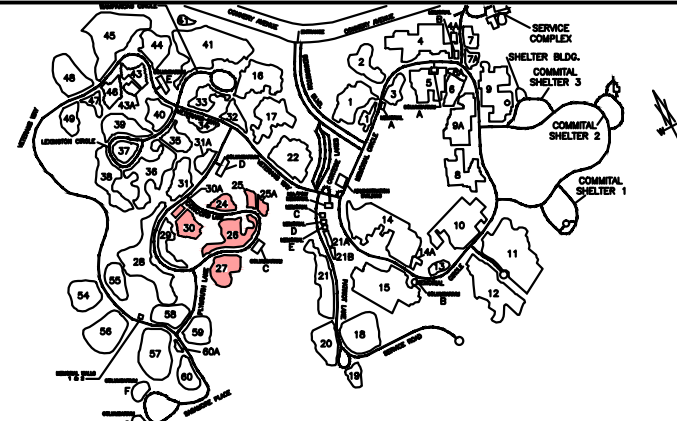

Drawing Title

Approved: Division Chief

Approved: Service Director

Project Title

Building No.

Checked

Drawn


Location
Bourne, MA

Date

Project No.

DRAWING NO.
818-M&R16-03-006

Veterans
Administration

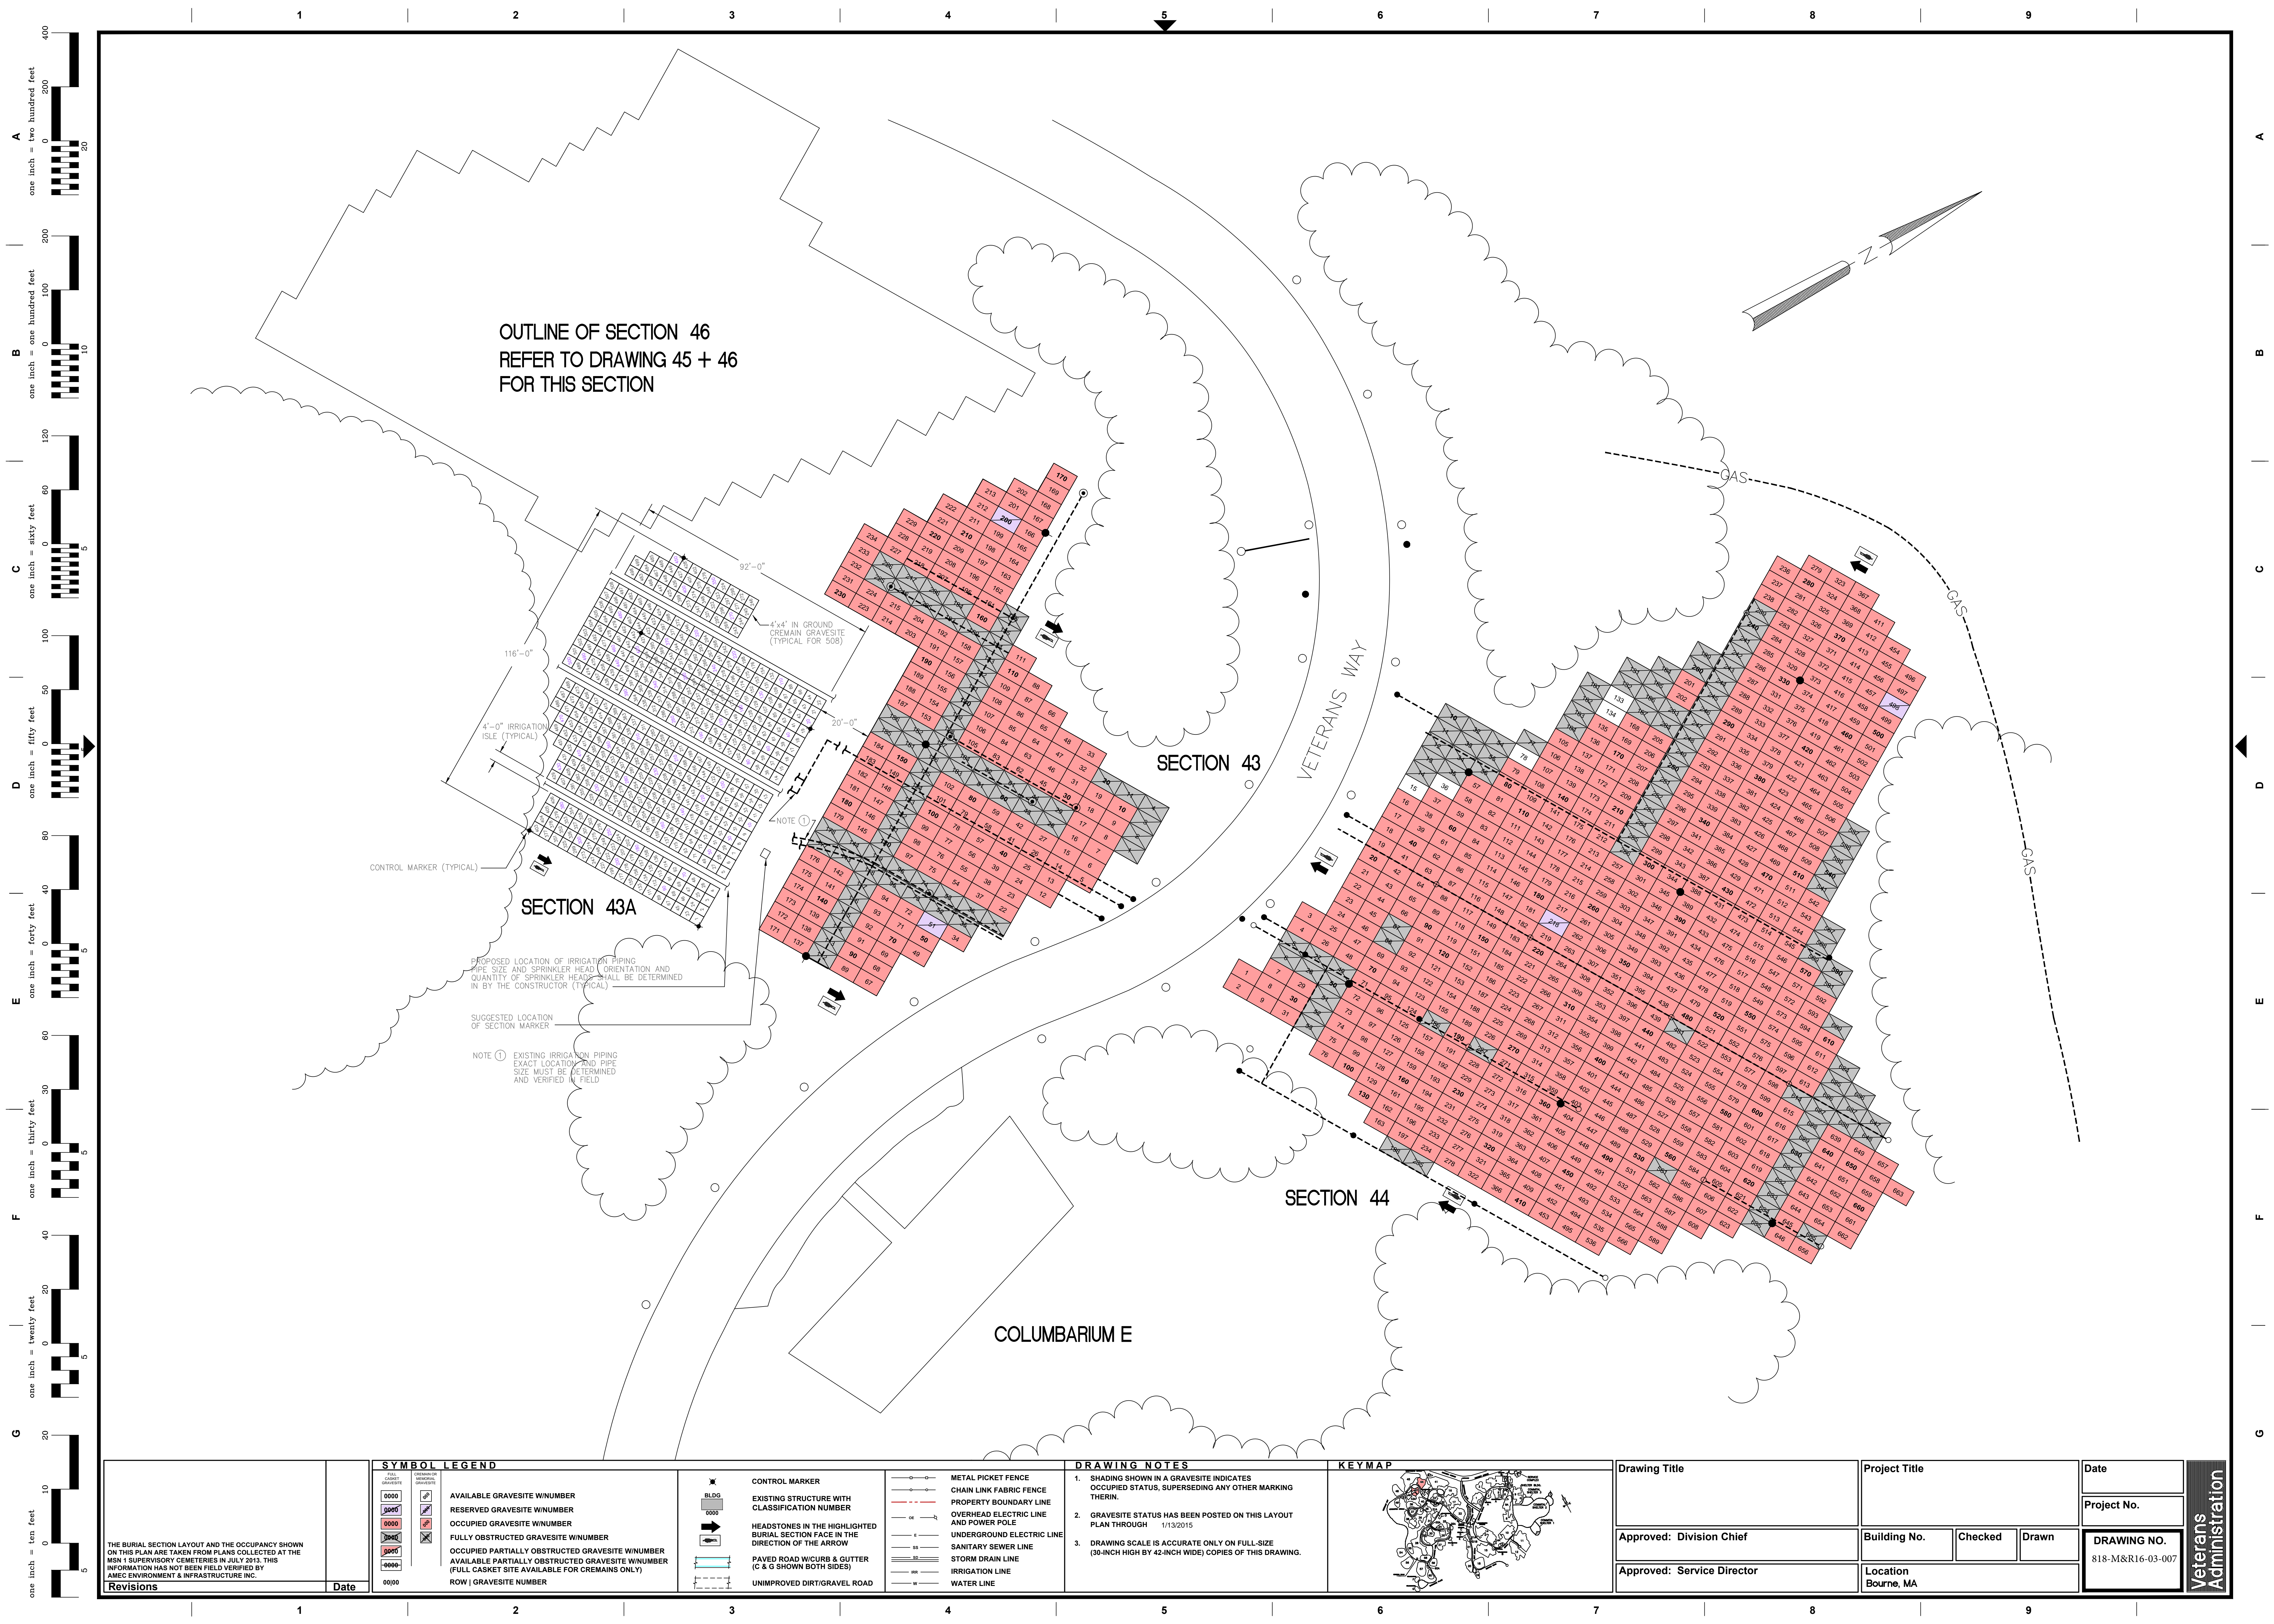

OUTLINE OF SECTION 46
REFER TO DRAWING 45 + 46
FOR THIS SECTION

SECTION 43

SECTION 43A

SECTION 44

COLUMBARIUM E

VETERANS WAY

GAS

GAS

GAS

SYMBOL LEGEND

	AVAILABLE GRAVESITE W/NUMBER
	RESERVED GRAVESITE W/NUMBER
	OCCUPIED GRAVESITE W/NUMBER
	FULLY OBSTRUCTED GRAVESITE W/NUMBER
	OCCUPIED PARTIALLY OBSTRUCTED GRAVESITE W/NUMBER
	AVAILABLE PARTIALLY OBSTRUCTED GRAVESITE W/NUMBER (FULL CASKET SITE AVAILABLE FOR CREMAINS ONLY)
	ROW J GRAVESITE NUMBER


	CONTROL MARKER
	EXISTING STRUCTURE WITH CLASSIFICATION NUMBER
	HEADSTONES IN THE HIGHLIGHTED BURIAL SECTION FACE IN THE DIRECTION OF THE ARROW
	PAVED ROAD W/CURB & GUTTER (C & G SHOWN BOTH SIDES)
	UNIMPROVED DIRT/GRAVEL ROAD

	METAL PICKET FENCE
	CHAIN LINK FABRIC FENCE
	PROPERTY BOUNDARY LINE
	OVERHEAD ELECTRIC LINE AND POWER POLE
	UNDERGROUND ELECTRIC LINE
	SANITARY SEWER LINE
	STORM DRAIN LINE
	IRRIGATION LINE
	WATER LINE

DRAWING NOTES

- SHADING SHOWN IN A GRAVESITE INDICATES OCCUPIED STATUS, SUPERSADING ANY OTHER MARKING THEREIN.
- GRAVESITE STATUS HAS BEEN POSTED ON THIS LAYOUT PLAN THROUGH 1/13/2015
- DRAWING SCALE IS ACCURATE ONLY ON FULL-SIZE (30-INCH HIGH BY 42-INCH WIDE) COPIES OF THIS DRAWING.

KEYMAP

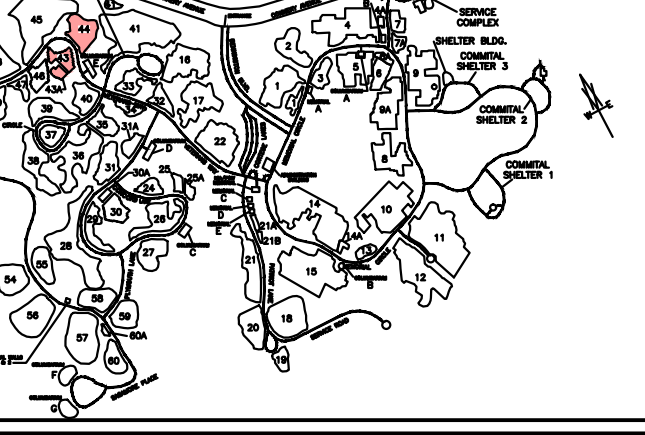

Drawing Title	Project Title	Date
Approved: Division Chief	Building No.	Project No.
Approved: Service Director	Checked	Drawn
	Location	DRAWING NO.
	Bourne, MA	818-M&R16-03-007

Veterans Administration