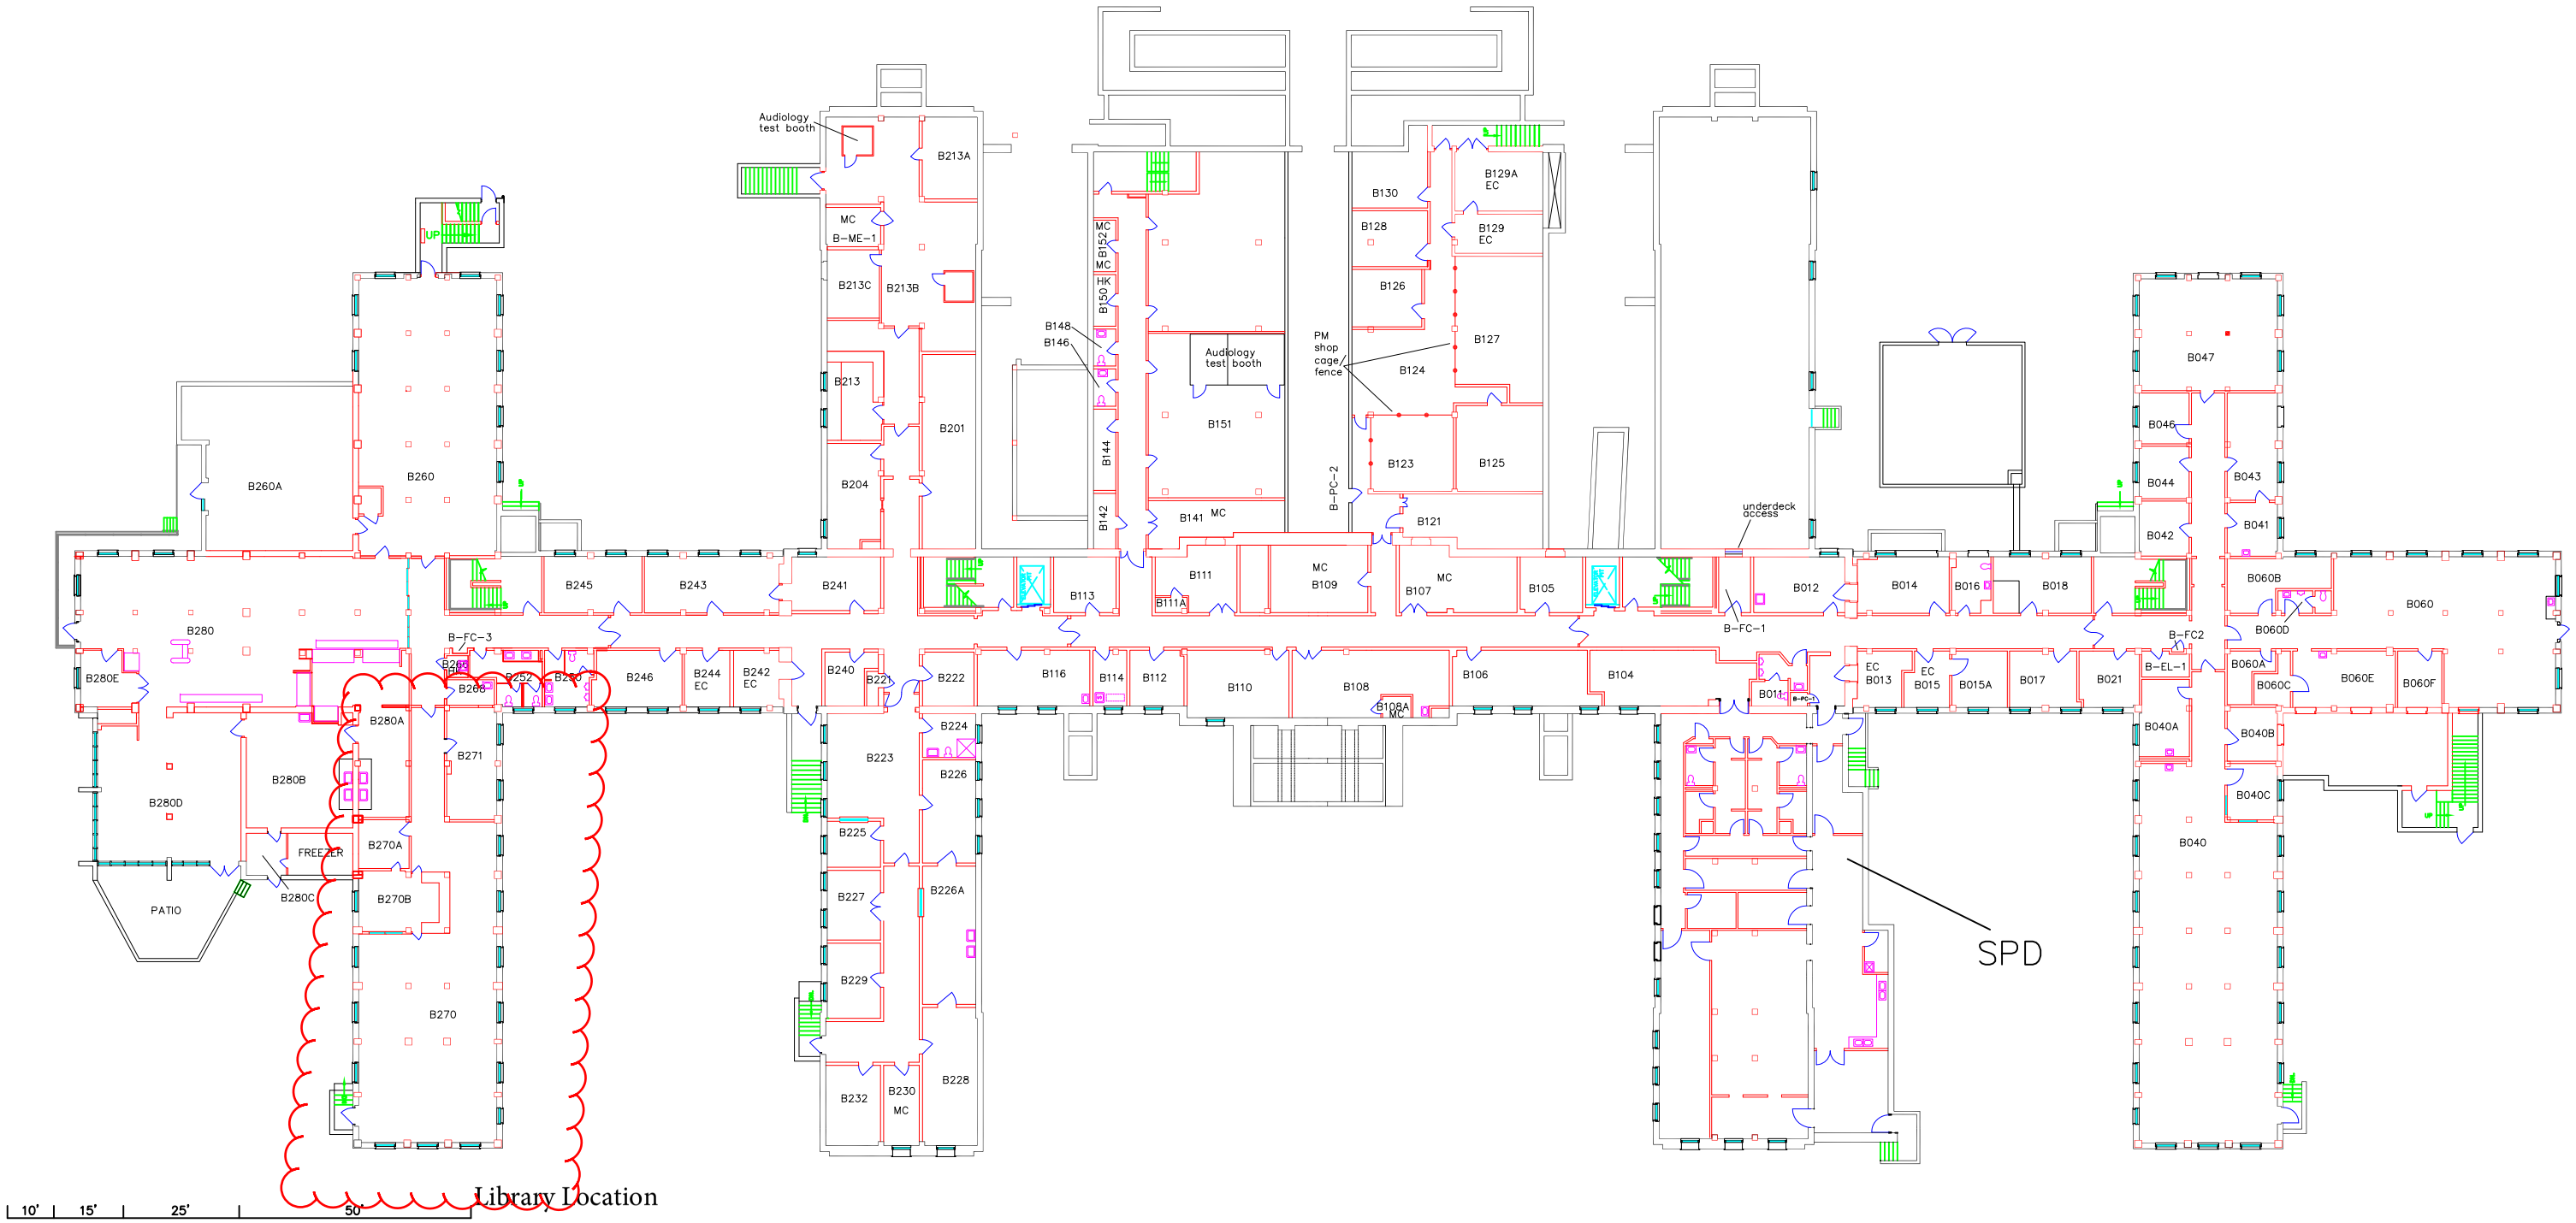

Revisions	Date

Professional Seal

Drawing Title	Project Title	Date
BASEMENT FLOOR	TREATMENT, WARD AND ADMINISTRATION	01/2013
Approved: Project Manager	Drawing No. / Checked / Drawn GT	Project No.
Approved: Service Chief	Location VAMC, NORTHAMPTON MASS.	Building Number 1

VAMC, NORTHAMPTON

VA Department of Veterans Affairs