


2nd FLOOR ELECT. CLOSET
F.A. PANEL LOCATION

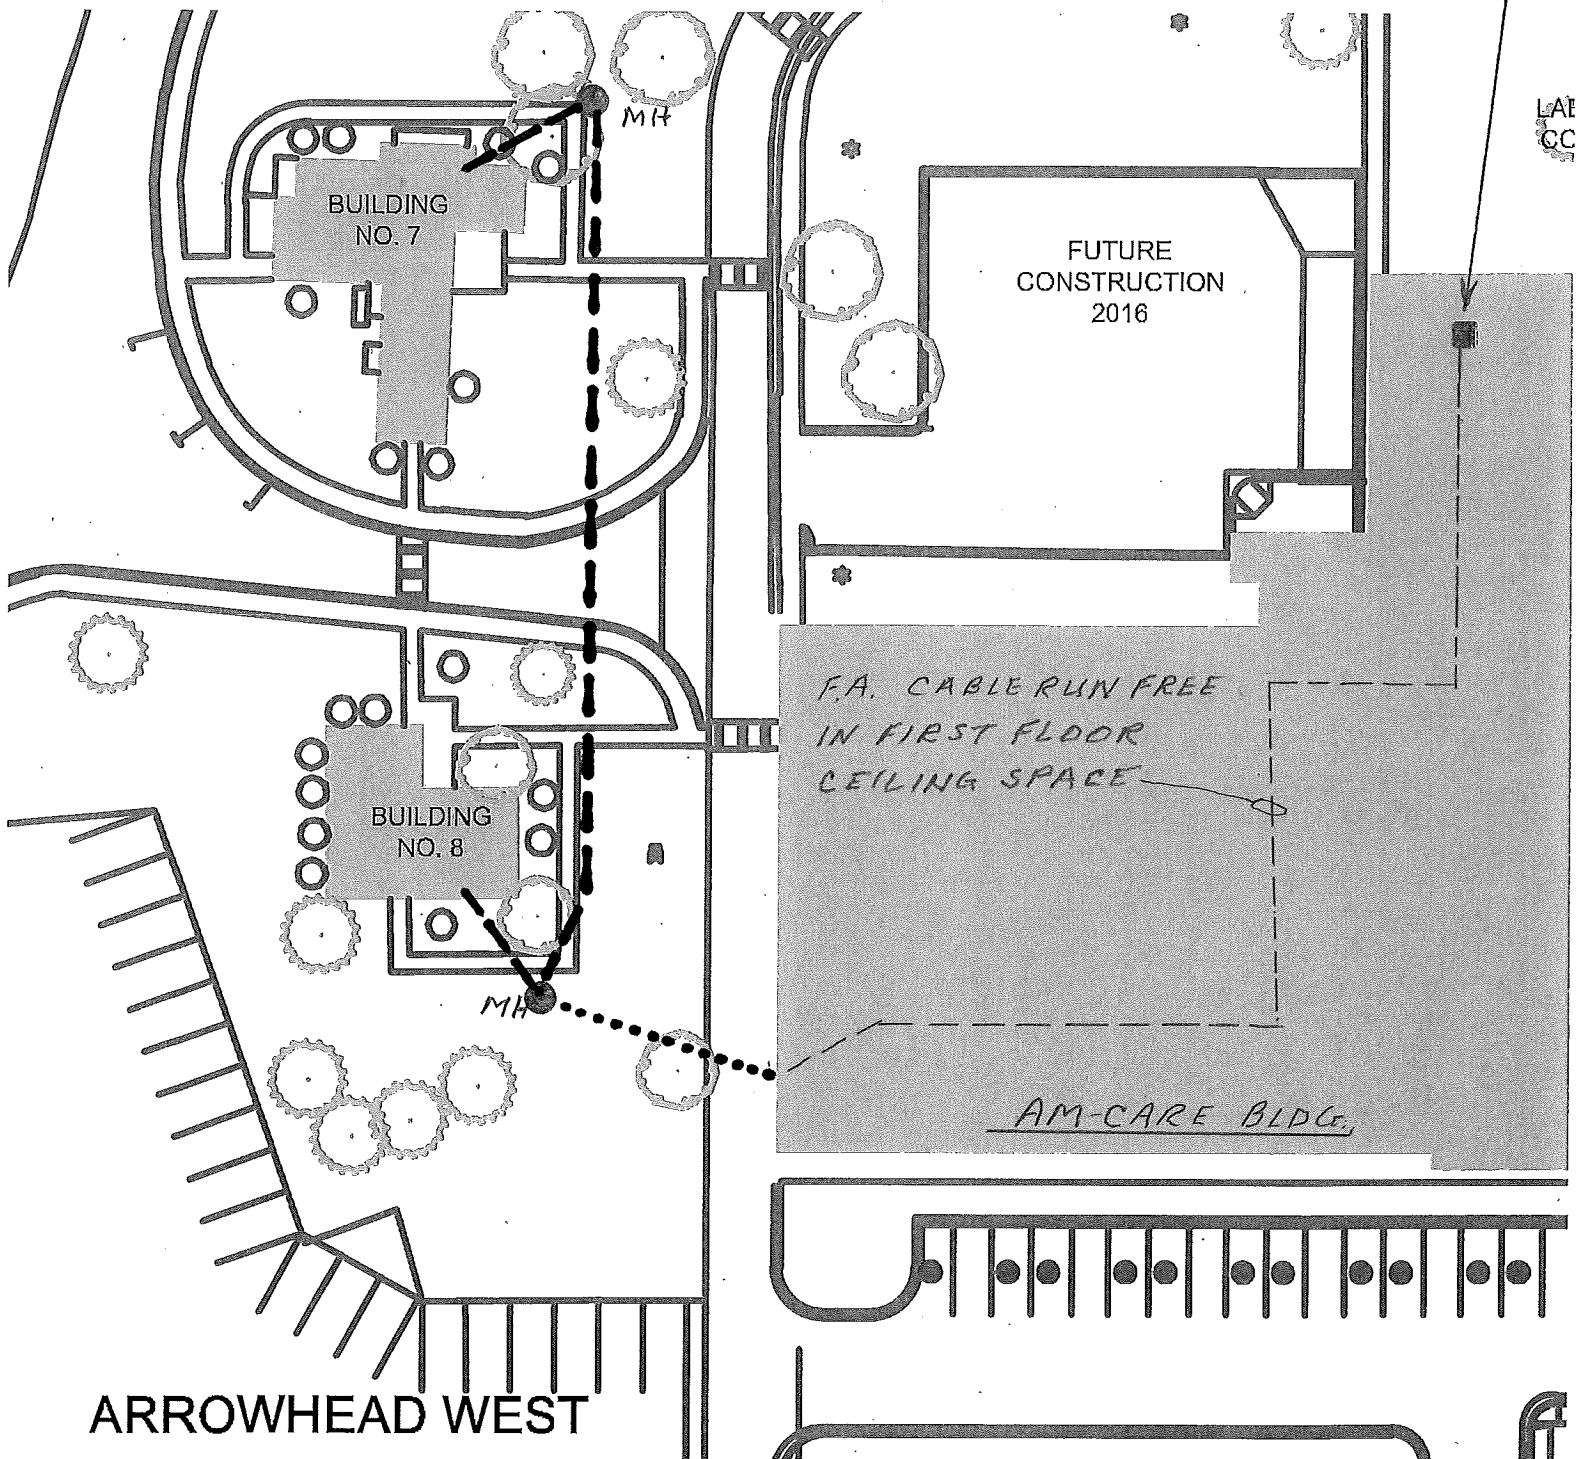

--- EXISTING CONDUIT

..... DIRECTIONAL U.G. BORE

● EXISTING MANHOLE