


- ⬡ DAMAGED AREA (SF)
- ⊗ SKY FACING JOINT (LF)
- ⬠ LIMESTONE SPALL REPAIR (SF)
- ▽ LIMESTONE CRACK (LF)
- ⊠ LINTEL (approx 42")
- ⬢ UNUSED ANCHORS

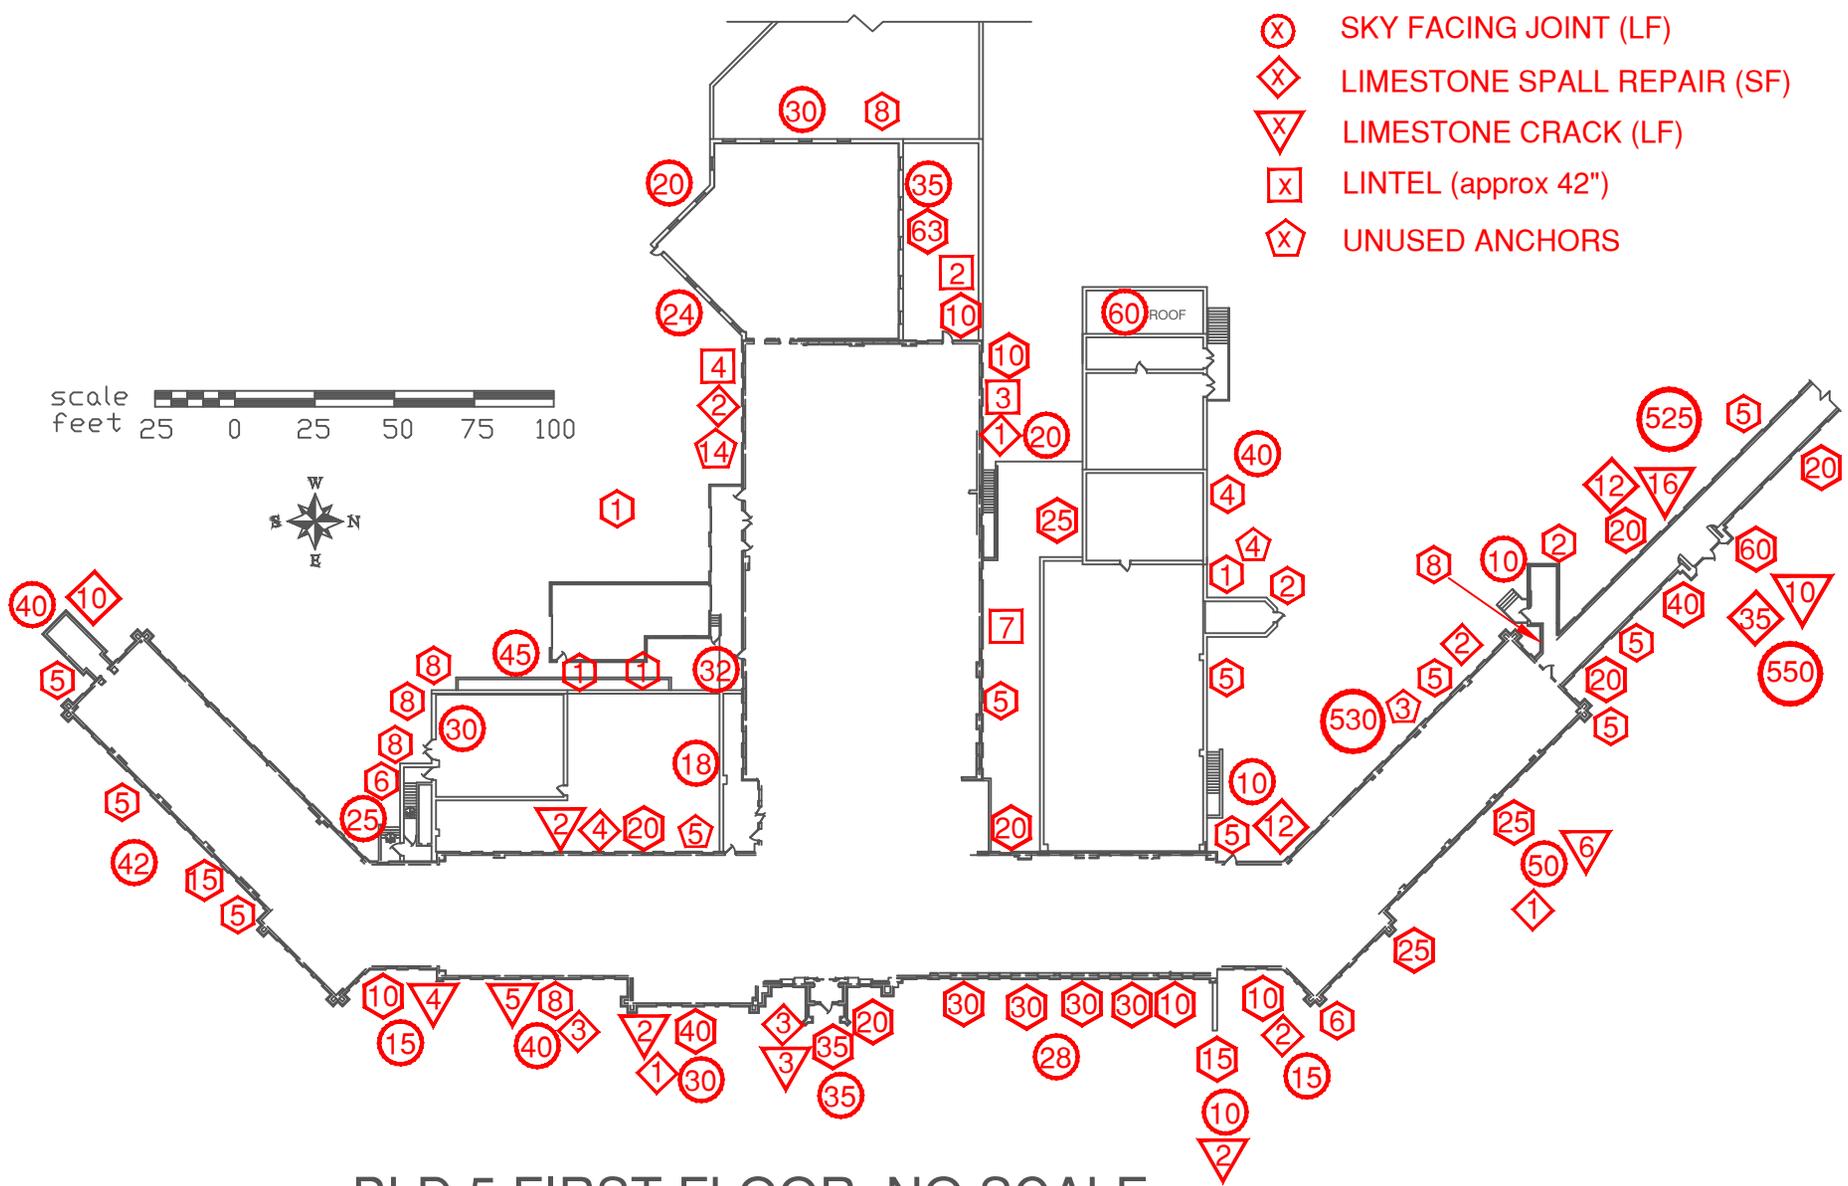

BLD 5 FIRST FLOOR NO SCALE
 APPROX. 32,115 SF TOTAL FACADE