


- ⊗ DAMAGED AREA (SF)
- ⊗ SKY FACING JOINT (LF)
- ⊗ LIMESTONE SPALL REPAIR (SF)
- ▽ LIMESTONE CRACK (LF)
- ⊗ LINTEL (approx 42")
- ⊗ UNUSED ANCHORS

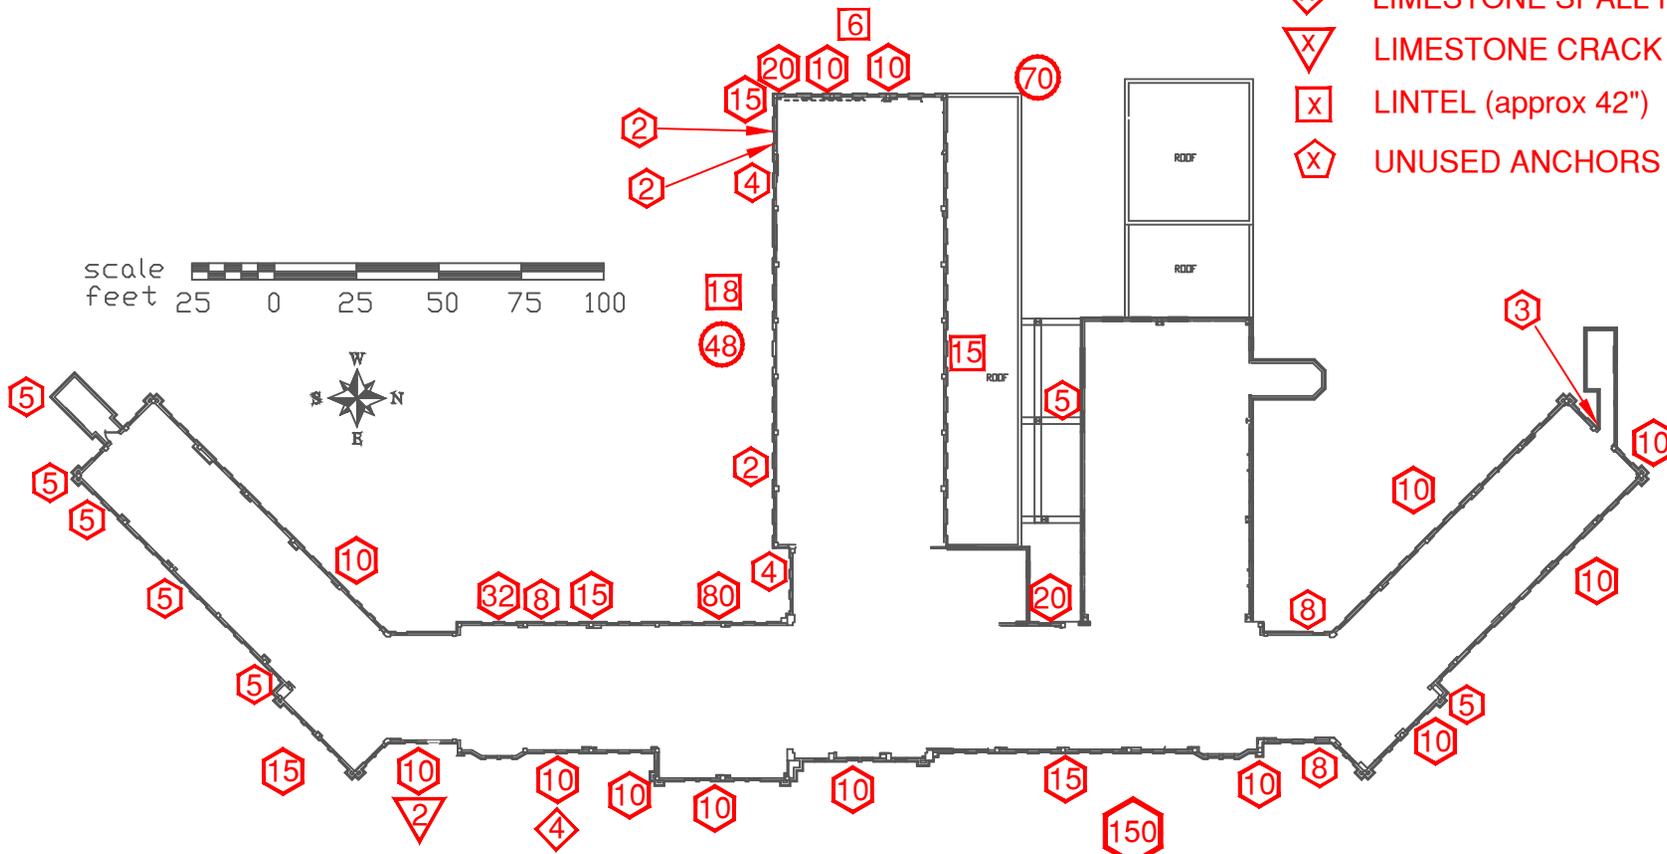

BLD 5 THIRD FLOOR NO SCALE
 APPROX. 21,015 SF TOTAL FACADE