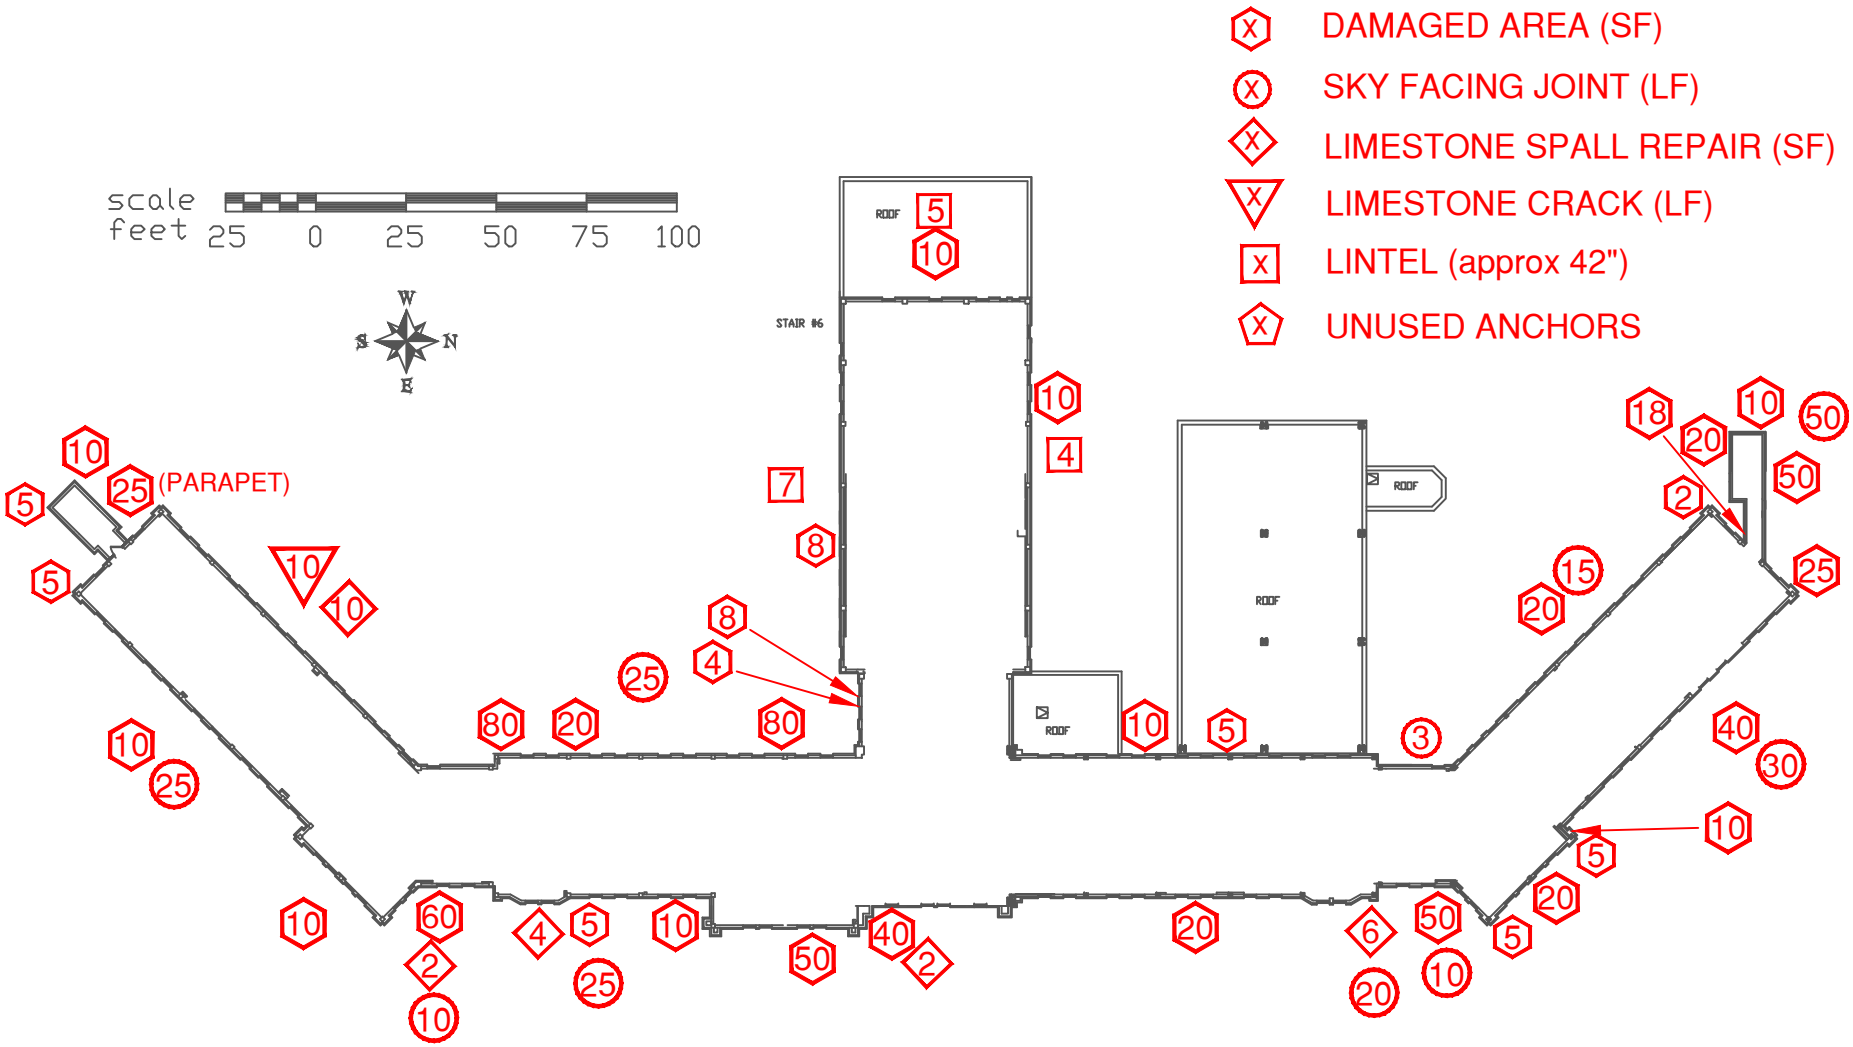

BLD 5 FOURTH FLOOR NO SCALE
APPROX. 18,785 SF TOTAL FACADE