

Revisions	Date
VARIOUS PROJECTS UPDATE	04-19-11
EP LAB ABATEMENT	01-28-13
OR, GI AND RETAIL STORE	05-29-15

Drawing Title

FIRE PROOFING  
SECOND FLOOR

Project Title

ASBESTOS

Approved: Project Section Chief

Approved: Division Chief

Approved: Facility Director

Location

JAMES A. HALEY VETERANS' HOSPITAL  
13000 BRUCE B. DOWNS BLVD.  
TAMPA, FLORIDA 33612

Drawn

MWK

Date

12/30/02

Checked

Project No.

Bldg #

1

DRAWING NO.


1HA133

File Number

Dwg. Of





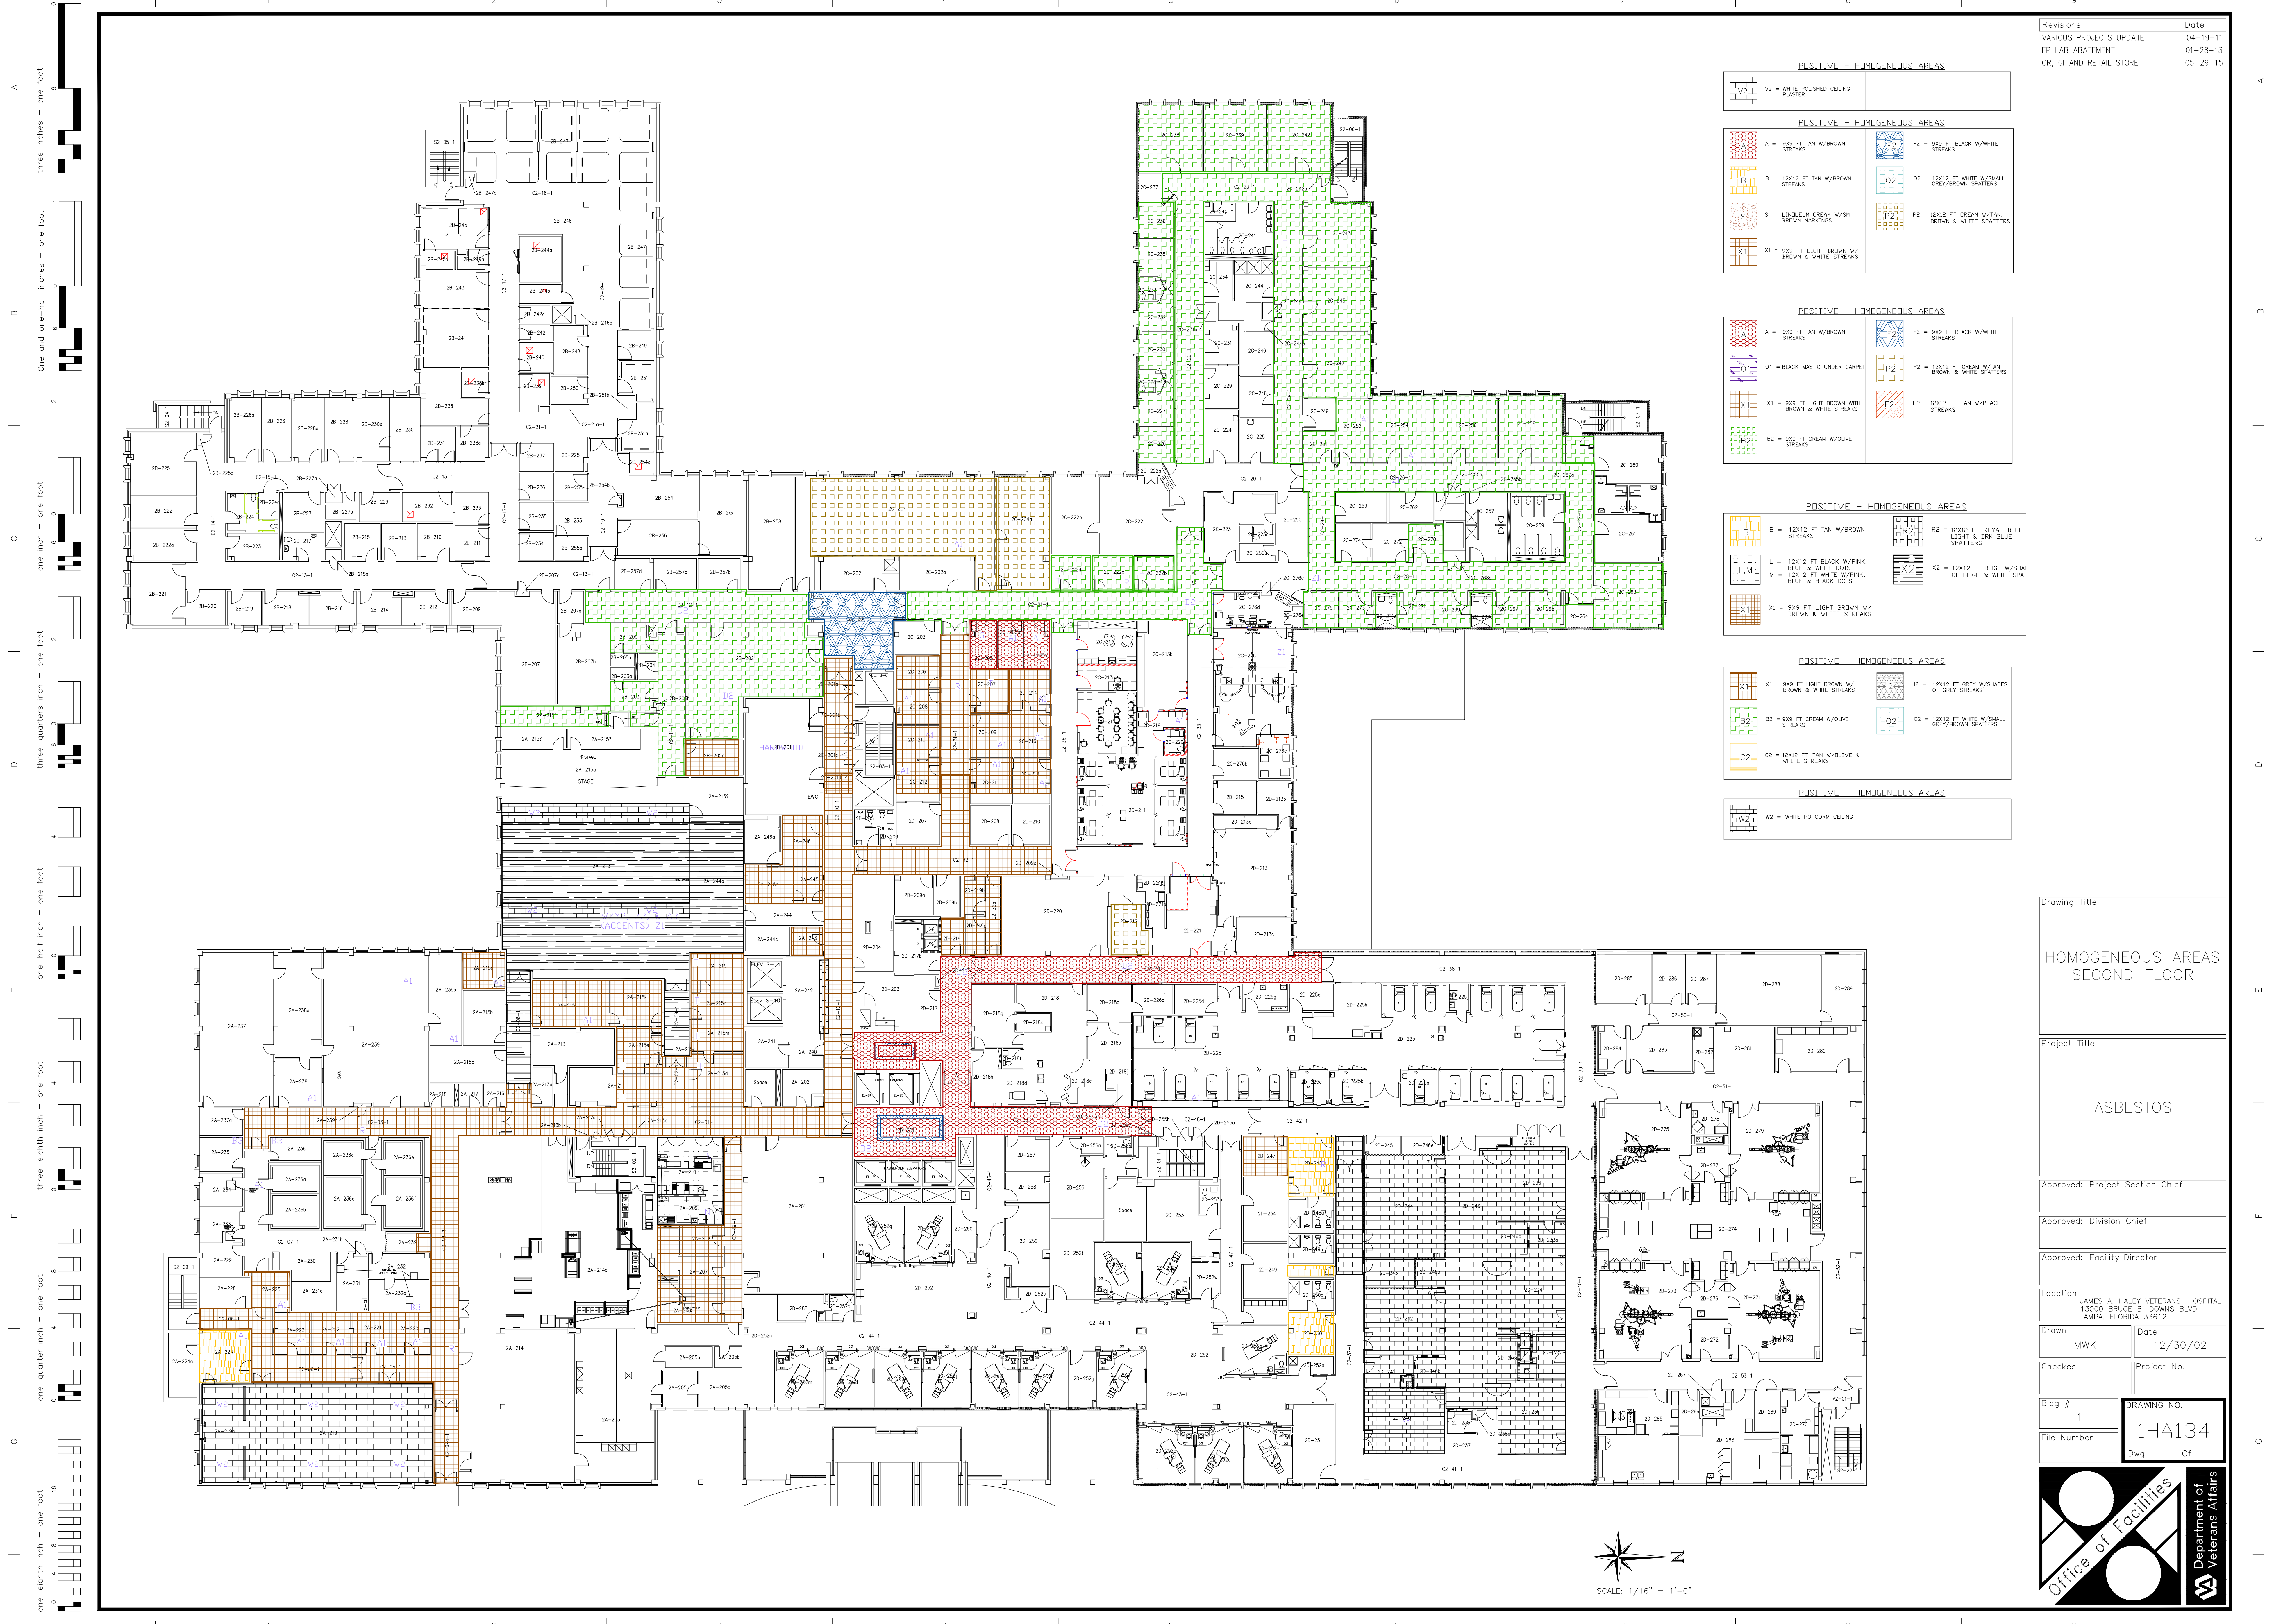

Revisions	Date
VARIOUS PROJECTS UPDATE	04-19-11
EP LAB ABATEMENT	01-28-13
OR, GI AND RETAIL STORE	05-29-15

POSITIVE - HOMOGENEOUS AREAS

V2 = WHITE POLISHED CEILING PLASTER

POSITIVE - HOMOGENEOUS AREAS

A = 9X9 FT TAN W/BROWN STREAKS

B = 12X12 FT TAN W/BROWN STREAKS

S = LINOLEUM CREAM W/SM BROWN MARKINGS

X1 = 9X9 FT LIGHT BROWN W/ BROWN & WHITE STREAKS

F2 = 9X9 FT BLACK W/WHITE STREAKS

O2 = 12X12 FT WHITE W/SMALL GREY/BROWN SPATTERS

P2 = 12X12 FT CREAM W/TAN, BROWN & WHITE SPATTERS

POSITIVE - HOMOGENEOUS AREAS

A = 9X9 FT TAN W/BROWN STREAKS

O1 = BLACK MASTIC UNDER CARPET

X1 = 9X9 FT LIGHT BROWN WITH BROWN & WHITE STREAKS

B2 = 9X9 FT CREAM W/OLIVE STREAKS

F2 = 9X9 FT BLACK W/WHITE STREAKS

P2 = 12X12 FT CREAM W/TAN, BROWN & WHITE SPATTERS

E2 = 12X12 FT TAN W/PEACH STREAKS

POSITIVE - HOMOGENEOUS AREAS

B = 12X12 FT TAN W/BROWN STREAKS

LM = 12X12 FT BLACK W/PINK, BLUE & WHITE DOTS

M = 12X12 FT WHITE W/PINK, BLUE & BLACK DOTS

X1 = 9X9 FT LIGHT BROWN W/ BROWN & WHITE STREAKS

R2 = 12X12 FT ROYAL BLUE LIGHT & DRK BLUE SPATTERS

X2 = 12X12 FT BEIGE W/SHAI OF BEIGE & WHITE SPAT

POSITIVE - HOMOGENEOUS AREAS

X1 = 9X9 FT LIGHT BROWN W/ BROWN & WHITE STREAKS

B2 = 9X9 FT CREAM W/OLIVE STREAKS

C2 = 12X12 FT TAN W/OLIVE & WHITE STREAKS

I2 = 12X12 FT GREY W/SHADES OF GREY STREAKS

O2 = 12X12 FT WHITE W/SMALL GREY/BROWN SPATTERS

POSITIVE - HOMOGENEOUS AREAS

W2 = WHITE POPCORN CEILING

Drawing Title

HOMOGENEOUS AREAS  
SECOND FLOOR

Project Title

ASBESTOS

Approved: Project Section Chief

Approved: Division Chief

Approved: Facility Director

Location

JAMES A. HALEY VETERANS' HOSPITAL  
13000 BRUCE B. DOWNS BLVD.  
TAMPA, FLORIDA 33612

Drawn

MWK

Date

12/30/02

Checked

Project No.


Blgd #

1

File Number


DRAWING NO.  
1HA134

Dwg. Of

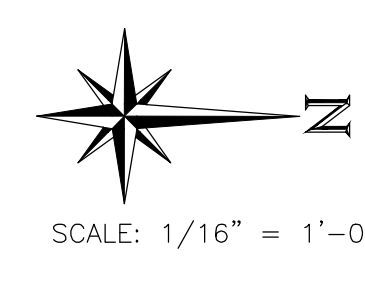

SCALE: 1/16" = 1'-0"



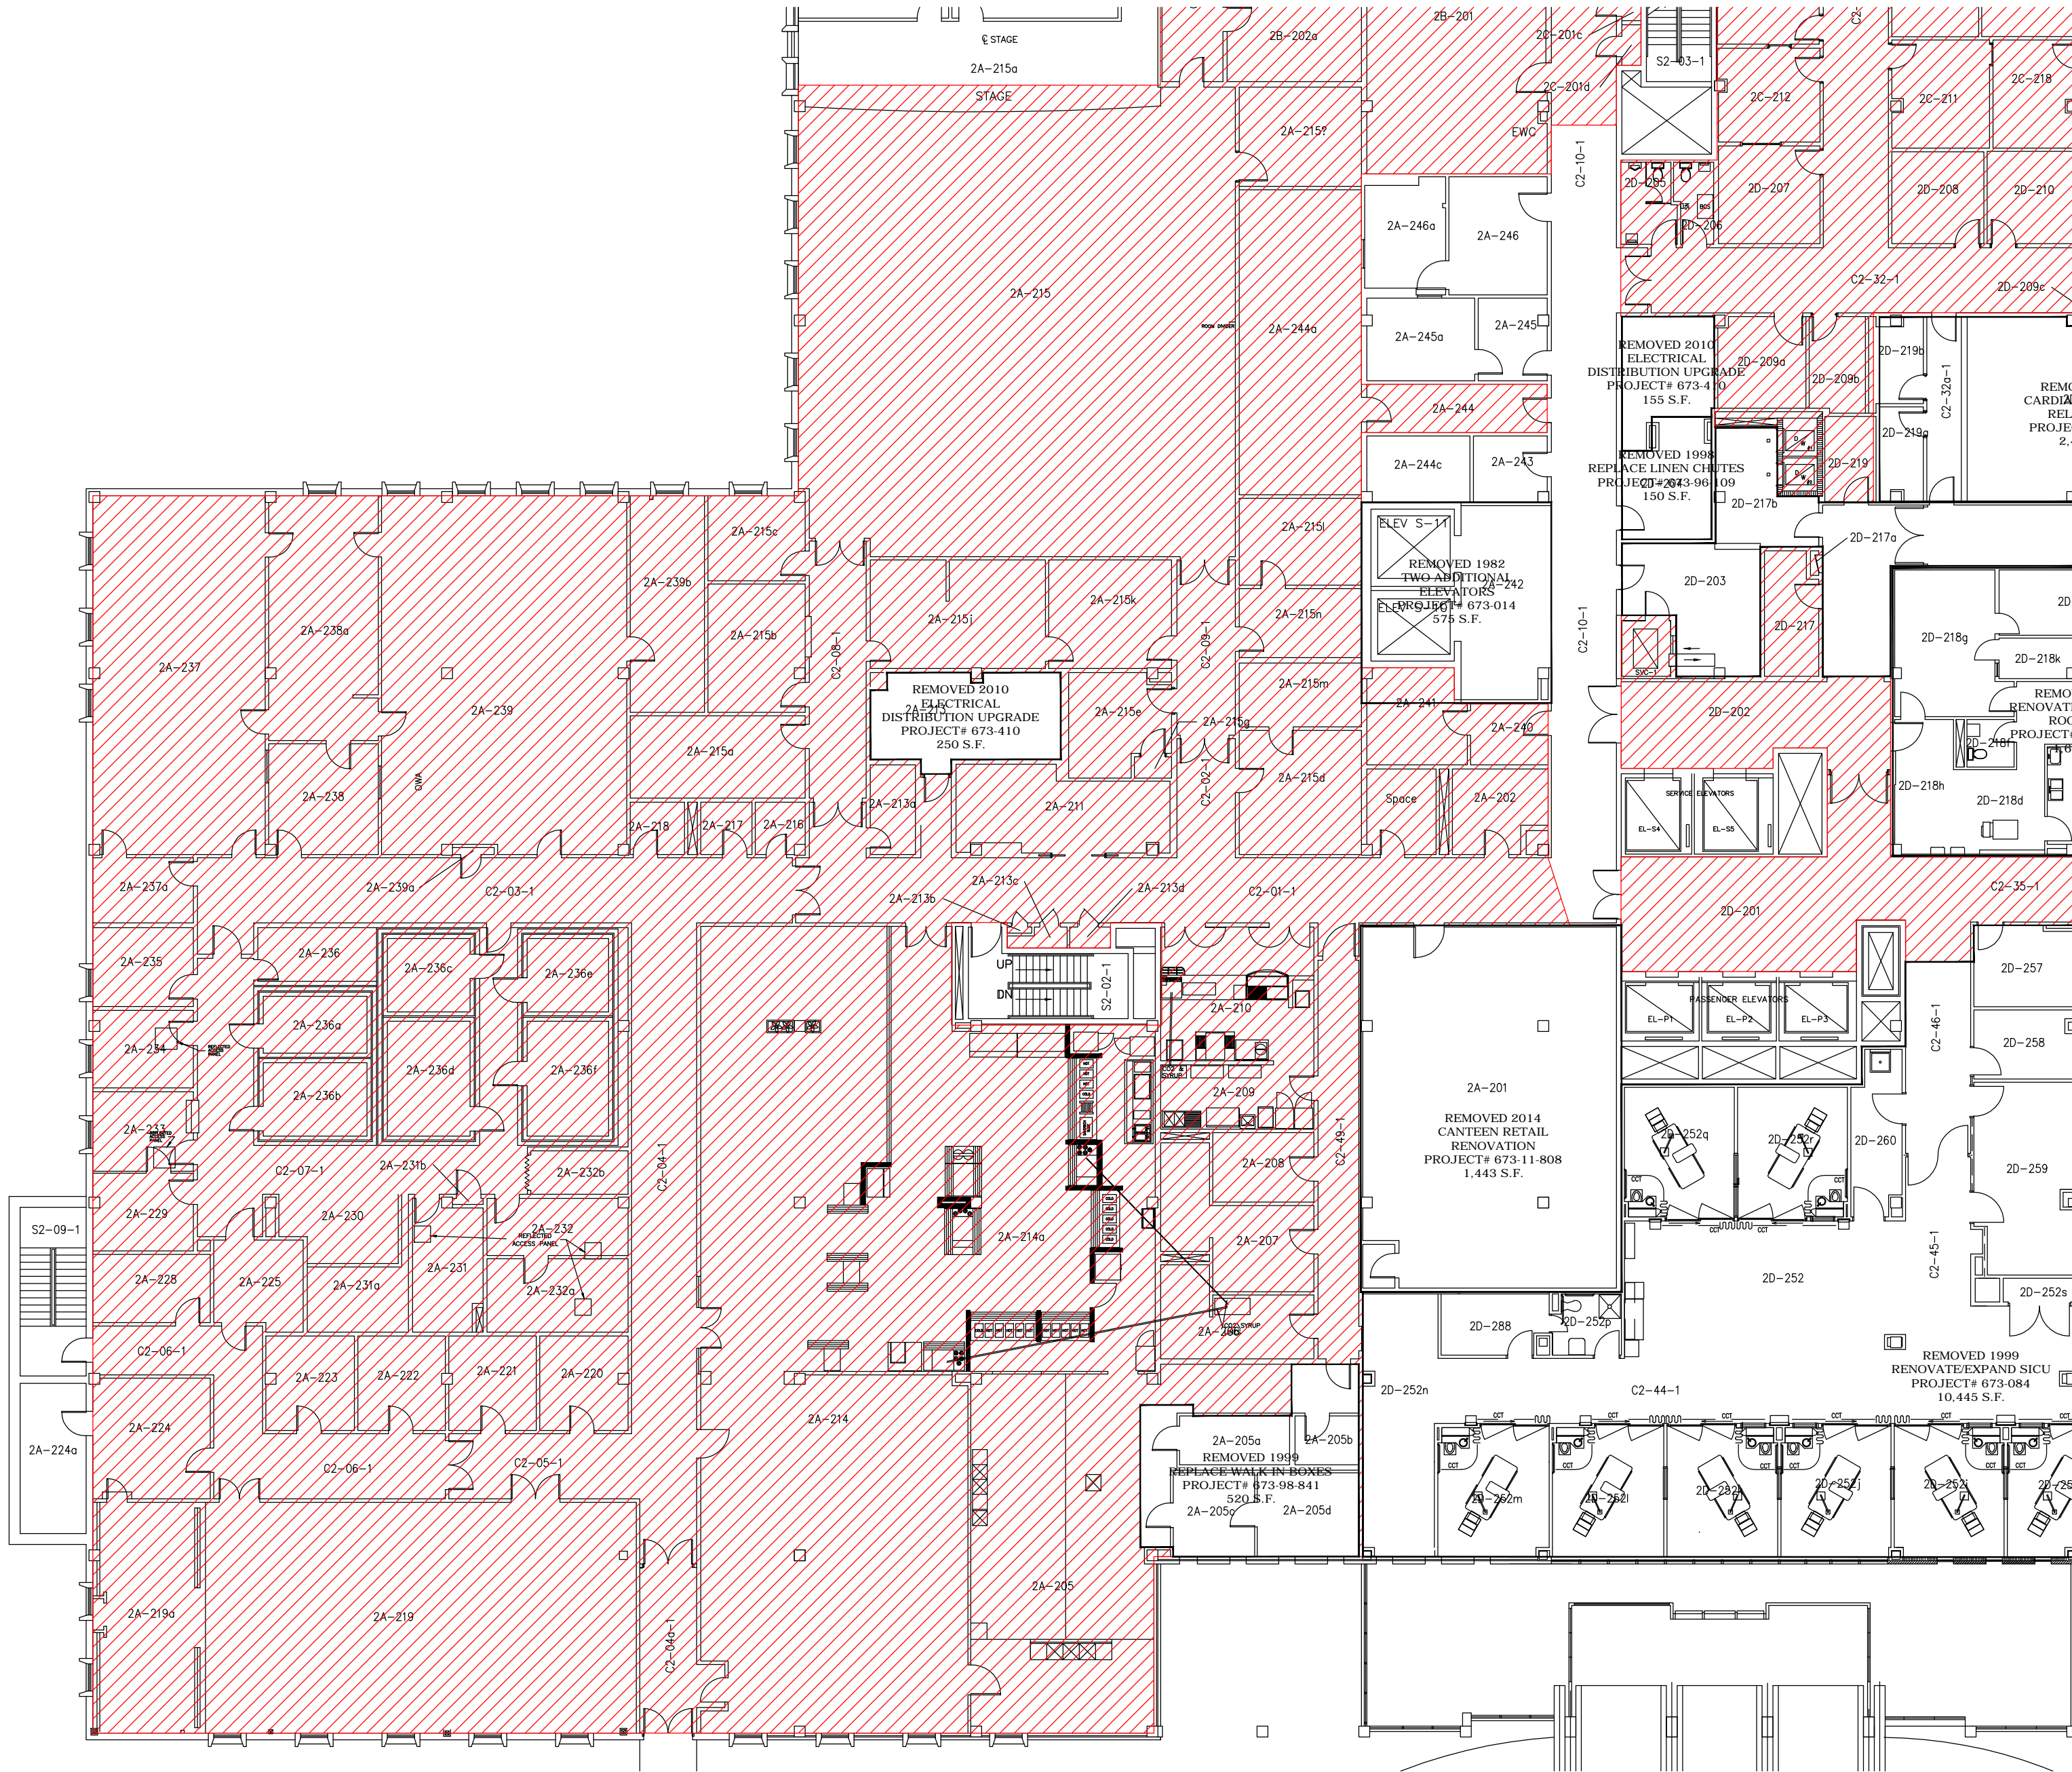

Revisions	Date
VARIOUS PROJECTS UPDATE	04-19-11
OR, GI AND RETAIL STORE	05-29-15

Drawing Title

FIRE PROOFING  
SECOND FLOOR  
WING A

Project Title

ASBESTOS

Approved: Project Section Chief

Approved: Service Chief

Approved: Facility Director


LocationJAMES A. HALEY VETERANS' HOSPITAL  
13000 BRUCE B. DOWNS BLVD.  
TAMPA, FLORIDA 33612

Drawn Date  
MWK 4/25/01


Checked Project No.





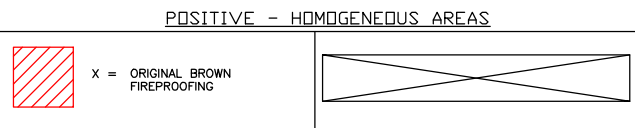


Building Number  
1








File Number  
1HA135




 

 

[illegible]


 

 

POSITIVE - HOMOGENEOUS AREAS	
	<p>V2 = WHITE POLISHED CEILING PLASTER</p>


<u>POSITIVE - HOMOGENEOUS AREAS</u>		
	A = 9x9 FT TAN W/BROWN STREAKS	
	B = 12x12 FT TAN W/BROWN STREAKS	
	S = LINOLEUM CREAM W/SM BROWN MARKINGS	
	X1 = 9x9 FT LIGHT BROWN W/ BROWN & WHITE STREAKS	
		F2 = 9x9 FT BLACK W/WHITE STREAKS
		O2 = 12x12 FT WHITE W/SMALL GREY/BROWN SPATTERS
		P2 = 12x12 FT CREAM W/TAN, BROWN & WHITE SPATTERS

POSITIVE - HOMOGENEOUS AREAS	
 <p>A = 9'x9 FT TAN W/BROWN STRAIGHTS</p>	 <p>F2 = 9'x9 FT BLACK W/WHITE STRAIGHTS</p>
 <p>O1 = BLACK MASTIC UNDER CARPET</p>	 <p>P2 = 12'x12 FT CREAM W/TAN BROWN &amp; WHITE SPATTERS</p>
 <p>X1 = 12'x12 FT LIGHT BROWN WITH BROWN &amp; WHITE STRAIGHTS</p>	 <p>E2 = 12'x12 FT TAN W/PEACH STRAIGHTS</p>
 <p>B2 = 9'x9 FT CREAM W/OLIVE STRAIGHTS</p>	

POSITIVE - HOMOGENEOUS AREAS

 <p><b>B</b></p>	<p><b>B = 12X12 FT TAN W/BROWN STREAKS</b></p>	 <p><b>R2</b></p>	<p><b>R2 = 12X12 FT ROYAL BLUE W/ LIGHT &amp; DRK BLUE SPATTERS</b></p>
 <p><b>L,M</b></p>	<p><b>L = 12X12 FT BLACK W/PINK, BLUE &amp; WHITE DOTS</b>  <b>M = 12X12 FT WHITE W/PINK, BLUE &amp; BLACK DOTS</b></p>	 <p><b>X2</b></p>	<p><b>X2 = 12X12 FT BEIGE W/SHADES OF BEIGE &amp; WHITE SPATTERS</b></p>
 <p><b>X1</b></p>	<p><b>X1 = 9X9 FT LIGHT BROWN W/ BROWN &amp; WHITE STREAKS</b></p>		

POSITIVE - HOMOGENEOUS AREAS	
 <p>X1 = 9X9 FT LIGHT BROWN W/ BROWN &amp; WHITE STREAKS</p>	 <p>I2 = 12X12 FT GREY W/SHADES OF GREY STREAKS</p>
 <p>B2 = 9X9 FT CREAM W/OLIVE STREAKS</p>	 <p>O2 = 12X12 FT WHITE W/SMALL GREY/BROWN SPATTERS</p>
 <p>C2 = 12X12 FT TAN W/OLIVE &amp; WHITE STREAKS</p>	

POSITIVE - HOMOGENEOUS AREAS	
 <p>W2 = WHITE POPCORN CEILING</p>	

Drawing Title

HOMOGENEOUS AREAS  
SECOND FLOOR  
WING A

Project Title

ASBESTOS

Approved: Project Section Chief

Approved: Service Chief

Approved: Facility Director

Location JAMES A. HALEY VETERANS' HOSPITAL  
13000 BRUCE B. DOWNS BLVD.  
TAMPA, FLORIDA 33612

Drawn	Date
MMK	1/26/04

Checked	Project No.
---------	-------------


Building Number	<b>DRAWING NO.</b>

File Number	1HA136
-------------	--------

5






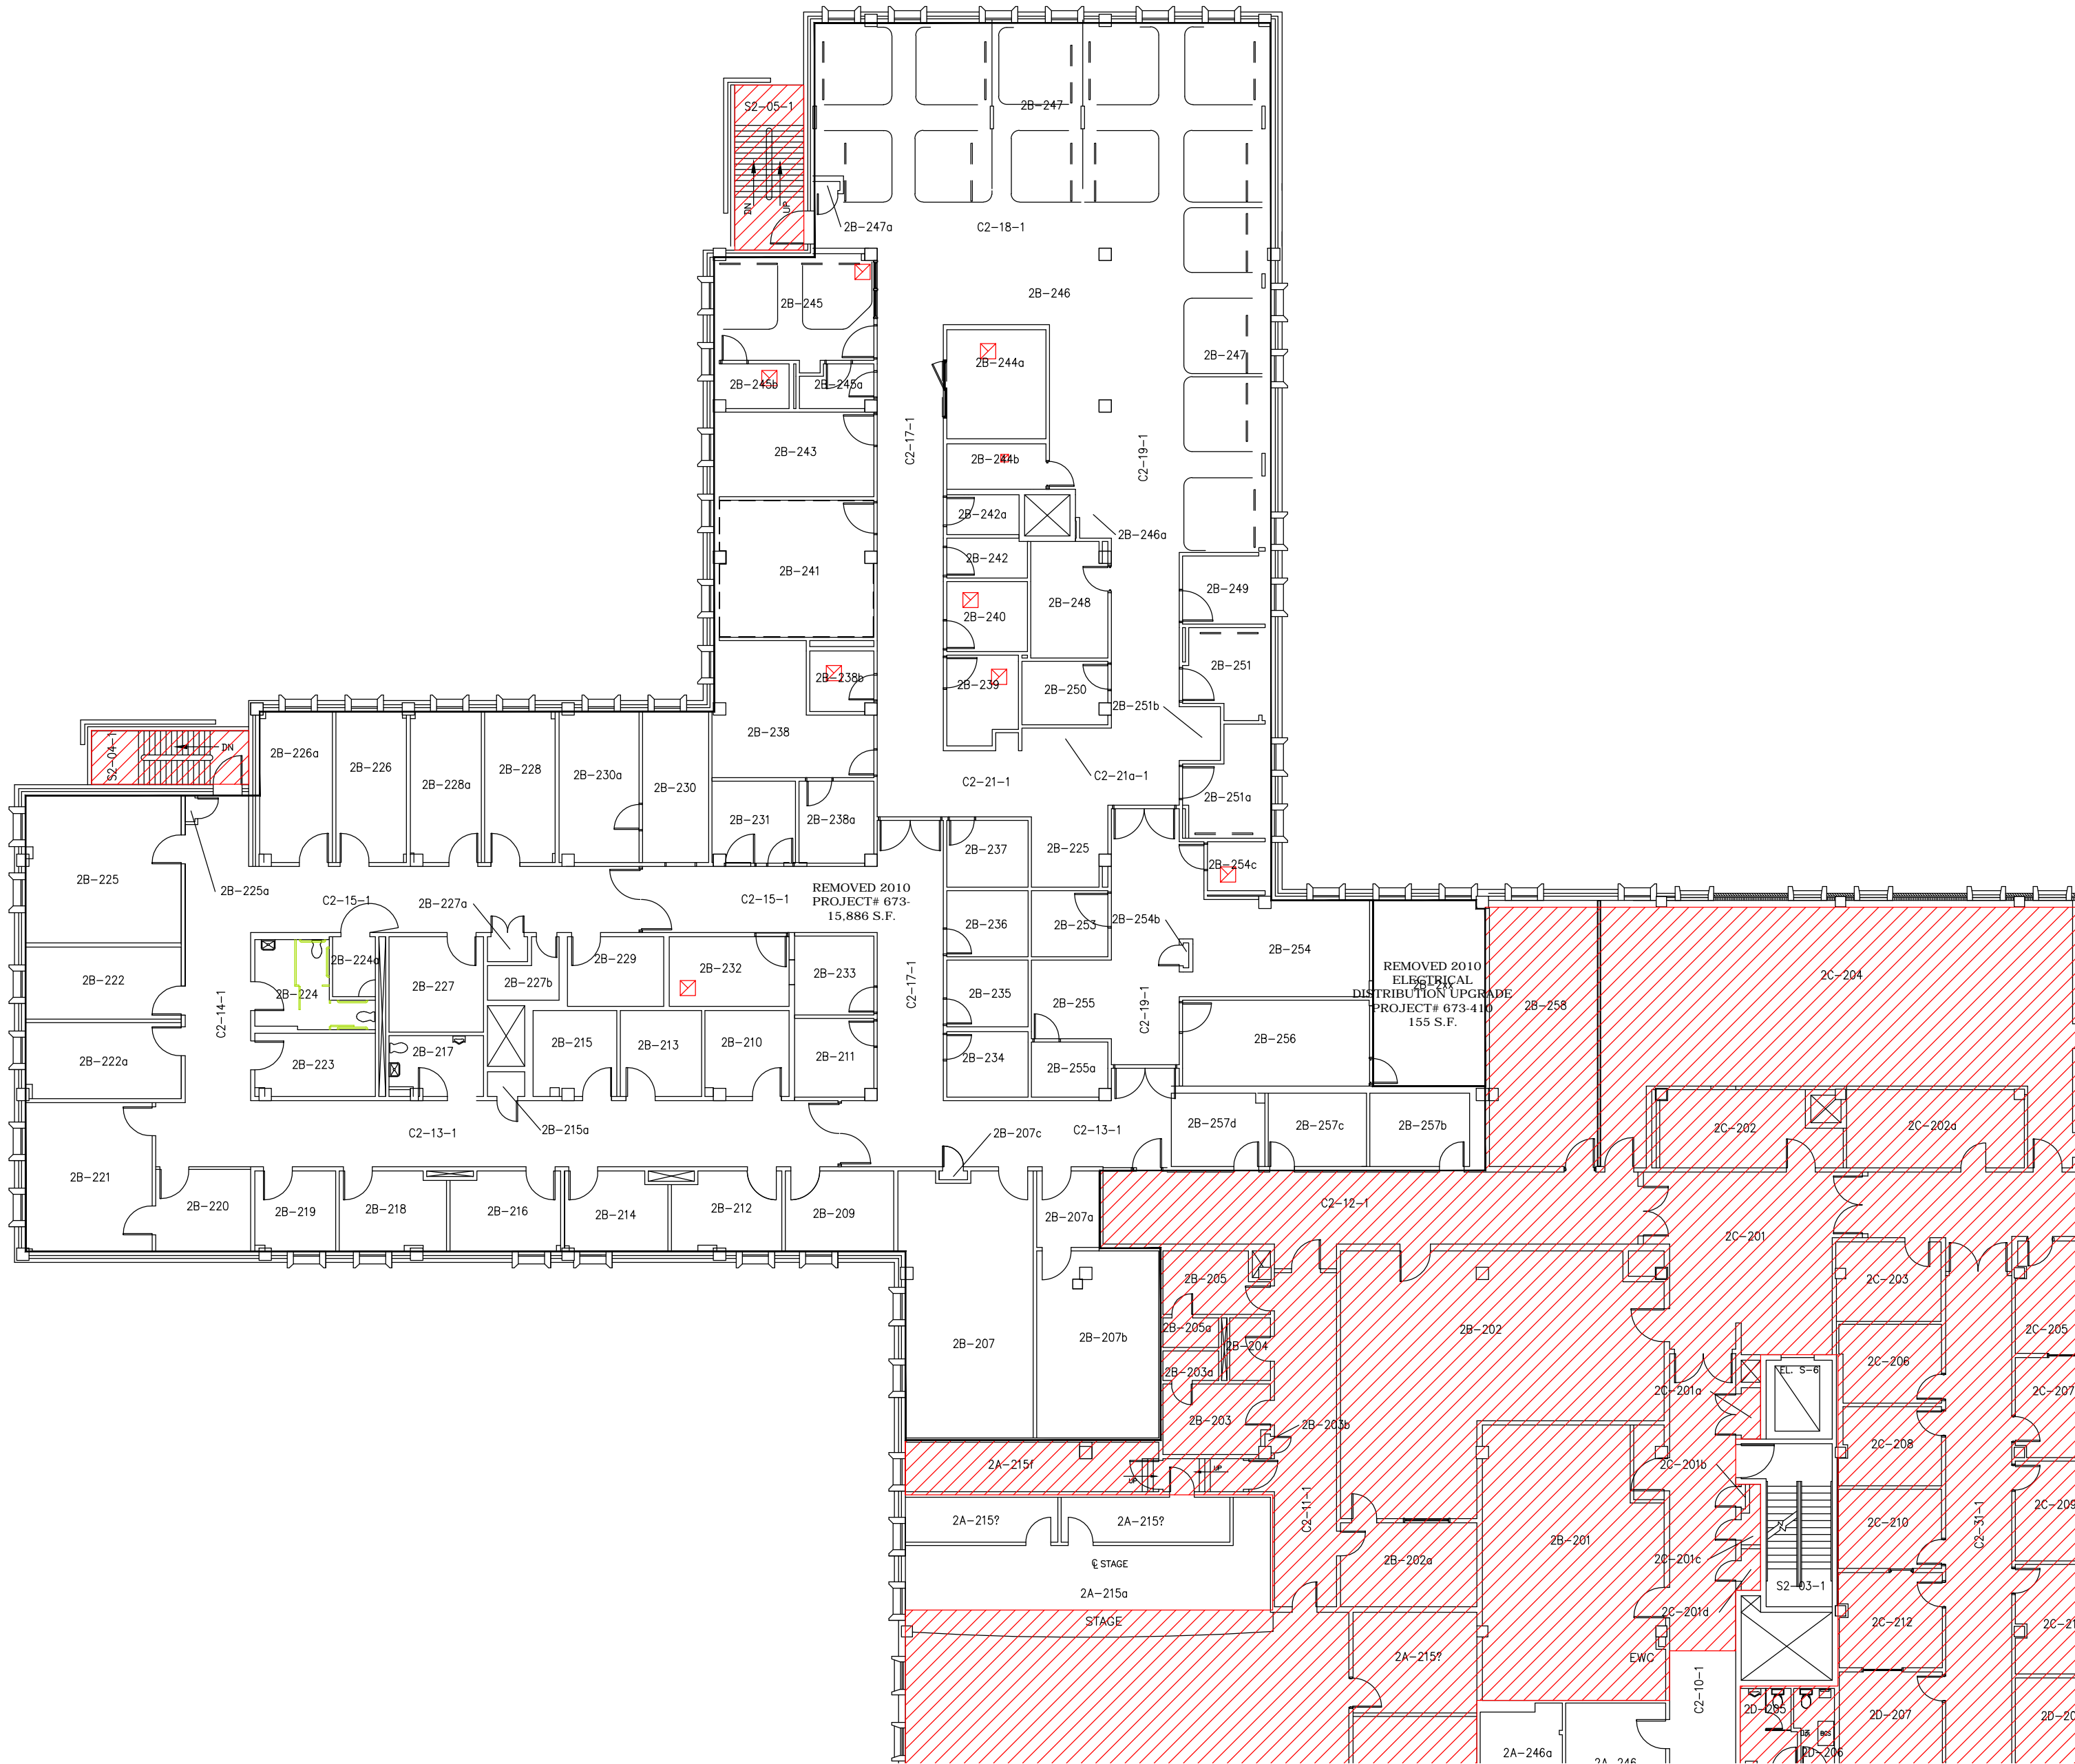


Revisions	Date
VARIOUS PROJECTS UPDATE	04-19-11



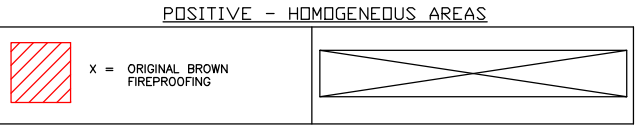




Drawing Title	
FIRE PROOFING SECOND FLOOR WING B	
Project Title	
ASBESTOS	
Approved: Project Section Chief	
Approved: Service Chief	
Approved: Facility Director	
LocationJAMES A. HALEY VETERANS' HOSPITAL 13000 BRUCE B. DOWNS BLVD. TAMPA, FLORIDA 33612	
Drawn	Date
MWK	4/26/01
Checked	Project No.
Building Number	DRAWING NO.
1	1HA137
File Number	Dwg. Of










[illegible]

POSITIVE - HOMOGENEOUS AREAS	
	V2 = WHITE POLISHED CEILING PLASTER


 

 

**POSITIVE - HOMOGENEOUS AREAS**

 <p><b>A</b> = 9'9" FT TAN W/BROWN STRIPES</p>	 <p><b>F2</b> = 9'9" FT BLACK W/WHITE STRIPES</p>
 <p><b>B</b> = 12'12" FT TAN W/BROWN STRIPES</p>	 <p><b>O2</b> = 12'12" FT WHITE W/SMALL GREY/BROWN SPATTERS</p>
 <p><b>S</b> = 1' LINDHEIM CREAM W/SM BROWN MARKINGS</p>	 <p><b>P2</b> = 12'12" FT CREAM W/TAN, BROWN &amp; WHITE SPATTERS</p>
 <p><b>X1</b> = 9'9" FT LIGHT BROWN W/ BROWN &amp; WHITE STRIPES</p>	

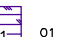



POSITIVE - HOMOGENEOUS AREAS


 <p>A = 9X9 FT TAN W/BROWN STREAKS</p>	 <p>F2 = 9X9 FT BLACK W/WHITE STREAKS</p>
 <p>O1 = BLACK MASTIC UNDER CARPET</p>	 <p>P2 = 12X12 FT CREAM W/TAN BROWN &amp; WHITE SPATTERS</p>
 <p>X1 = 9X9 FT LIGHT BROWN WITH BROWN &amp; WHITE STREAKS</p>	 <p>E2 = 12X12 FT TAN W/PEACH STREAKS</p>
 <p>B2 = 9X9 FT CREAM W/OLIVE STREAKS</p>	

POSITIVE - HOMOGENEOUS AREAS

	<p>B = 12X12 FT TAN W/BROWN STREAKS</p>		<p>R2 = 12X12 FT ROYAL BLUE W/ LIGHT &amp; DRK BLUE SPATTERS</p>
	<p>L = 12X12 FT BLACK W/PINK, BLUE &amp; WHITE DOTS</p> <p>M = 12X12 FT WHITE W/PINK, BLUE &amp; BLACK DOTS</p>		<p>X2 = 12X12 FT BEIGE W/SHADES OF BEIGE &amp; WHITE SPATTERS</p>
	<p>X1 = 9X9 FT LIGHT BROWN W/ BROWN &amp; WHITE STREAKS</p>		

POSITIVE - HOMOGENEOUS AREAS

 <p>X1 = 9x9 FT LIGHT BROWN W/ BROWN &amp; WHITE STREAKS</p>	 <p>I2 = 12x12 FT GREY W/ SHADES OF GREY STREAKS</p>
 <p>B2 = 9x9 FT CREAM W/ OLIVE STREAKS</p>	 <p>O2 = 12x12 FT WHITE W/ SMALL GREY/BROWN SPATTERS</p>

POSITIVE - HOMOGENEOUS AREAS	
 <p>W2 = WHITE POPCORN CEILING</p>	



Drawing Title

HOMOGENEOUS AREAS  
SECOND FLOOR  
WING B

Project Title

ASBESTOS

Approved: Project Section Chief

Approved: Service Chief

Approved: Facility Director

Location JAMES A. HALEY VETERANS' HOSPITAL  
13000 BRUCE B. DOWNS BLVD.  
TAMPA, FLORIDA 33612

Drawn	Date
MWK	4/26/01


Checked	Project No.
---------	-------------

Building Number 1	DRAWING NO.
----------------------	-------------


File Number 1HA138  
Dwg. Of



Revisions	Date
VARIOUS PROJECTS UPDATE	04-19-11
EP LAB ABATEMENT	01-28-13
OR, GI AND RETAIL STORE	05-29-15

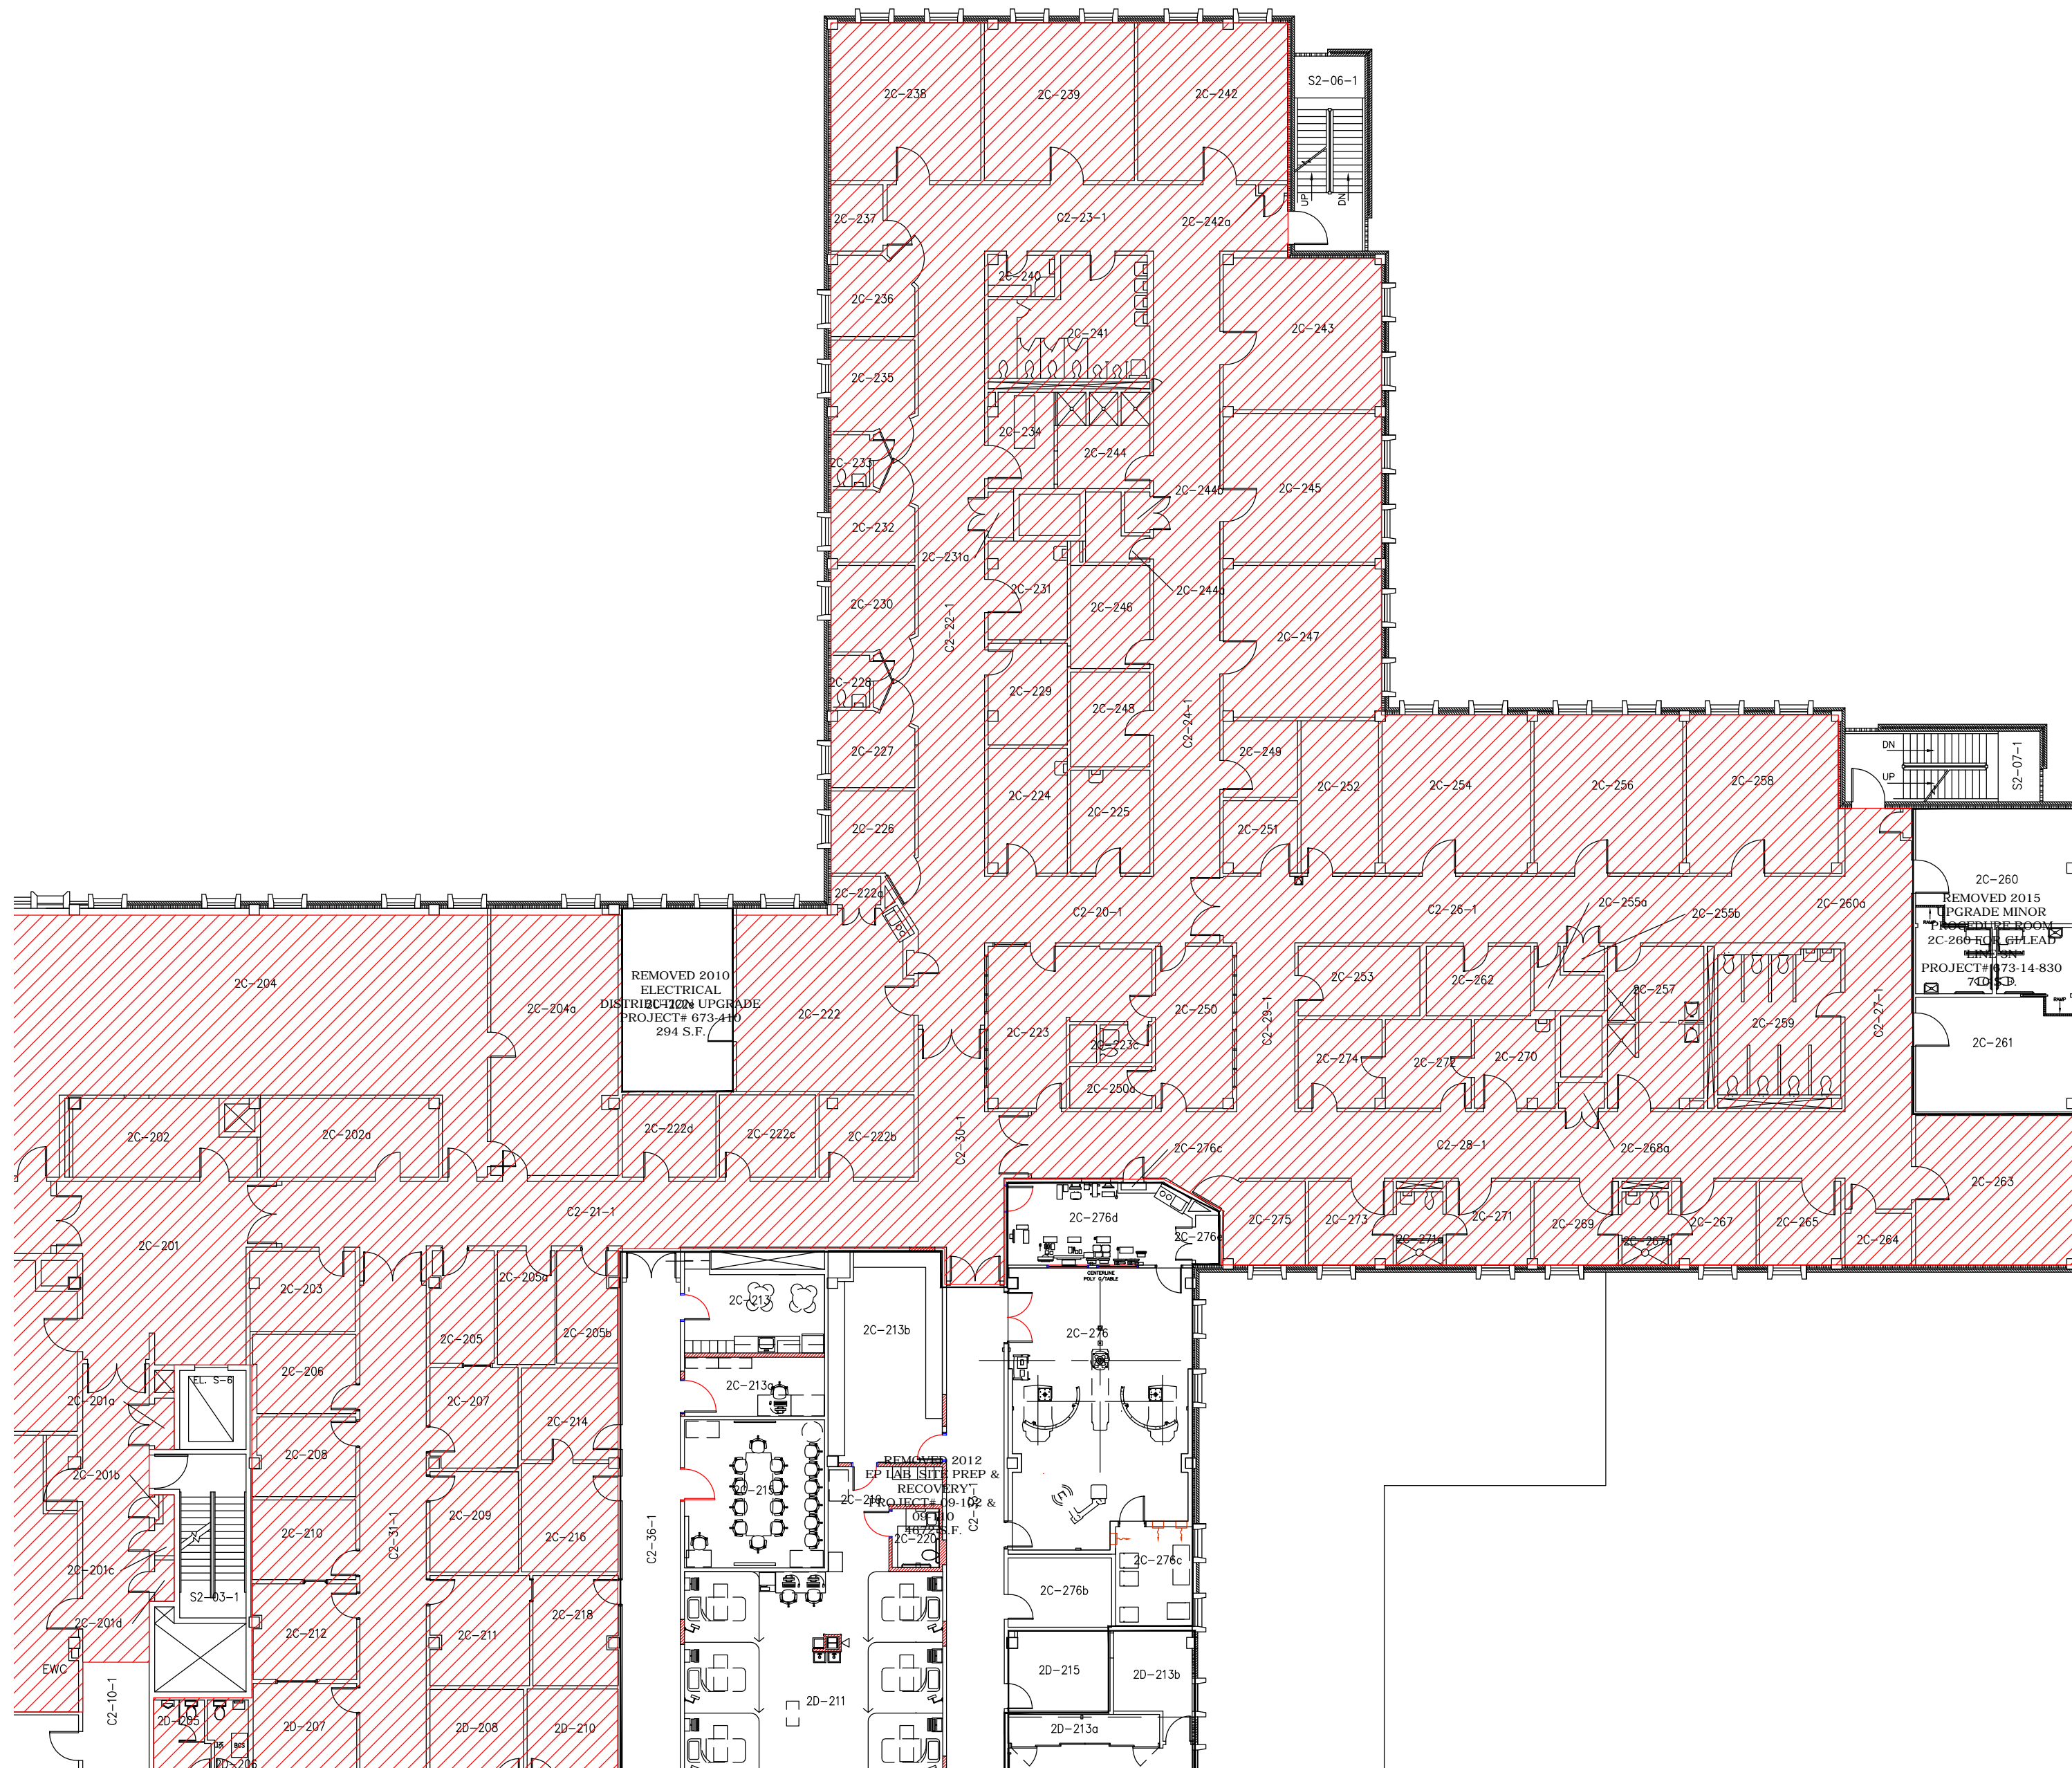


Drawing Title	
FIRE PROOFING SECOND FLOOR WING C	
Project Title	
ASBESTOS	
Approved: Project Section Chief	
Approved: Service Chief	
Approved: Facility Director	
Location JAMES A. HALEY VETERANS' HOSPITAL 13000 BRUCE B. DOWNS BLVD. TAMPA, FLORIDA 33612	
Drawn	Date
MWK	4/26/01
Checked	Project No.
Building Number	DRAWING NO.
1	1HA139
File Number	Dwg. Of

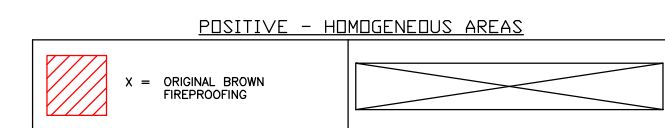





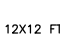




Revisions	Date
VARIOUS PROJECTS UPDATE	04-19-11
EP LAB ABATEMENT	01-28-13
OR, GI AND RETAIL STORE	05-29-15



POSITIVE - HOMOGENEOUS AREAS	
	V2 = WHITE POLISHED CEILING PLASTER
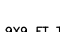
<u>POSITIVE - HOMOGENEOUS AREAS</u>	
	A = 9'x9' FT TAN W/BROWN STREAKS
	B = 12'x12' FT TAN W/BROWN STREAKS
	S = LINOLEUM DREAM W/SM BROWN MARKINGS
	X1 = 9'x9' FT LIGHT BROWN W/ BROWN & WHITE STREAKS
	F2 = 9'x9' FT BLACK W/WHITE STREAKS
	O2 = 12'x12' FT WHITE W/SMALL GREY/BROWN SPATTERS
	IP2 = 12'x12' FT DREAM W/TAN, BROWN & WHITE SPATTERS

## POSITIVE - HOMOGENEOUS AREAS


A = 9'9" FT TAN W/BROWN STREAKS


O1 = BLACK MASTIC UNDER CARPET


X1 = 9'9" FT LIGHT BROWN WITH BROWN & WHITE STREAKS


B2 = 9'9" FT CREAM W/OLIVE STREAKS





 

F2 = 9'9" FT BLACK W/WHITE STREAKS







P2 = 12'12" FT CREAM W/TAN BROWN & WHITE SPATTERS



E2 = 12'12" FT TAN W/PEACH STREAKS

POSITIVE - HOMOGENEOUS AREAS	
 <p>B = 12X12 FT TAN W/BROWN STREAKS</p>	 <p>R2 = 12X12 FT ROYAL BLUE W/ LIGHT &amp; DRK BLUE SPATTERS</p>
 <p>L = 12X12 FT BLACK W/PINK, BLUE &amp; WHITE DOTS</p> <p>M = 12X12 FT WHITE W/PINK, BLUE &amp; BLACK DOTS</p>	 <p>X2 = 12X12 FT BEIGE W/SHADES OF BEIGE &amp; WHITE SPATTERS</p>
 <p>X1 = 9X9 FT LIGHT BROWN W/ BROWN &amp; WHITE STREAKS</p>	

POSITIVE -- HOMOGENEOUS AREAS

 <p>X1 = 9X9 FT LIGHT BROWN W/ BROWN &amp; WHITE STREAKS</p>	 <p>I2 = 12X12 FT GREY W/SHADES OF GREY STREAKS</p>
 <p>B2 = 9X9 FT CREAM W/OLIVE STREAKS</p>	 <p>O2 = 12X12 FT WHITE W/SMALL GREY/BROWN SPATTERS</p>
 <p>C2 = 12X12 FT TAN W/OLIVE &amp; WHITE STREAKS</p>	

POSITIVE - HOMOGENEOUS AREAS	
	W2 = WHITE POPCORN CEILING

Drawing Title

HOMOGENEOUS AREAS  
SECOND FLOOR  
WING C

Project Title

ASBESTOS

Approved: Project Section Chief

Approved: Service Chief

Approved: Facility Director

Location JAMES A. HALEY VETERANS' HOSPITAL  
13000 BRUCE B. DOWNS BLVD.  
TAMPA, FLORIDA 33612

Drawn MWK	Date 4/26/01
--------------	-----------------

Checked	Project No.
---------	-------------

Building Number 1	DRAWING NO. 111A140
----------------------	------------------------

File Number 1HA140

Dwg. Of









