

 


Revisions	Date

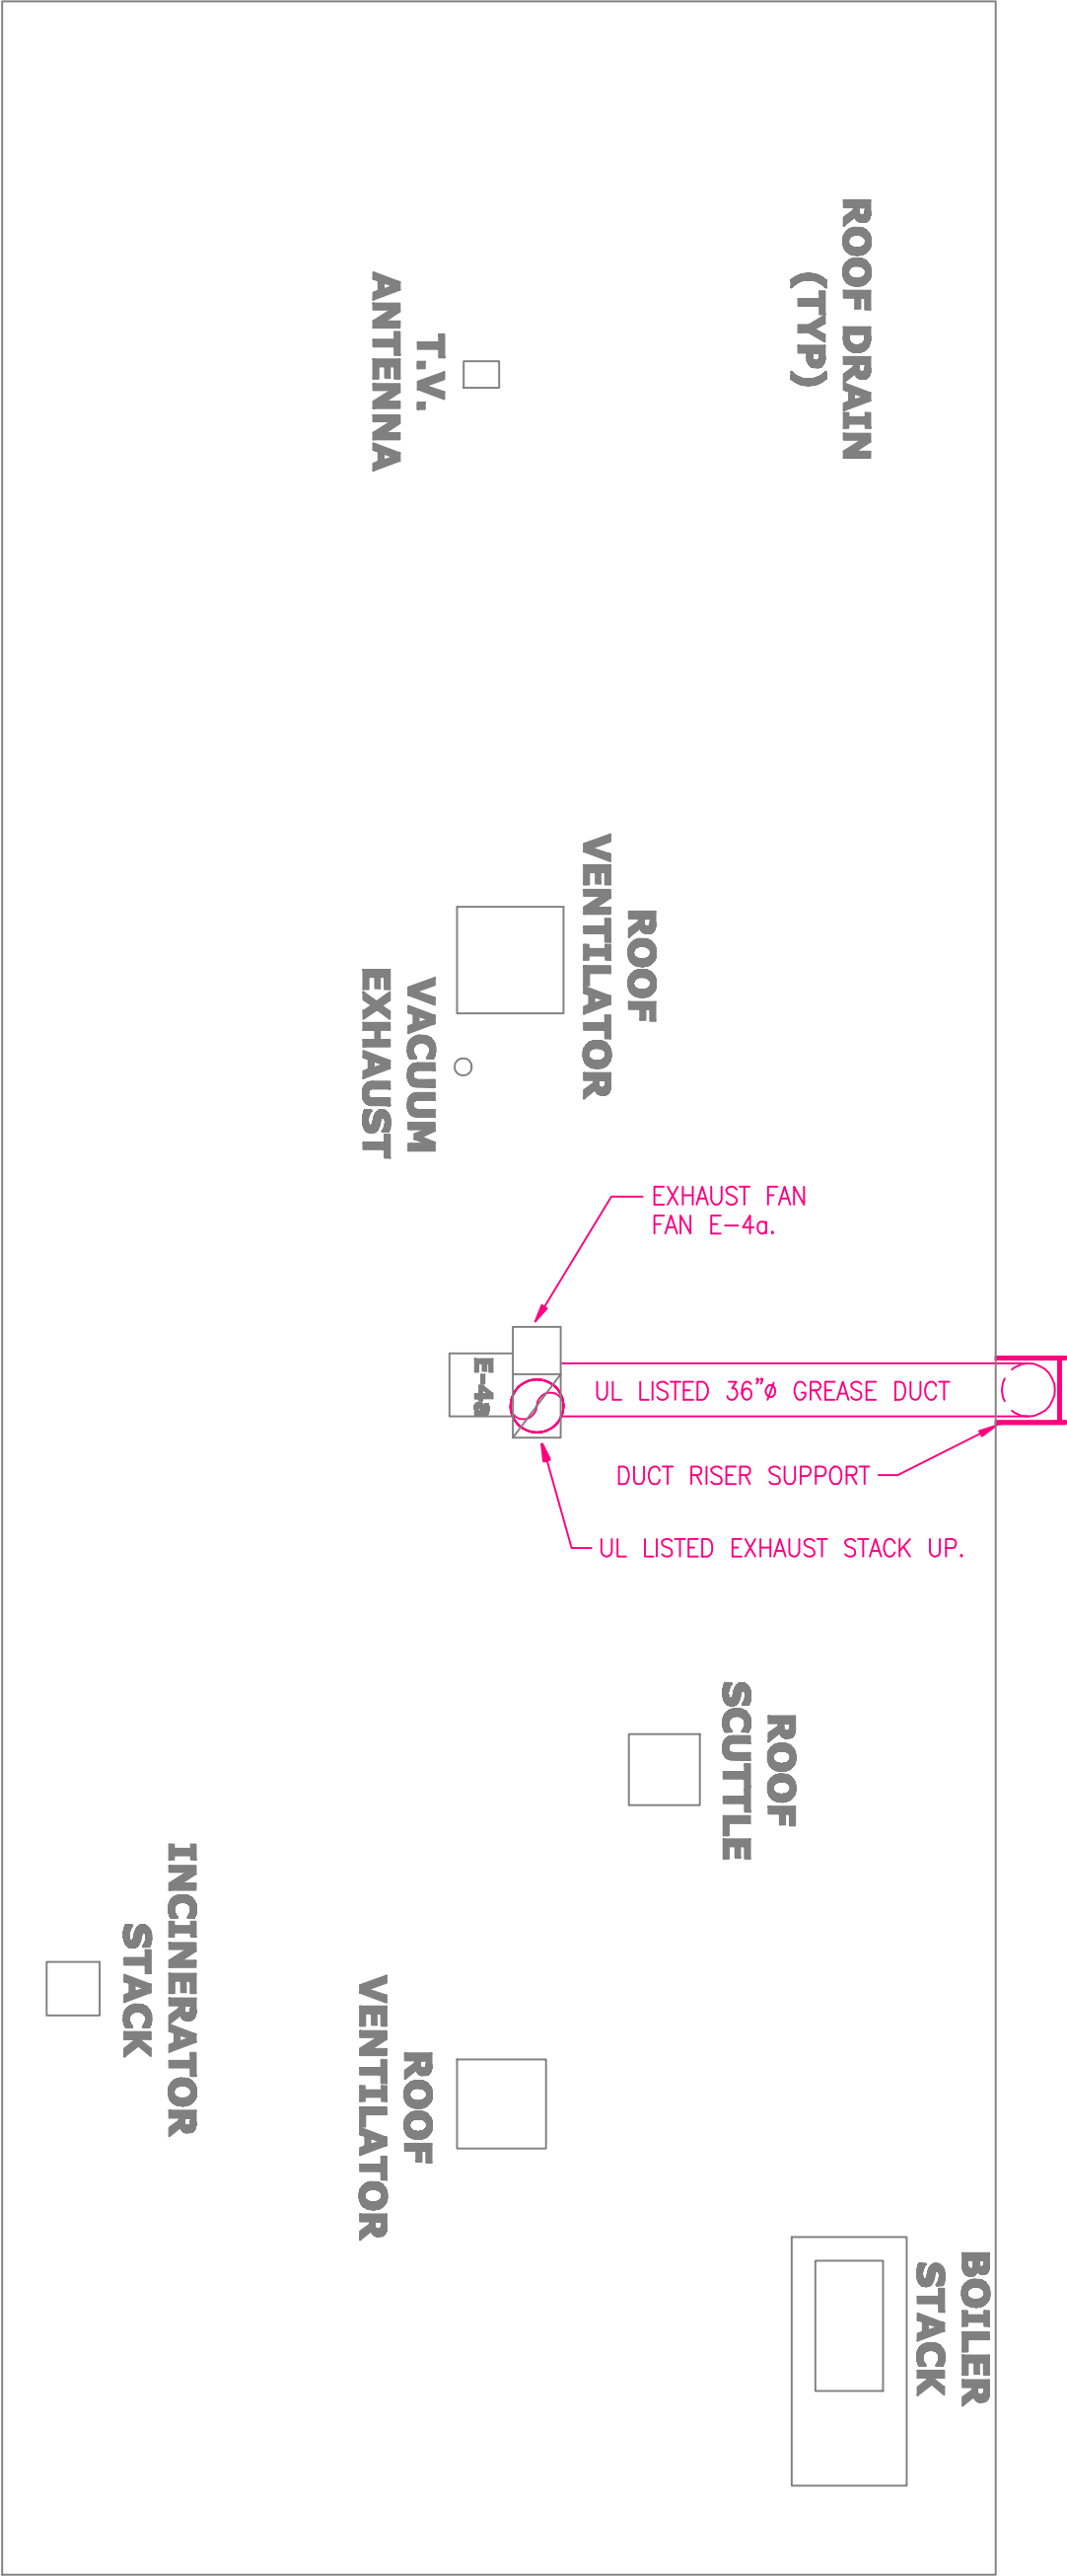

Drawing Title	
PENTHOUSE ROOF	
Project Title	
HVAC	
Approved: Project Section Chief	
Approved: Service Chief	
Approved: Facility Director	
Drawn	Date
MWK	
Checked	Project No.
Building Number	DRAWING NO.
1	1-MH137
File Number	Drawg. of

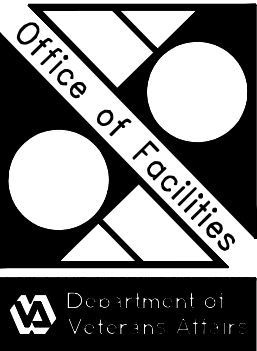

Department of
Veterans Affairs



SCALE: 3/32" = 1'-0"