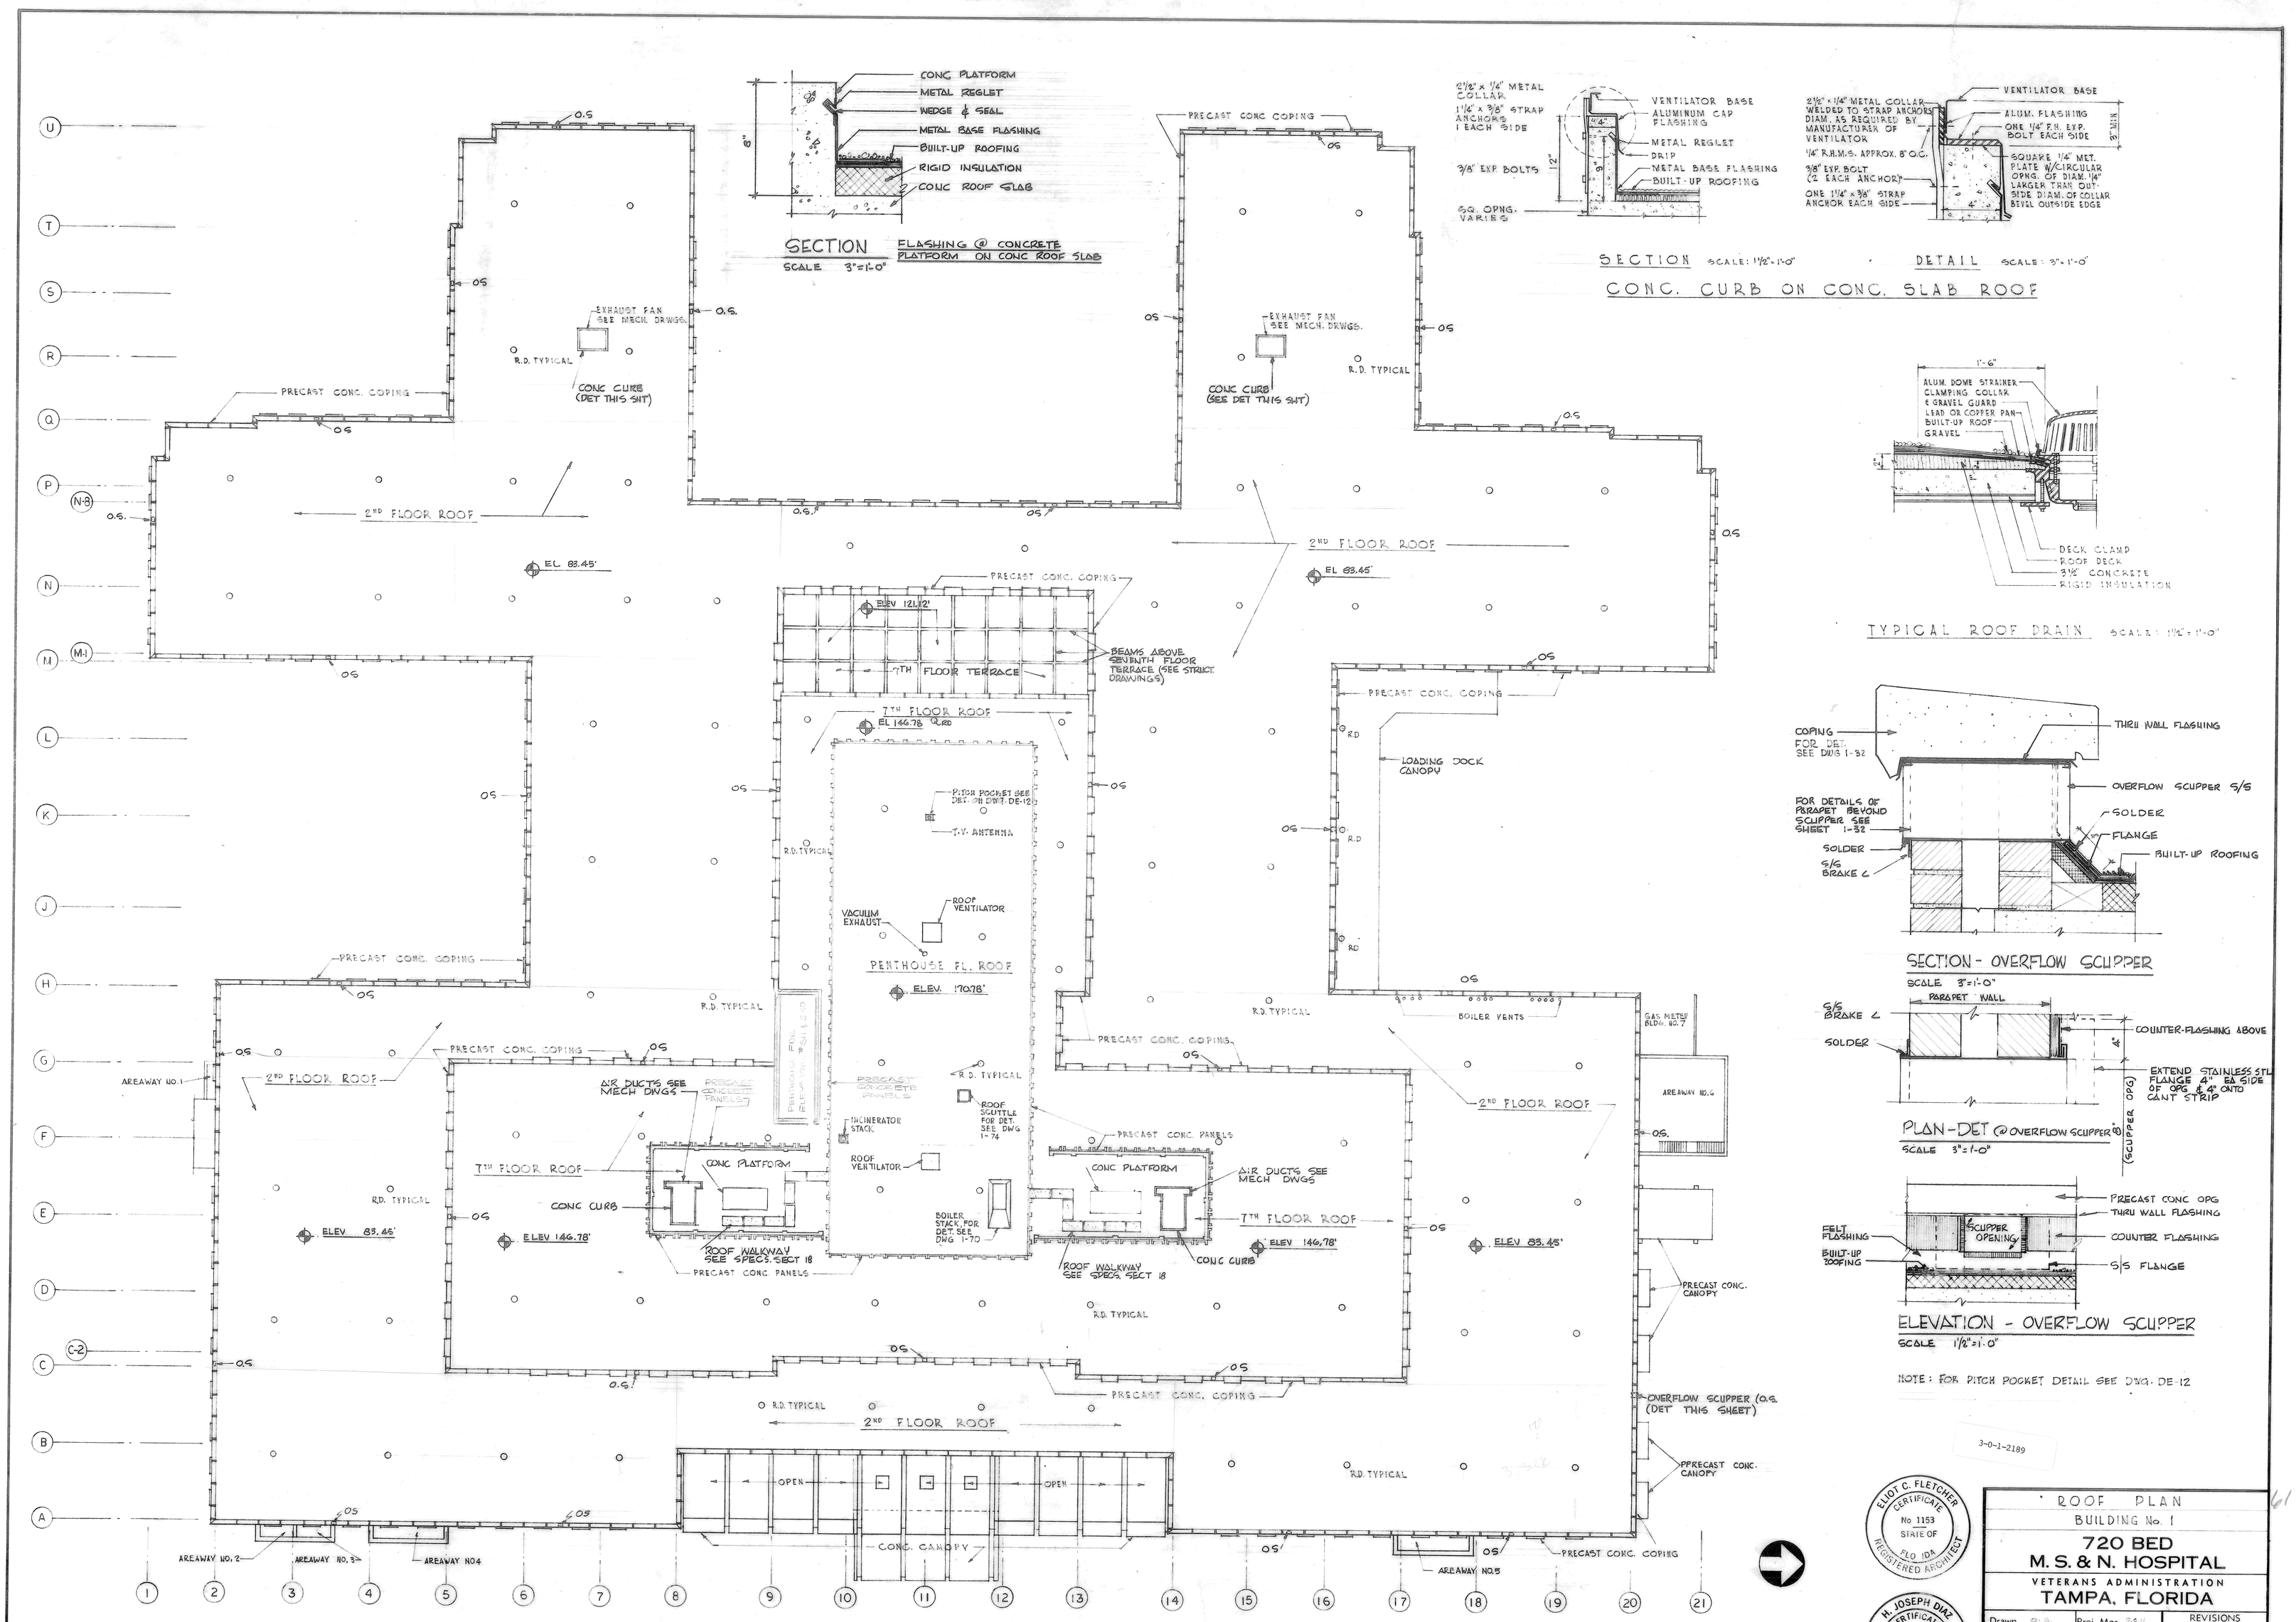
CONC PLATFORM
METAL REGLET
WEDGE & SEAL
METAL BASE FLASHING
BUILT-UP ROOFING
RIGID INSULATION
CONC ROOF SLAB
SECTION FLASHING @ CONCRETE PLATFORM ON CONC ROOF SLAB
SCALE 3"=1'-0"
2 1/8" x 1/4" METAL COLLAR
1 1/4" x 3/8" STRAP ANCHORS 1 EACH SIDE
3/8" EXP BOLTS
SQ. OPNG. VARIES
VENTILATOR BASE
ALUMINUM CAP FLASHING
METAL REGLET
DRIP
METAL BASE FLASHING
BUILT-UP ROOFING
SECTION SCALE: 1 1/2"=1'-0"
2 1/8" x 1/4" METAL COLLAR WELDED TO STRAP ANCHORS DIAM. AS REQUIRED BY MANUFACTURER OF VENTILATOR
1/4" R.H.M.S. APPROX. 8" O.C.
3/8" EXP. BOLT (2 EACH ANCHOR)
ONE 1 1/4" x 3/8" STRAP ANCHOR EACH SIDE
VENTILATOR BASE
ALUM. FLASHING
ONE 1/4" F.H. EXP. BOLT EACH SIDE
SQUARE 1/4" MET. PLATE W/CIRCULAR OPNG. OF DIAM. 1/4" LARGER THAN OUTSIDE DIAM. OF COLLAR BEVEL OUTSIDE EDGE
DETAIL SCALE: 3"=1'-0"
CONC. CURB ON CONC. SLAB ROOF
EXHAUST FAN SEE MECH. DRWGS.
R.D. TYPICAL
CONC CURB (DET THIS SHT)
PRECAST CONC. COPING
2ND FLOOR ROOF
EL 83.45'
7TH FLOOR TERRACE
BEAMS ABOVE SEVENTH FLOOR TERRACE (SEE STRUCT. DRAWINGS)
7TH FLOOR ROOF
EL 146.78
PITCH POCKET SEE DET. ON DWG. DE-12
T.V. ANTENNA
VACUUM EXHAUST
ROOF VENTILATOR
PENTHOUSE FL. ROOF
ELEV. 170.78'
LOADING DOCK CANOPY
BOILER VENTS
GAS METER BLDG. NO. 7
AREAWAY NO. 6
AREAWAY NO. 1
AIR DUCTS SEE MECH DWGS
PRECAST CONC. PANELS
ROOF SCUTTLE FOR DET. SEE DWG 1-74
INCINERATOR STACK
CONC PLATFORM
CONC CURB
ROOF WALKWAY SEE SPECS. SECT 18
BOILER STACK, FOR DET SEE DWG 1-70
ELEV 146.78'
ELEV 83.45'
PRECAST CONC. CANOPY
OVERFLOW SCUPPER (O.S. (DET THIS SHEET)
CONC. CANOPY
OPEN
AREAWAY NO. 2
AREAWAY NO. 3
AREAWAY NO 4
AREAWAY NO. 5
PRECAST CONC. COPING
ALUM. DOME STRAINER
CLAMPING COLLAR & GRAVEL GUARD
LEAD OR COPPER PAN
BUILT-UP ROOF
GRAVEL
DECK CLAMP
ROOF DECK
3 1/2" CONCRETE
RIGID INSULATION
TYPICAL ROOF DRAIN SCALE: 1 1/2"=1'-0"
COPING FOR DET. SEE DWG 1-32
THRU WALL FLASHING
OVERFLOW SCUPPER S/S
FOR DETAILS OF PARAPET BEYOND SCUPPER SEE SHEET 1-32
SOLDER
FLANGE
BUILT-UP ROOFING
S/S BRAKE ∠
SECTION - OVERFLOW SCUPPER
SCALE 3"=1'-0"
PARAPET WALL
COUNTER-FLASHING ABOVE
EXTEND STAINLESS STL FLANGE 4" EA SIDE OF OPG & 4" ONTO CANT STRIP
PLAN-DET @ OVERFLOW SCUPPER
SCALE 3"=1'-0"
PRECAST CONC OPG
THRU WALL FLASHING
COUNTER FLASHING
S/S FLANGE
FELT FLASHING
BUILT-UP ROOFING
SCUPPER OPENING
ELEVATION - OVERFLOW SCUPPER
SCALE 1 1/2"=1'-0"
NOTE: FOR PITCH POCKET DETAIL SEE DWG. DE-12
ROOF PLAN
SCALE: 1/16"=1'-0"
THREE INCHES EQUAL ONE FOOT
ONE AND ONE HALF INCHES EQUAL ONE FOOT
ONE SIXTEENTH INCH EQUALS ONE FOOT
ELIOT C. FLETCHER CERTIFICATE No. 1153 STATE OF FLORIDA REGISTERED ARCHITECT
H. JOSEPH DIAZ CERTIFICATE No. 8893 STATE OF FLORIDA REGISTERED ENGINEER
ROOF PLAN
BUILDING No. 1
720 BED
M. S. & N. HOSPITAL
VETERANS ADMINISTRATION
TAMPA, FLORIDA
Drawn
Checked E.M.M.
Proj. Mgr.
Date AUG 15, 68
REVISIONS
1 AS BUILT 7-20-72
ELIOT C. FLETCHER AIA
FRANK S. VALENTI AIA
ARCHITECTS TAMPA
SCHMIDT, GARDEN & ERIKSON
ASSOCIATE ARCHITECTS-ENGINEERS CHICAGO
H. JOSEPH DIAZ & ASSOCS.
SAM CARASTRO & ASSOCS.
ENGINEERS TAMPA
DRAWING NUMBER
1-21
Sheet 21 of 33
Proj. No. 09-5239
RETURN TRACINGS TO PLAN LIBRARY
FILE FOLDER NO. 2