


CONTROL SYSTEM

- FIRST COMPRESSOR START 60 PSIG.
- SECOND COMPRESSOR START 55 PSIG.
- BOTH COMPRESSOR STOP 80 PSIG.
- P.R.V. SET 55 PSIG.

NOTE: DISASSEMBLE AIR COMPRESSOR TO PASS THRU EXISTING DOOR-WAY.

MEDICAL AIR COMPRESSORS DIAGRAM

SCALE: NONE

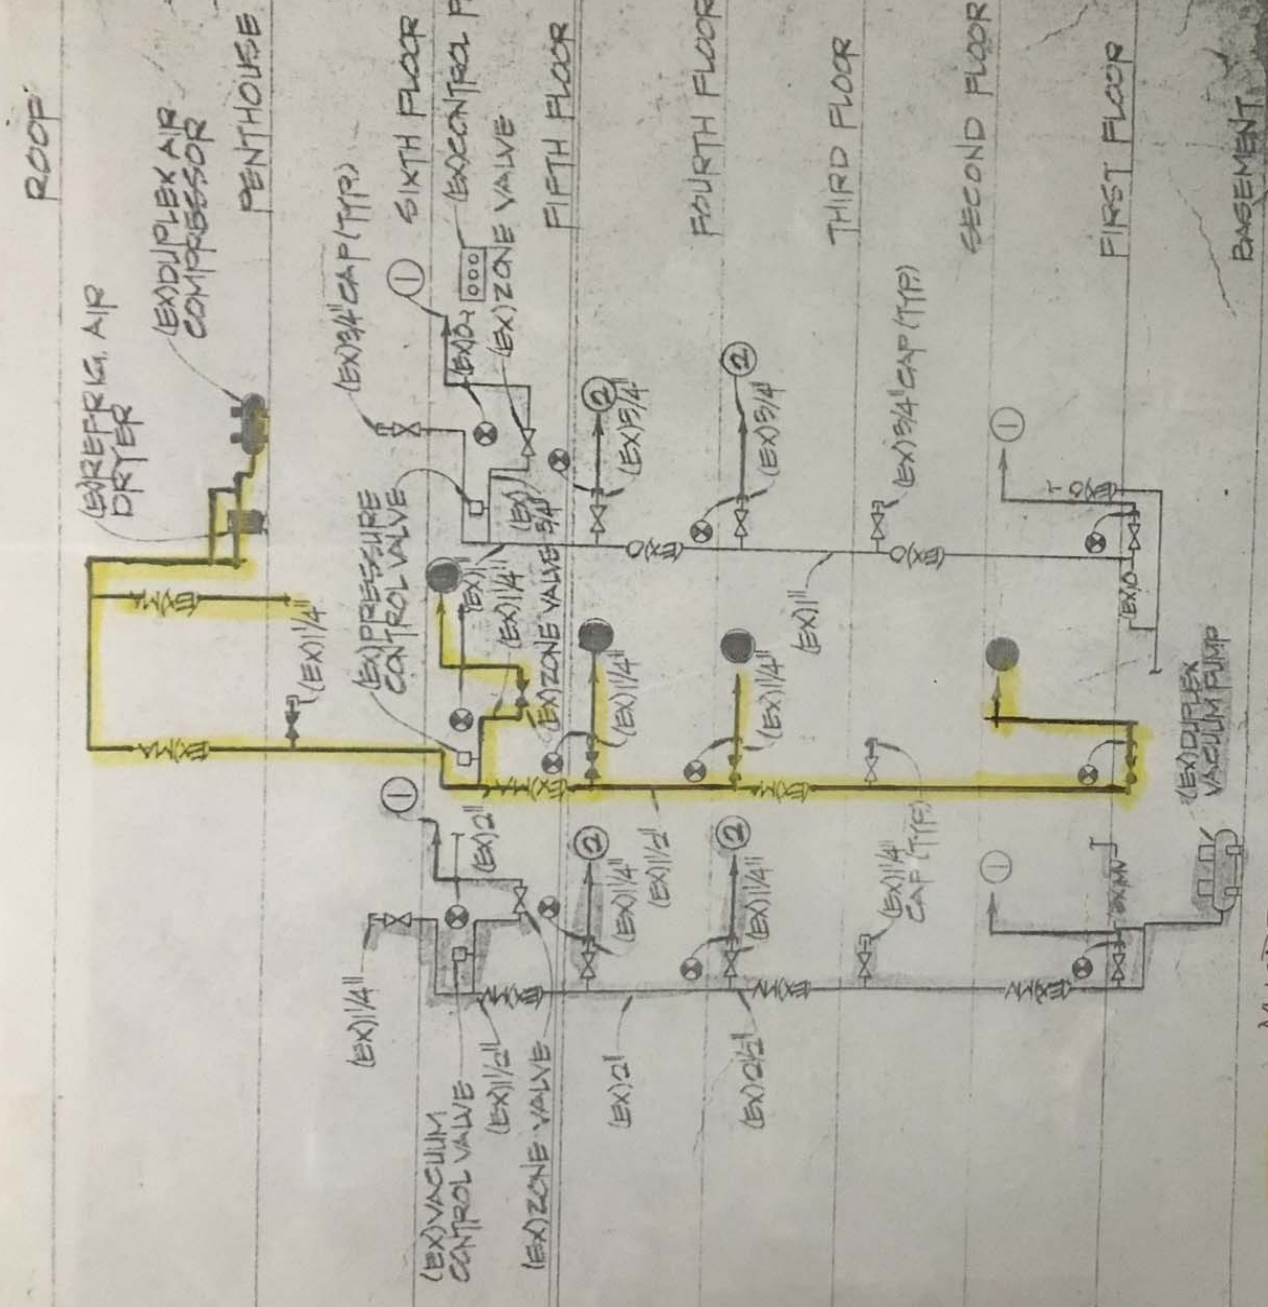

= MEDICAL AIR RISER

2 MEDICAL GAS RISER DIAGRAM 8/25/95
NOT TO SCALE

- NOTES:
- ① TO (N) PEPUS 4 OR MEDICAL GAS OUTLETS
 - ② TO (N) PEPUS, NGAs, & MVES