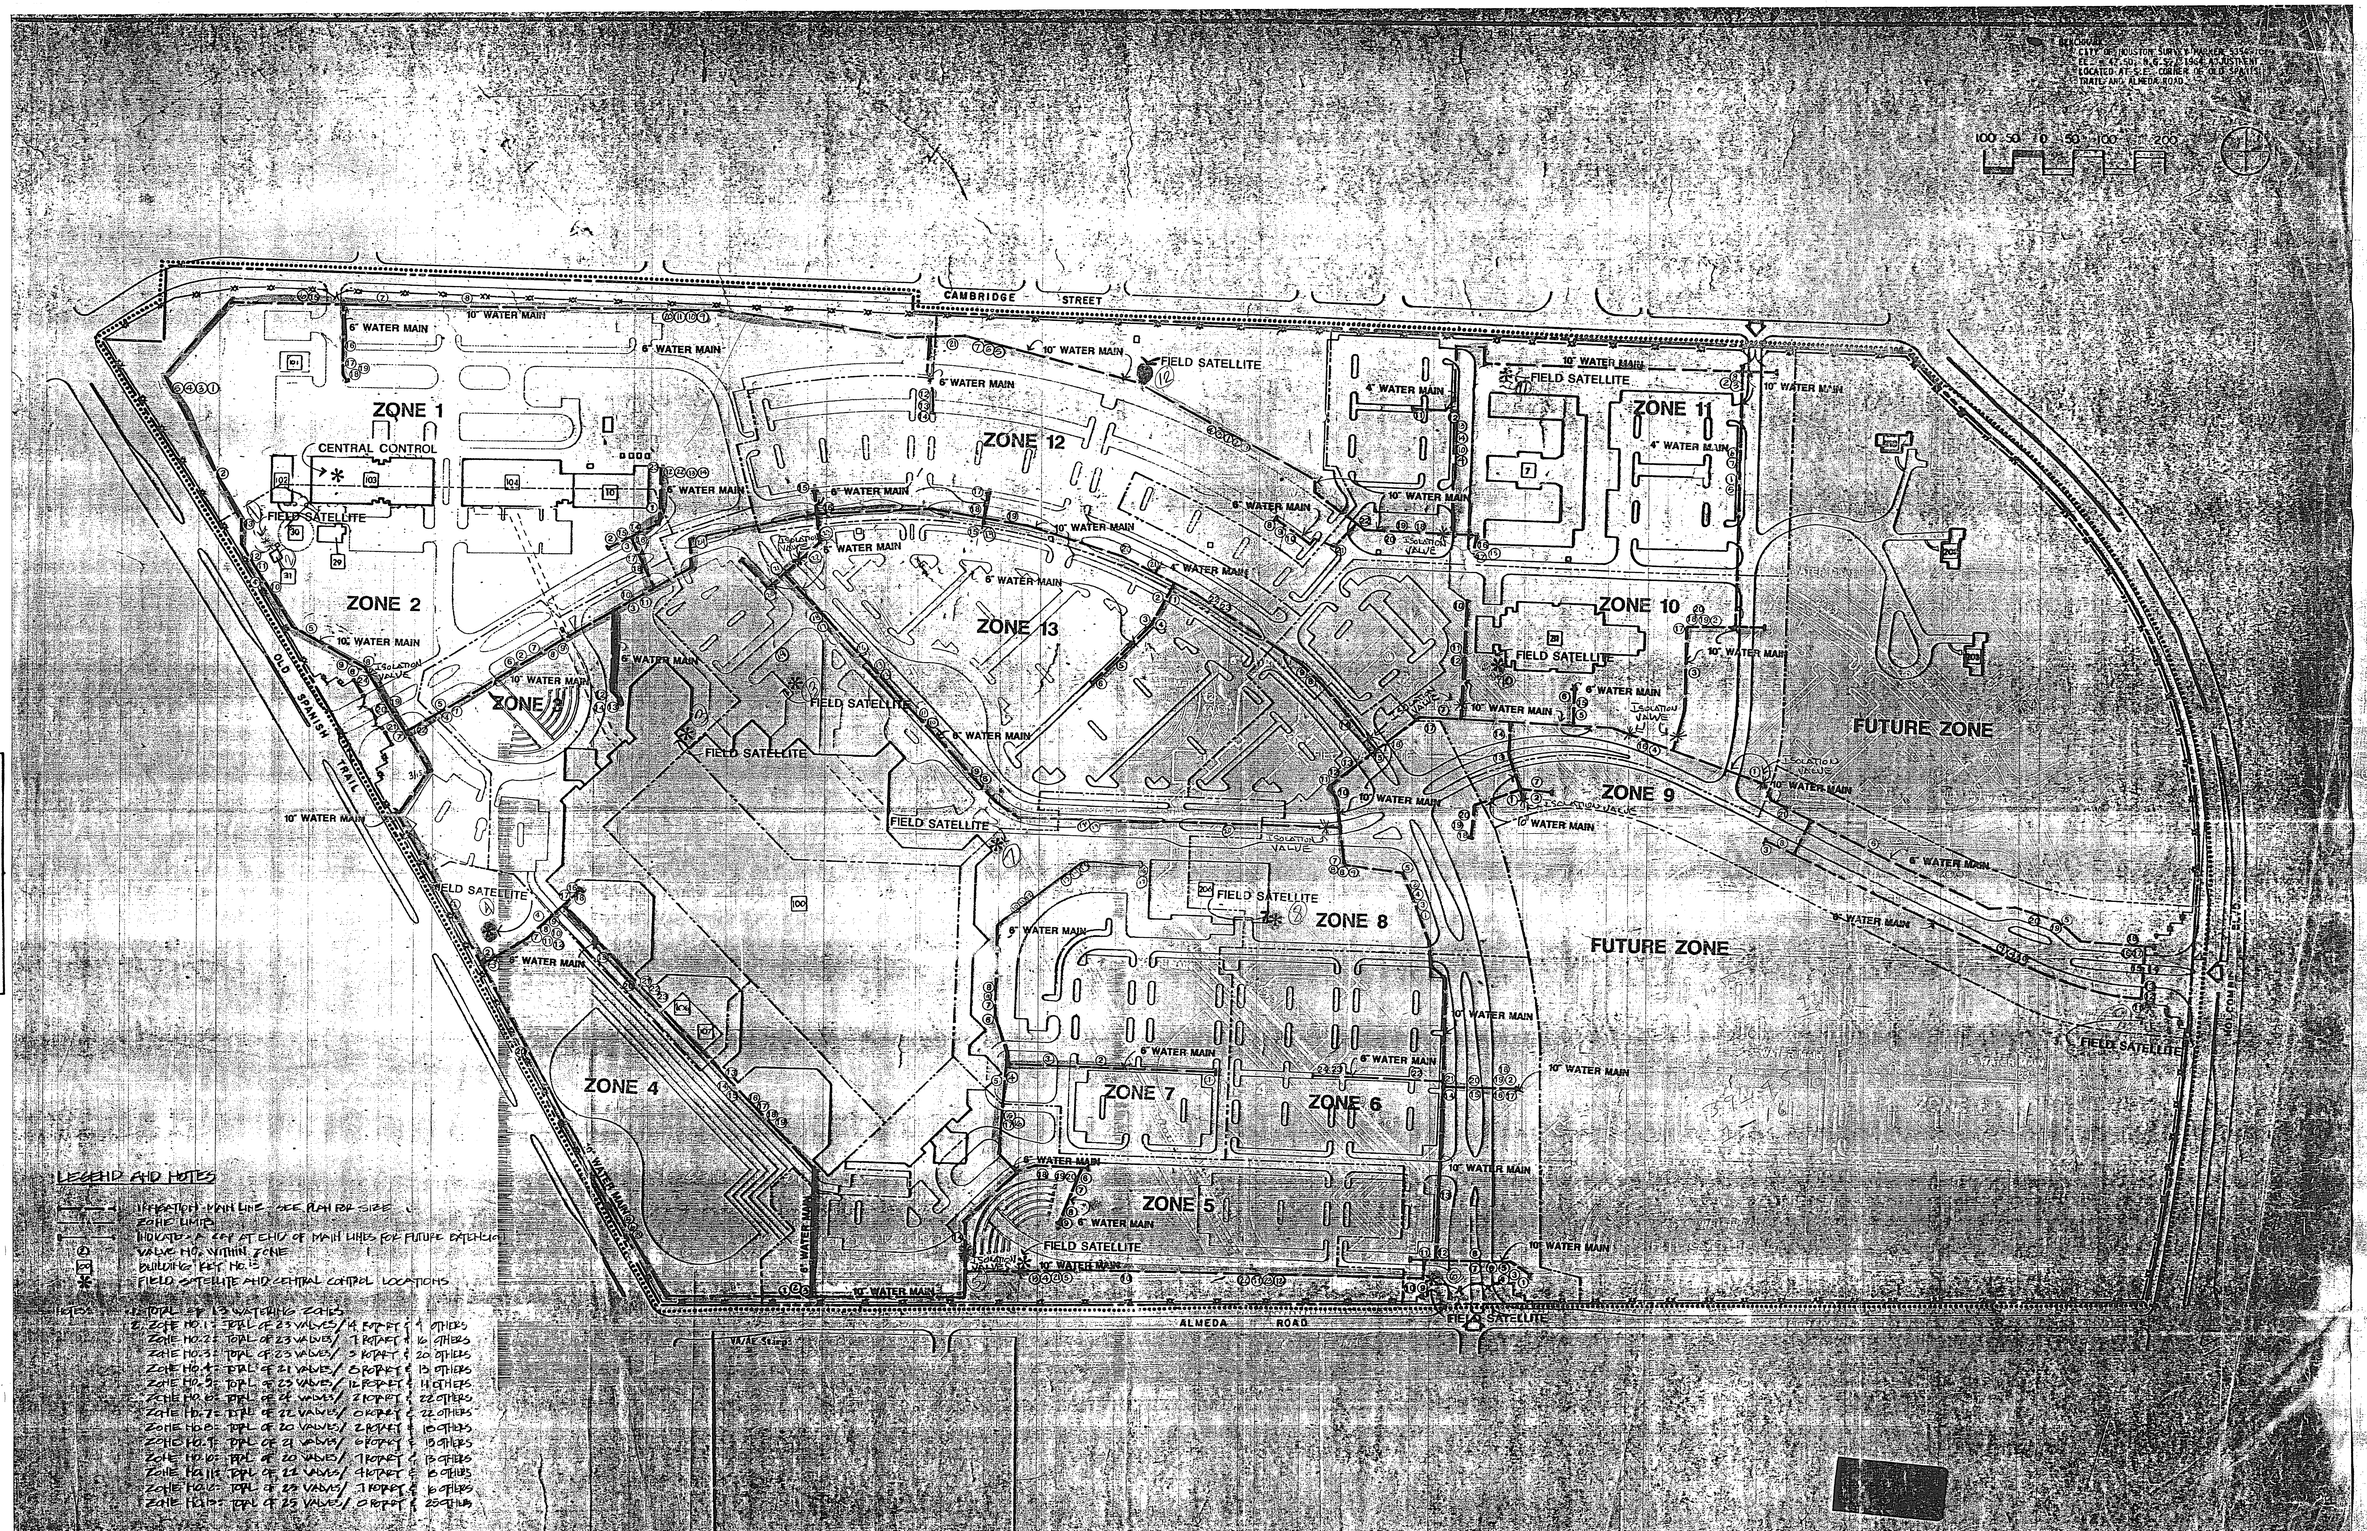

LEGEND AND NOTES

IRRIGATION MAIN LINE - SEE PLAN FOR SIZE
ZONE LIMITS
INDICATES A CAP AT END OF MAIN LINES FOR FUTURE EXTENSION
VALVE NO. WITHIN ZONE
BUILDING KEY NO. 13
FIELD SATELLITE AND CENTRAL CONTROL LOCATIONS

NOTES: 1. TOTAL OF 13 WATERING ZONES
2. ZONE NO. 1: TOTAL OF 23 VALVES/ 14 ROTARY & 9 OTHERS
ZONE NO. 2: TOTAL OF 23 VALVES/ 7 ROTARY & 16 OTHERS
ZONE NO. 3: TOTAL OF 23 VALVES/ 3 ROTARY & 20 OTHERS
ZONE NO. 4: TOTAL OF 21 VALVES/ 8 ROTARY & 13 OTHERS
ZONE NO. 5: TOTAL OF 23 VALVES/ 12 ROTARY & 11 OTHERS
ZONE NO. 6: TOTAL OF 24 VALVES/ 2 ROTARY & 22 OTHERS
ZONE NO. 7: TOTAL OF 22 VALVES/ 0 ROTARY & 22 OTHERS
ZONE NO. 8: TOTAL OF 20 VALVES/ 2 ROTARY & 18 OTHERS
ZONE NO. 9: TOTAL OF 21 VALVES/ 6 ROTARY & 15 OTHERS
ZONE NO. 10: TOTAL OF 20 VALVES/ 7 ROTARY & 13 OTHERS
ZONE NO. 11: TOTAL OF 22 VALVES/ 4 ROTARY & 18 OTHERS
ZONE NO. 12: TOTAL OF 23 VALVES/ 7 ROTARY & 16 OTHERS
ZONE NO. 13: TOTAL OF 25 VALVES/ 0 ROTARY & 25 OTHERS

alfred l. simpson & company, inc.
planted environments
5317 campbellton road • p.o. box 310025 • atlanta, ga. 30331 • (404) 349-1432
sheet of scale: date: drawn by:

REVISIONS			
No.	Date	Remarks	Date: 2 JAN 87
	19/APR/93	"AS BUILT"	Proj. No.: 500-040
			Bldg. No.:
			Spec No.:
			Drawn by:
			Scale: 1" = 100'-0"
			Sheet No.: W-25
			17 / 25

Replacement/Modernization
Phases II & III
VAMC Houston, Texas

Drawing Title IRRIGATION SITE PLAN ZONING

Refer Contract Dwg No.

Architect 3D/I--SMP | General Contractor--J. W. Watson Company, Inc.

Str Engr. Walter P. Moore & Associates | Mech Engr. Yandell & Hiller 3D/I