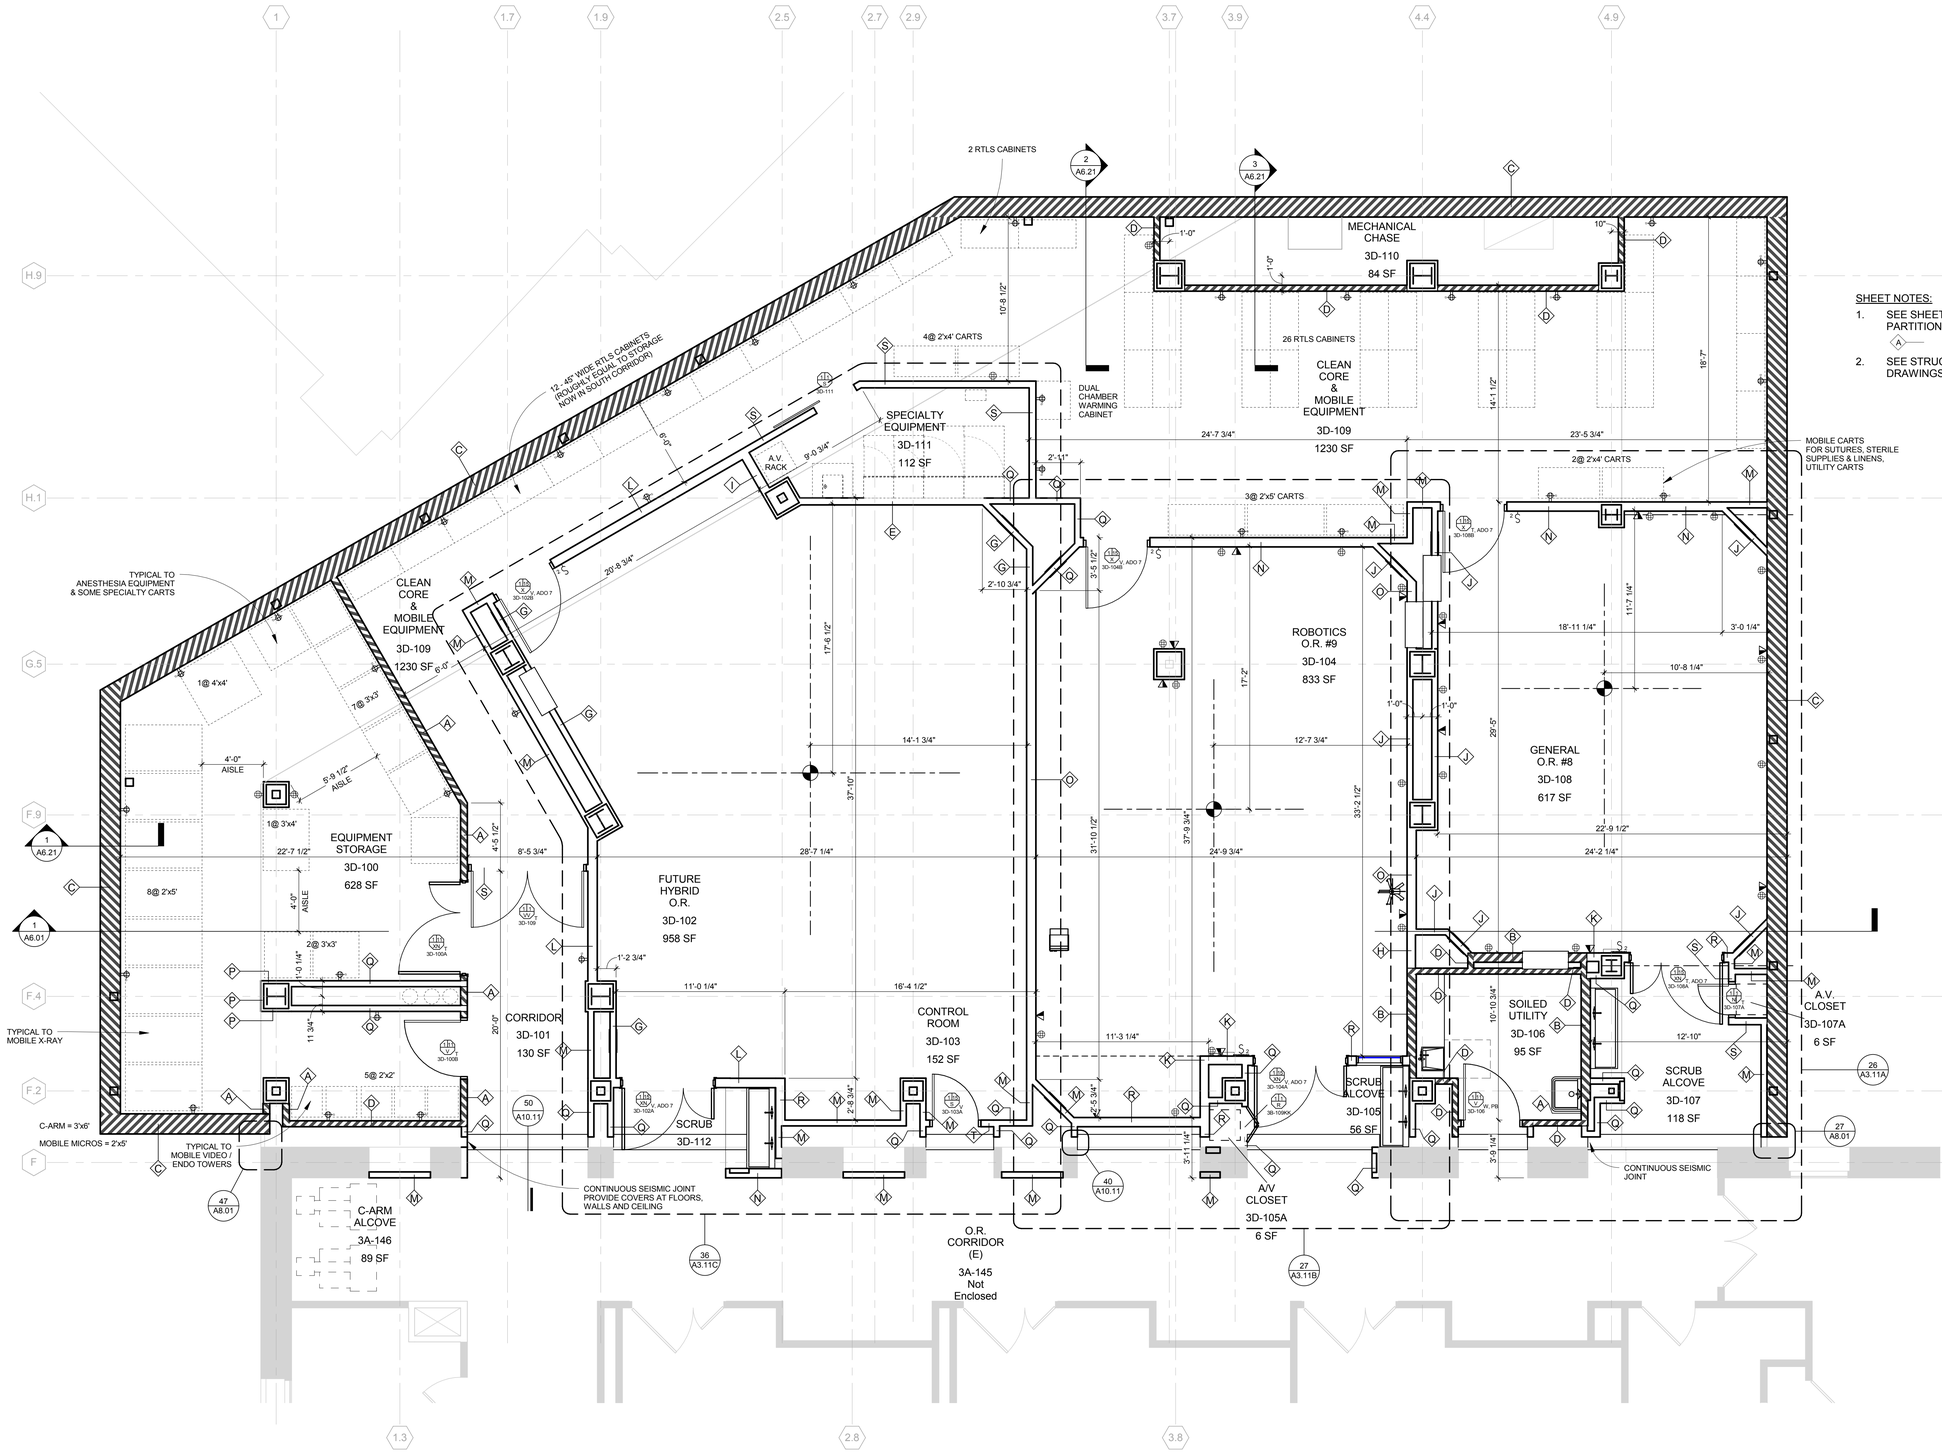

1 ENLARGED FLOOR PLAN - 3RD FLOOR B200 - OR EXPANSION

0 2' 4' 8'

FINAL BID DOCUMENTS

HILLIARD ARCHITECTS INC. COPYRIGHT

ADDENDUM 1	07/01/16
Revisions:	Date

CONSULTANTS:

ARCHITECT/ENGINEERS:

HILLIARD ARCHITECTS, INC
1330 Broadway, Suite 1111
Oakland, CA 94612
Tel 415 989 6400, Fax 415 989 3056
www.HilliardArchitects.com

Drawing Title: ENLARGED FLOOR PLAN - (N) 3RD FLOOR D-WING - OR EXPANSION

Approved: Project Director

Project Title: EXPAND CLINICAL OR AND SURGERY

Location: 4150 Clement Street

Date: 6/30/2016 | Checked: M.H. | Drawn: JC

Project Number: 662-618

Building Number: 200

Drawing Number: A3.01

Dwg. 18 of 143

Office of Construction and Facilities Management

Department of Veterans Affairs

VA FORM 08-6231

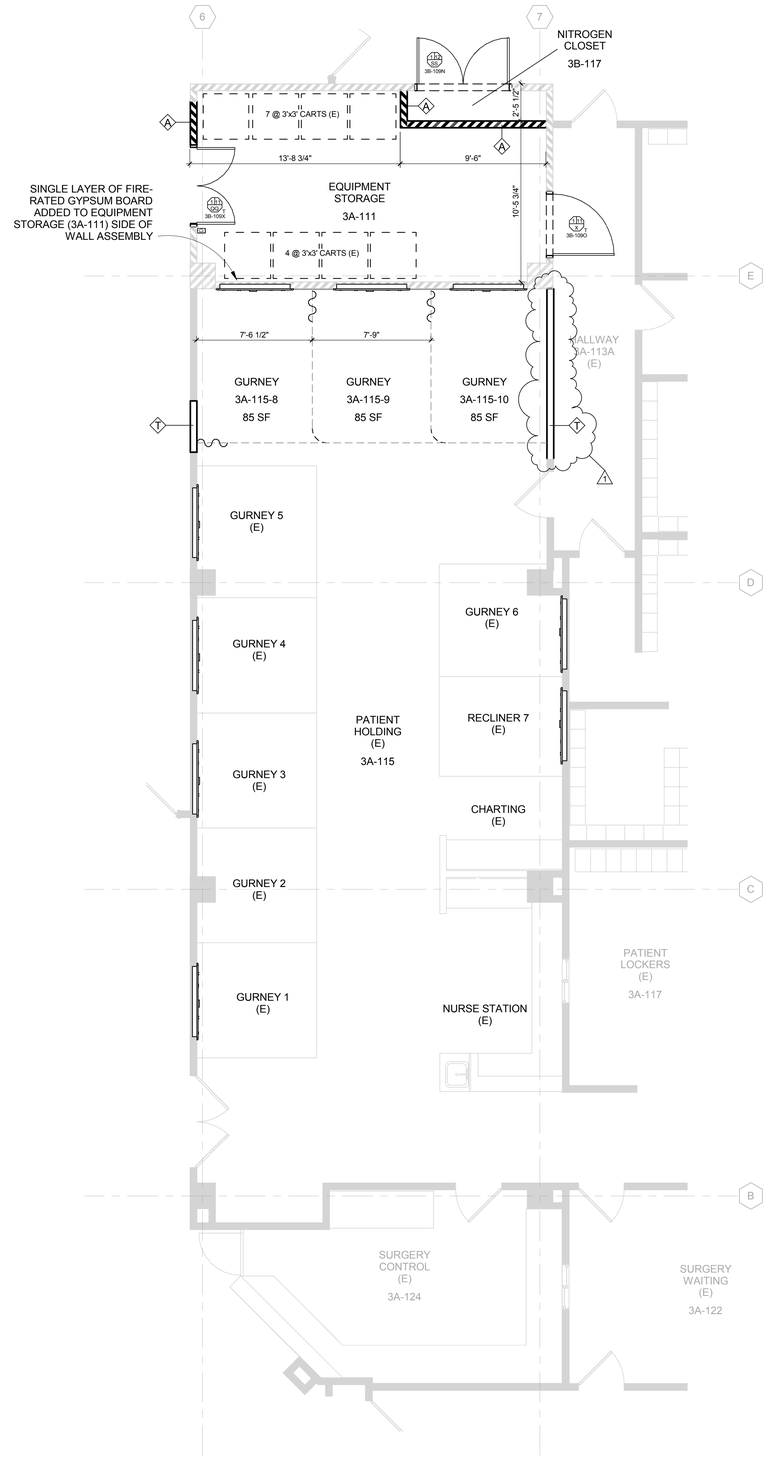

1 ENLARGED FLOOR PLAN - 3RD FLOOR B200 - PRE OP

0 2' 4' 8'

SHEET NOTES:

1. SEE SHEET A10.04 FOR PARTITION TYPES

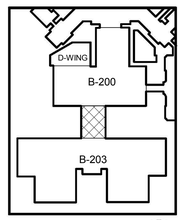

KEY PLAN

FINAL BID DOCUMENTS

HILLIARD ARCHITECTS INC. COPYRIGHT

ADDENDUM 1	07/01/16
Revisions:	Date

CONSULTANTS:

ARCHITECT/ENGINEERS:

HILLIARD ARCHITECTS, INC
1330 Broadway, Suite 1111
Oakland, CA 94612
Tel 415 989 6400, Fax 415 989 3056
www.HilliardArchitects.com

Drawing Title: **ENLARGED FLOOR PLAN - (N) 3RD FLOOR B200 - ASU PRE-OP SUITE RENOVATION**

Approved: Project Director

Project Title: **EXPAND CLINICAL OR AND SURGERY**

Location: 4150 Clement Street

Date: 6/30/2016 | Checked: M.H. | Drawn: JC

Project Number: 662-618

Building Number: 200

Drawing Number: A3.02

Dwg. 19 of 143

Office of Construction and Facilities Management

Department of Veterans Affairs

VA FORM 08-6231

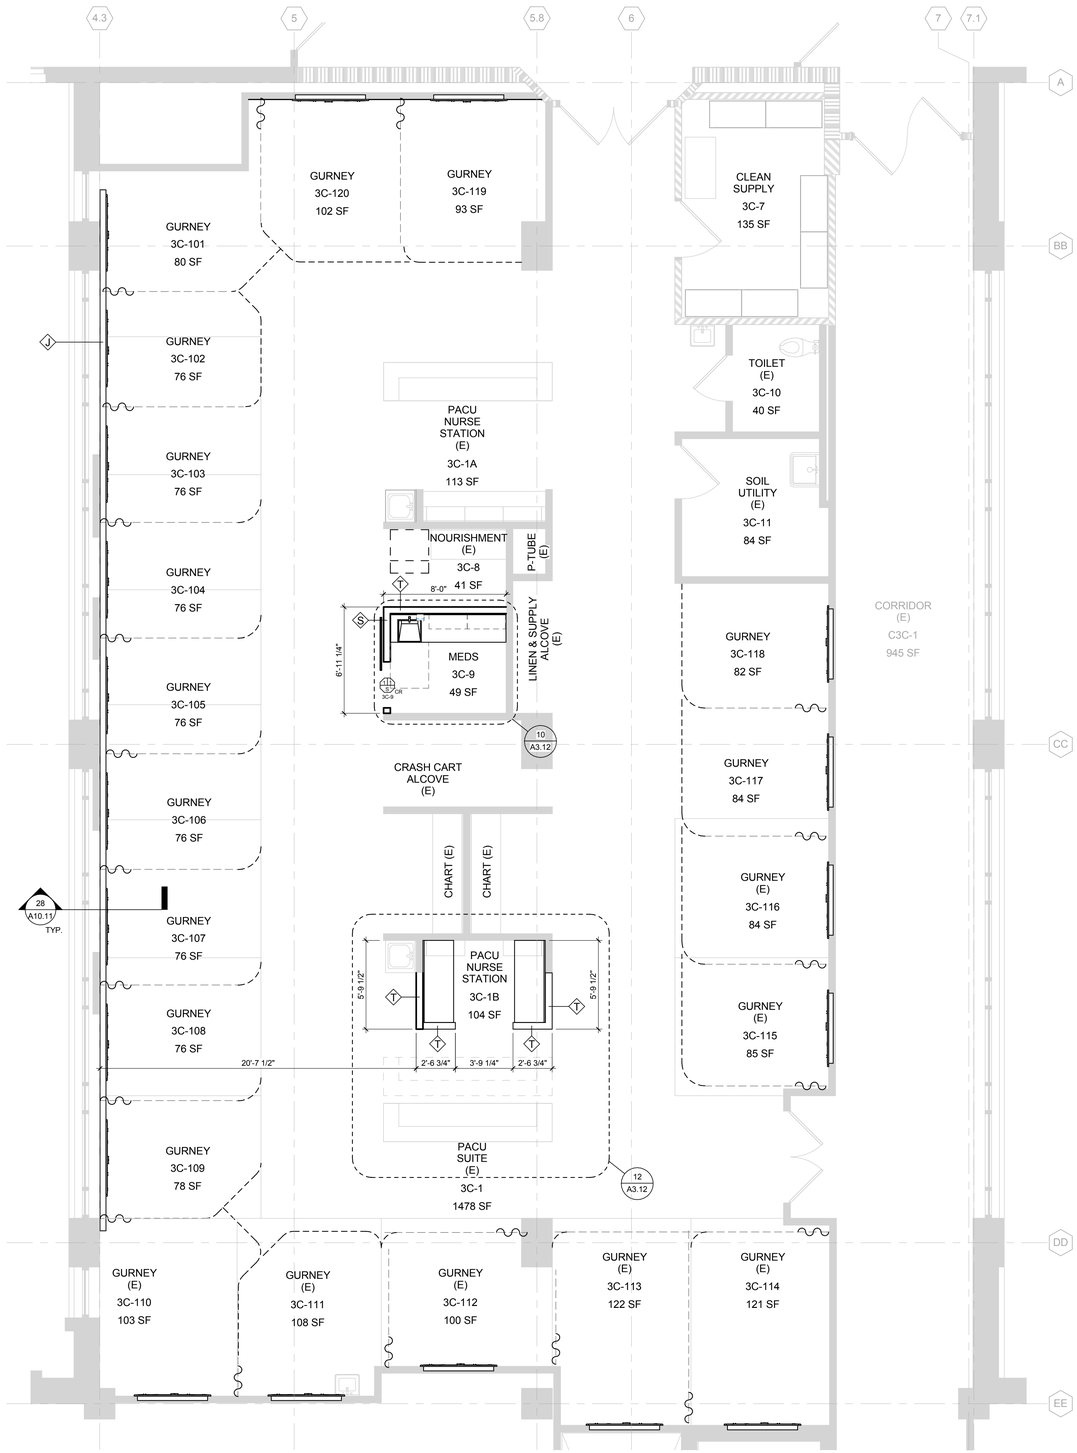

1 ENLARGED FLOOR PLAN - 3RD FLOOR B203 - ASU/PACU

0 2' 4' 8'

SHEET NOTES:

1. SEE SHEET A10.04 FOR PARTITION TYPES

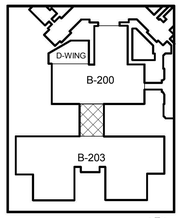

KEY PLAN

FINAL BID DOCUMENTS

HILLIARD ARCHITECTS INC. COPYRIGHT

ADDENDUM 1	07/01/16
Revisions:	Date

CONSULTANTS:

ARCHITECT/ENGINEERS:

ESTABLISHED 1988 HILLIARD ARCHITECTS GOING GREEN

HILLIARD ARCHITECTS, INC
1330 Broadway, Suite 1111
Oakland, CA 94612
Tel 415 989 6400, Fax 415 989 3056
www.HilliardArchitects.com

Drawing Title: **ENLARGED FLOOR PLAN - 3RD FLOOR B203 - PACU RENOVATION**

Approved: Project Director

Project Title: **EXPAND CLINICAL OR AND SURGERY**

Location: 4150 Clement Street

Date: **6/30/2016** | Checked: **M.H.** | Drawn: **JC**

Project Number: **662-618**

Building Number: **200**

Drawing Number: **A3.03**

Dwg. **20** of **143**

Office of Construction and Facilities Management

Department of Veterans Affairs

VA FORM 08-6231

14 STAFF LOUNGE PERSPECTIVE

EQUIPMENT SCHEDULE - CLINIC RENOVATION					
Furnished/Installed	Room: Number	Room: Name	Equip. No.	Description	Count
					9
VC	3A-163	STAFF LOUNGE	004	Dishwasher	1
VV	3A-163	STAFF LOUNGE	005	Coffee Maker	1
VV	3A-163	STAFF LOUNGE	006	Microwave Oven	1
CC	3A-163	STAFF LOUNGE	007	Side by Side Refrigerator	1
CC			010	Ceiling Curtain Track	3
VV			013	Dispenser, Glove, Triple Box	3
VV			014	Disposal, Sharps, Wall Mount	3
VV			023	Mobile Stool	3
CC			081	Wall Mounted Paper Towel Dispenser	4
VV			082	Wall Mounted Soap Dispenser	4
VV			090	Sphgmomanometer	3
VV			100	Otoscope	3
VV			101	Exam Table	3
VC			102	WORK STATION	3
VV			103	Portable Examining Light	3
VV			104	Basket, Waste	3
CC	3B-115	WAITING	112	CPU HOLDER	1
CC	3B-115	WAITING	113	MONITOR ARM	1
CC	3B-115	WAITING	114	CPU	1

"FURNISHED/INSTALLED" KEY:
CC = CONTRACTOR FURNISHED & INSTALLED
VC = VA FURNISHED, CONTRACTOR INSTALLED
VV = VA FURNISHED & INSTALLED

SHEET NOTES:
1. SEE SHEET A10.04 FOR PARTITION TYPES

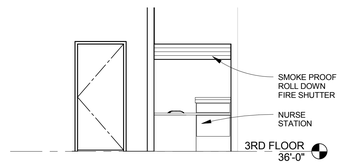

24 RECEPTION AREA
0 2' 4' 8'

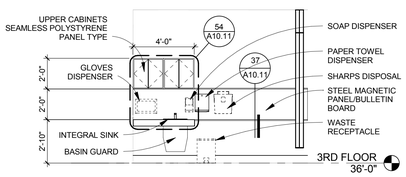

42 TYP. EXAM ROOM - NORTH
0 2' 4' 8'

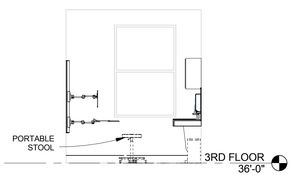

44 TYP. EXAM ROOM - WEST
0 2' 4' 8'

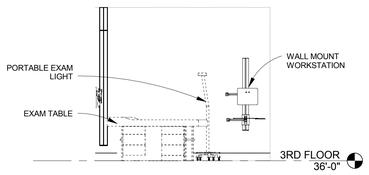

52 TYP. EXAM ROOM - SOUTH
0 2' 4' 8'

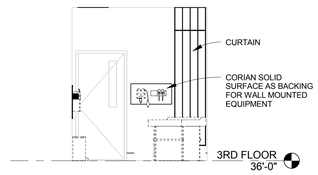

54 TYP. EXAM ROOM - EAST
0 2' 4' 8'

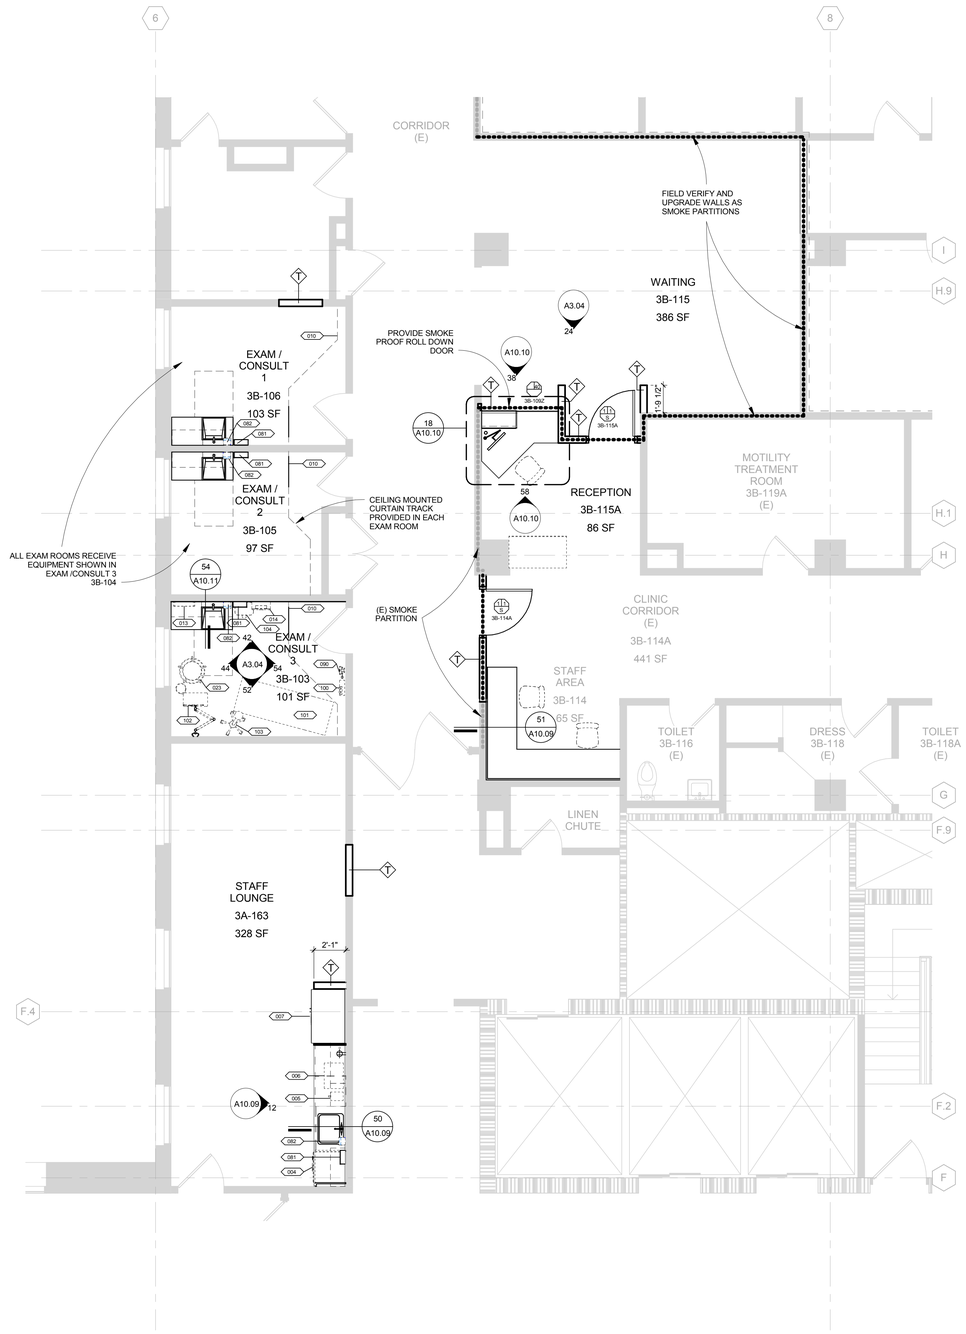

56 ENLARGED FLOOR PLAN - 3RD FLOOR B200 - CLINIC RENOVATION
0 2' 4' 8'

NOTE:
ADD HANDRAIL TO MATCH EXISTING AT PATCHED CORRIDOR WALL

FINAL BID DOCUMENTS

HILLIARD ARCHITECTS INC. COPYRIGHT

Revisions:	Date
ADDENDUM 1	07/01/16

CONSULTANTS:

ARCHITECT/ENGINEERS:

HILLIARD ARCHITECTS, INC
1330 Broadway, Suite 1111
Oakland, CA 94612
Tel 415 989 6400, Fax 415 989 3056
www.HilliardArchitects.com

Drawing Title: ENLARGED FLOOR PLAN - (N) 3RD FLOOR B200 - CLINIC RENOVATION

Approved: Project Director

Project Title: EXPAND CLINICAL OR AND SURGERY

Location: 4150 Clement Street

Date: 6/30/2016 | Checked: M.H. | Drawn: JC

Project Number: 662-618

Building Number: 200

Drawing Number: A3.04

Dwg. 21 of 143

Office of Construction and Facilities Management

Department of Veterans Affairs

VA FORM 08-6231

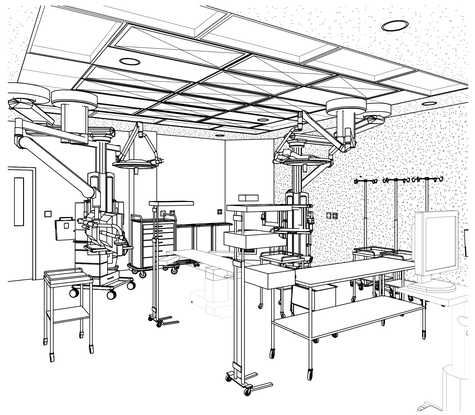

14 INTERIOR VIEW GENERAL O.R.#8
N.T.S.

EQUIPMENT SCHEDULE - OR#8				
Furnished /Installed	Room: Name	Equip. No.	Description	Count
VV	GENERAL O.R. #8	011	Cart, Case, Medium (40-49in wide)	1
VV	GENERAL O.R. #8	012	Anesthesia Machine w/ GE Monitoring and PICIS Charting Workstation	1
VV	GENERAL O.R. #8	013	Dispenser, Glove, Triple Box	2
VV	GENERAL O.R. #8	014	Disposal, Sharps, Wall Mount	2
VC	GENERAL O.R. #8	016	Cart, Anesthesia, 6-drawer	1
VV	GENERAL O.R. #8	017	Hamper, Linen	6
VV	GENERAL O.R. #8	022	Whiteboard, 36"x 36"	1
VC	GENERAL O.R. #8	026	Computer Workstation on Wheels	1
VC	GENERAL O.R. #8	030	Large Monitor, 42"	3
CC	GENERAL O.R. #8	035	O.R. Light Controls	1
CC	GENERAL O.R. #8	037	Digital Elapsed Time Clock	1
VV	GENERAL O.R. #8	038	Wall Mounted Telephone	1
VV	GENERAL O.R. #8	041	Bucket, Kick	2
VC	GENERAL O.R. #8	060	Dispenser, Supply, Host	1
VC	GENERAL O.R. #8	065	AUR7 Surgical Light - One Head	2
VC	GENERAL O.R. #8	066	EQ_Boom_Equipment_Dual Arm(maquet)_C-152894	1
VC	GENERAL O.R. #8	067	EQ_Boom, Anesthesia(MAQUET)_6400-000	1
VV	GENERAL O.R. #8	071	Stand, Basin, Single	1
VV	GENERAL O.R. #8	072	Disposal, Sharps, Floor Cart	2
VV	GENERAL O.R. #8	073	Stand, IV, Stainless Steel	2
VV	GENERAL O.R. #8	074	Warmer, Fluid/Blood, Portable	1
VV	GENERAL O.R. #8	075	Table, Utility, General Purpose	4
VV	GENERAL O.R. #8	076	Table, Instrument, 72 inch	1
VC	GENERAL O.R. #8	077	EQ_Electrosurgical Unit_Bipolar_4824-012	1
VC	GENERAL O.R. #8	078	EQ_Camera_Headlight System_6199-002	1
VV	GENERAL O.R. #8	079	EQ_Stand_Mayo_Foot-Operated_6260-004	2
VV	GENERAL O.R. #8	084	Bracket, Patient Transfer Device	1
VV	GENERAL O.R. #8	085	Stool, Step	2
VV	GENERAL O.R. #8	086	Stool, Step, Stackable	2
VC	GENERAL O.R. #8	087	EQ_Monitor_Physiologic_Anesthesia_4794-041	1
VC	GENERAL O.R. #8	088	Oximeter, Cerebral	1
VC	GENERAL O.R. #8	089	Headlight, w/Light Source	1

EQUIPMENT SCHEDULE - SOILED UTILITY				
Furnished /Installed	Room: Name	Equip. No.	Description	Count
VC	SOILED UTILITY	046	Neptune Waste Docking/Flushing System #1	1
VC	SOILED UTILITY	047	Neptune Waste Docking/Flushing System #2	1
CC	SOILED UTILITY	081	Wall Mounted Paper Towel Dispenser	1
VV	SOILED UTILITY	082	Wall Mounted Soap Dispenser	2

"FURNISHED/INSTALLED" KEY:
CC = CONTRACTOR FURNISHED & INSTALLED
VC = VA FURNISHED, CONTRACTOR INSTALLED
VV = VA FURNISHED & INSTALLED

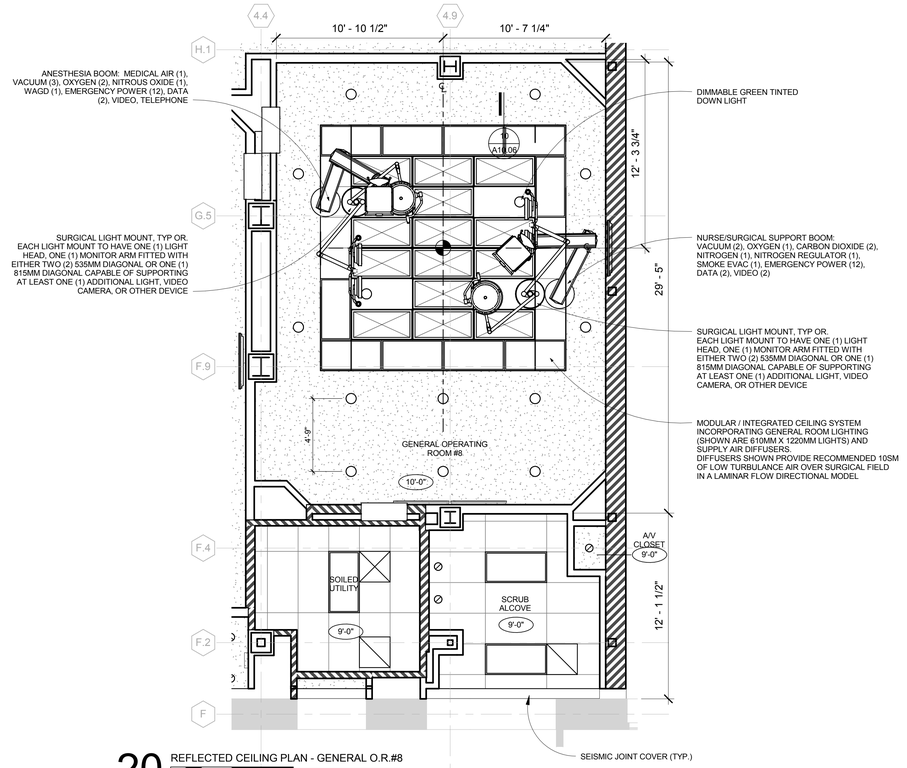

20 REFLECTED CEILING PLAN - GENERAL O.R.#8

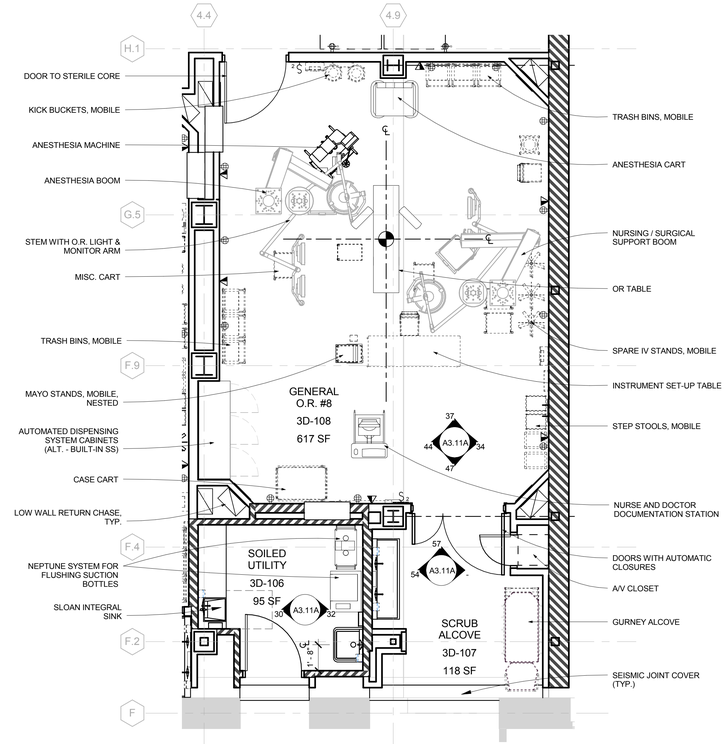

26 DETAIL FLOOR PLAN - GENERAL O.R.#8

SHEET NOTES:
1. SEE SHEET A10.11 FOR BACKING PLATE DETAILS

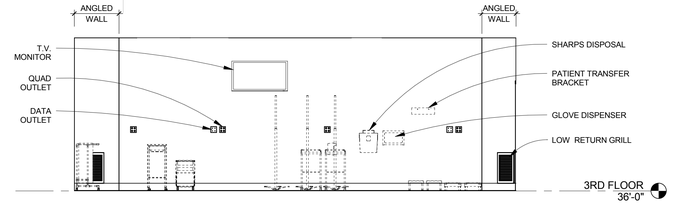

34 O.R.#8 - VIEW EAST

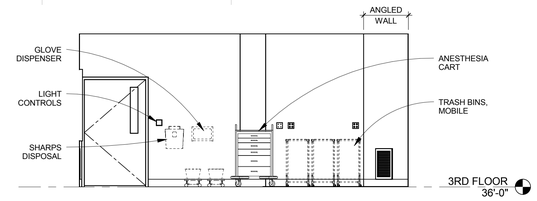

37 O.R.#8 - VIEW NORTH

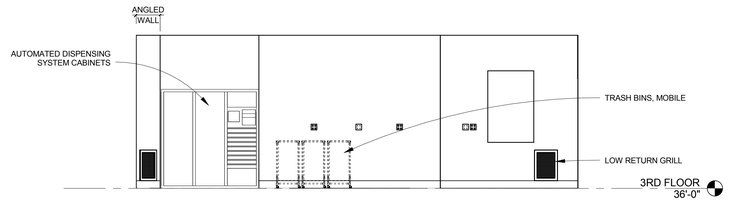

44 O.R.#8 - VIEW WEST

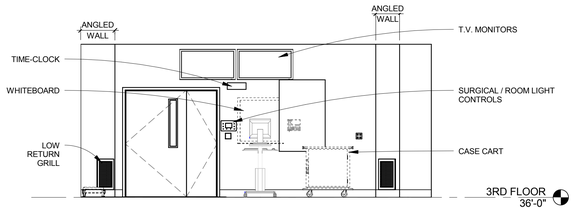

47 O.R.#8 - VIEW SOUTH

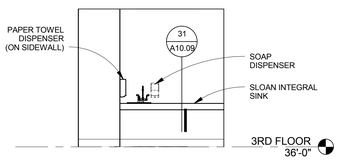

30 SOILED UTILITY - VIEW WEST

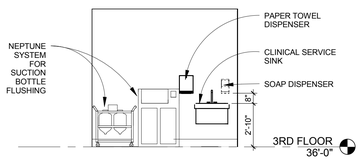

32 SOILED UTILITY - VIEW EAST

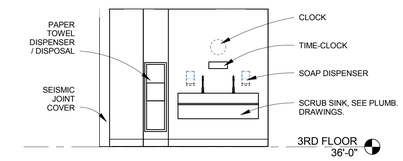

54 SCRUB ALCOVE O.R.#8 - WEST

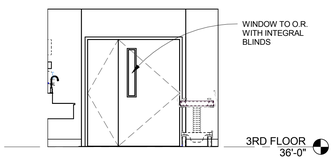

57 SCRUB ALCOVE O.R.#8 - NORTH

FINAL BID DOCUMENTS

HILLIARD ARCHITECTS INC. COPYRIGHT

Revisions:	Date
ADDENDUM 1	07/01/16

CONSULTANTS:

ARCHITECT/ENGINEERS:

HILLIARD ARCHITECTS, INC
1330 Broadway, Suite 1111
Oakland, CA 94612
Tel 415 989 6400, Fax 415 989 3056
www.HilliardArchitects.com

Drawing Title: GENERAL O.R.#8 DETAIL PLANS & ELEVATIONS

Approved: Project Director

Project Title: EXPAND CLINICAL OR AND SURGERY

Location: 4150 Clement Street

Date: 6/30/2016 | Checked: M.H. | Drawn: JC

Project Number: 662-618

Building Number: 200

Drawing Number: A3.11A

Dwg. 22 of 143

Office of Construction and Facilities Management

Department of Veterans Affairs

VA FORM 08-6231

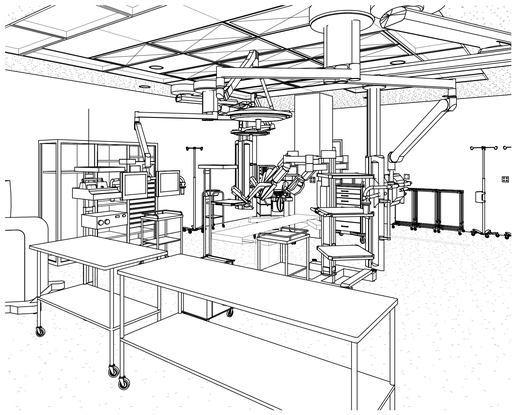

14 INTERIOR VIEW ROBOTICS O.R.#9
N.T.S.

EQUIPMENT SCHEDULE - OR#9				
Furnished /Installed	Room: Name	Equip. No.	Description	Count
VV	ROBOTICS O.R. #9	011	Cart, Case, Medium (40-49in wide)	1
VV	ROBOTICS O.R. #9	012	Anesthesia Machine w/ GE Monitoring and PICIS Charting Workstation	1
VV	ROBOTICS O.R. #9	013	Dispenser, Glove, Triple Box	2
VV	ROBOTICS O.R. #9	014	Disposal, Sharps, Wall Mount	2
VC	ROBOTICS O.R. #9	016	Cart, Anesthesia, 6-drawer	1
VV	ROBOTICS O.R. #9	017	Hamper, Linen	6
VV	ROBOTICS O.R. #9	022	Whiteboard, 36"x 36"	1
VV	ROBOTICS O.R. #9	023	Mobile Stool	1
VC	ROBOTICS O.R. #9	026	Computer Workstation on Wheels	1
VC	ROBOTICS O.R. #9	030	Large Monitor, 42"	3
CC	ROBOTICS O.R. #9	035	O.R. Light Controls	1
CC	ROBOTICS O.R. #9	037	Digital Elapsed Time Clock	1
VV	ROBOTICS O.R. #9	038	Wall Mounted Telephone	1
VV	ROBOTICS O.R. #9	041	Bucket, Kick	2
VV	ROBOTICS O.R. #9	049	Wall Mounted Clock	1
VC	ROBOTICS O.R. #9	060	Dispenser, Supply, Host	1
VC	ROBOTICS O.R. #9	065	AUR7 Surgical Light - One Head	2
VC	ROBOTICS O.R. #9	066	EQ_Boom_Equipment_Dual Arm(maquet)_C-152894	1
VC	ROBOTICS O.R. #9	067	EQ_Boom, Anesthesia(MAQUET)_6400-000	1
VV	ROBOTICS O.R. #9	071	Stand, Basin, Single	1
VV	ROBOTICS O.R. #9	072	Disposal, Sharps, Floor Cart	1
VV	ROBOTICS O.R. #9	073	Stand, IV, Stainless Steel	2
VV	ROBOTICS O.R. #9	074	Warmer, Fluid/Blood, Portable	2
VV	ROBOTICS O.R. #9	075	Table, Utility, General Purpose	4
VV	ROBOTICS O.R. #9	076	Table, Instrument, 72 inch	1
VC	ROBOTICS O.R. #9	077	EQ_Electrosurgical Unit_Bipolar_4824-012	1
VC	ROBOTICS O.R. #9	078	EQ_Camera_Headlight System_6199-002	1
VV	ROBOTICS O.R. #9	079	EQ_Stand_Mayo_Foot-Operated_6260-004	3
VV	ROBOTICS O.R. #9	085	Stool, Step	2
VV	ROBOTICS O.R. #9	086	Stool, Step, Stackable	2
VC	ROBOTICS O.R. #9	088	Oximeter, Cerebral	1
VC	ROBOTICS O.R. #9	089	Headlight, w/Light Source	1
VC	ROBOTICS O.R. #9	091	Vision System Power Cart, da Vinci	1
VC	ROBOTICS O.R. #9	092	Surgeon Control Console #1, da Vinci	1
VC	ROBOTICS O.R. #9	093	Robotic Instrument, da Vinci	1
VC	ROBOTICS O.R. #9	094	EQ_Slush Maker_Saline_4339-003	1
VC	ROBOTICS O.R. #9	095	Defibrillator Heartstart MRX, Monitor, w/Pacemaker	1
VV	ROBOTICS O.R. #9	096	Table, Instrument, 48 in	1

"FURNISHED/INSTALLED" KEY:
CC = CONTRACTOR FURNISHED & INSTALLED
VC = VA FURNISHED, CONTRACTOR INSTALLED
VV = VA FURNISHED & INSTALLED

SHEET NOTES:
1. SEE SHEET A10.11 FOR BACKING PLATE DETAILS

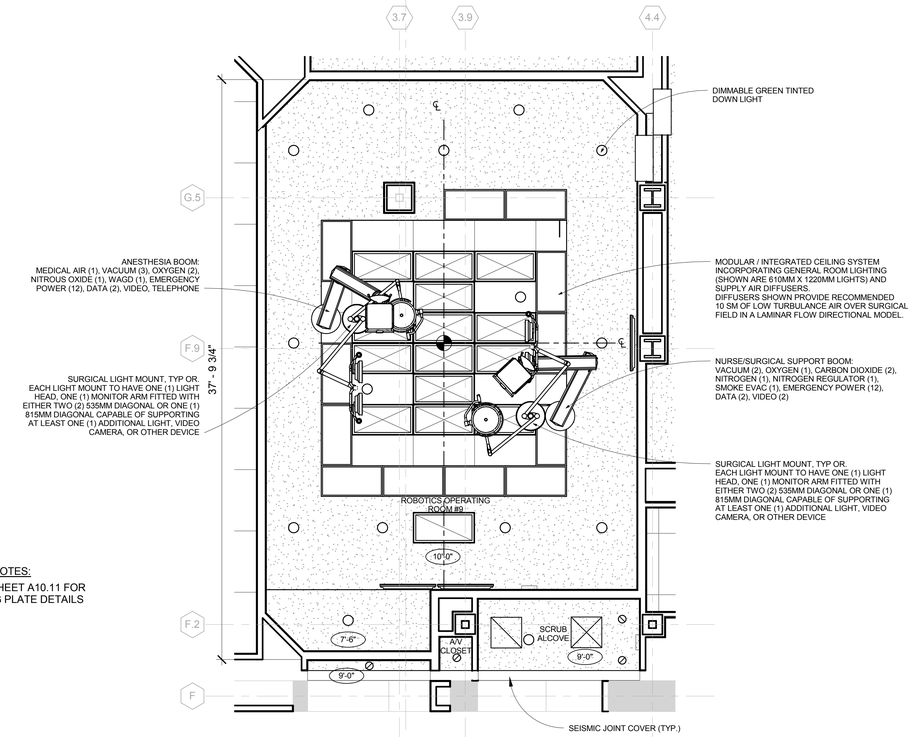

20 REFLECTED CEILING PLAN -ROBOTICS O.R.#9
0 2' 4' 8'

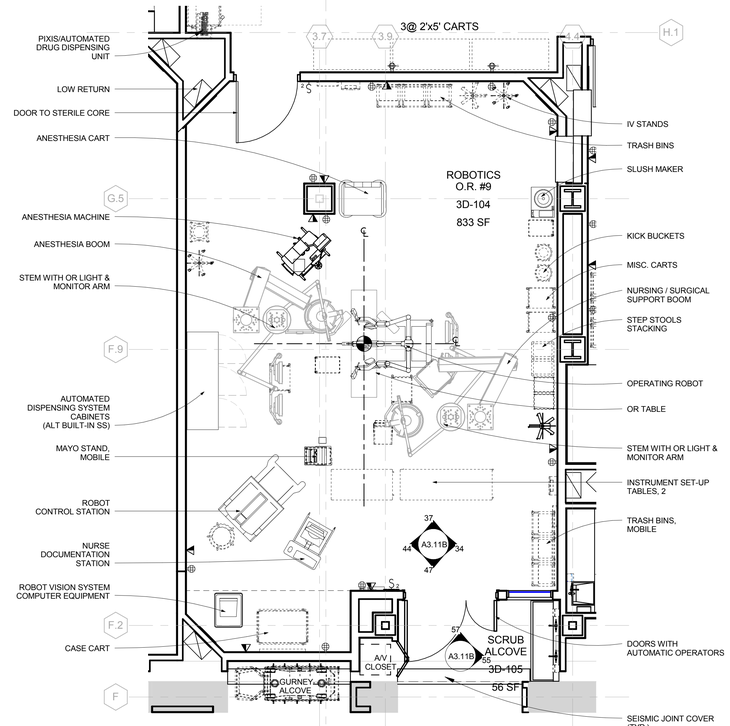

27 DETAIL FLOOR PLAN - ROBOTICS O.R.#9
0 2' 4' 8'

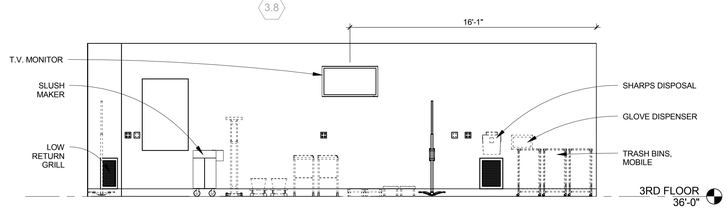

34 O.R.#9 - VIEW EAST
0 2' 4' 8'

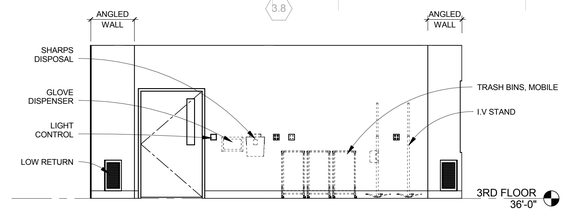

37 O.R.#9 - VIEW NORTH
0 2' 4' 8'

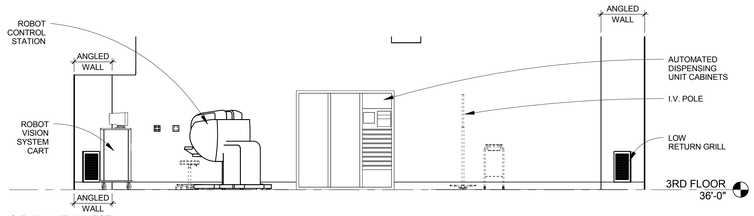

44 O.R.#9 - VIEW WEST
0 2' 4' 8'

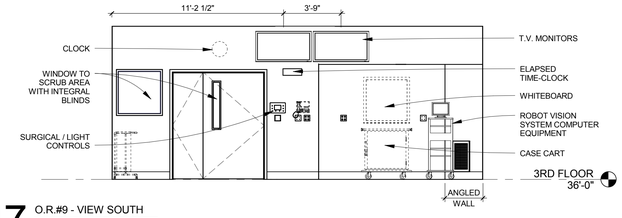

47 O.R.#9 - VIEW SOUTH
0 2' 4' 8'

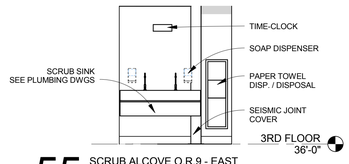

55 SCRUB ALCOVE O.R.9 - EAST
0 2' 4' 8'

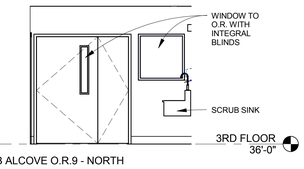

57 SCRUB ALCOVE O.R.9 - NORTH
0 2' 4' 8'

FINAL BID DOCUMENTS

HILLIARD ARCHITECTS INC. COPYRIGHT

Revisions:	Date
ADDENDUM 1	07/01/16

CONSULTANTS:

ARCHITECT/ENGINEERS:

HILLIARD ARCHITECTS, INC
1330 Broadway, Suite 1111
Oakland, CA 94612
Tel 415 989 6400, Fax 415 989 3056
www.HilliardArchitects.com

Drawing Title: **ROBOTICS O.R.#9 DETAIL PLANS & ELEVATIONS**

Approved: Project Director

Project Title: **EXPAND CLINICAL OR AND SURGERY**

Location: 4150 Clement Street

Date: 6/30/2016 | Checked: M.H. | Drawn: JC

Project Number: 662-618

Building Number: 200

Drawing Number: **A3.11B**

Dwg. 23 of 143

Office of Construction and Facilities Management

Department of Veterans Affairs

VA FORM 08-6231

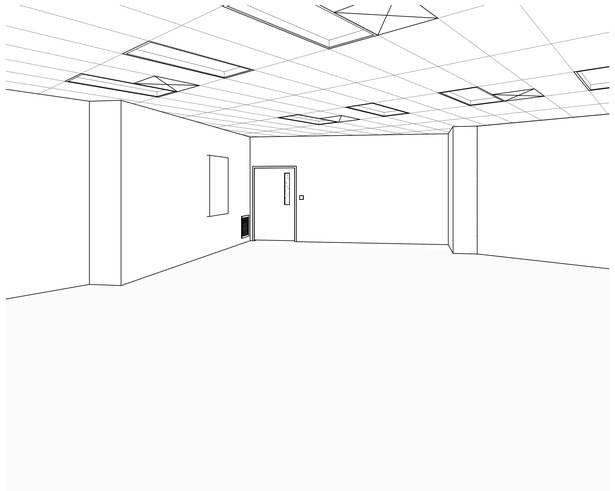

20 INTERIOR VIEW FUTURE HYBRID O.R.
N.T.S.

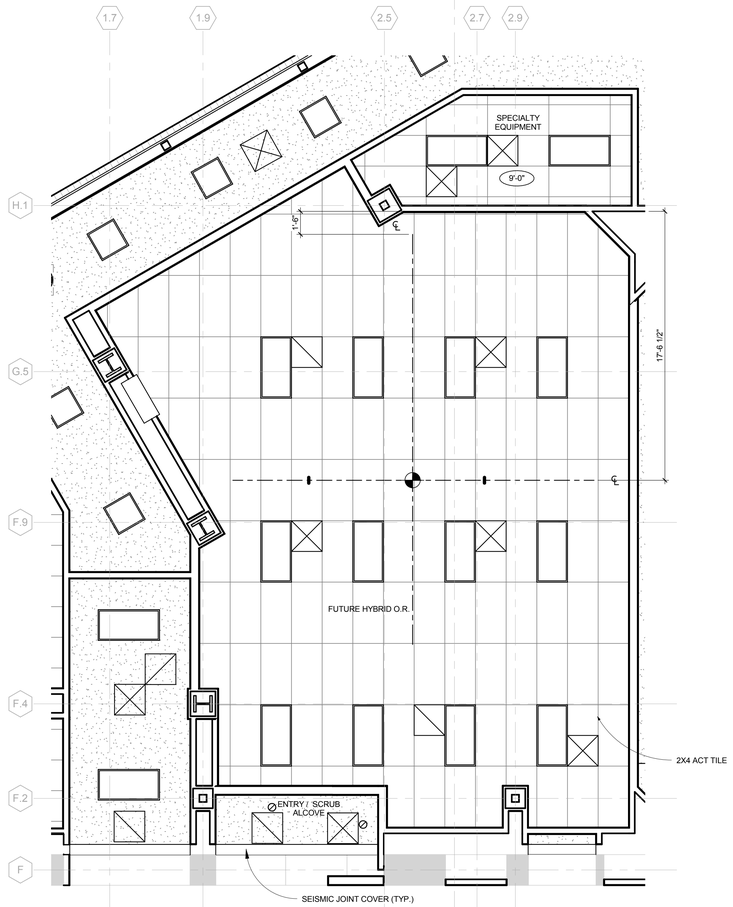

33 REFLECTED CEILING PLAN - FUTURE HYBRID O.R.
0 2' 4' 8'

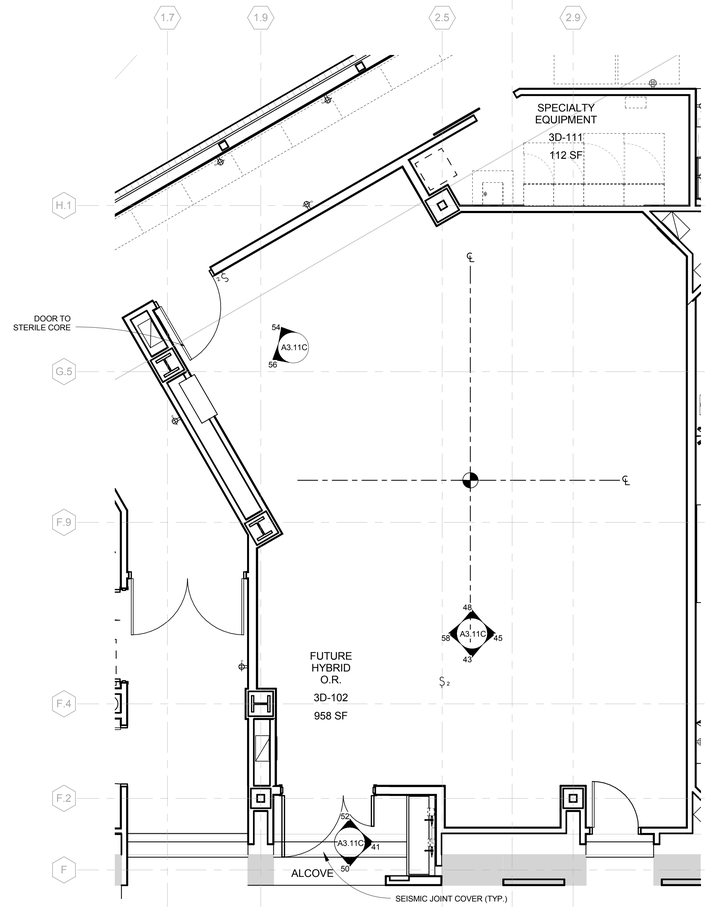

36 DETAIL FLOOR PLAN - FUTURE HYBRID O.R.
0 2' 4' 8'

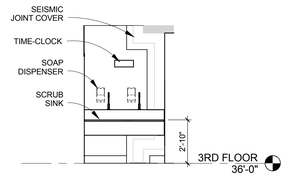

40 SCRUB ALCOVE O.R. - EAST
0 2' 4' 8'

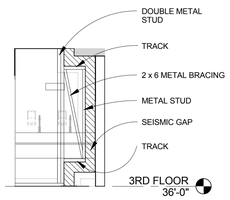

41 STRUCTURAL - SCRUB ALCOVE O.R. - EAST
0 2' 4' 8'

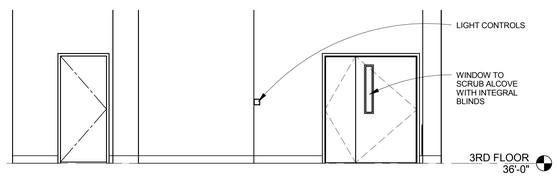

43 FUTURE HYBRID O.R. - VIEW SOUTH
0 2' 4' 8'

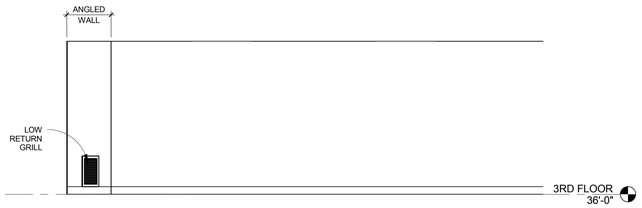

45 FUTURE HYBRID O.R. - VIEW EAST
0 2' 4' 8'

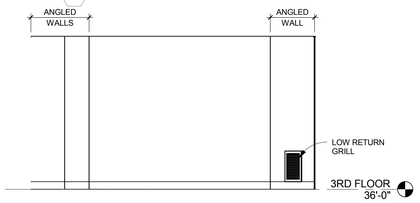

48 FUTURE HYBRID O.R. - VIEW NORTH
0 2' 4' 8'

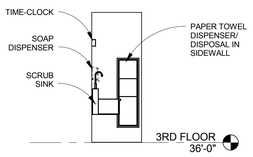

50 SCRUB ALCOVE O.R. - SOUTH
0 2' 4' 8'

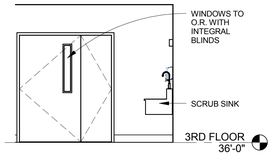

52 SCRUB ALCOVE O.R. - NORTH
0 2' 4' 8'

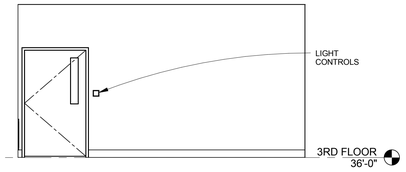

54 FUTURE HYBRID O.R. - VIEW NORTHWEST
0 2' 4' 8'

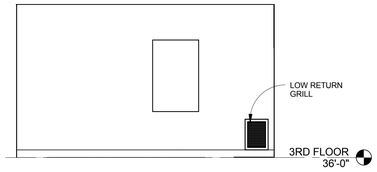

56 FUTURE HYBRID O.R. - VIEW SOUTHWEST
0 2' 4' 8'

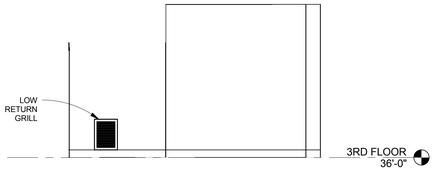

58 FUTURE HYBRID O.R. - VIEW WEST
0 2' 4' 8'

FINAL BID DOCUMENTS

HILLIARD ARCHITECTS INC. COPYRIGHT

Revisions:	Date
ADDENDUM 1	07/01/16

CONSULTANTS:

ARCHITECT/ENGINEERS:

HILLIARD ARCHITECTS, INC
1330 Broadway, Suite 1111
Oakland, CA 94612
Tel 415 989 6400, Fax 415 989 3056
www.HilliardArchitects.com

Drawing Title: FUTURE HYBRID O.R. DETAIL PLANS & ELEVATIONS

Approved: Project Director

Project Title: EXPAND CLINICAL OR AND SURGERY

Location: 4150 Clement Street

Date: 6/30/2016 | Checked: M.H. | Drawn: JC

Project Number: 662-618

Building Number: 200

Drawing Number: A3.11C

Dwg. 24 of 143

Office of Construction and Facilities Management

Department of Veterans Affairs

VA FORM 08-6231

10 MEDICATION ROOM PERSPECTIVE
N.T.S.

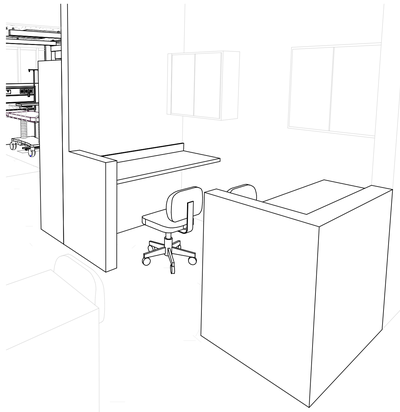

12 PACU NURSE STATION PERSPECTIVE
N.T.S.

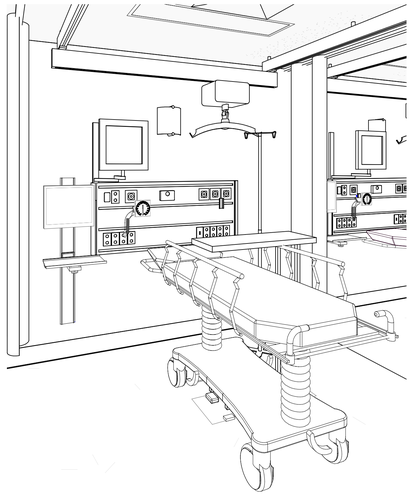

14 PACU STATION - VIEW
N.T.S.

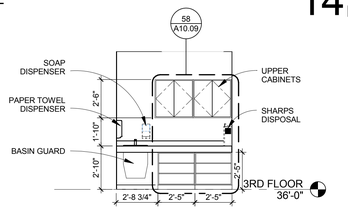

23 PACU MEDS - NORTH
0 2' 4' 8'

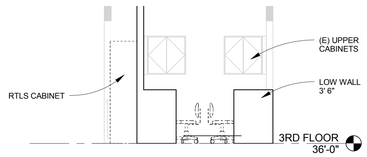

24 PACU NURSE STATION - NORTH
0 2' 4' 8'

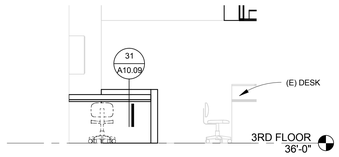

33 PACU NURSE STATION - EAST
0 2' 4' 8'

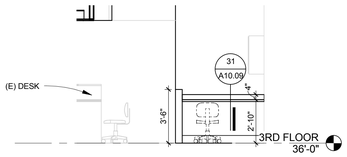

34 PACU NURSE STATION - WEST
0 2' 4' 8'

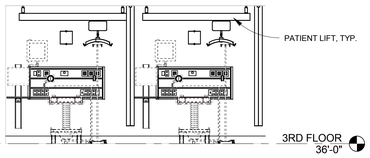

42 PACU STATIONS - EAST
0 2' 4' 8'

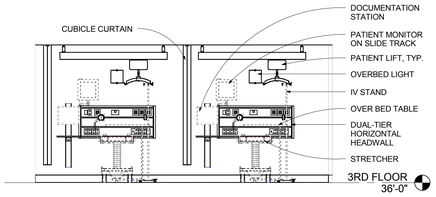

44 PACU STATIONS - NORTH
0 2' 4' 8'

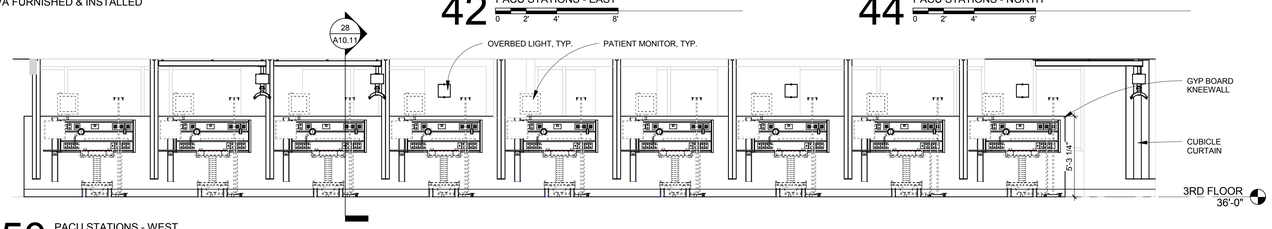

50 PACU STATIONS - WEST
0 2' 4' 8'

EQUIPMENT SCHEDULE - PACU					
Furnished /Installed	Room: Number	Room: Name	Equip. No.	Description	Count
VV	3C-7	CLEAN SUPPLY	002	RTLS Cabinet	6
VV	3C-7	CLEAN SUPPLY	003	Supply Cart, 24"x 48"	1
CC		GURNEY	001	Patient Lift System	6
VV		GURNEY	008	Mobile I.V. Stand	13
VV		GURNEY	009	Cubicle Curtain	3
CC		GURNEY	010	Ceiling Curtain Track	3
VV		GURNEY	044	Wall Mounted Monitor w/track	13
VV		GURNEY	050	Stretcher	13
VV		GURNEY	080	Overbed Table	13
VV		GURNEY	090	Sphygmomanometer	13
CC		GURNEY	097	Double Tier Headwall	13
VV		GURNEY	098	LCD Terminal	13
CC		GURNEY	099	Wall Mounted Terminal Bracket	13
VV	3C-9	MEDS	014	Disposal, Sharps, Wall Mount	1
CC	3C-9	MEDS	081	Wall Mounted Paper Towel Dispenser	1
VV	3C-9	MEDS	082	Wall Mounted Soap Dispenser	1
VV	3C-1B	PACU NURSE STATION	002	RTLS Cabinet	1

"FURNISHED/INSTALLED" KEY:
CC = CONTRACTOR FURNISHED & INSTALLED
VC = VA FURNISHED, CONTRACTOR INSTALLED
VV = VA FURNISHED & INSTALLED

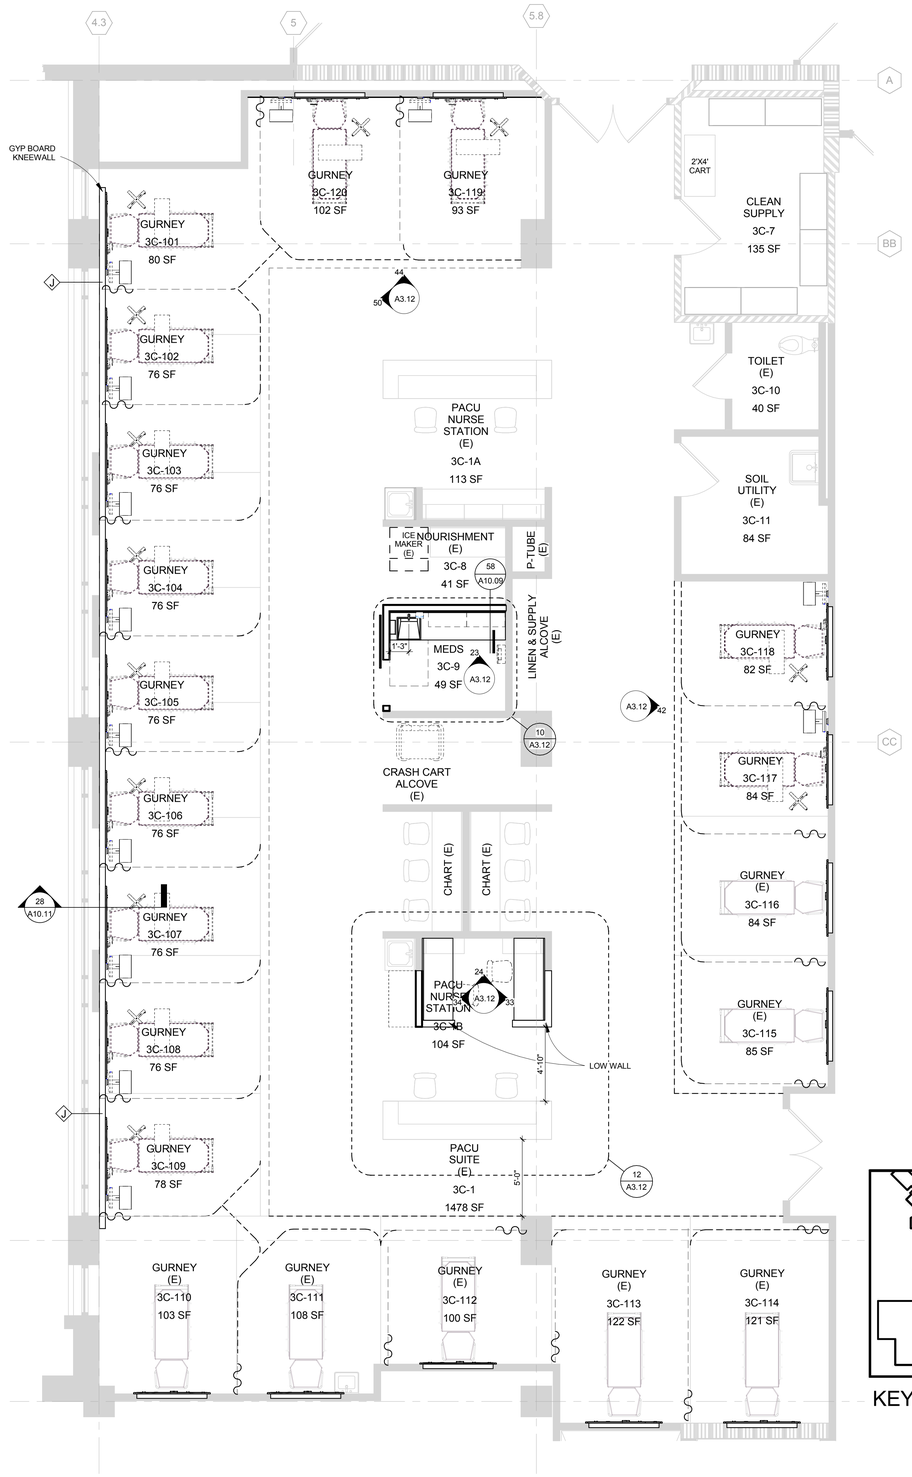

55 DETAIL FLOOR PLAN - PACU STATIONS
0 2' 4' 8'

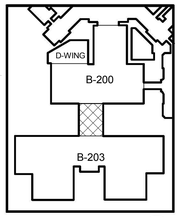

KEY PLAN

FINAL BID DOCUMENTS

HILLIARD ARCHITECTS INC. COPYRIGHT

ADDENDUM 1	07/01/16
Revisions:	Date

CONSULTANTS:

ARCHITECT/ENGINEERS:

HILLIARD ARCHITECTS, INC
1330 Broadway, Suite 1111
Oakland, CA 94612
Tel 415 989 6400, Fax 415 989 3056
www.HilliardArchitects.com

Drawing Title: **PACU DETAIL PLANS & ELEVATIONS**

Approved: Project Director

Project Title: **EXPAND CLINICAL OR AND SURGERY**

Location: 4150 Clement Street

Date: 6/30/2016 | Checked: M.H. | Drawn: JC

Project Number: 662-618

Building Number: 200

Drawing Number: A3.12

Dwg. 25 of 143

Office of Construction and Facilities Management

Department of Veterans Affairs

VA FORM 08-6231

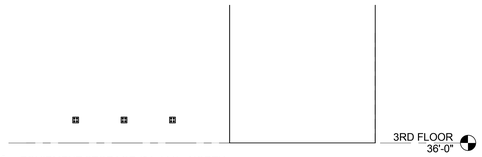

01 EQUIPMENT STORAGE (3A-111) - NORTH
0 2' 4' 8'

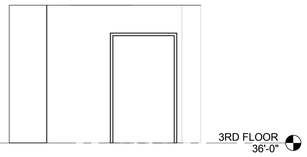

03 EQUIPMENT STORAGE (3A-111) - EAST
0 2' 4' 8'

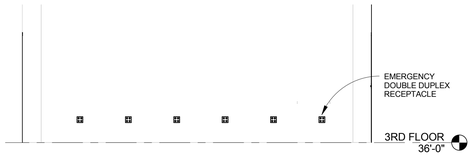

10 EQUIPMENT STORAGE (3A-111) - SOUTH
0 2' 4' 8'

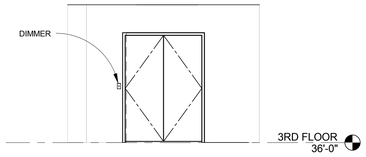

13 EQUIPMENT STORAGE (3A-111) - WEST
0 2' 4' 8'

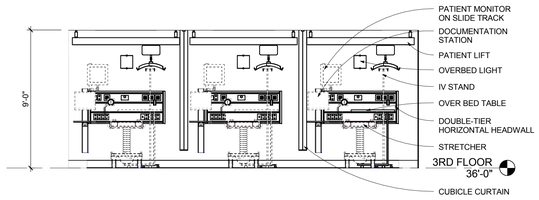

30 ASU PRE-OP HEADWALL
0 2' 4' 8'

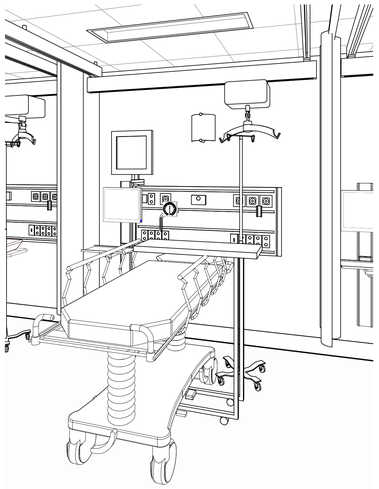

51 ASU PRE-OP STATION - GURNEY #9 - VIEW

EQUIPMENT SCHEDULE - ASU PRE OP					
Furnished /Installed	Room: Number	Room: Name	Equip. No.	Description	Count
CC		GURNEY	001	Patient Lift System	3
VV		GURNEY	008	Mobile I.V. Stand	3
CC		GURNEY	009	Cubicle Curtain	3
CC		GURNEY	010	Ceiling Curtain Track	3
VV		GURNEY	044	Wall Mounted Monitor w/track	3
VV		GURNEY	050	Stretcher	3
VV		GURNEY	080	Overbed Table	3
VV		GURNEY	090	Sphygmomanometer	3
CC		GURNEY	097	Double Tier Headwall	3
VV		GURNEY	098	LCD Terminal	3
CC		GURNEY	099	Wall Mounted Terminal Bracket	3

"FURNISHED/INSTALLED" KEY:
CC = CONTRACTOR FURNISHED & INSTALLED
VC = VA FURNISHED, CONTRACTOR INSTALLED
VV = VA FURNISHED & INSTALLED

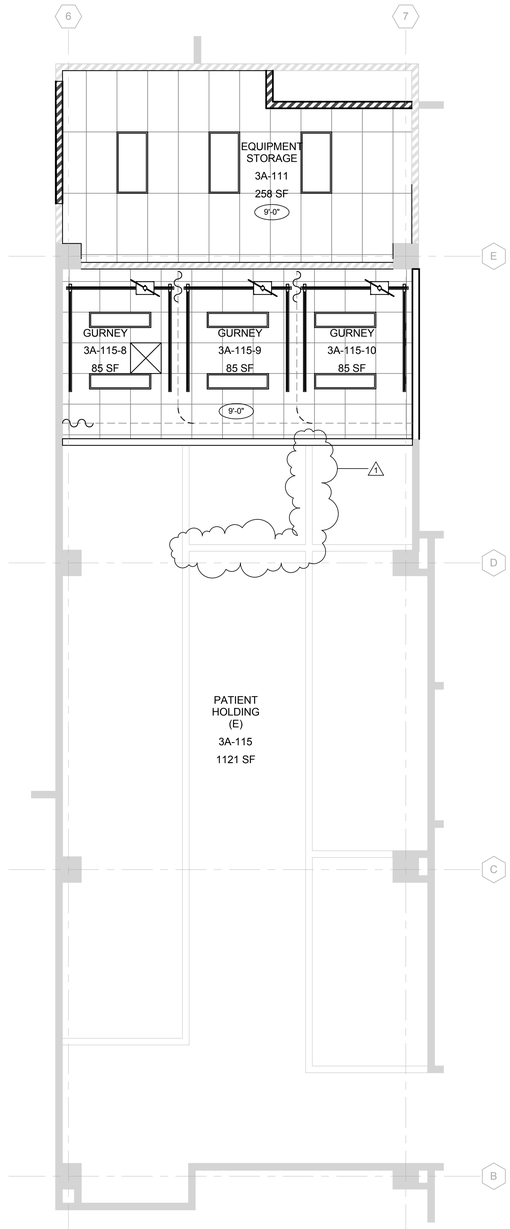

55 REFLECTED CEILING PLAN - 3RD FLOOR B200 - ASU PRE OP
0 2' 4' 8'

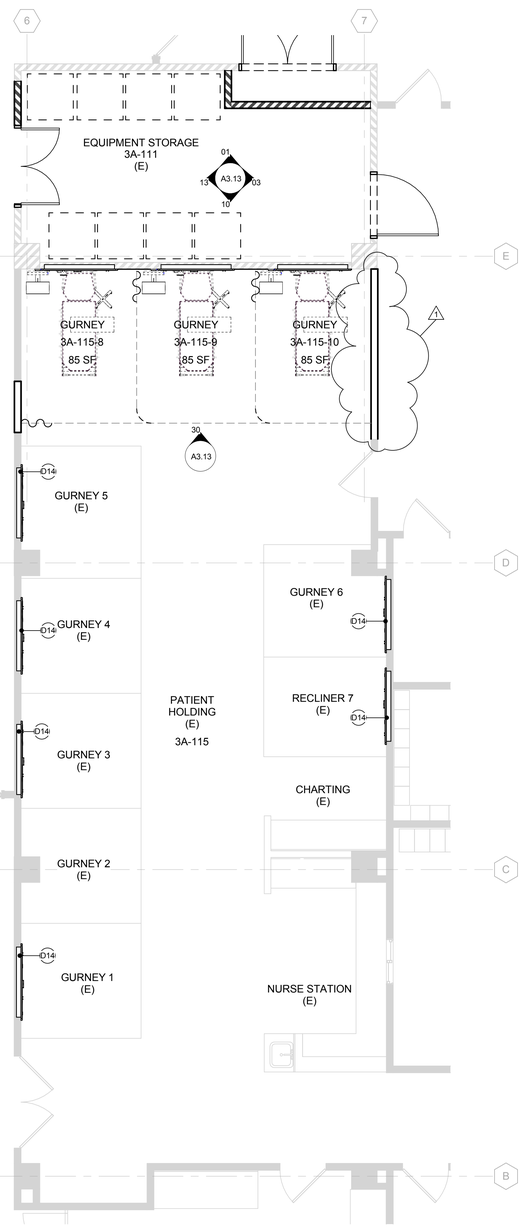

56 DETAIL FLOOR PLAN - ASU PRE OP STATIONS
0 2' 4' 8'

RCP SYMBOLS LEGEND

- 2 x 4 CEILING TILE
- 5/8" TYPE X GYP. BD CEILING ALL NEW GYP. BD. CEILING TO BE FINISH TYPE P3
- SUPPLY GRILLE
- SUPPLY DIFFUSER
- RETURN GRILLE
- RETURN REGISTER
- EXHAUST GRILLE
- 6" DOWNLIGHT SURFACE MOUNTED
- 6" DOWNLIGHT RECESSED
- 1X4 LINEAR BOX FIXTURE
- 2X4 EXISTING LINEAR BOX FIXTURE
- 1-HOUR RATED PARTITION

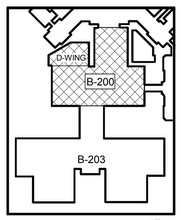

KEY PLAN

FINAL BID DOCUMENTS

HILLIARD ARCHITECTS INC. COPYRIGHT

ADDENDUM 1	07/01/16
Revisions:	Date

CONSULTANTS:

ARCHITECT/ENGINEERS:

HILLIARD ARCHITECTS, INC
1330 Broadway, Suite 1111
Oakland, CA 94612
Tel 415 989 6400, Fax 415 989 3056
www.HilliardArchitects.com

Drawing Title: **ASU DETAIL PLANS & ELEVATIONS**

Approved: Project Director

Project Title: **EXPAND CLINICAL OR AND SURGERY**

Location: 4150 Clement Street

Date: 6/30/2016 | Checked: M.H. | Drawn: JC

Project Number: 662-618

Building Number: 200

Drawing Number: A3.13

Dwg. 26 of 143

Office of Construction and Facilities Management

Department of Veterans Affairs

VA FORM 08-6231

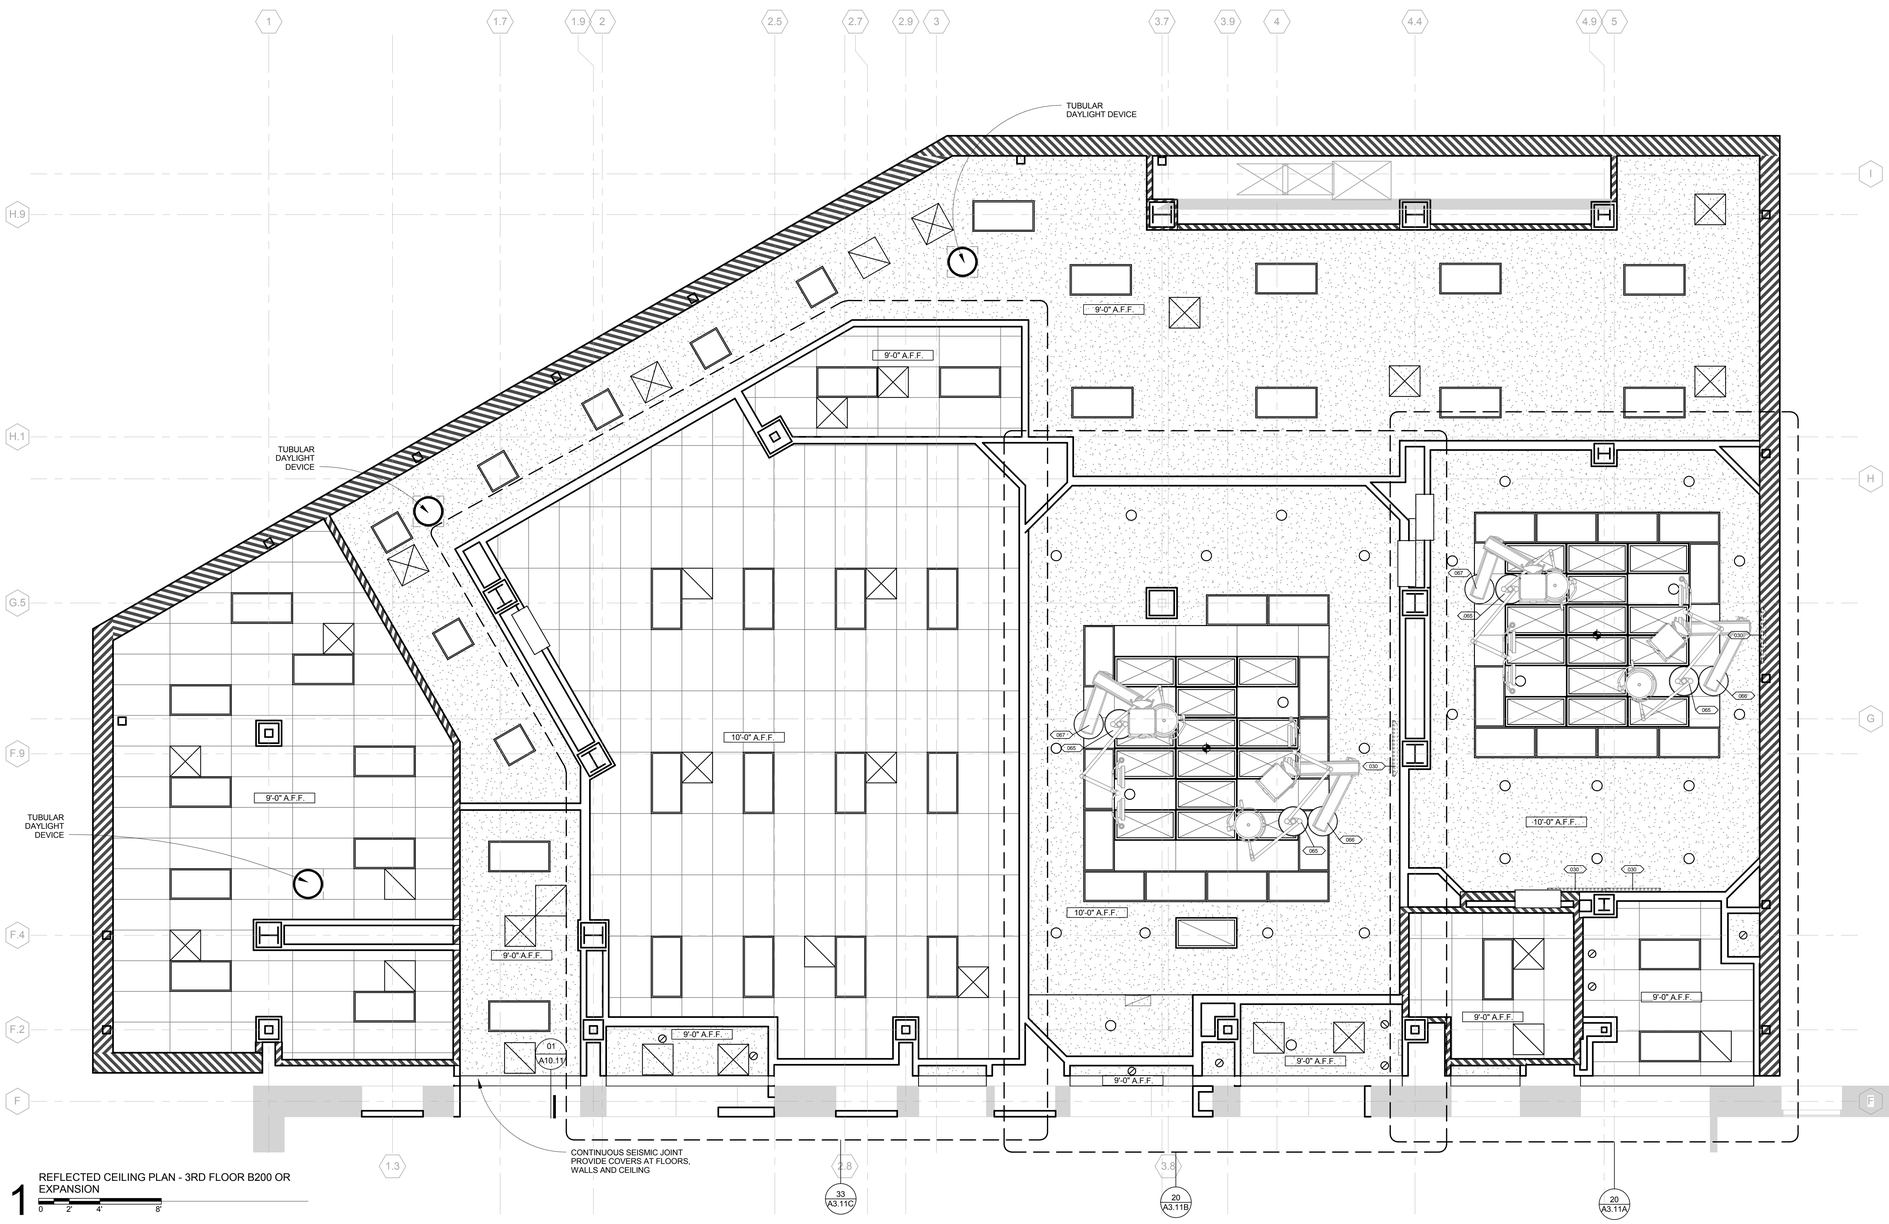

1 REFLECTED CEILING PLAN - 3RD FLOOR B200 OR EXPANSION

0' 2' 4' 8'

RCP SYMBOLS LEGEND

- 2 x 4 CEILING TILE
- 5/8" TYPE X GYP. BD CEILING ALL NEW GYP. BD. CEILING TO BE FINISH TYPE P3
- SUPPLY GRILLE
- SUPPLY DIFFUSER
- RETURN GRILLE
- RETURN REGISTER
- EXHAUST GRILLE
- 6" DOWNLIGHT SURFACE MOUNTED
- 6" DOWNLIGHT RECESSED
- 1X4 LINEAR BOX FIXTURE
- 2X4 EXISTING LINEAR BOX FIXTURE
- 1-HOUR RATED PARTITION

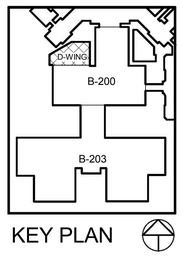

KEY PLAN

FINAL BID DOCUMENTS

HILLIARD ARCHITECTS INC. COPYRIGHT

Revisions:	Date
ADDENDUM 1	07/01/16

CONSULTANTS:

ARCHITECT/ENGINEERS:

HILLIARD ARCHITECTS, INC
1330 Broadway, Suite 1111
Oakland, CA 94612
Tel 415 989 6400, Fax 415 989 3056
www.HilliardArchitects.com

Drawing Title: **CEILING PLAN - 3RD FLOOR B200 - OR EXPANSION**

Approved: Project Director

Project Title: **EXPAND CLINICAL OR AND SURGERY**

Location: 4150 Clement Street

Date: 6/30/2016 | Checked: M.H. | Drawn: JC

Project Number: 662-618

Building Number: 200

Drawing Number: A4.01

Dwg. 27 of 143

Office of Construction and Facilities Management

Department of Veterans Affairs

VA FORM 08-6231

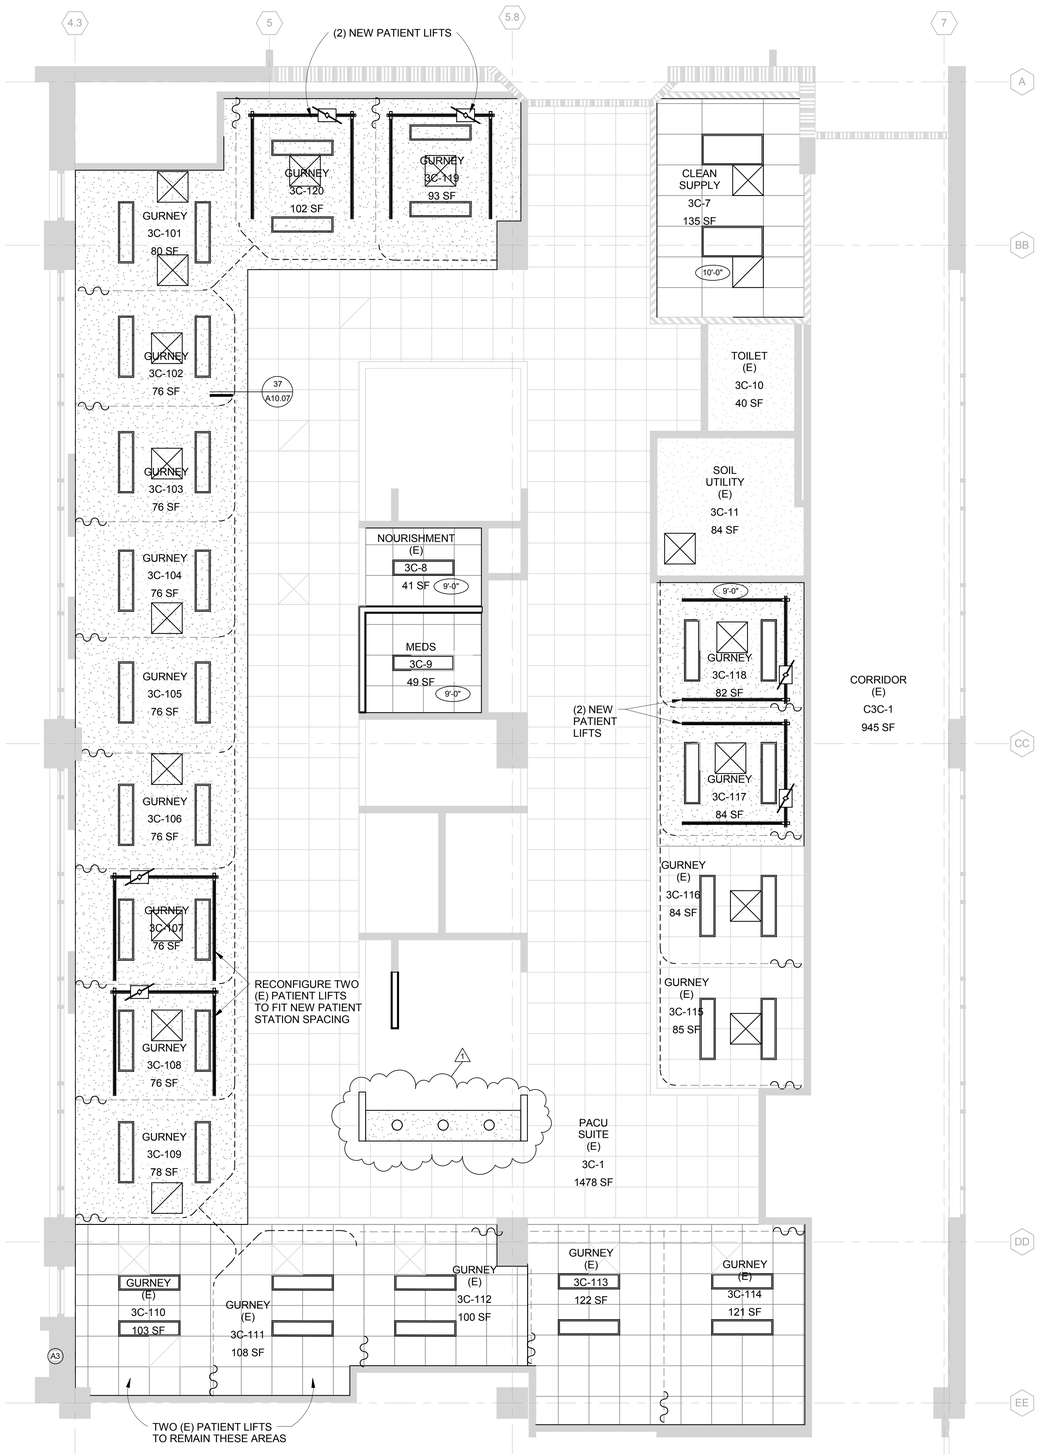

1 REFLECTED CEILING PLAN - 3RD FLOOR B200 - PACU

0 2' 4' 8'

RCP SYMBOLS LEGEND

- 2 x 4 CEILING TILE
- 5/8" TYPE X GYP. BD CEILING ALL NEW GYP. BD. CEILING TO BE FINISH TYPE P3
- SUPPLY GRILLE
- SUPPLY DIFFUSER
- RETURN GRILLE
- RETURN REGISTER
- EXHAUST GRILLE
- 6" DOWNLIGHT SURFACE MOUNTED
- 6" DOWNLIGHT RECESSED
- 1X4 LINEAR BOX FIXTURE
- 2X4 EXISTING LINEAR BOX FIXTURE
- 1-HOUR RATED PARTITION

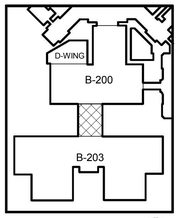

KEY PLAN

FINAL BID DOCUMENTS

HILLIARD ARCHITECTS INC. COPYRIGHT

ADDENDUM 1	07/01/16
Revisions:	Date

CONSULTANTS:

ARCHITECT/ENGINEERS:

ESTABLISHED 1988 HILLIARD ARCHITECTS GOING GREEN

HILLIARD ARCHITECTS, INC
1330 Broadway, Suite 1111
Oakland, CA 94612
Tel 415 989 6400, Fax 415 989 3056
www.HilliardArchitects.com

Drawing Title: **PACU DETAIL REFLECTED CEILING PLAN**

Approved: Project Director

Project Title: **EXPAND CLINICAL OR AND SURGERY**

Location: 4150 Clement Street

Date: 6/30/2016 | Checked: M.H. | Drawn: JC

Project Number: 662-618

Building Number:

Drawing Number: **A4.02**

Dwg. 28 of 143

Office of Construction and Facilities Management

Department of Veterans Affairs

VA FORM 08-6231

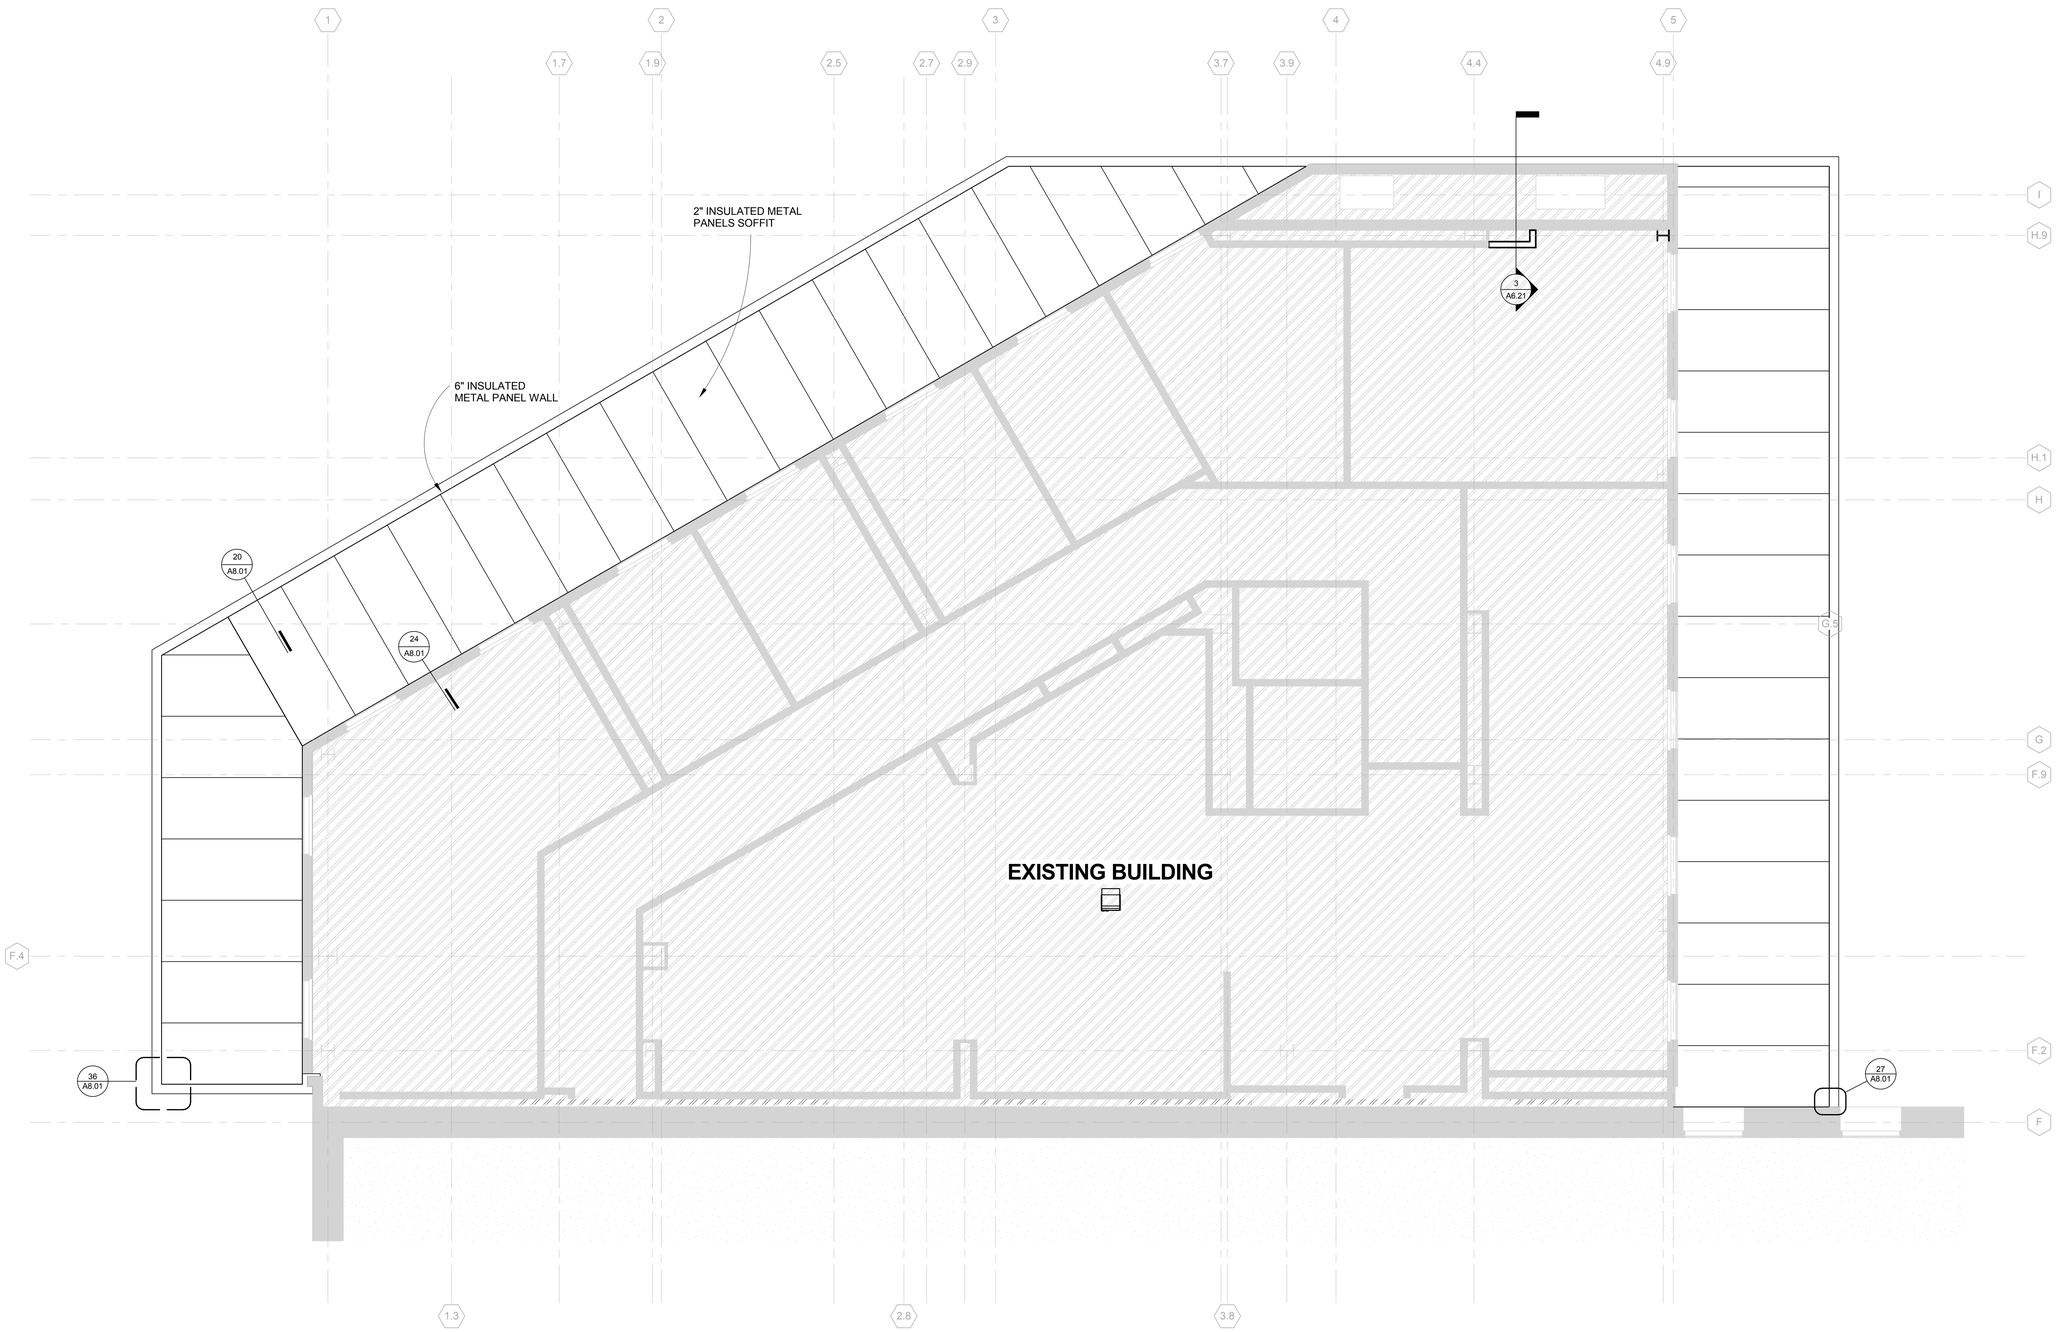

1 SOFFIT RCP
0 2' 4' 8'

FINAL BID DOCUMENTS

HILLIARD ARCHITECTS INC. COPYRIGHT

Revisions:	Date
ADDENDUM 1	07/01/16

CONSULTANTS:

ARCHITECT/ENGINEERS:

HILLIARD ARCHITECTS, INC
1330 Broadway, Suite 1111
Oakland, CA 94612
Tel 415 989 6400, Fax 415 989 3056
www.HilliardArchitects.com

Drawing Title: SOFFIT LAYOUT PLAN

Approved: Project Director

Project Title: EXPAND CLINICAL OR AND SURGERY

Location: 4150 Clement Street

Date: 6/30/2016 | Checked: M.H. | Drawn: Author

Project Number: 662-618

Building Number:

Drawing Number: A4.03

Dwg. 29 of 143

Office of Construction and Facilities Management

Department of Veterans Affairs

VA FORM 08-6231

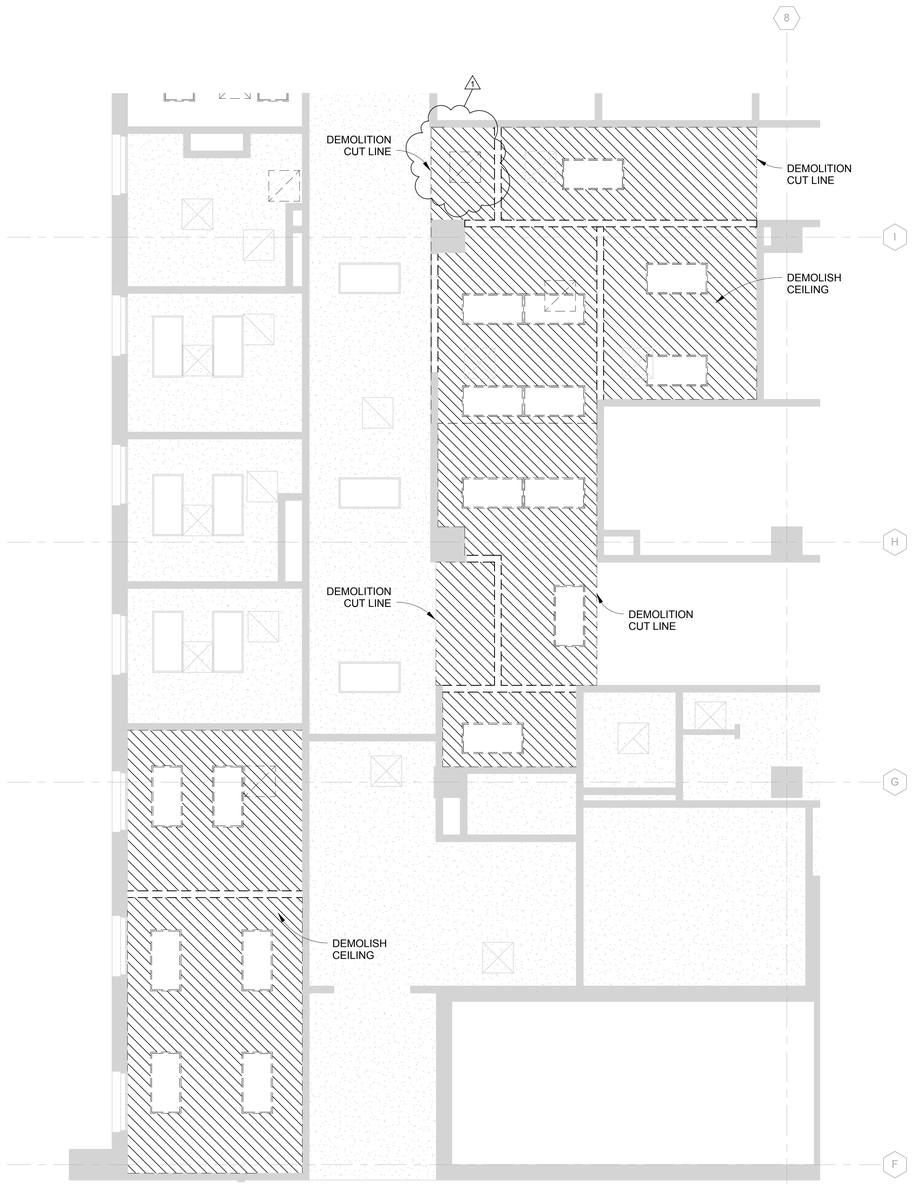

1 REFLECTED CEILING PLAN - 3RD FLOOR B200 - DEMO PRE-OP WAITING CLINIC

0 2' 4' 8'

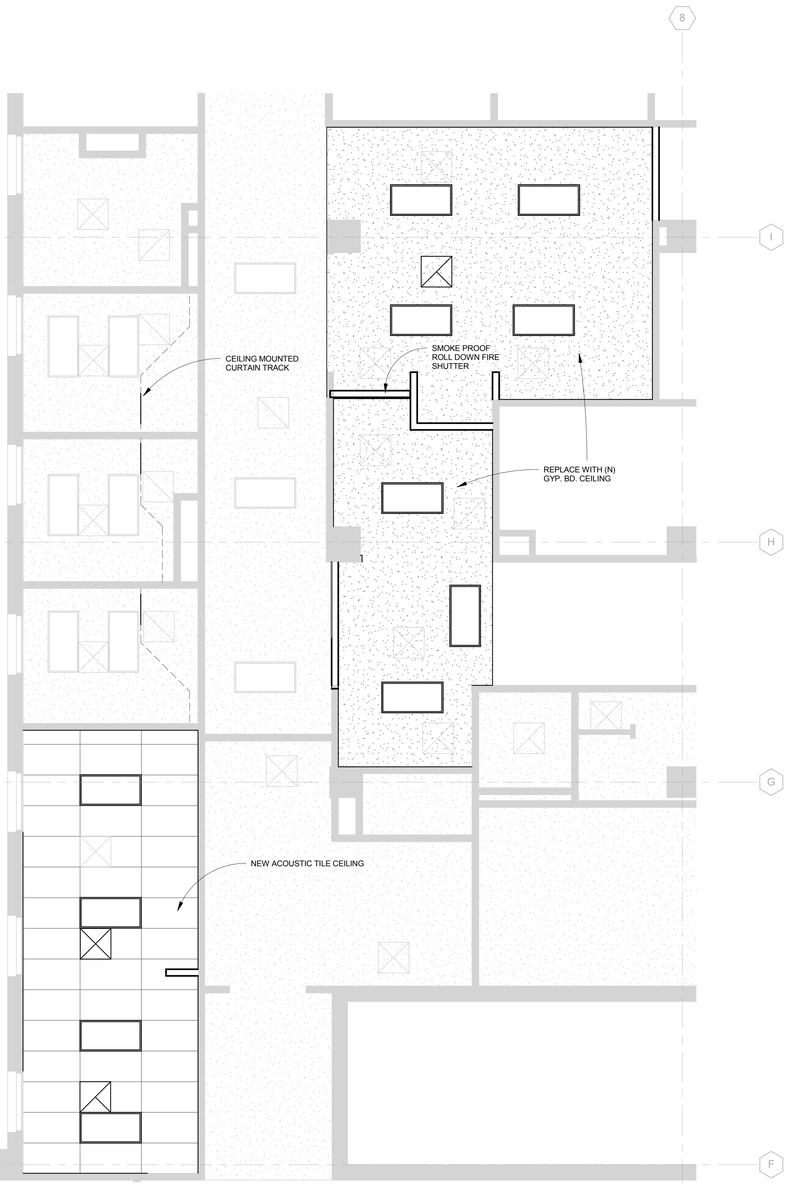

2 REFLECTED CEILING PLAN - 3RD FLOOR B200 - PRE-OP WAITING CLINIC

0 2' 4' 8'

RCP SYMBOLS LEGEND

- 2 x 4 CEILING TILE
- 5/8" TYPE X GYP. BD CEILING ALL NEW GYP. BD. CEILING TO BE FINISH TYPE P3
- SUPPLY GRILLE
- SUPPLY DIFFUSER
- RETURN GRILLE
- RETURN REGISTER
- EXHAUST GRILLE
- 6" DOWNLIGHT SURFACE MOUNTED
- 6" DOWNLIGHT RECESSED
- 1X4 LINEAR BOX FIXTURE
- 2X4 EXISTING LINEAR BOX FIXTURE
- 1-HOUR RATED PARTITION

DEMOLITION LEGEND

- xxxxxxxxxxxxxxxxxx — CONSTRUCTION BARRIER CONSISTING OF FIRE TREATED PLYWOOD WITH A HIGH-BUILD GLAZED COATING (APPLIED OUTSIDE CONSTRUCTION AREA) INSTALLED OVER STEEL STUD FRAMING AND FLATHEAD FASTENERS.
- DEMOLITION AREA
- ACCESSIBLE PATH OF TRAVEL
- EXISTING PARTITIONS, FURRING, DOORS, CASEWORK, WINDOWS, RELITES, PLUMBING FIXTURES & THE LIKE TO BE REMOVED.
- EXISTING CONSTRUCTION TO REMAIN.
- EXAM #1 — EXISTING ROOM NAME
- EXISTING SUSPENDED CEILING GRID AND TILE SYSTEM TO BE REMOVED
- EXISTING GYP BD CEILING AND/OR SOFFITS TO BE REMOVED
- 9'-0" — EXISTING CEILING HEIGHT (TYP. U.O.N.)

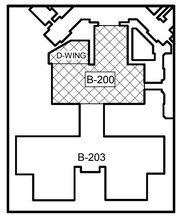

KEY PLAN

FINAL BID DOCUMENTS

HILLIARD ARCHITECTS INC. COPYRIGHT

Revisions:	Date
ADDENDUM 1	07/01/16

CONSULTANTS:

ARCHITECT/ENGINEERS:

HILLIARD ARCHITECTS, INC
1330 Broadway, Suite 1111
Oakland, CA 94612
Tel 415 989 6400, Fax 415 989 3056
www.HilliardArchitects.com

Drawing Title: **PRE-OP CLINIC RCP - DEMO AND NEW CONSTRUCTION**

Approved: Project Director

Project Title: **EXPAND CLINICAL OR AND SURGERY**

Location: 4150 Clement Street

Date: 6/30/2016 | Checked: M.H. | Drawn: JC

Project Number: 662-618

Building Number: 200

Drawing Number: **A4.04**

Dwg. 30 of 143

Office of Construction and Facilities Management

Department of Veterans Affairs

VA FORM 08-6231

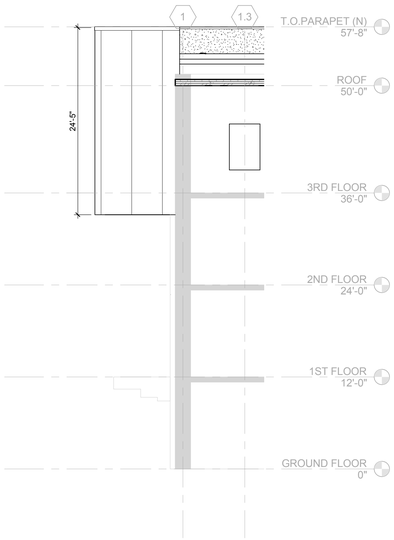

1 SOUTH ELEVATION
0 4' 8' 16'

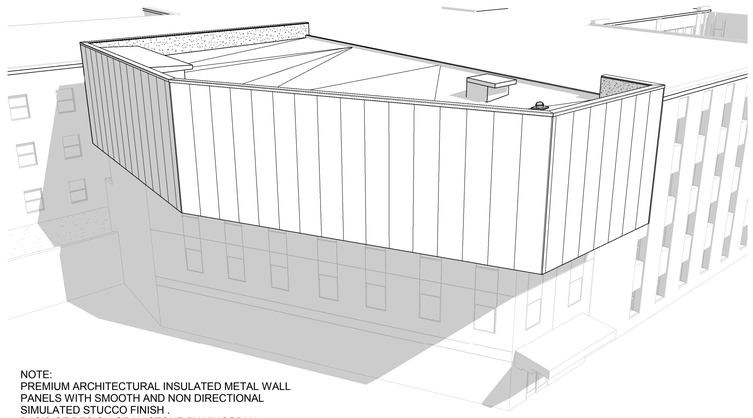

NOTE:
PREMIUM ARCHITECTURAL INSULATED METAL WALL PANELS WITH SMOOTH AND NON DIRECTIONAL SIMULATED STUCCO FINISH .
BASIS OF DESIGN GRANISTONE BY KINGSPAN
(209) 531-0991
TYP. AT ALL EXTERIOR WALLS.

5 Exterior Elevations - 3D View
0

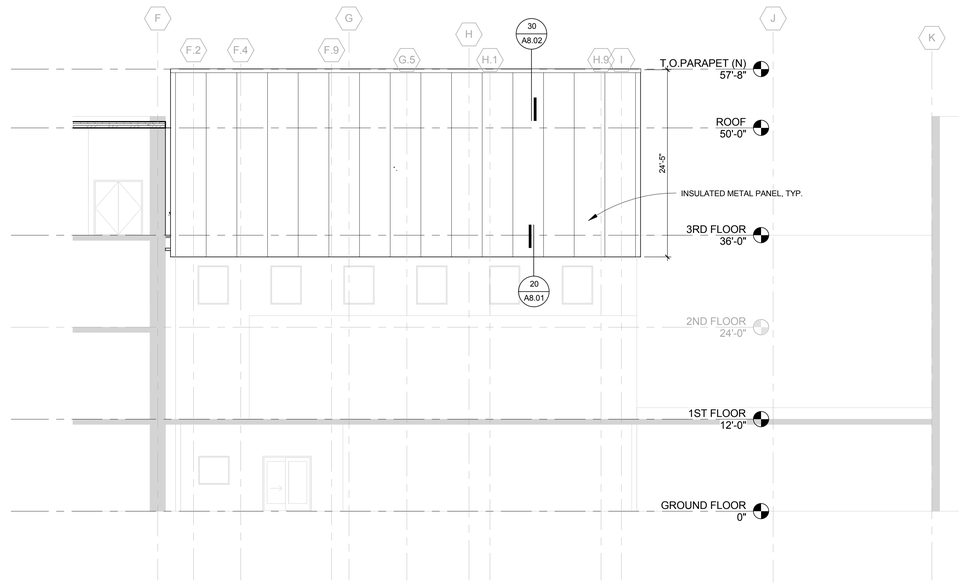

3 EAST ELEVATION
0 4' 8' 16'

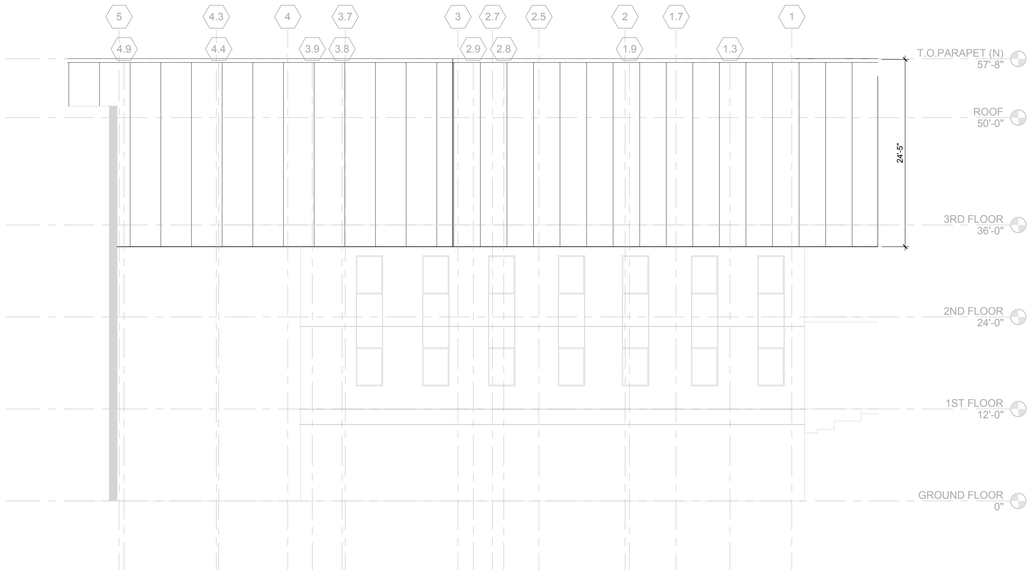

2 NORTH ELEVATION
0 4' 8' 16'

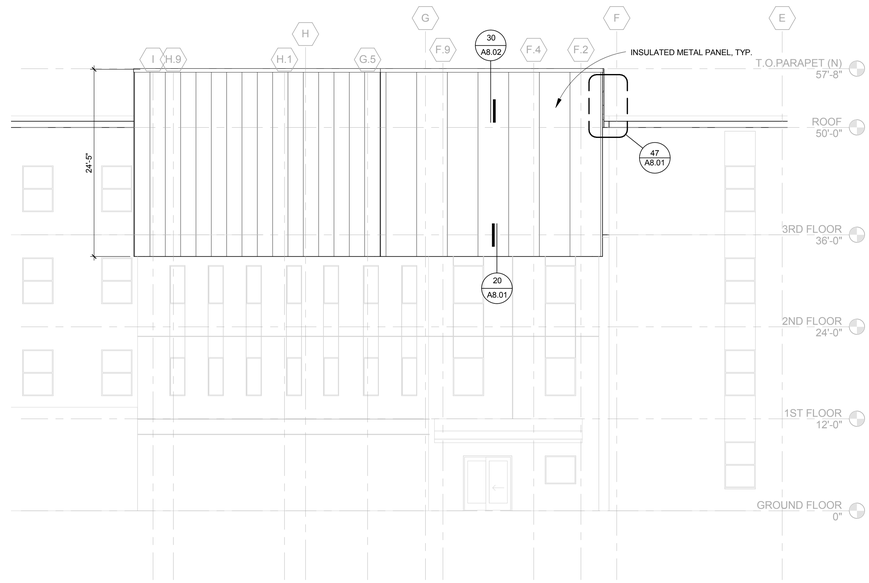

4 WEST ELEVATION
0 4' 8' 16'

FINAL BID DOCUMENTS

HILLIARD ARCHITECTS INC. COPYRIGHT

ADDENDUM 1	07/01/16
Revisions:	Date

VA FORM 08-6231

CONSULTANTS:

ARCHITECT/ENGINEERS:

HILLIARD ARCHITECTS, INC
1330 Broadway, Suite 1111
Oakland, CA 94612
Tel 415 989 6400, Fax 415 989 3056
www.HilliardArchitects.com

Drawing Title: **EXTERIOR ELEVATIONS**

Approved: Project Director

Project Title: **EXPAND CLINICAL OR AND SURGERY**

Location: 4150 Clement Street

Date: **6/30/2016** | Checked: **M.H.** | Drawn: **JC**

Project Number: **662-618**

Building Number: **200**

Drawing Number: **A5.01**

Dwg. **31** of **143**

Office of Construction and Facilities Management

Department of Veterans Affairs