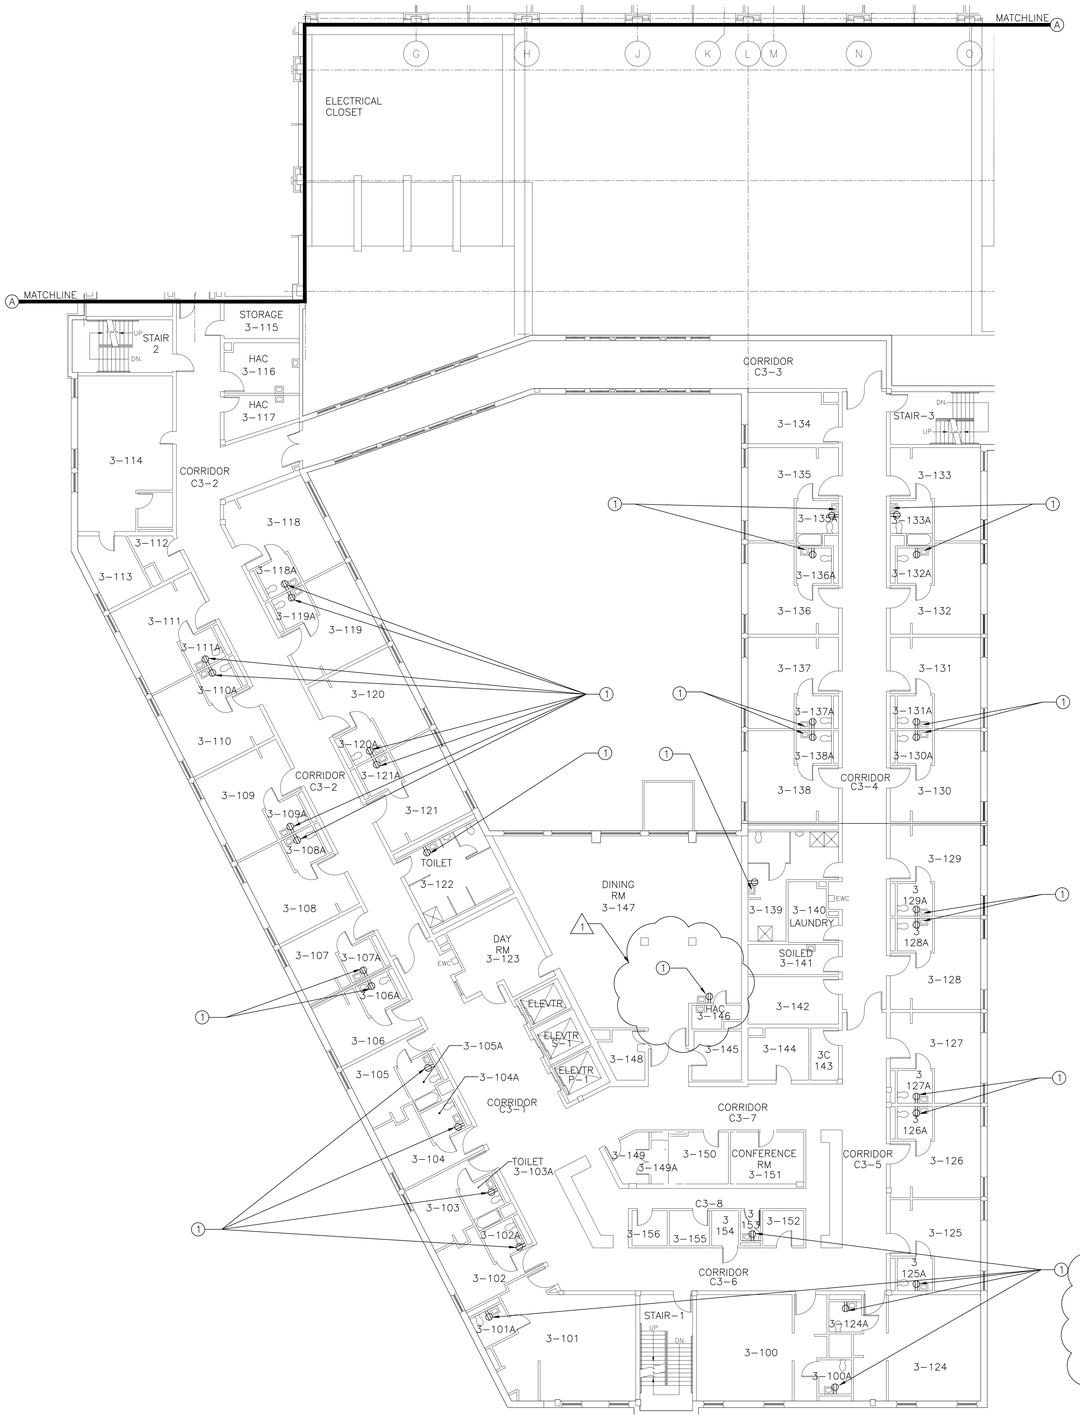

KEYED NEW WORK NOTES

1. PROVIDE NEW RECEPTACLE #12 CONDUCTORS, #12 GROUND IN 3/4" CONDUIT ON NORMAL POWER, TIE INTO LOCAL CIRCUIT. WHERE CUTTING, CHANNELING, CHASING OR DRILLING OF FLOORS, WALLS, PARTITIONS, CEILINGS OR OTHER CONSTRUCTION IS NECESSARY FOR PROPER INSTALLATION, THE WORK SHALL BE DONE CAREFULLY TO PRESERVE THE INTEGRITY OF THE EXISTING CONSTRUCTION. PATCH AND REPAIR ALL HOLES TO THEIR ORIGINAL CONDITION, INCLUDING FIRE RATING AND FINISH. RESTORE ALL DISTURBED SURFACES TO MATCH EXISTING CONDITIONS. ALL NEW WIRING SHALL BE CONCEALED. MOUNT RECEPTACLE UNDER EXISTING SINK.

PROJECT NORTH

1 / 1-E16 BUILDING 27 CLC THIRD FLOOR ELECTRICAL PLAN

SCALE: 3/32"=1'-0"

CONTRACTOR'S NOTE-CLC BATHROOMS

THE CONTRACTOR SHALL NOTE THAT A LIMITED AMOUNT OF BATHROOMS WILL BE MADE AVAILABLE TO THE CONTRACTOR, ADDITIONALLY, ALL WORK WITHIN THE BATHROOMS SHALL BE PERFORMED DURING THE DAY. FOR THE PURPOSES OF BIDDING, THE CONTRACTOR SHALL BASE HIS BID ON ACQUIRING NO MORE THEN (2) TWO BATHROOMS/FLOOR AT ANY GIVEN TIME. ADDITIONALLY, EACH BATHROOM SHALL NOT BE OUT OF SERVICE TO PATIENT USE FOR MORE THEN (3) THREE BUSINESS DAYS. ALL BATHROOM WORK SHALL BE CONDUCTED DURING THE HOURS OF 7:30 AM AND 4:00 PM WEEKDAYS.

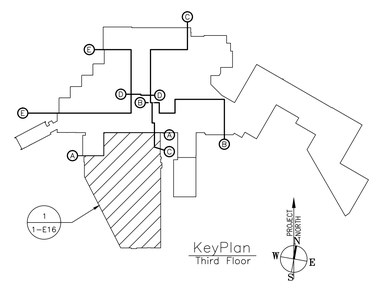

BID AMENDMENT NO.1

AUGUST 24, 2016

FULLY SPRINKLERED

Revisions	Date
AMENDMENT NO. 1	8/24/16

Professional Seal

Project Lead

NORTHEAST INFRASTRUCTURE, LLC
630 PARK STREET HONESDALE, PA 18431
570-253-0846 OFFICE 570-253-1935 FAX
WWW.NEINFRA.COM

Drawing Title: BUILDING 27 CLC THIRD FLOOR ELECTRICAL PLAN

Facility Project Name: DEPARTMENT OF VETERANS AFFAIRS MEDICAL CENTER WILKES-BARRE, PA

Project Title: PLUMBING SYSTEM UPGRADE PHASE II

Building Number: 27

Checked: D.L.E.

Drawn: D.J.P.

Location: WILKES-BARRE, PENNSYLVANIA

Date: 08/24/2016

Project No.: 693-11-119

DRAWING NO. DRAWING 1-E16

DWG. 54 OF 55

Veterans Affairs