




1  
1-P23  
SCALE: 1/2"=1'-0"

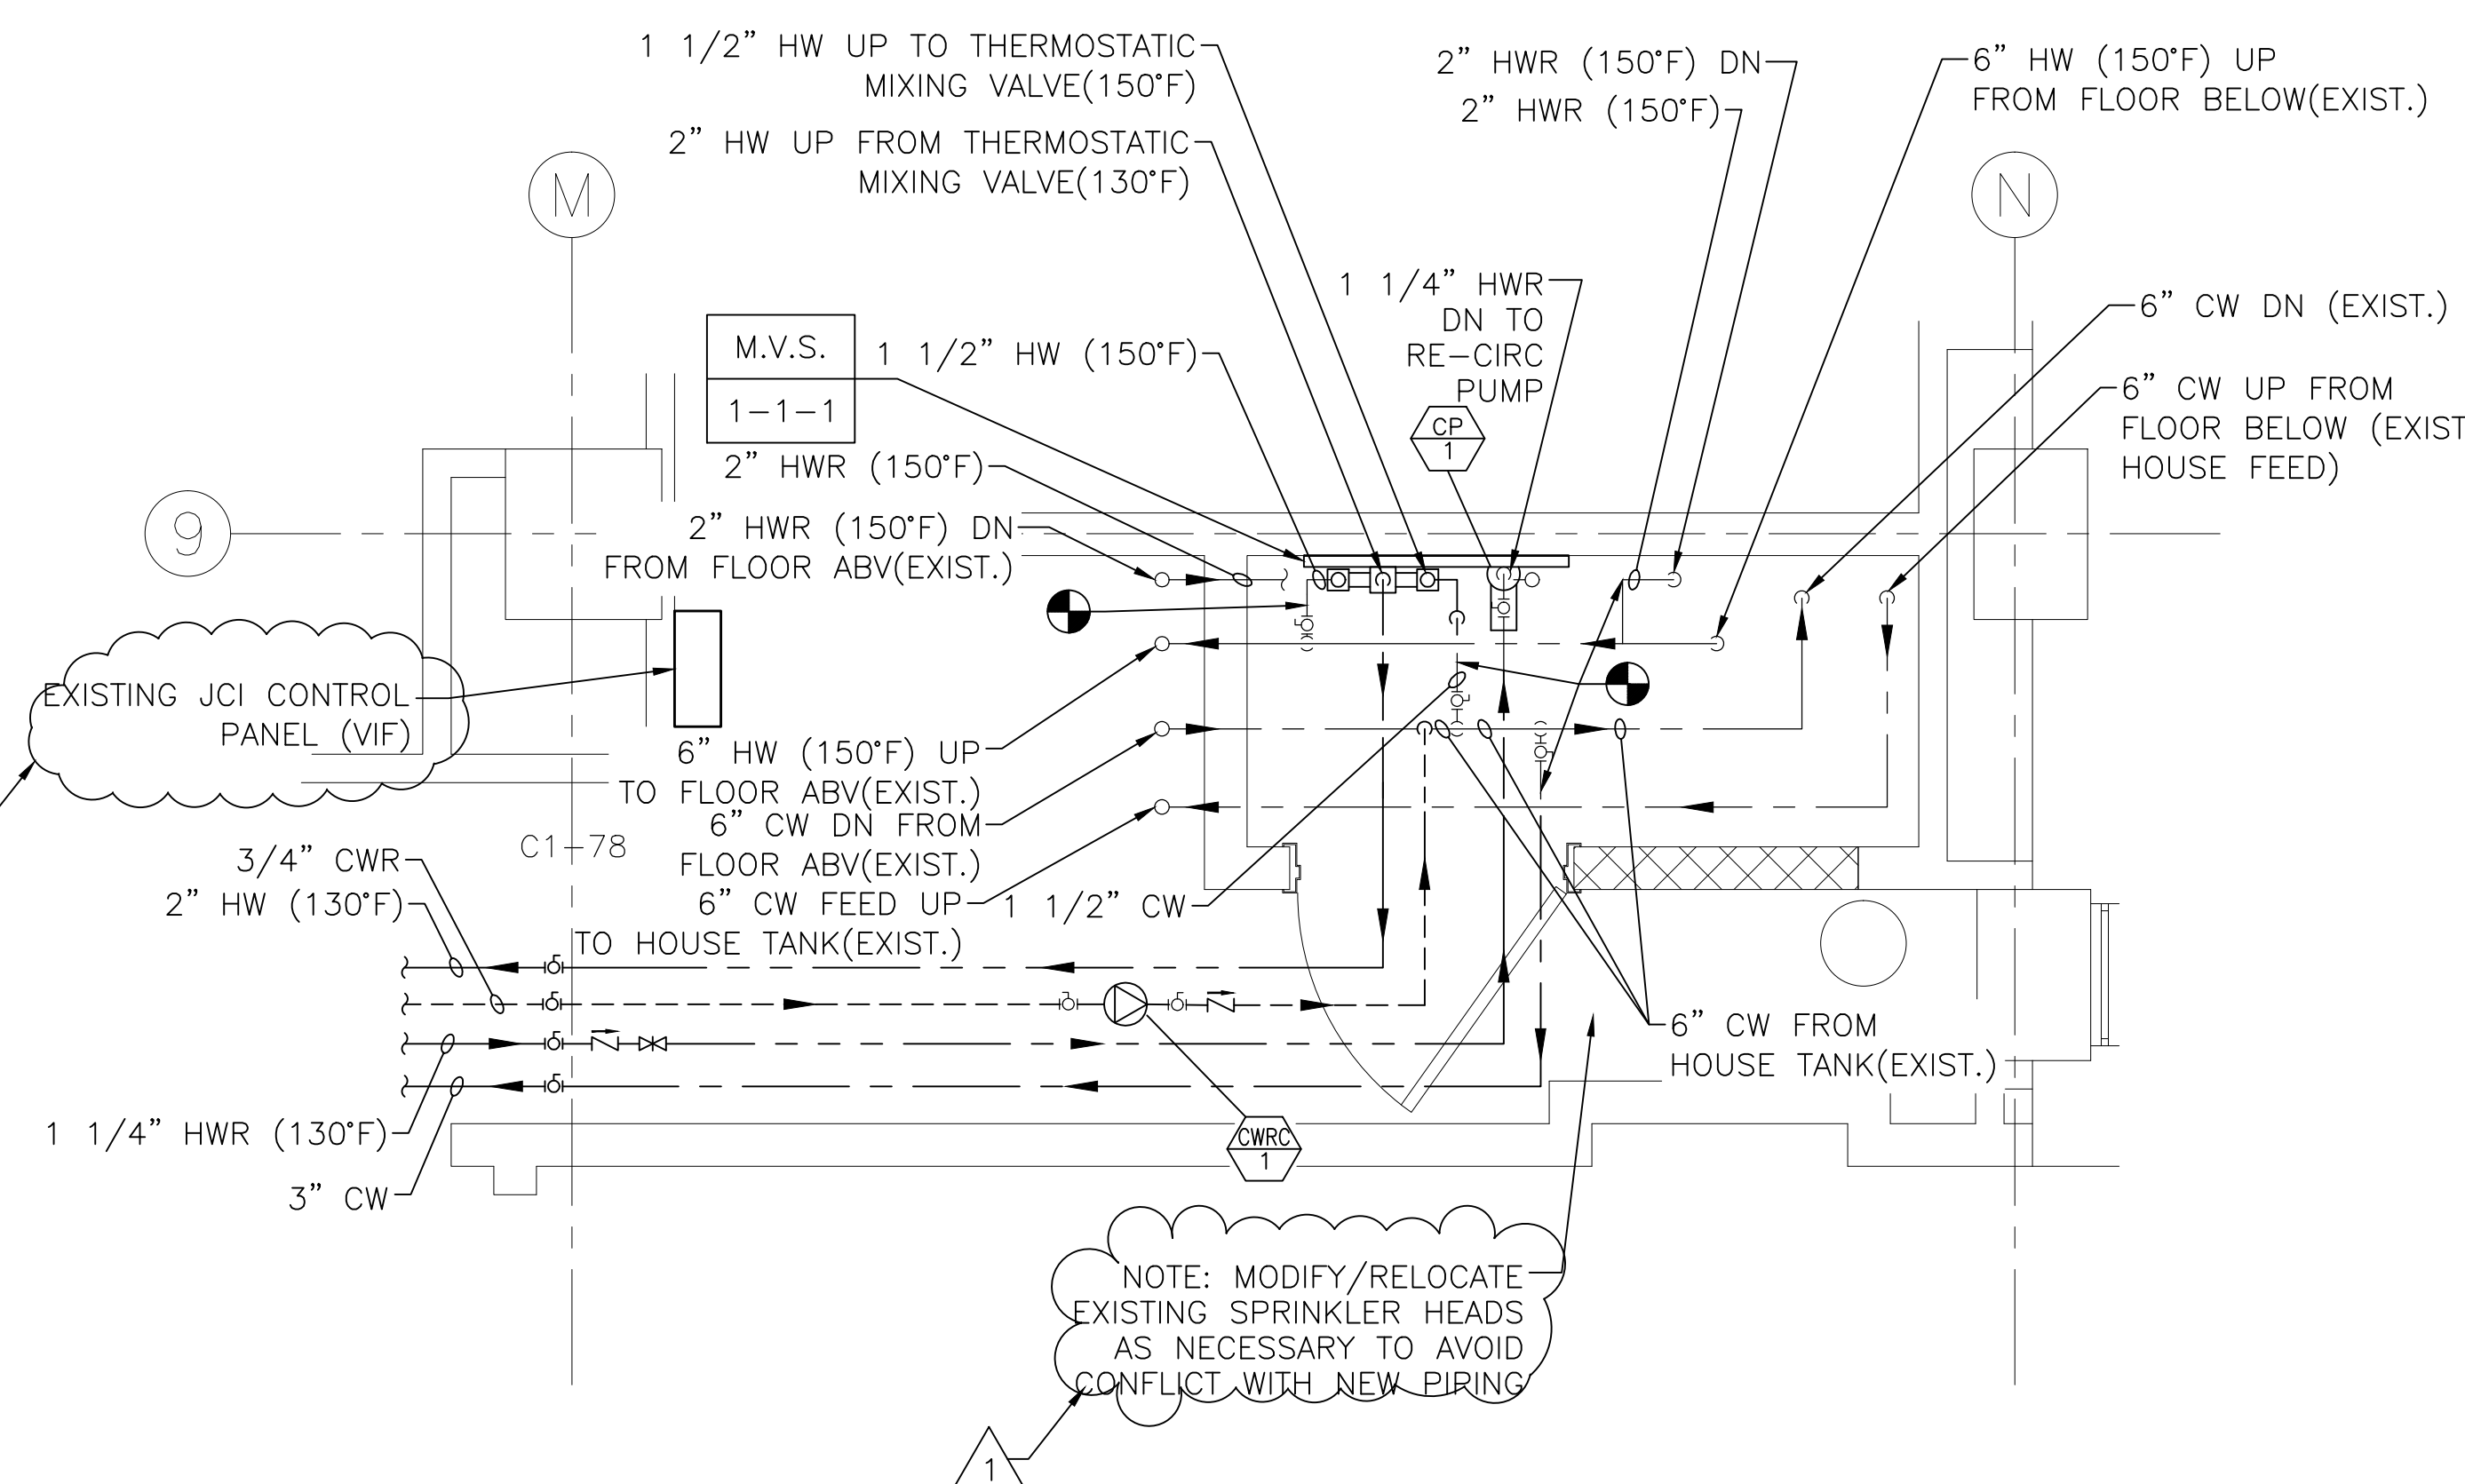


2  
1-P23  
SCALE: 1/2"=1'-0"

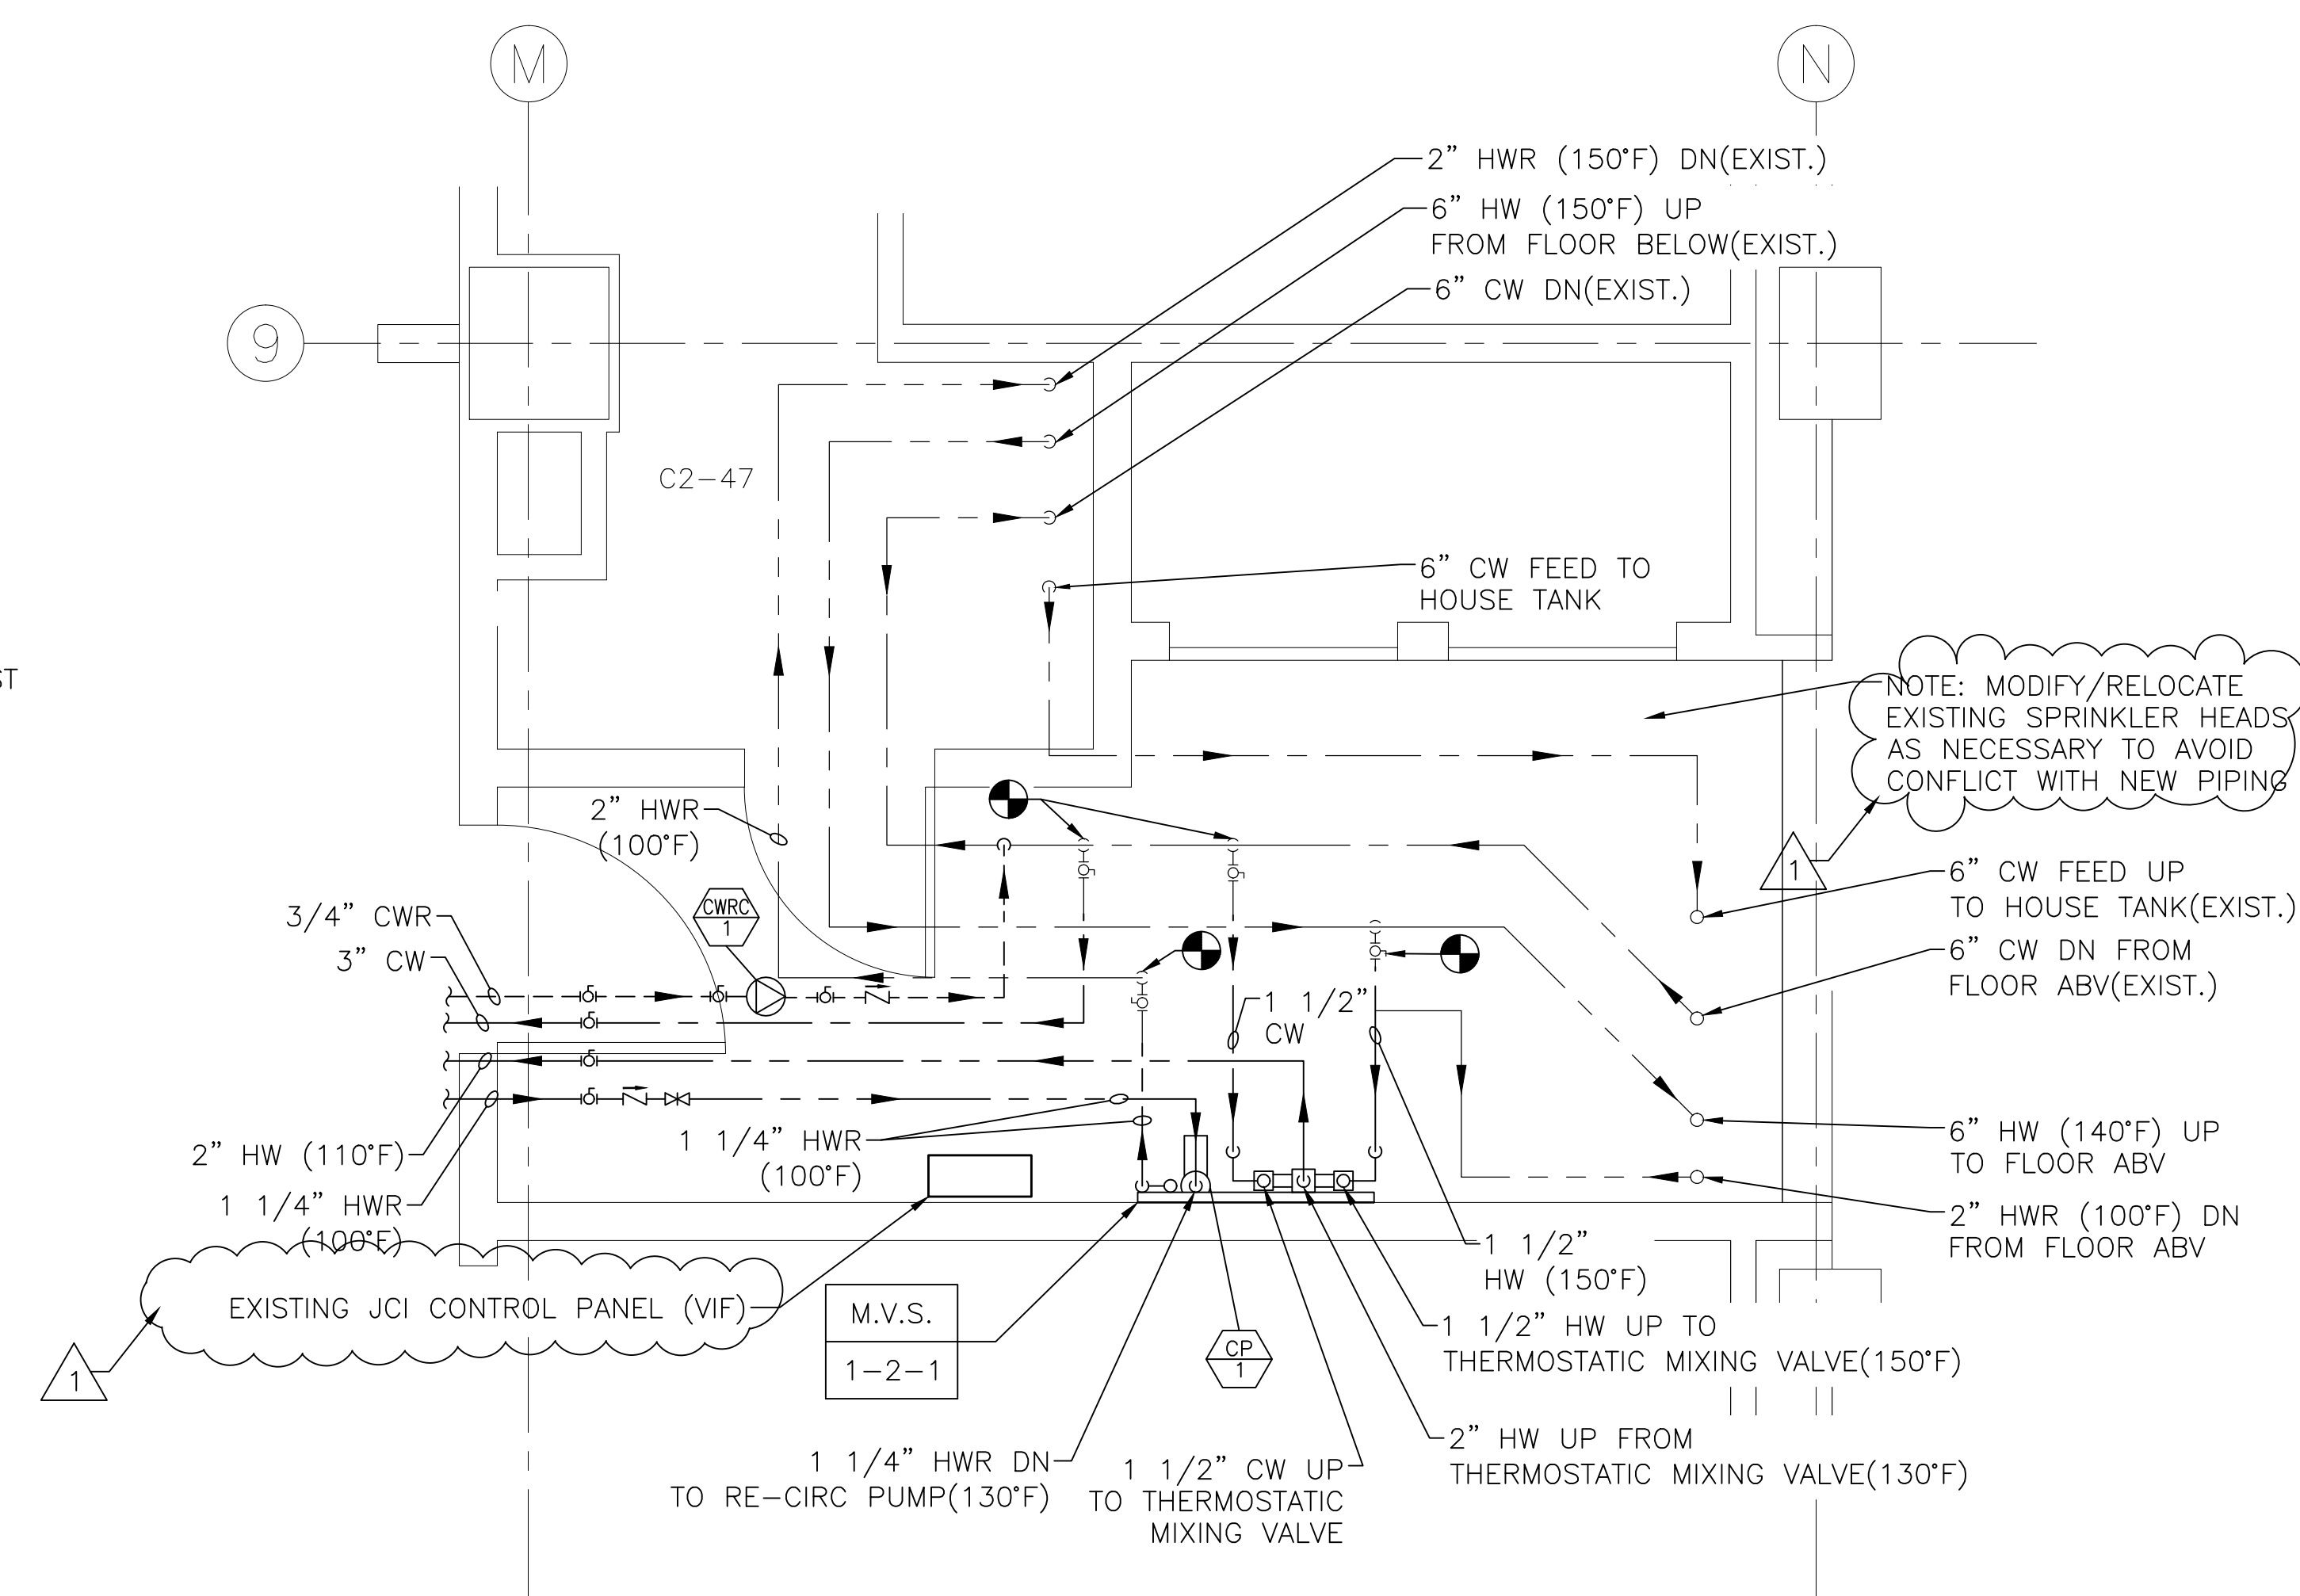


3  
1-P23  
SCALE: 1/2"=1'-0"

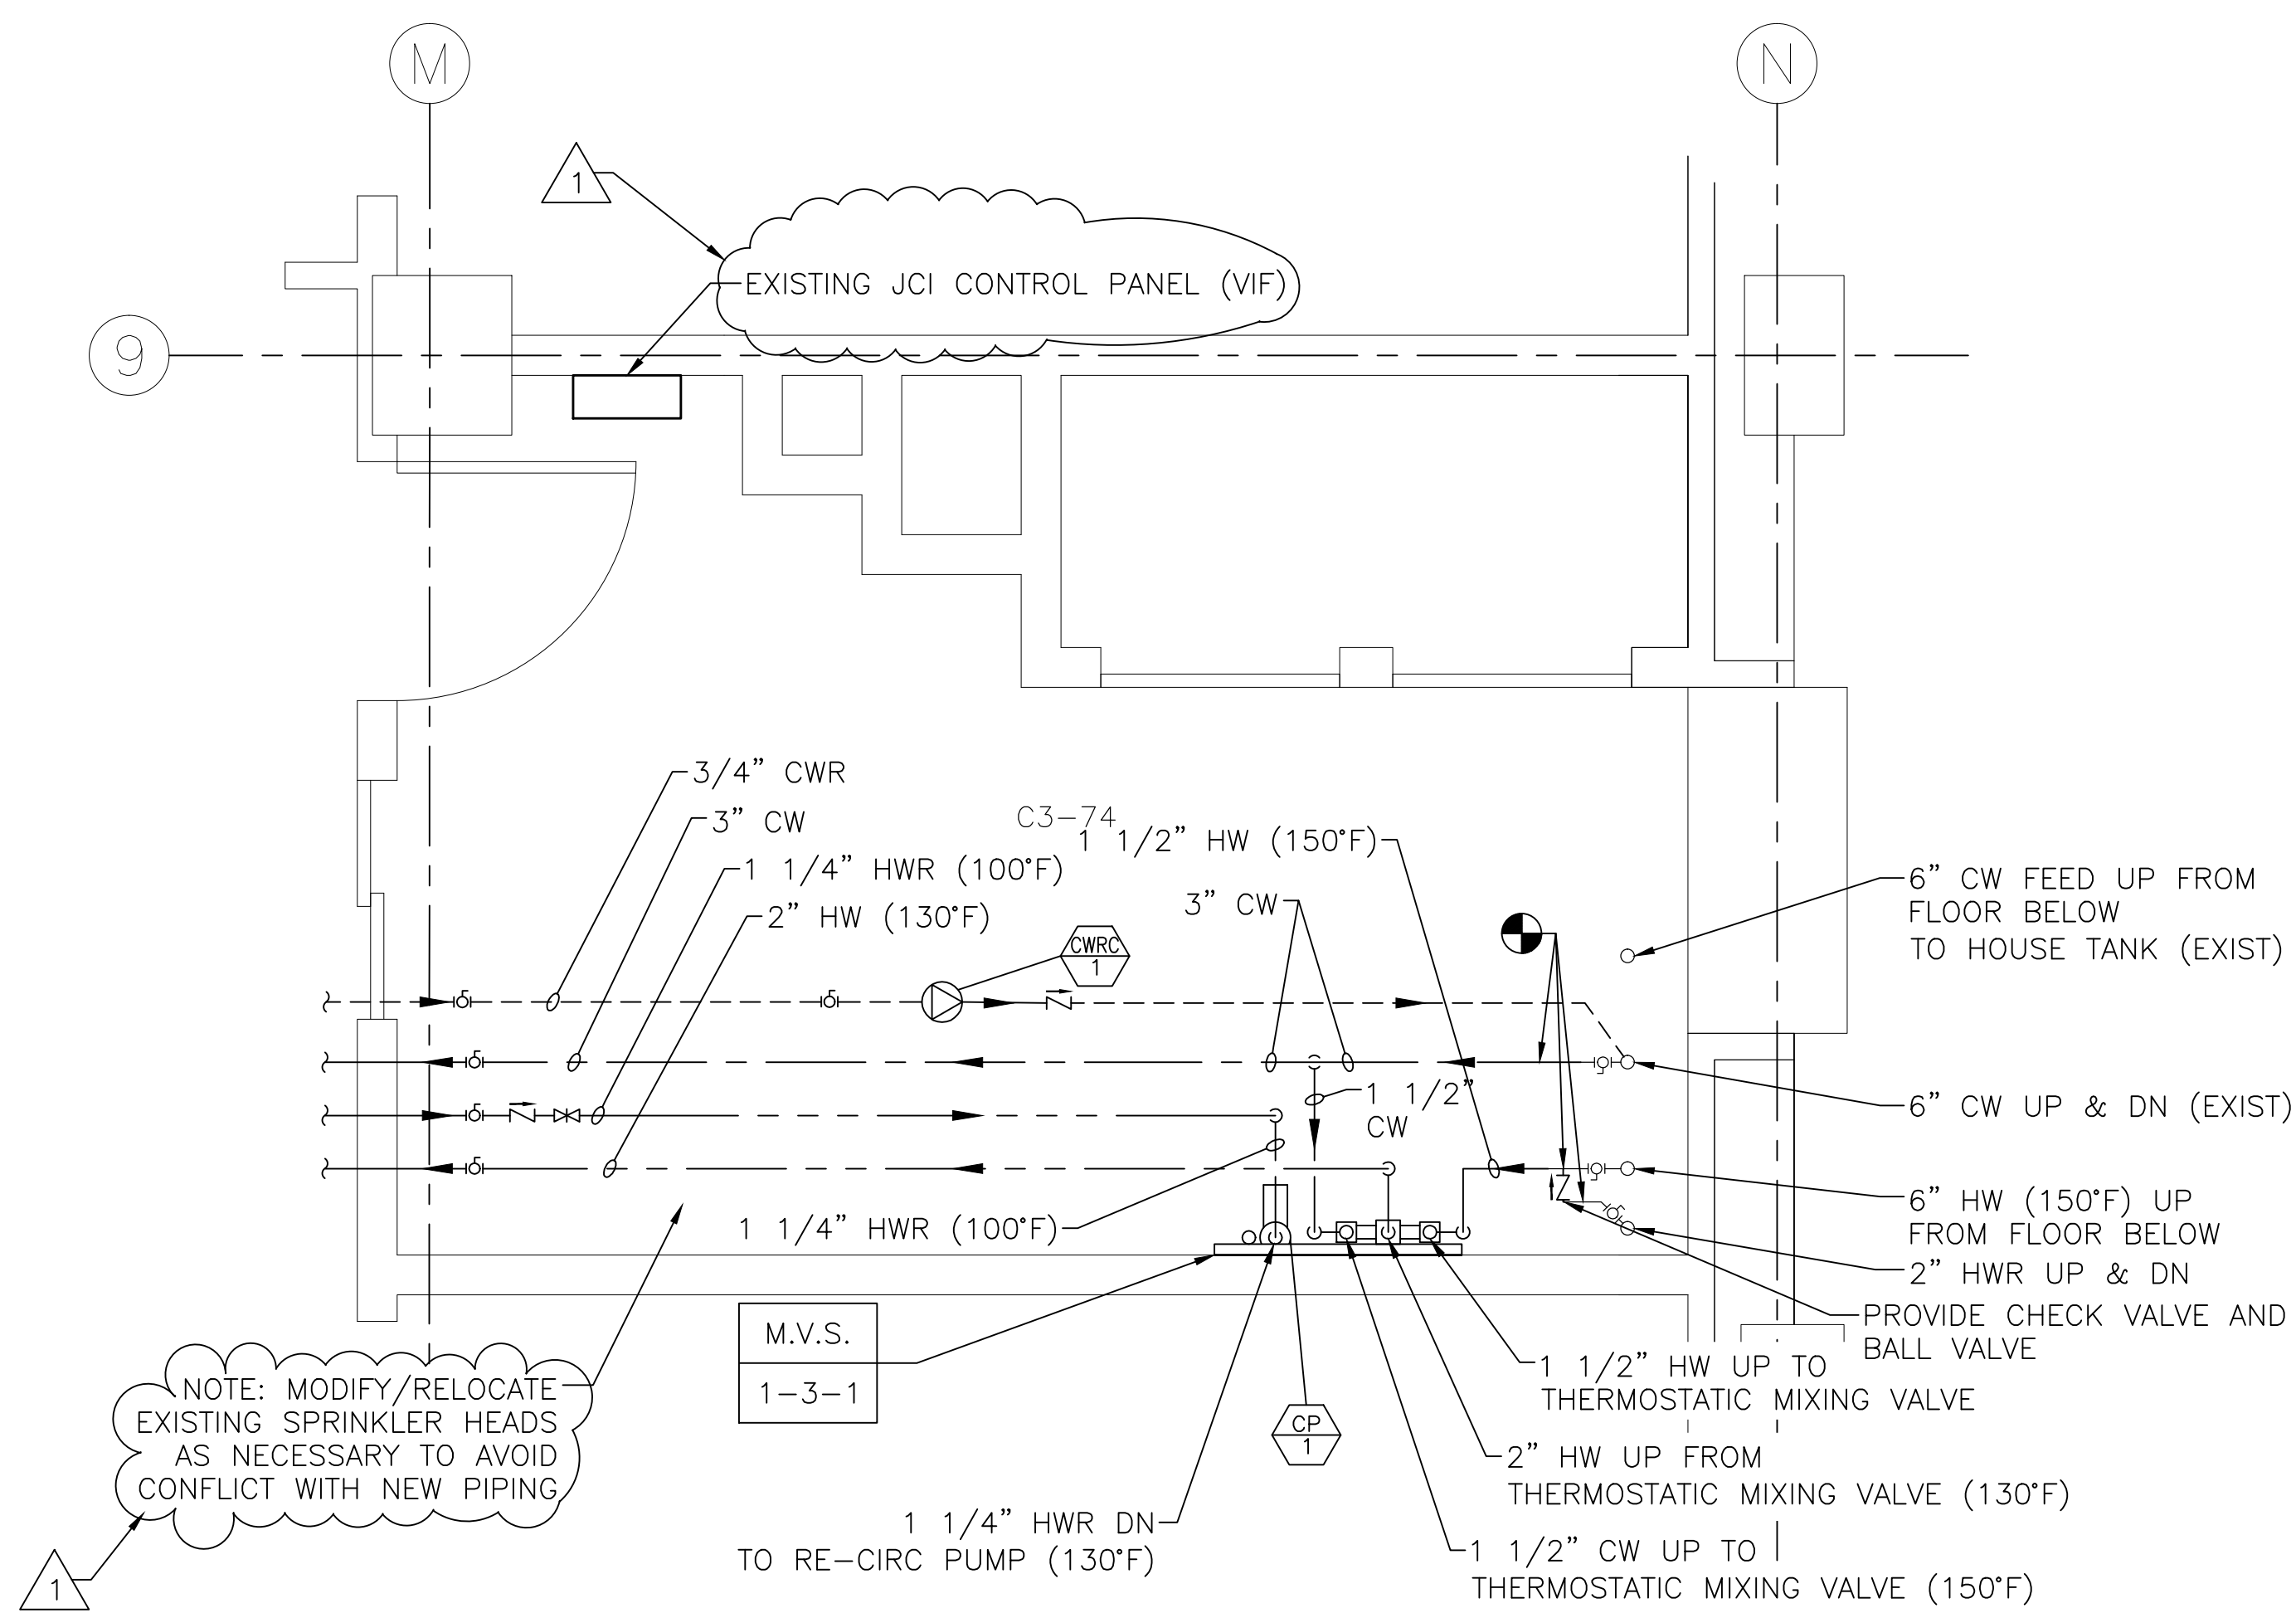

4  
1-P23  
SCALE: 1/2"=1'-0"

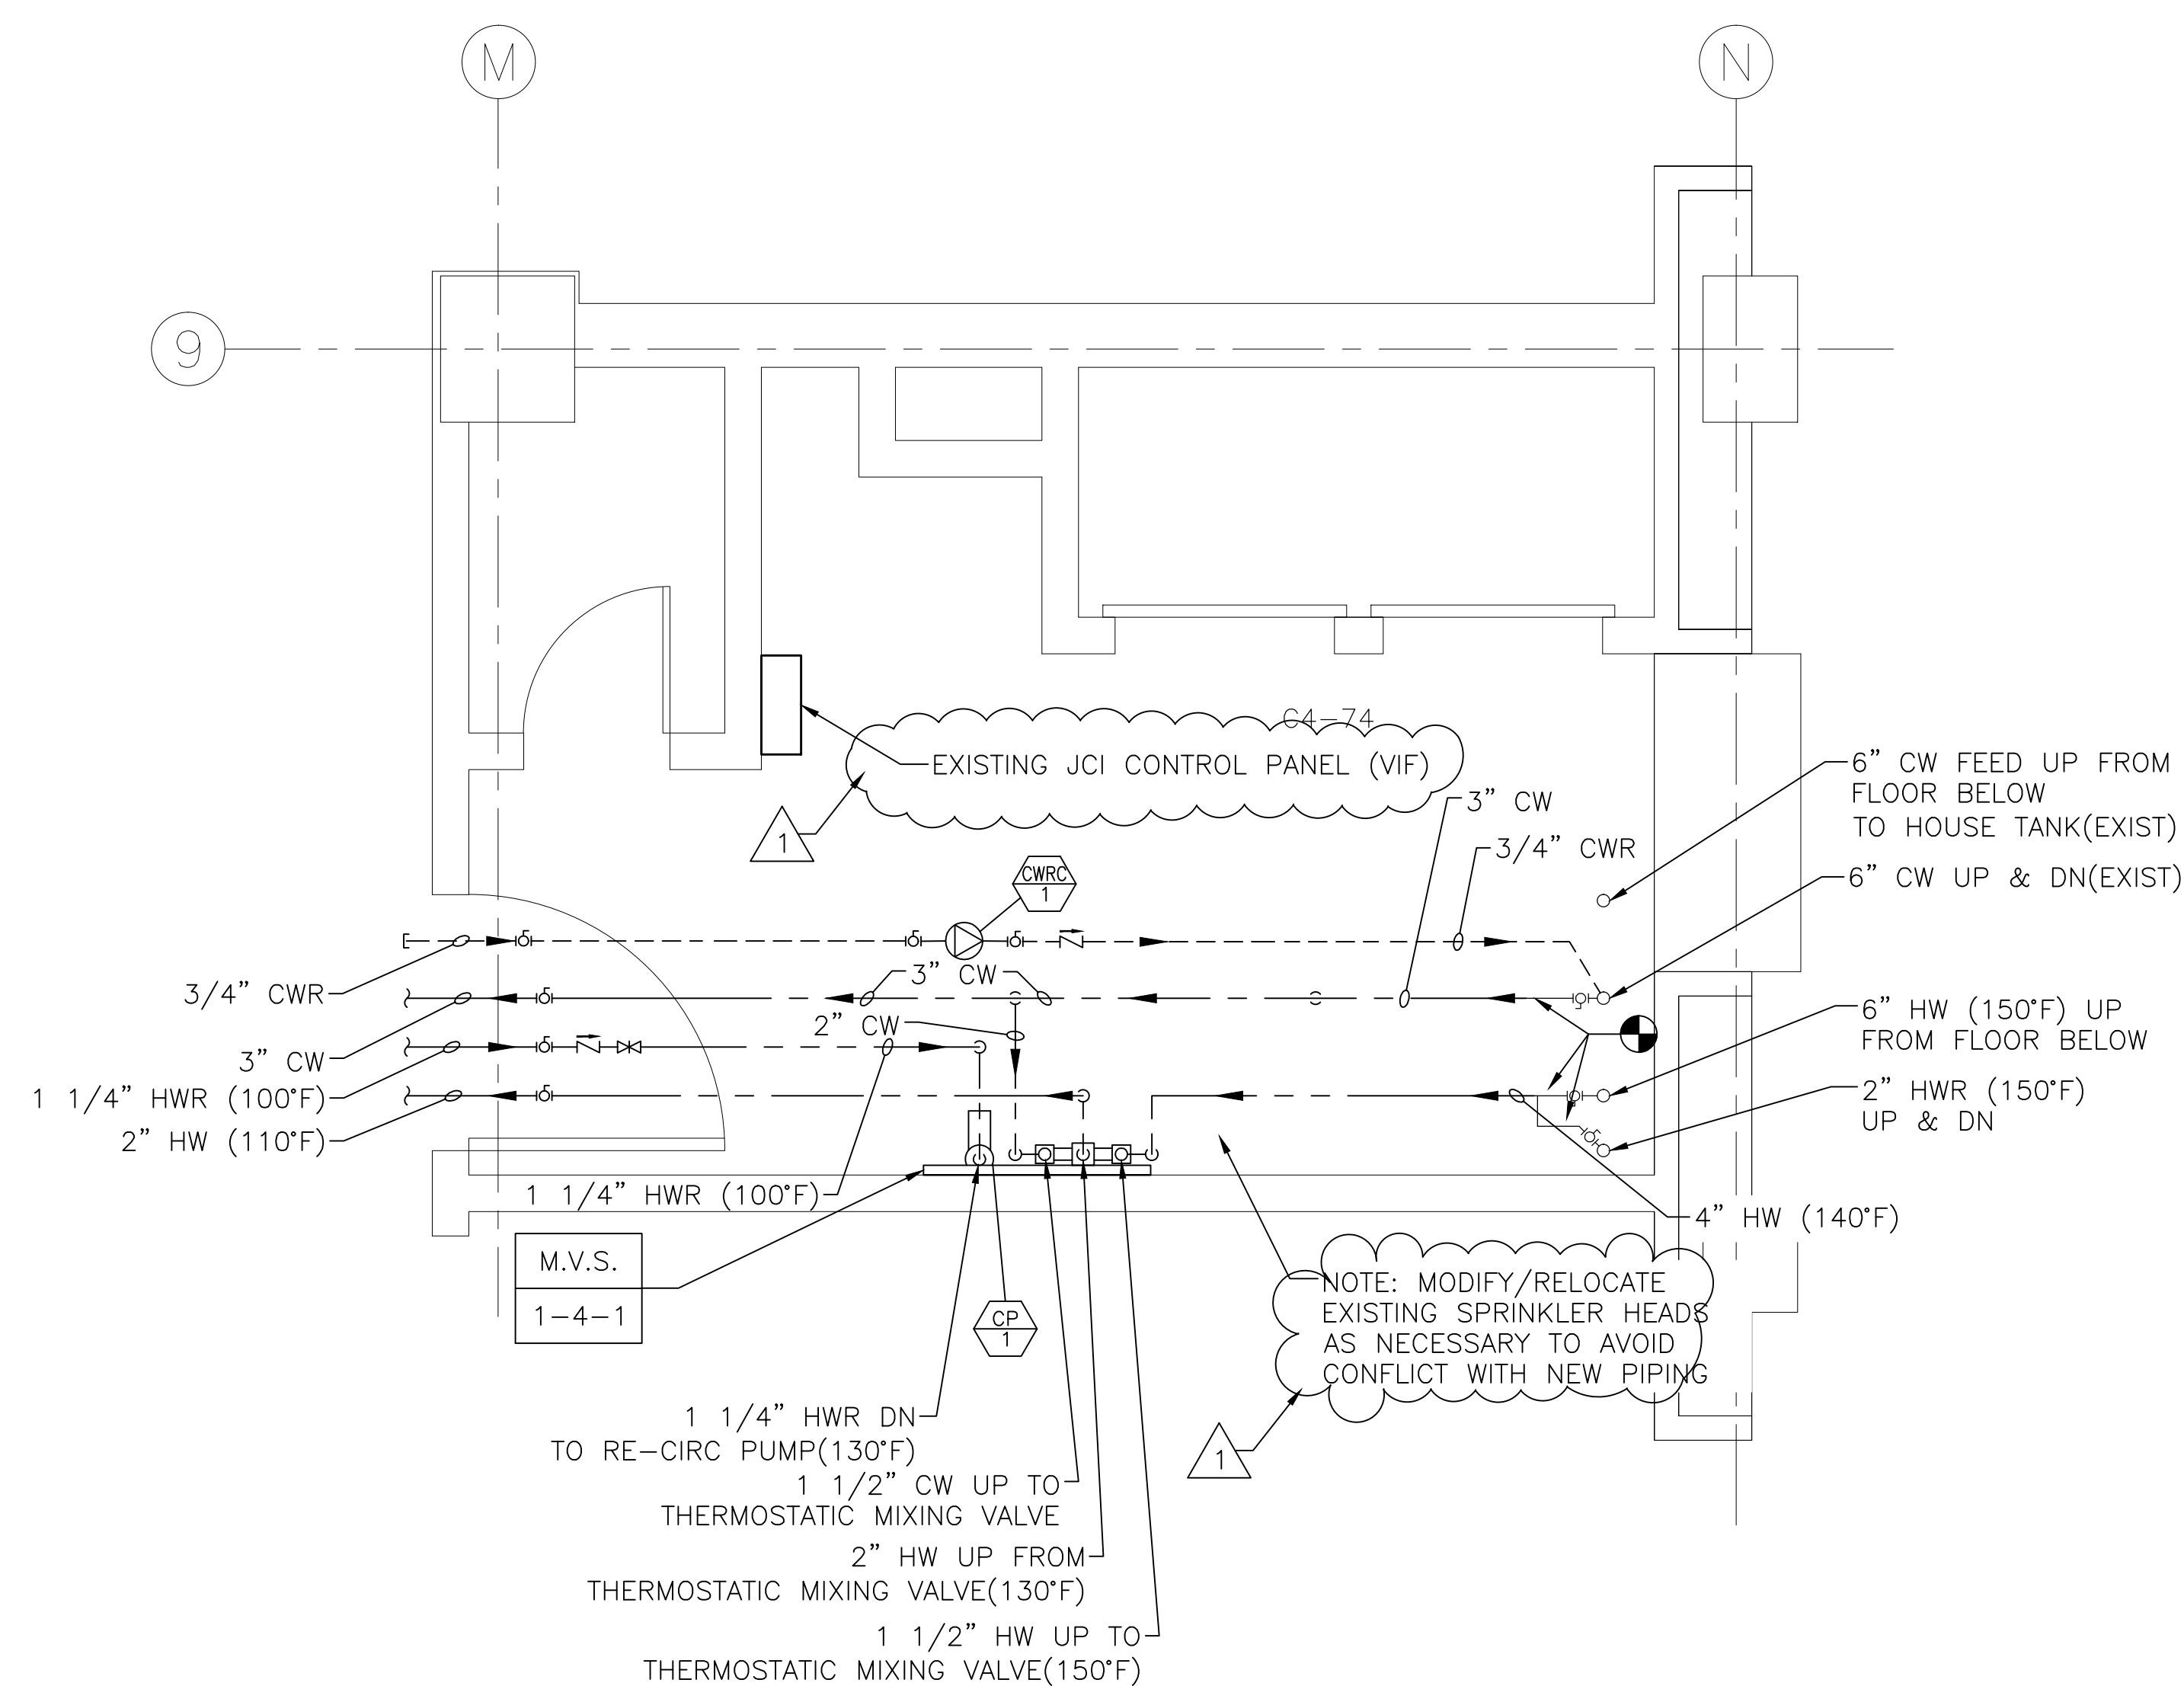

5  
1-P23  
SCALE: 1/2"=1'-0"

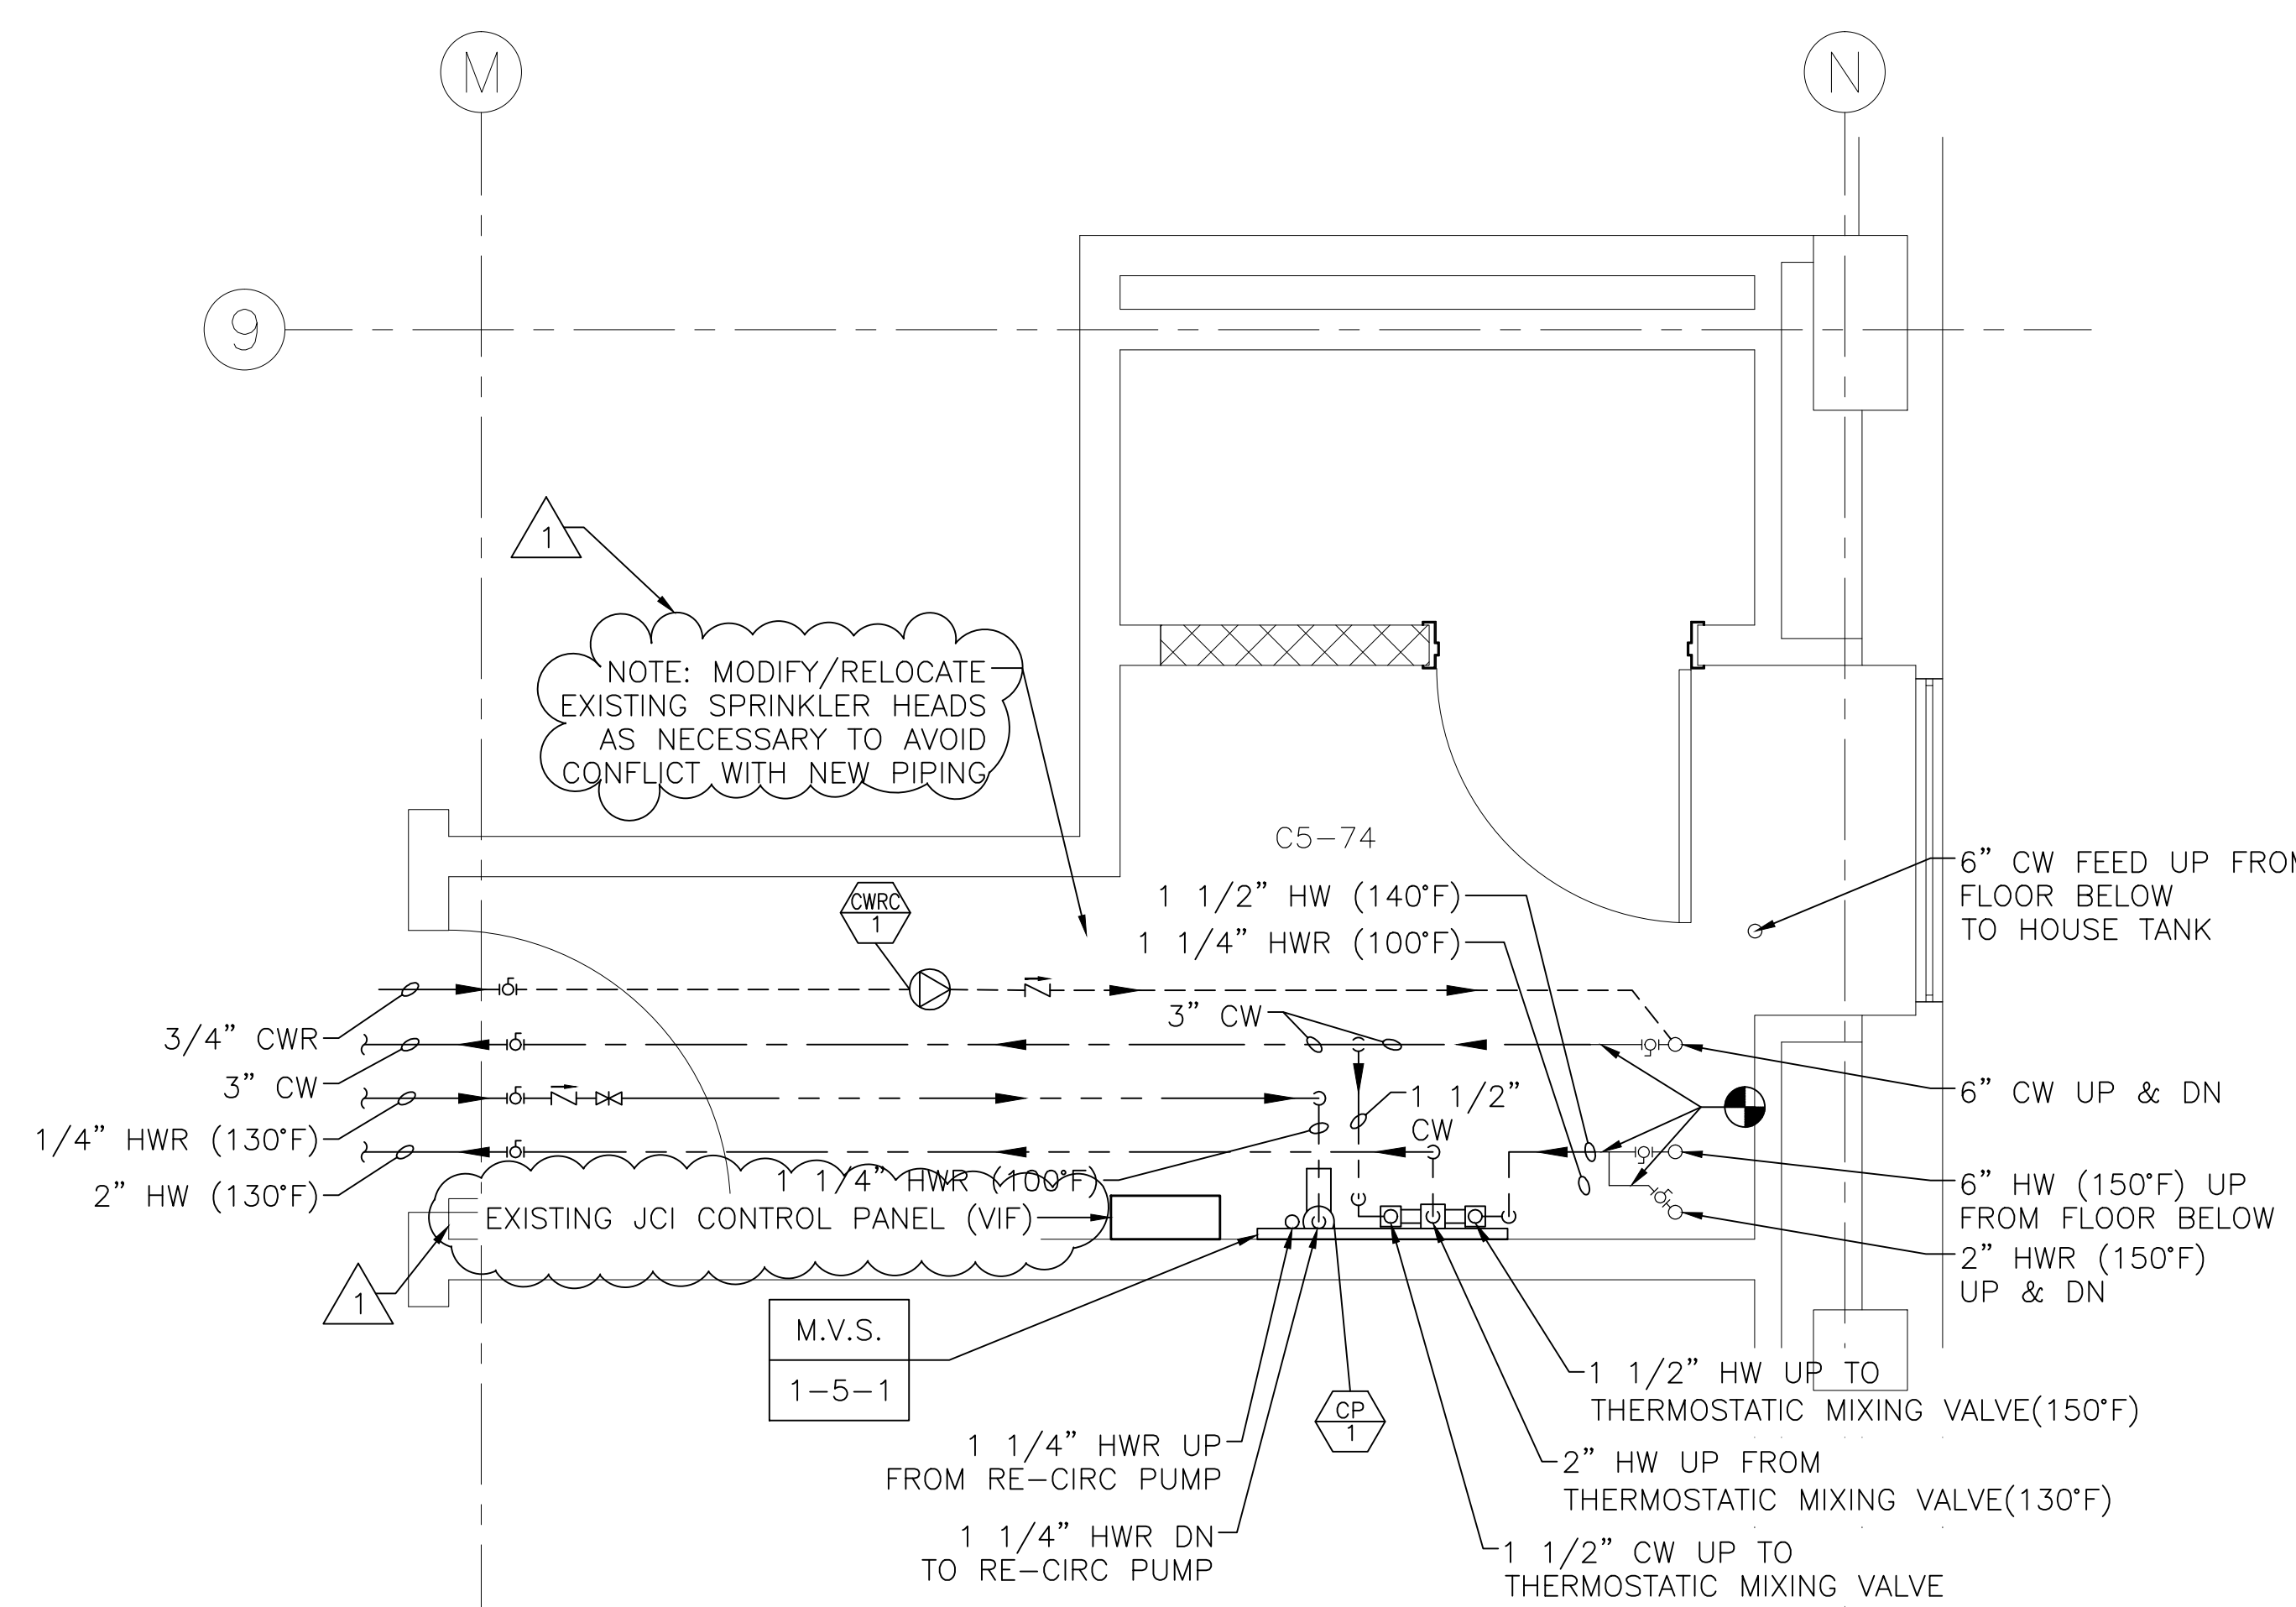

6  
1-P23  
SCALE: 1/2"=1'-0"

BID AMENDMENT  
NO.1

AUGUST 24, 2016

FULLY SPRINKLERED

AMENDMENT NO. 1	8/24/16
Revisions	Date

Professional Seal



Project Lead



Drawing Title

BUILDING 1 MIXING VALVE STATION  
ENLARGED PLANS

Facility Project Name

DEPARTMENT OF VETERANS  
AFFAIRS MEDICAL CENTER  
WILKES-BARRE, PA

Project Title

PLUMBING SYSTEM UPGRADE  
PHASE II

Building Number

1

Checked

L.J.M.

Drawn

R.W.P.

Date

08/24/2016

Project No.

693-11-119

DRAWING NO.

1-P23

DWG. 33 OF 55

Veterans  
Affairs