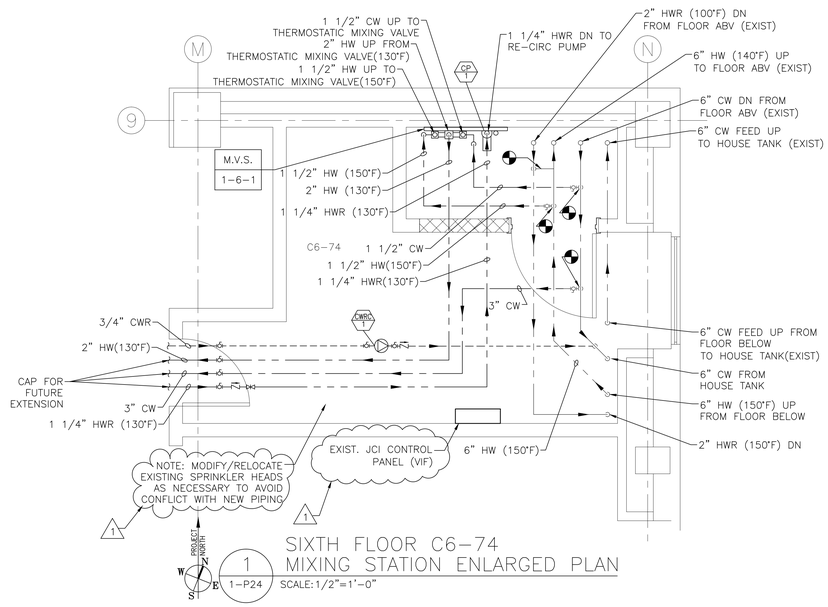

1 — 1-P24

SIXTH FLOOR C6-74
MIXING STATION ENLARGED PLAN

SCALE: 1/2"=1'-0"

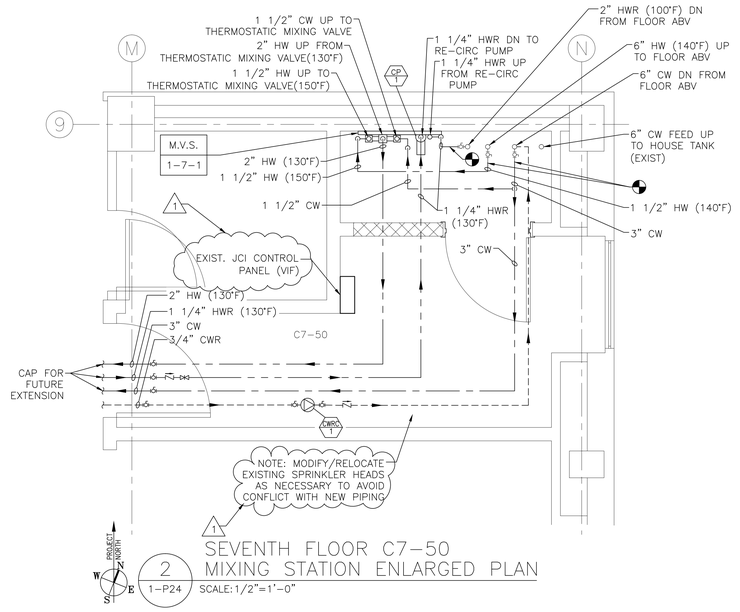

2 — 1-P24

SEVENTH FLOOR C7-50
MIXING STATION ENLARGED PLAN

SCALE: 1/2"=1'-0"

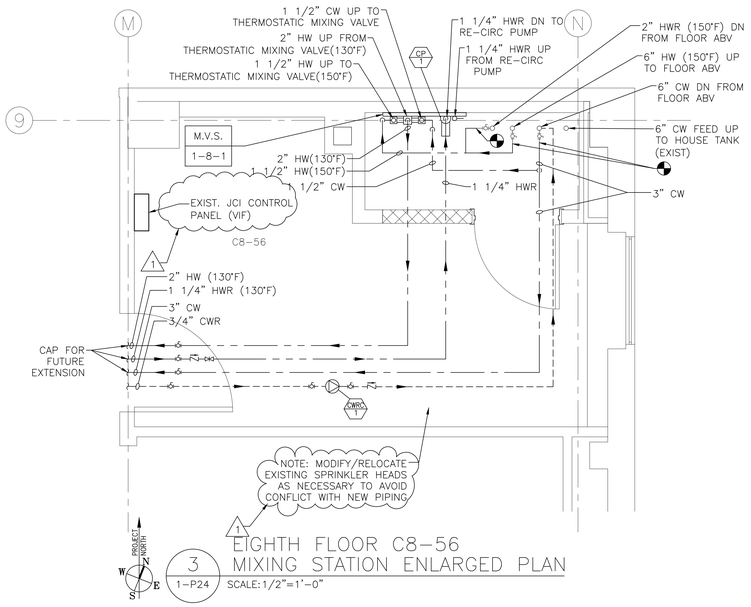

3 — 1-P24

EIGHTH FLOOR C8-56
MIXING STATION ENLARGED PLAN

SCALE: 1/2"=1'-0"

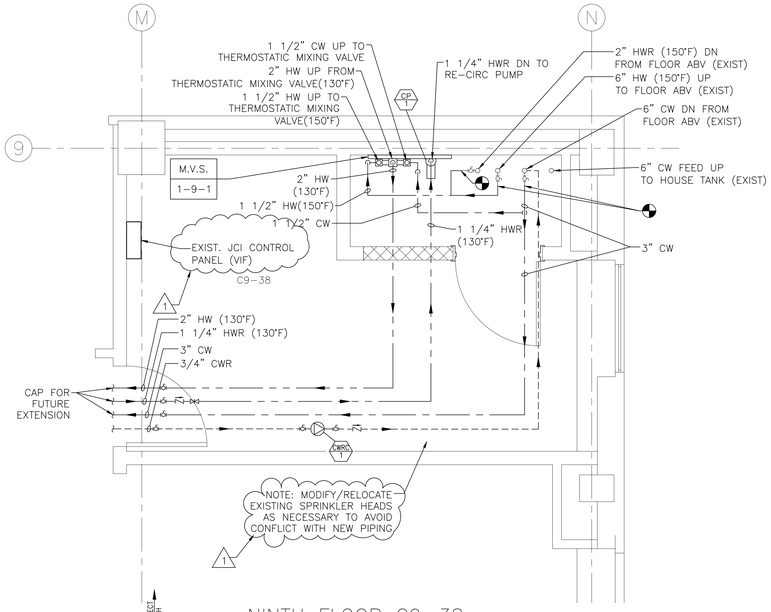

4 — 1-P24

NINTH FLOOR C9-38
MIXING STATION ENLARGED PLAN

SCALE: 1/2"=1'-0"

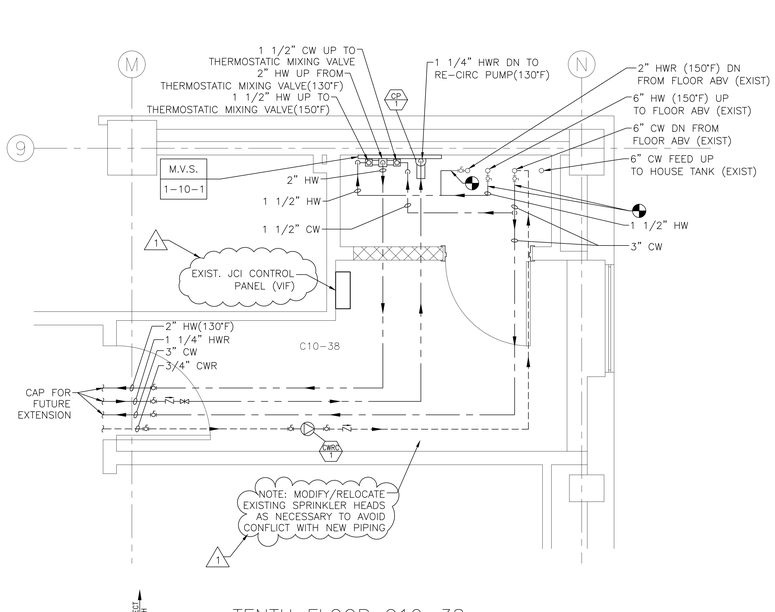

5 — 1-P24

TENTH FLOOR C10-38
MIXING STATION ENLARGED PLAN

SCALE: 1/2"=1'-0"

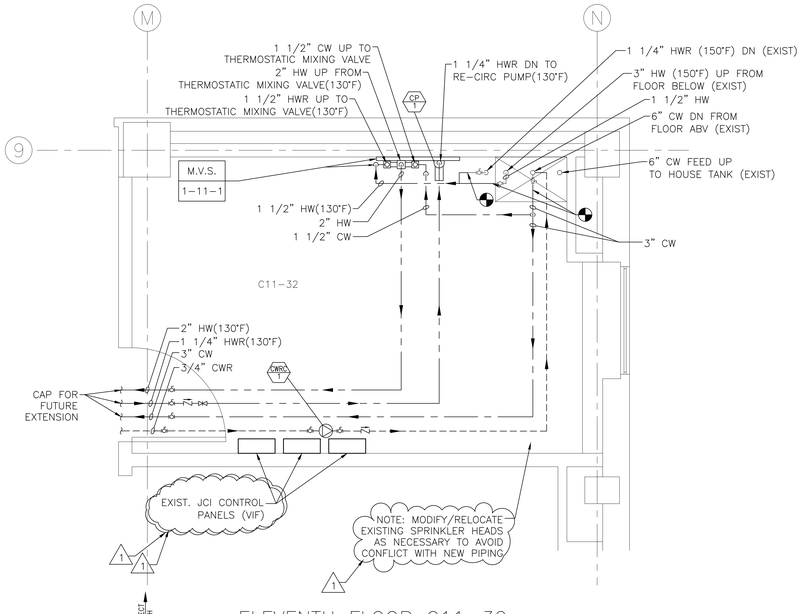

6 — 1-P24

ELEVENTH FLOOR C11-32
MIXING STATION ENLARGED PLAN

SCALE: 1/2"=1'-0"

BID AMENDMENT NO.1

AUGUST 24, 2016

FULLY SPRINKLERED

AMENDMENT NO. 1	8/24/16
Revisions	Date

Professional Seal

LAWRENCE J. MARCHETTI

Project Lead

NEI
NORTHEAST INFRASTRUCTURE, LLC
630 PARK STREET HONESDALE, PA 18431
570-253-0846 OFFICE 570-253-1935 FAX
WWW.NEINFRA.COM

Drawing Title: BUILDING 1 MIXING VALVE STATION ENLARGED PLANS

Project Title: PLUMBING SYSTEM UPGRADE PHASE II

Date: 08/24/2016

Project No.: 693-11-119

Facility Project Name: DEPARTMENT OF VETERANS AFFAIRS MEDICAL CENTER WILKES-BARRE, PA

Building Number: 1 | Checked: L.J.M. | Drawn: R.W.P.

Location: WILKES-BARRE, PENNSYLVANIA

DRAWING NO. DRAWING 1-P24

DWG. 34 OF 55

Veterans Affairs