


1 BASEMENT FLOOR PLAN -VOICE/DATA

2-EP101 | 2-TS100 1/8" = 1'-0"

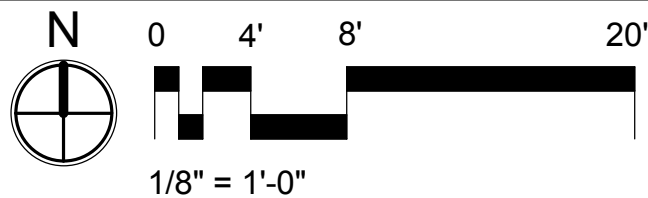

GENERAL VOICE/DATA NOTES

1 COORDINATE MOUNTING HEIGHTS AND LOCATION OF ALL DEVICES WITH ARCHITECTURAL ELEVATIONS AND CASEWORK.

2 INSTALLATION OF THE CABLE IN CONDUIT, RACEWAY AND CABLE TRAY(S) SHALL NOT EXCEED A 60% FILL RATIO.

KEYED NOTE:

- ① COORDINATE WITH VA FACILITIES PERSONNEL TO AVOID ANY DISRUPTION OF OTHER BUILDINGS.
- ② ROUTE 2" CONDUIT AND (2) 4" CONDUIT FROM WEST END SIGNAL AND TELECOM CLOSETS TO RELOCATED SECURITY AS WELL AS TELECOM/DATA (COPPER AND FIBER) IN SIGNAL RM PB01.

Revisions	Date
1 RESPONSE TO RFI #001	08-29-16

M. Moncef Hadji, P.E.  
Florida License #48022

06/20/2016

**TLC** ENGINEERING FOR ARCHITECTURE  
874 Dixon Boulevard  
Cocoa, FL 32922  
Phone: 321-634-0274  
Fax: 321-639-8986  
www.tlc-engineers.com  
© Copyright 2016 TLC Engineering for Architecture, Inc.  
COA #15 TLC NO: 515172

**mri** ARCHITECTURAL GROUP, INC.  
FLIC #AA000264  
5032 GODDARD AVENUE  
ORLANDO, FLORIDA 32804  
(407) 245-3660  
ORLANDO@MRIARCHITECTS.COM  
PETER M. IKEGAMI FL LIC #AR13065

Drawing Title

BASEMENT FLOOR PLAN  
-VOICE/DATA

Project Title

RENOVATE BUILDING 2  
(Interiors and Systems)  
RESEARCH (FCA-D)

Approved: Project Section Chief

James Dahnke

Approved: Division Chief

James A. Blatchley

Approved: Facility Director

Joe D. Battle

Location

JAMES A. HALEY VETERANS' HOSPITAL  
13000 BRUCE B. DOWNS BLVD.  
TAMPA, FLORIDA 33612

Drawn

DRS

Date

JUNE 23, 2016

Checked

MMH

Project No.

673-11-114

Bldg #

2

DRAWING NO.

2-TS100

VA File Number

Dwg.

Of

