

three inches = one foot  
One and one-half inches = one foot  
one inch = one foot  
three-quarters inch = one foot  
one-half inch = one foot  
three-eighths inch = one foot  
one-quarter inch = one foot  
one-eighth inch = one foot

A

B


C

D

E

F

G

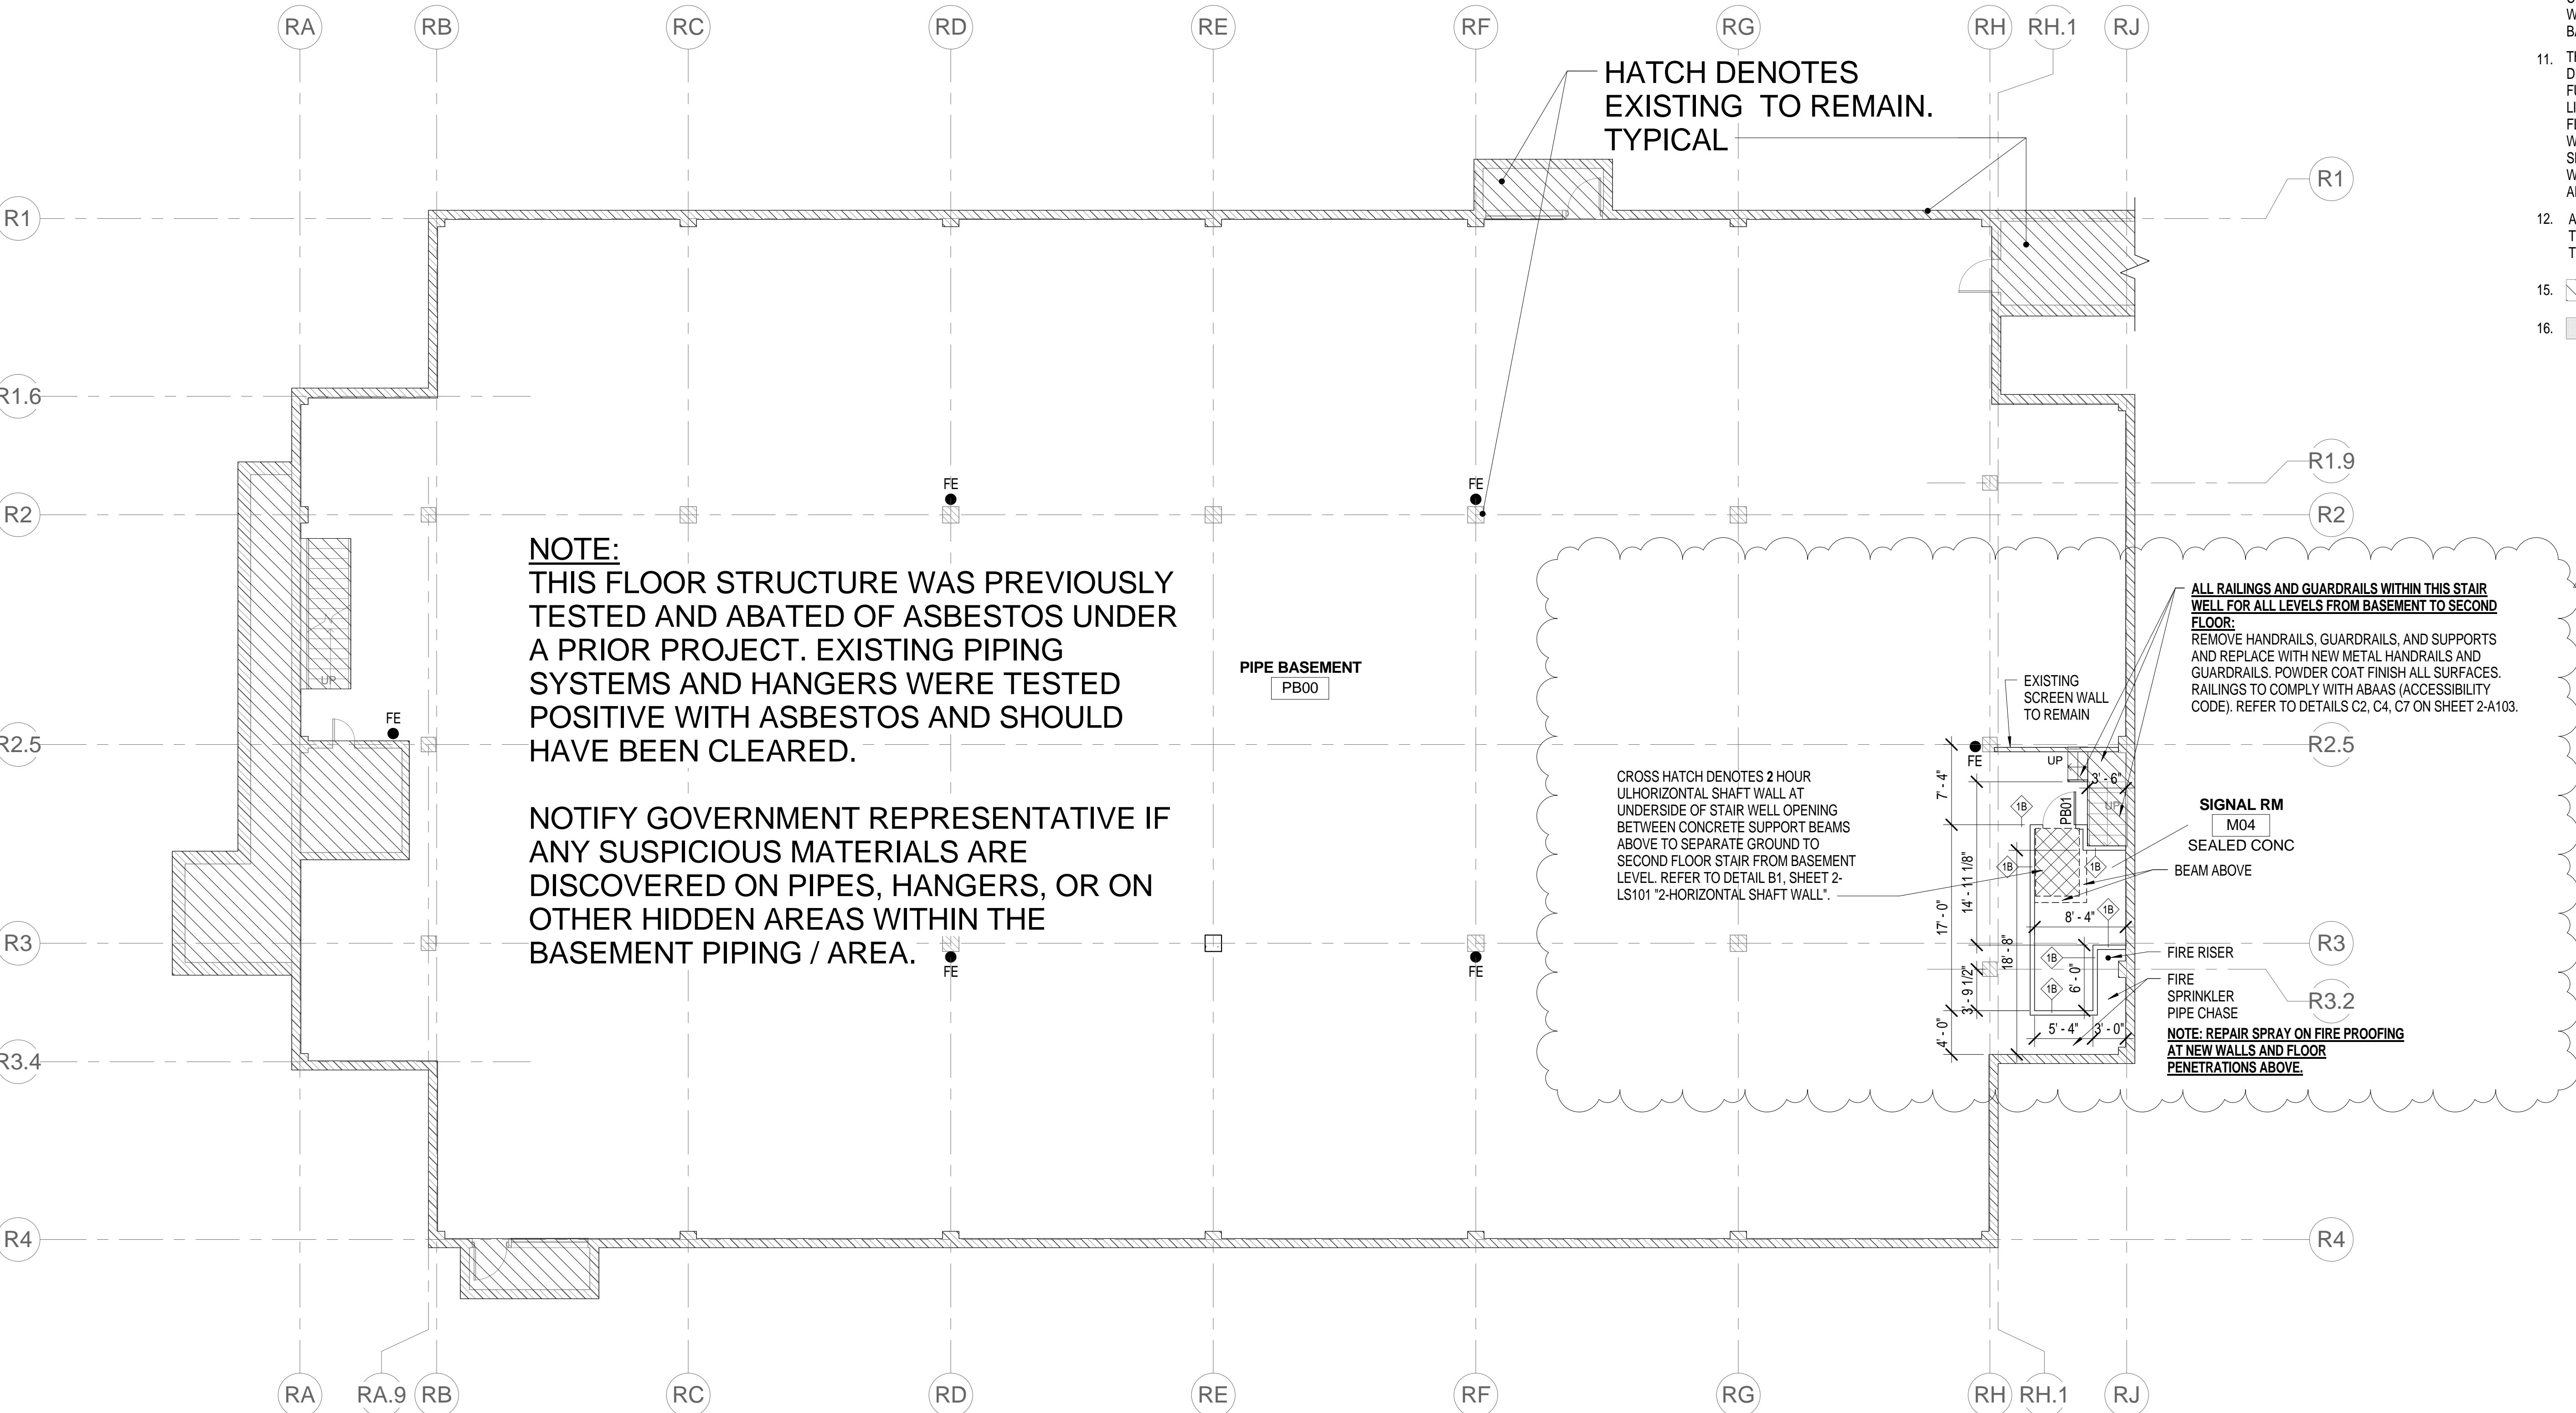

## GENERAL NOTES

- PARTITION TYPE (SEE 2-A601)
- WINDOW TYPE (SEE SHEET 2-A604)
- DOOR NUMBER (SEE SHEET 2-A604)
- SEE SHEET 2-ID001 FOR ROOM FINISH SCHEDULE.
- ALL DIMENSIONS TO OUTSIDE FACES OF CONCRETE AND CONCRETE MASONRY UNITS (CMU), FACE OF METAL STUDS OR CENTER LINE OF COLUMN UNLESS NOTED OTHERWISE. ALL DIMENSIONS FOR ADA AND ABAS SHALL BE CLEAR DIMENSIONS FROM FACE OF FINISHES.
- REFER TO LIFE SAFETY PLANS 2-LS101, 2-LS102, 2-LS103, 2-LS104, AND 2-LS105 FOR FIRE EXTINGUISHER CABINET AND WALL MOUNTED FIRE EXTINGUISHERS.
- 1-HR FIRE-RATED WALL CONSTRUCTION  
2-HR FIRE-RATED WALL CONSTRUCTION
- CONTRACTOR SHALL PROVIDE ALL BLOCKING / SUPPORTS WITHIN WALLS AND ABOVE CEILINGS FOR VA FURNISHED FINISHES / MATERIALS, DEVICES AND EQUIPMENT. ALL BLOCKING SHALL BE OF NON-COMBUSTIBLE MATERIAL. FIRE TREATED LUMBER MAY BE USED IF PERMITTED BY BUILDING CODE AND AGENCY HAVING JURISDICTION. ALL SUPPORTS SHALL BE FIELD LOCATED AND APPROVED BY ARCHITECT AND VA REPRESENTATIVE PRIOR TO FINAL INSTALLATION.
- CONTRACTOR SHALL COORDINATE ALL TRADES AND SHALL PROVIDE ELECTRICAL, MECHANICAL, PLUMBING SERVICES AND HOOKUPS TO VA FURNISHED DEVICES AND EQUIPMENT. SUCH INCLUDES, BUT ARE NOT LIMITED TO SPECIALTY LIGHT FIXTURES, CEILING MOUNTED PROJECTORS, TV MONITORS, PROJECTOR SCREENS, AUDIO EQUIPMENT, CASEWORK, ETC.
- ALL WORK SHALL COMPLY WITH ALL APPLICABLE CODES AND STATUTES, INCLUDING THE AMERICANS WITH DISABILITIES ACT (ADA) AND ARCHITECTURAL BARRIERS ACT ACCESSIBILITY STANDARDS (ABAS).
- THE EXACT LOCATION OF ALL ELECTRICAL DEVICES EXPOSED TO VIEW OR SERVING VA FURNISHED EQUIPMENT (INCLUDING BUT NOT LIMITED TO RECEPTACLES, LIGHT SWITCHES, FLOOR BOXES, TELEPHONE / DATA BOXES, WALL SCONCES, ALARMS AND THERMOSTATS) SHALL BE PHYSICALLY MARKED ON THE FLOOR, WALL AND CEILING AND APPROVED BY ARCHITECT AND VA PRIOR TO INSTALLATION.
- ANY DAMAGE TO EXTERIOR WALLS AND EXISTING TO REMAIN SHALL BE REPAIRED AND FINISHED TO MATCH ADJACENT SURFACES OR REPLACED.
- EXISTING TO REMAIN
- TEMPORARY 1-HR FIRE RATED CORRIDOR / TRANSITION SPACE

## HAZARDOUS MATERIALS:

THIS BUILDING HAS BEEN TESTED POSITIVE FOR THE PRESENCE OF HAZARDOUS MATERIALS (HM) ASBESTOS AND LEAD. REFER TO ASBESTOS SURVEY REPORT, ASBESTOS ABATEMENT DRAWINGS AND SPECIFICATIONS AND LEAD SURVEY REPORT AND ABATEMENT SPECIFICATIONS PREPARED BY OHC ENVIRONMENTAL ENGINEERING.

ALL HAZARDOUS MATERIALS WITHIN THE PROJECT LIMITS AND ASSOCIATED WITH PROJECT SCOPE OF WORK SHALL BE REMOVED PER OHC ABATEMENT SPECIFICATIONS. ALL ASBESTOS AND SHALL BE REMOVED AS INDICATED. ABATEMENT SHALL INCLUDE REMOVAL OF IDENTIFIED HAZARDOUS MATERIALS ON ALL STRUCTURE, FLOORING, WALLS CEILINGS, AND UNDERSIDE OF FLOOR AND ROOF DECKS, INCLUDING BUT NOT LIMITED TO: HAZARDOUS MATERIALS THAT ARE CONCEALED BEHIND WALLS, COLUMN SHROUDS AND INACCESSIBLE HARD CEILINGS.



ARCHITECTURAL GROUP, INC.  
5032 GODDARD AVENUE  
ORLANDO, FLORIDA 32804  
(407) 245-3660  
ORLANDO@MRIARCHITECTS.COM  
PETER M. IKEGAMI FL LIC #AR13065

Drawing Title  
DIMENSION PLAN - BASEMENT

Project Title  
RENOVATE BUILDING 2  
(Interiors and Systems)  
RESEARCH (FCA-D)

Approved: Project Section Chief  
James Dahnke

Approved: Division Chief  
James A. Blatchley

Approved: Facility Director  
Joe D. Battle



Location JAMES A. HALEY VETERANS' HOSPITAL  
13000 BRUCE B. DOWNS BLVD.  
TAMPA, FLORIDA 33612

Drawn PMI, FN Date JUNE 20, 2016

Checked JLR, COB Project No. 673-11-114

Bldg # 2 DRAWING NO.

VA File Number 2-A101 Dwg. Of

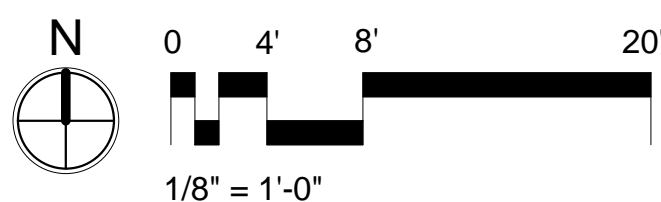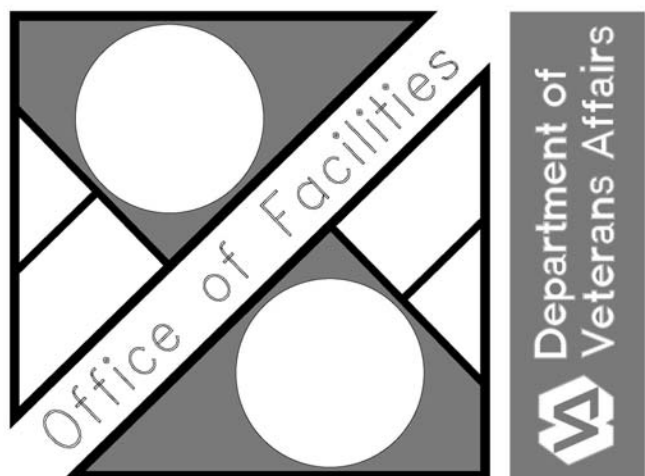

G1  
2-A301 | 2-A101  
1/8" = 1'-0"

DIMENSION PLAN - BASEMENT