



three inches = one foot
One end one-half inches = one foot
one inch = one foot
three-quarters inch = one foot
one-half inch = one foot
one-half inch = one foot
three-eighth inch = one foot
one-quarter inch = one foot
one-eighth inch = one foot

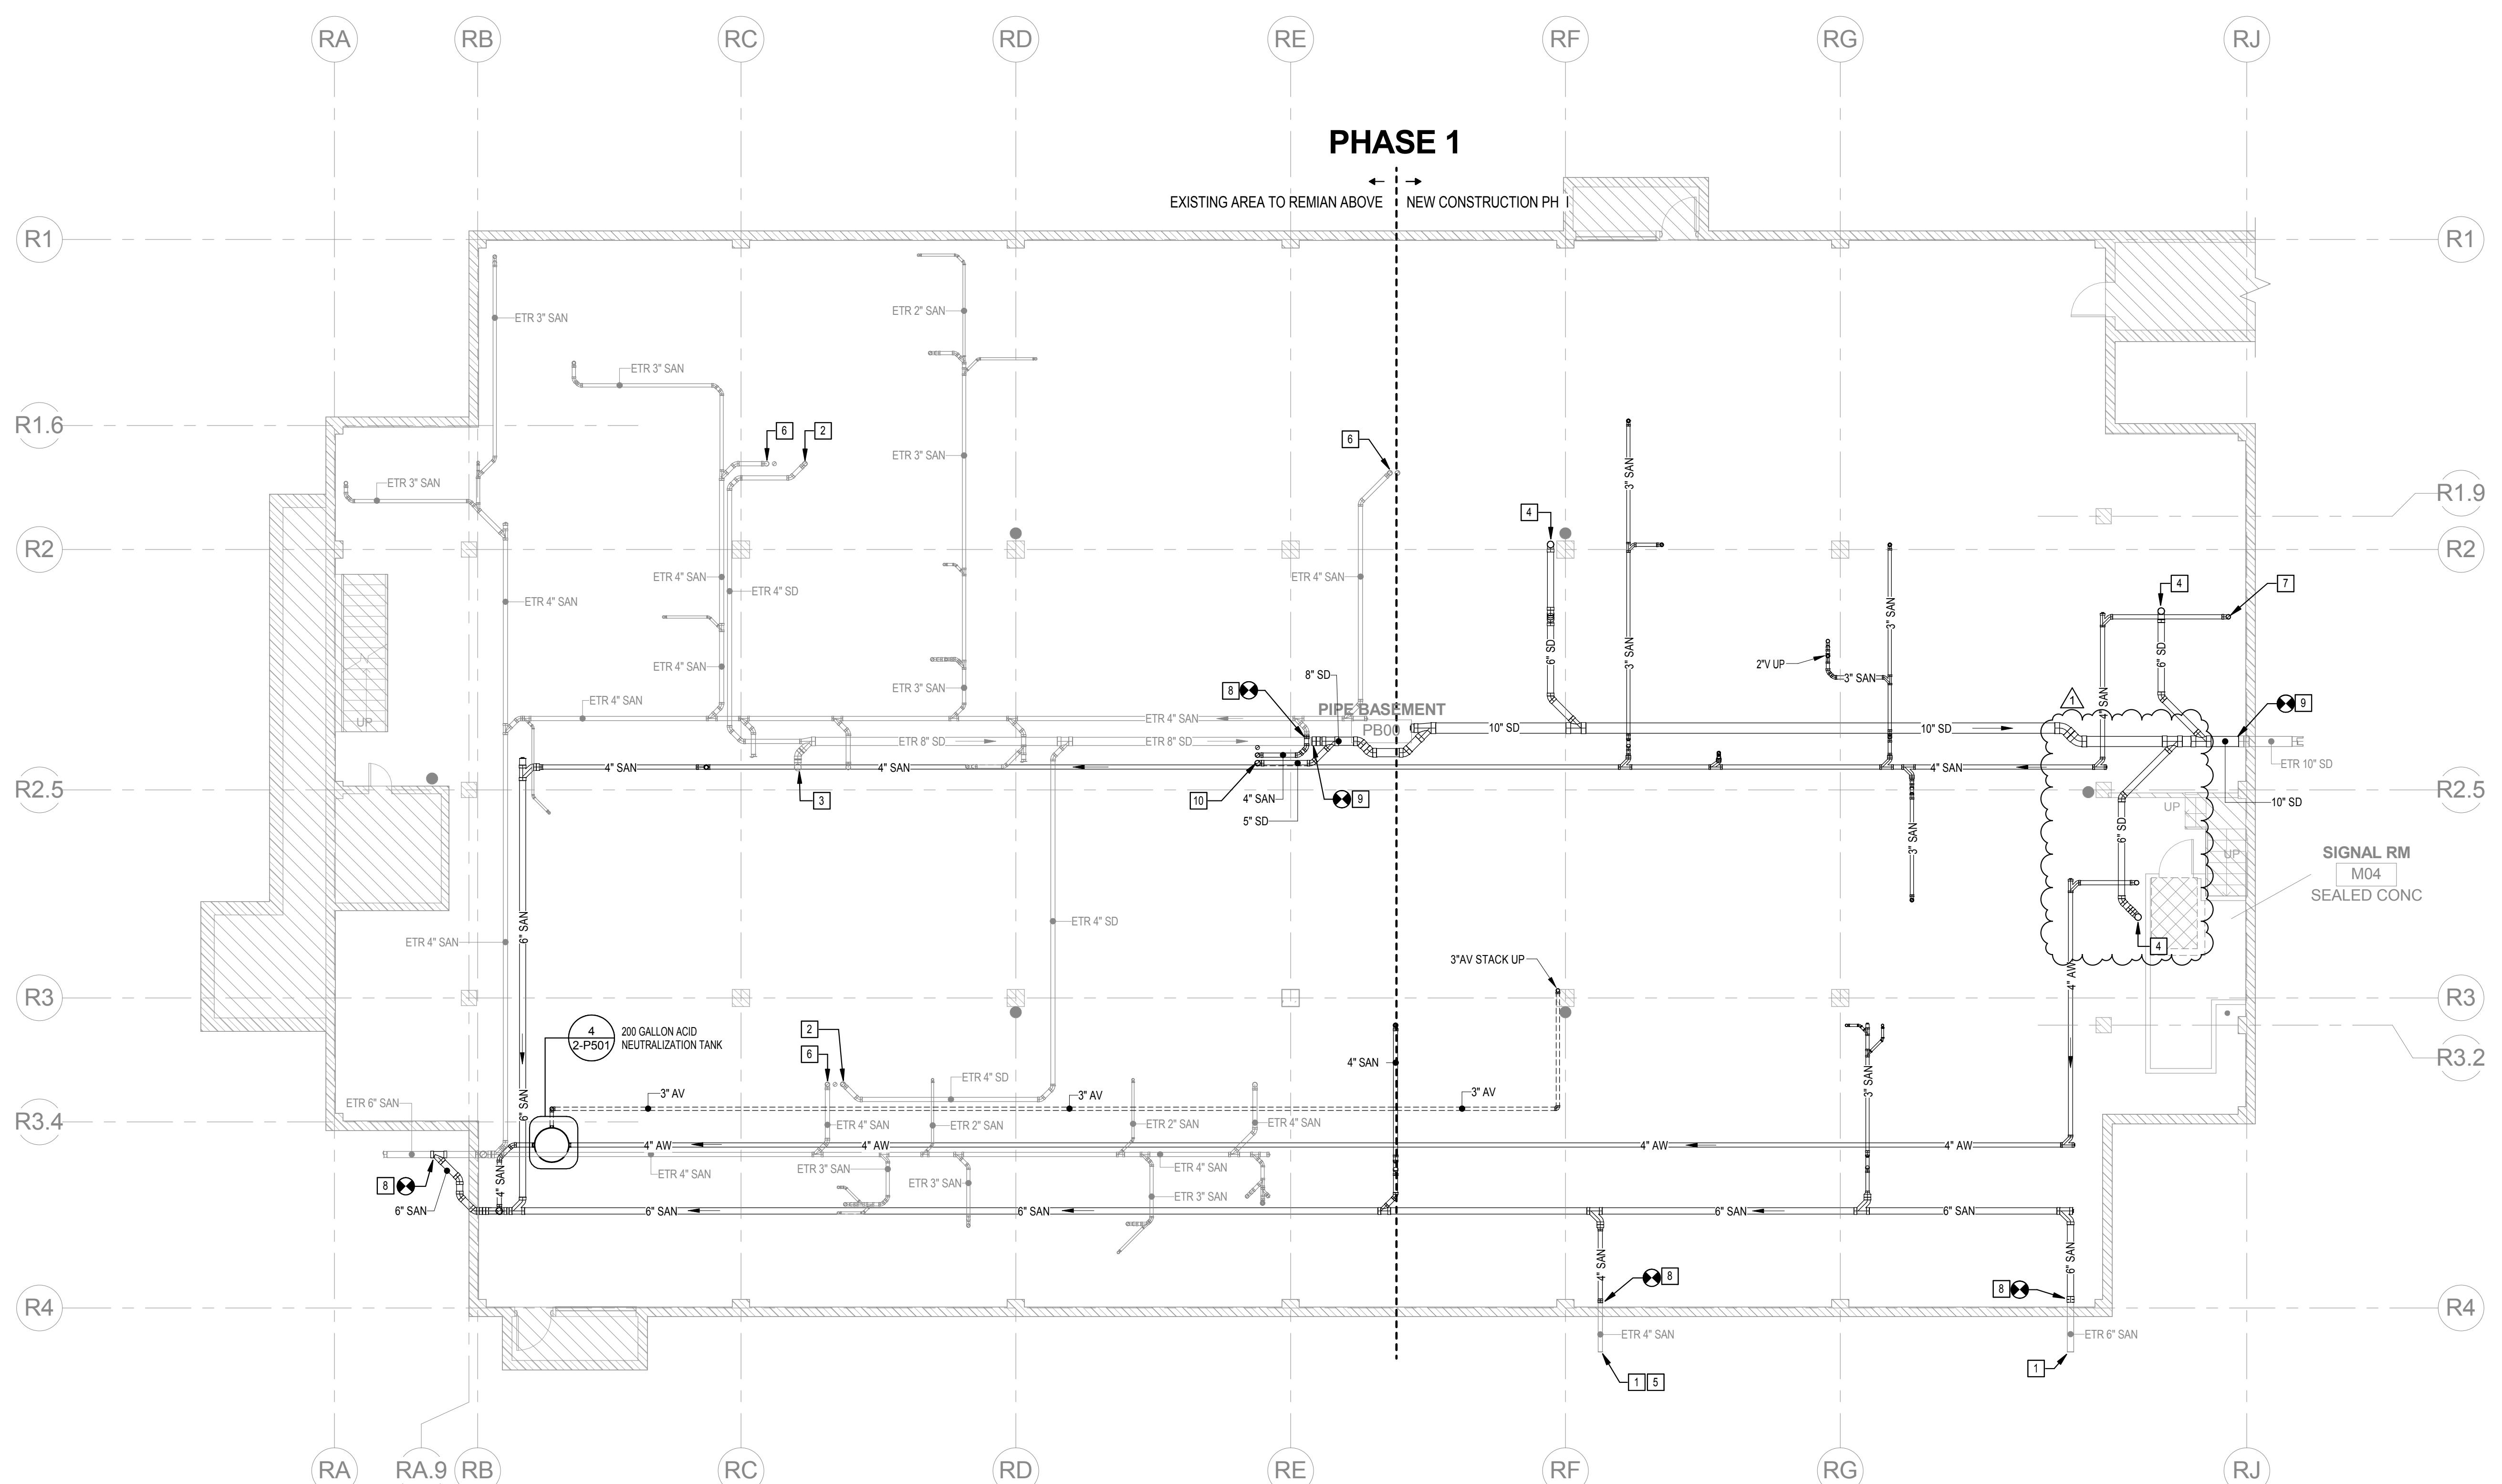

1 PLUMBING FLOOR PLAN – BASEMENT – GRAVITY
2-P201 1/8" = 1'-0"

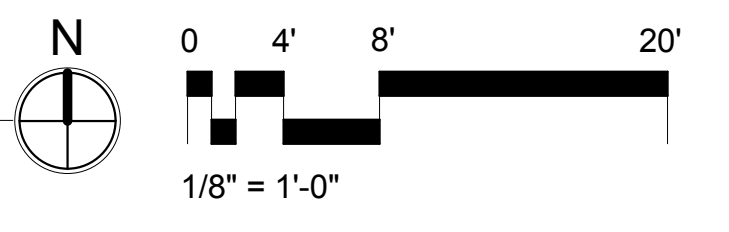

- GENERAL NOTES - GRAVITY**
- ALL SANITARY, SANITARY VENT (V), STORM (ST), AND STORM OVERFLOW (STO) AND CONDENSATE DRAIN PIPING OR ANY HORIZONTAL PIPE RUNS INDICATED ON THIS DRAWING IS LOCATED ABOVE SLAB IN WALL CHASE, CEILING SPACE OR EXPOSED IN MECHANICAL ROOMS UNLESS NOTED OTHERWISE.
 - PIPING IS SHOWN OFFSET FOR CLARITY. COORDINATE WITH HVAC AND ELECTRICAL CONTRACTORS AND PROVIDE ADDITIONAL OFFSETS AS REQUIRED TO AVOID CONFLICTS WITH OTHER TRADES.
 - PROVIDE WALL CLEANOUTS AT THE BASE OF EACH SANITARY, STORM, STORM OVERFLOW RISER (CLEANOUTS NOT SHOWN IN ALL CASES FOR DRAWING CLARITY).
 - COORDINATE ALL PIPING FLOOR PENETRATIONS WITH STRUCTURAL DRAWINGS, SLEEVE ALL BEAM PENETRATIONS.
 - FOR LAYOUT AND SIZING OF SANITARY AND VET PIPING SEE SANITARY RISER DIAGRAM.

- PHASING NOTES - RENOVATION**
- THE ENTIRE BASEMENT AREA IS PART OF PHASE 1 (NEW CONSTRUCTION) UNLESS OTHERWISE INDICATED.
 - PROVIDE NEW PLUMBING FIXTURES & EQUIPMENT & ALL ASSOCIATED PIPING & COMPONENTS FOR A COMPLETE OPERATIONAL BUILDING.
 - EXISTING SANITARY (SAN) AND VENT (V) PIPING SERVING EXISTING AREA TO REMAIN ABOVE SHALL REMAIN OPERATIONAL DURING PHASE 1 (NEW CONSTRUCTION) RENOVATION, EXCEPT FOR SHUTDOWN REQUIRED TO CONNECT TO NEW PIPING.
 - ALL EXISTING FLOOR DRAINS TO REMAIN. REPLACE ANY DRAIN THAT IS DAMAGED. RECONNECT NEW DRAINS TO EXISTING SEWER. FIELD VERIFY LOCATION OF EXISTING DRAINS AND DRAIN PIPING.
 - CONTRACTOR SHALL CAREFULLY EXAMINE ALL EXISTING UTILITIES PRIOR TO BID TO DETERMINE THE APPROPRIATE WORK REQUIRED TO MAINTAIN OPERATIONAL THE EXISTING AREAS TO REMAIN.
 - ALL EXISTING PLUMBING FIXTURES AND EQUIPMENT AND ALL ASSOCIATED PIPING AND COMPONENTS ARE EXISTING TO REMAIN OPERATIONAL UNLESS OTHERWISE INDICATED.

- PLUMBING KEYNOTES**
- | | |
|----|--|
| 1 | EXISTING PIPING TO EXISTING BUILDING. PIPING SHALL REMAIN IN SERVICE EXCEPT FOR SHUTDOWN REQUIRED TO CONNECT TO NEW PIPING. FIELD VERIFY EXACT LOCATION. |
| 2 | EXISTING TO REMAIN OPERATIONAL 4"SD LEADER. |
| 3 | EXISTING TO REMAIN OPERATIONAL 6"SD LEADER. |
| 4 | NEW 6"SD LEADER. |
| 5 | FIELD VERIFY PIPING IS LIVE AND REQUIRED TO MAINTAIN IN SERVICE BEFORE CONSTRUCTION. |
| 6 | EXISTING TO REMAIN OPERATIONAL 4"SANITARY STACK & 4"VENT STACK. |
| 7 | NEW 4"SAN STACK. |
| 8 | CONNECT EXISTING SANITARY PIPING WITH NEW SANITARY PIPING. |
| 9 | CONNECT EXISTING STORM DRAINAGE PIPING WITH NEW STORM DRAINAGE PIPING. |
| 10 | RELOCATED SANITARY, VENT & STORM DRAINAGE RISERS. FIELD VERIFY EXACT LOCATION & SERVICES REQUIRED TO BE RELOCATED. |

Revisions	Date
RESPONSE TO RFI # 001	08-29-16

TORY M. MCNEIL, P.E.
Florida License #77454

06/20/2016

874 Dixon Boulevard
Cocoa, FL 32922
Phone: 321-636-0274
Fax: 321-639-8986
www.tlc-engineers.com
© Copyright 2016 TLC Engineering for Architecture, Inc.
COA #15 TLC NO: 515172

FL LIC # A4002284

ARCHITECTURAL GROUP, INC.
5032 GODDARD AVENUE
ORLANDO, FLORIDA 32804
(407) 245-3660
ORLANDO@MRIARCHITECTS.COM
PETER M. IKEGAMI FL LIC #AR13065

Drawing Title

PLUMBING FLOOR PLAN -
BASEMENT - GRAVITY

Project Title

**RENOVATE BUILDING 2
(Interiors and Systems)
RESEARCH (FCA-D)**

Approved: Project Section Chief
James Dahnke

Approved: Division Chief
James A. Blatchley

Approved: Facility Director
Joe D. Battle

Location JAMES A. HALEY VETERANS' HOSPITAL
13000 BRUCE B. DOWNS BLVD.
TAMPA, FLORIDA 33612

Drawn ACR Date JUNE 23, 2016

Checked JJB Project No. 673-11-114

Bldg # 2 DRAWING NO.

VA File Number 2-P201
Dwg. Of

