


1 BASEMENT FLOOR PLAN — LIGHTING  
2-EP101 2-EL100 1/8" = 1'-0"

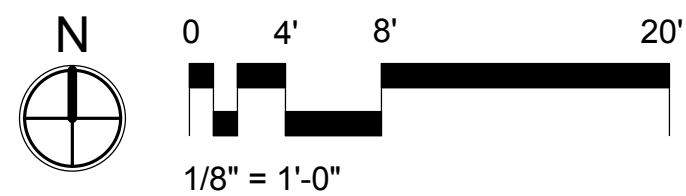

| Revisions |                      | Date     |
|-----------|----------------------|----------|
| 1         | RESPONSE TO RFI #001 | 08-29-16 |
|           |                      |          |
|           |                      |          |
| KEYNOTES - LIGHTING |   |
|---------------------|---|
| 1                   | INTERCEPT EXISTING CIRCUIT SERVING TUNNEL LIGHTS ON NORMAL POWER AND EXTEND TO NEW PANEL AS INDICATED. EXISTING SWITCHING SHALL REMAIN. |
| 2                   | INTERCEPT EXISTING CIRCUIT SERVING TUNNEL LIGHTS ON EMERGENCY POWER AND EXTEND TO NEW LIGHTING INTERTER PANEL AS INDICATED.             |

M. Moncef Hadji, P.E.  
Florida License #48022

06/20/2016

**TLC**  
ENGINEERING  
FOR ARCHITECTURE  
874 Dixon Boulevard  
Cocoa, FL 32922  
Phone: 321-434-0274  
Fax: 321-639-8986  
www.tlc-engineers.com  
© Copyright 2016 TLC Engineering for Architecture, Inc.  
COA #15 TLC NO: 515172

**mri**  
FL LIC # AA000284  
ARCHITECTURAL GROUP, INC.  
5032 GODDARD AVENUE  
ORLANDO, FLORIDA 32804  
(407) 245-3660  
ORLANDO@mriarchitects.com  
PETER M. IKEGAMI FL LIC #AR13065

Drawing Title

BASEMENT FLOOR PLAN -  
LIGHTING

Project Title

**RENOVATE BUILDING 2  
(Interiors and Systems)  
RESEARCH (FCA-D)**

Approved: Project Section Chief

**James Dahnke**

Approved: Division Chief

**James A. Blatchley**

Approved: Facility Director

**Joe D. Battle**

Location

JAMES A. HALEY VETERANS' HOSPITAL  
13000 BRUCE B. DOWNS BLVD.  
TAMPA, FLORIDA 33612

Drawn

DRS

Date

JUNE 23, 2016

Checked

MMH

Project No.

673-11-114

Bldg #

2

DRAWING NO.

2-EL100

VA File Number

Dwg.

Of

