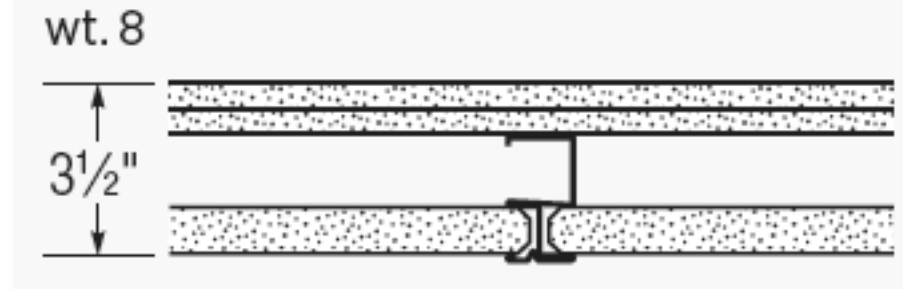



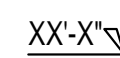

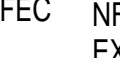



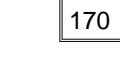


Non-loadbearing			Acoustical Performance		Reference	
Construction Detail	Description	Test Number	STC	Test Number	ARL	Index
	• 5/8" USG Sheetrock® Brand Firecode® X Panels, joints finished • 2-1/2" USG C-H studs 25 gauge 24" o.c. • 1" USG Sheetrock® Brand Gypsum Liner Panels	UL Design U415, System A or U469	39	USG-040901 Based on 4" C-H studs 25 gauge	SA926	1


b1 2 HR HORIZONTAL SHAFT WALL  
2-LS101 12" = 1'-0"

LIFE SAFETY GENERAL NOTES

- FOR BUILDING OCCUPANCY AND PLUMBING CALCULATIONS SEE SHEET 2-G002.
- RECESSED FIRE EXTINGUISHER CABINET AND 10 POUND ABC FIRE EXTINGUISHER PER 2013 OR LATEST EDITION NFPA 10, STANDARD FOR PORTABLE FIRE EXTINGUISHERS. ALL FE WITHIN CORRIDORS AND LOBBIES SHALL BE IN A SEMI-RECESSED FIRE EXTINGUISHER CABINET. ALL FIRE EXTINGUISHERS IN STORAGE ROOMS SHALL BE SURFACE MOUNTED. FIRE EXTINGUISHERS SHALL BE LOCATED SO THAT, FROM ANY POINT WITH IN THE BUILDING, THE TRAVEL DISTANCE TO THE EXTINGUISHER IS LESS THAN 50'-0".
-  PARTITION TYPE (SEE 2-A601)
-  1-HR FIRE-RATED WALL CONSTRUCTION  
 2-HR FIRE-RATED WALL CONSTRUCTION
-  MAXIMUM TRAVEL DISTANCE TO EXIT
-  SEMI RECESSED FIRE EXTINGUISHER CABINET AND 10 LB ABC EXTINGUISHER PER NFPA 10, STANDARD FOR PORTABLE FIRE EXTINGUISHERS, 2013 OR LATEST ADDITION
-  WALL MOUNTED 10 LB ABC FIRE EXTINGUISHER PER NFPA 10, STANDARD FOR PORTABLE FIRE EXTINGUISHERS, 2013 OR LATEST EDITION
-  EXIT LIGHT
-  EXIT UNIT WIDTH AND NUMBER OF PEOPLE EXIT WILL ACCOMMODATE
-  EXISTING TO REMAIN
-  TEMPORARY 1-HR FIRE RATED CORRIDOR / TRANSITION SPACE

LIFE SAFETY KEYNOTES

- SPILL CONTAINMENT CART (VV)
- DOOR TO REMAIN CLOSED TO ENTRY DURING CONSTRUCTION PANIC HARDWARE TO REMAIN FUNCTIONAL FOR EMERGENCY EGRESS ONLY.

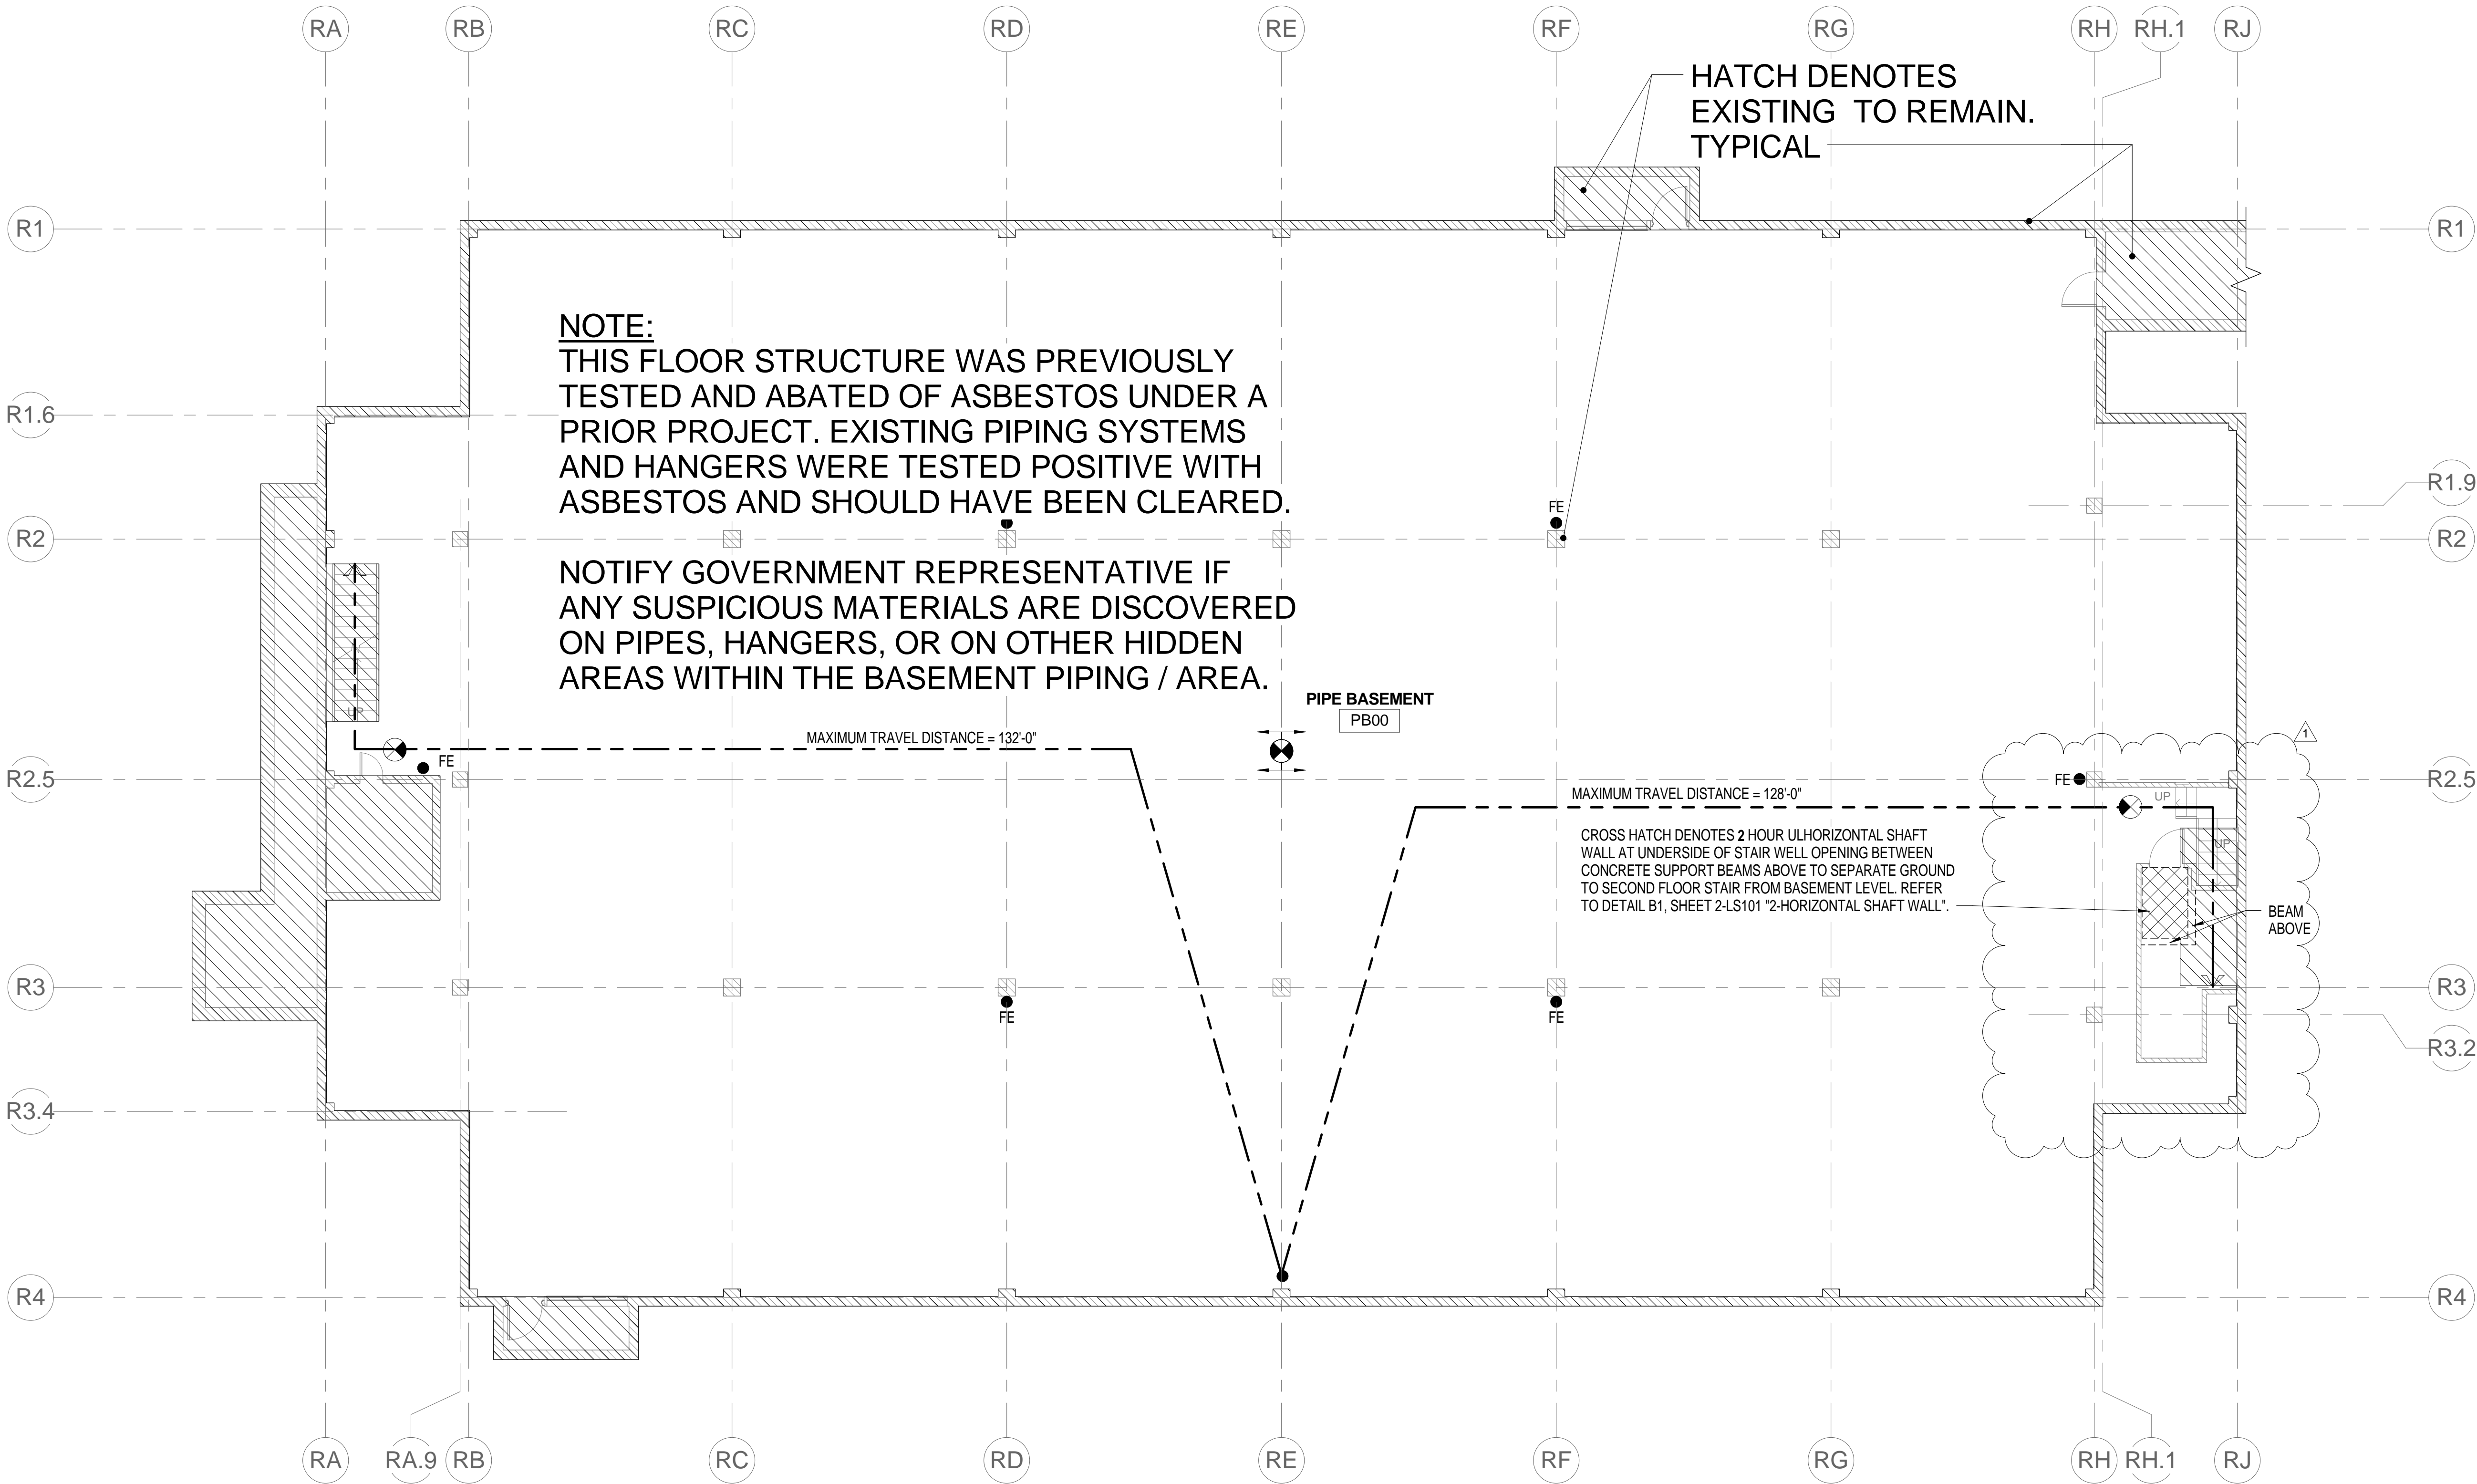

G1 LIFE SAFETY PLAN - BASEMENT  
2-A301 2-LS101 1/8" = 1'-0"

Revisions	Date
1 RESPONSE TO RFI #001	08-29-16

**HAZARDOUS MATERIALS:**

THIS BUILDING HAS BEEN TESTED POSITIVE FOR THE PRESENCE OF HAZARDOUS MATERIALS (HM) ASBESTOS AND LEAD. REFER TO ASBESTOS SURVEY REPORT, ASBESTOS ABATEMENT DRAWINGS AND SPECIFICATIONS AND LEAD SURVEY REPORT AND ABATEMENT SPECIFICATIONS PREPARED BY OHC ENVIRONMENTAL ENGINEERING.

ALL HAZARDOUS MATERIALS WITHIN THE PROJECT LIMITS AND ASSOCIATED WITH PROJECT SCOPE OF WORK SHALL BE REMOVED PER OHC ABATEMENT SPECIFICATIONS. ALL ASBESTOS AND SHALL BE REMOVED AS INDICATED. ABATEMENT SHALL INCLUDE REMOVAL OF IDENTIFIED HAZARDOUS MATERIALS ON ALL STRUCTURE, FLOORING, WALLS CEILINGS, AND UNDERSIDE OF FLOOR AND ROOF DECKS, INCLUDING BUT NOT LIMITED TO, HAZARDOUS MATERIALS THAT ARE CONCEALED BEHIND WALLS, COLUMN SHROUDS AND INACCESSIBLE HARD CEILINGS.

**mri** FL LIC: # AA0002264

ARCHITECTURAL GROUP, INC.

5032 GODDARD AVENUE  
ORLANDO, FLORIDA 32804  
(407) 245-3660  
ORLANDO@MRIARCHITECTS.COM  
PETER M. IKEGAMI FL LIC #AR13065

Drawing Title

LIFE SAFETY PLAN - BASEMENT

Project Title

RENOVATE BUILDING 2  
(Interiors and Systems)  
RESEARCH (FCA-D)

Approved: Project Section Chief  
James Dahnke

Approved: Division Chief  
James A. Blatchley

Approved: Facility Director  
Joe D. Battle

Location JAMES A. HALEY VETERANS' HOSPITAL  
13000 BRUCE B. DOWNS BLVD.  
TAMPA, FLORIDA 33612

Drawn PMJ, FN Date JUNE 20, 2016

Checked JLR, COB Project No. 673-11-114

Bldg # 2 DRAWING NO.

VA File Number 2-LS101 Dwg. Of

Office of Facilities  
Department of Veterans Affairs

