


one-eighth inch = one foot
one-quarter inch = one foot
three-eighths inch = one foot
one-half inch = one foot
three-quarters inch = one foot
one inch = one foot
one and one-half inches = one foot
three inches = one foot

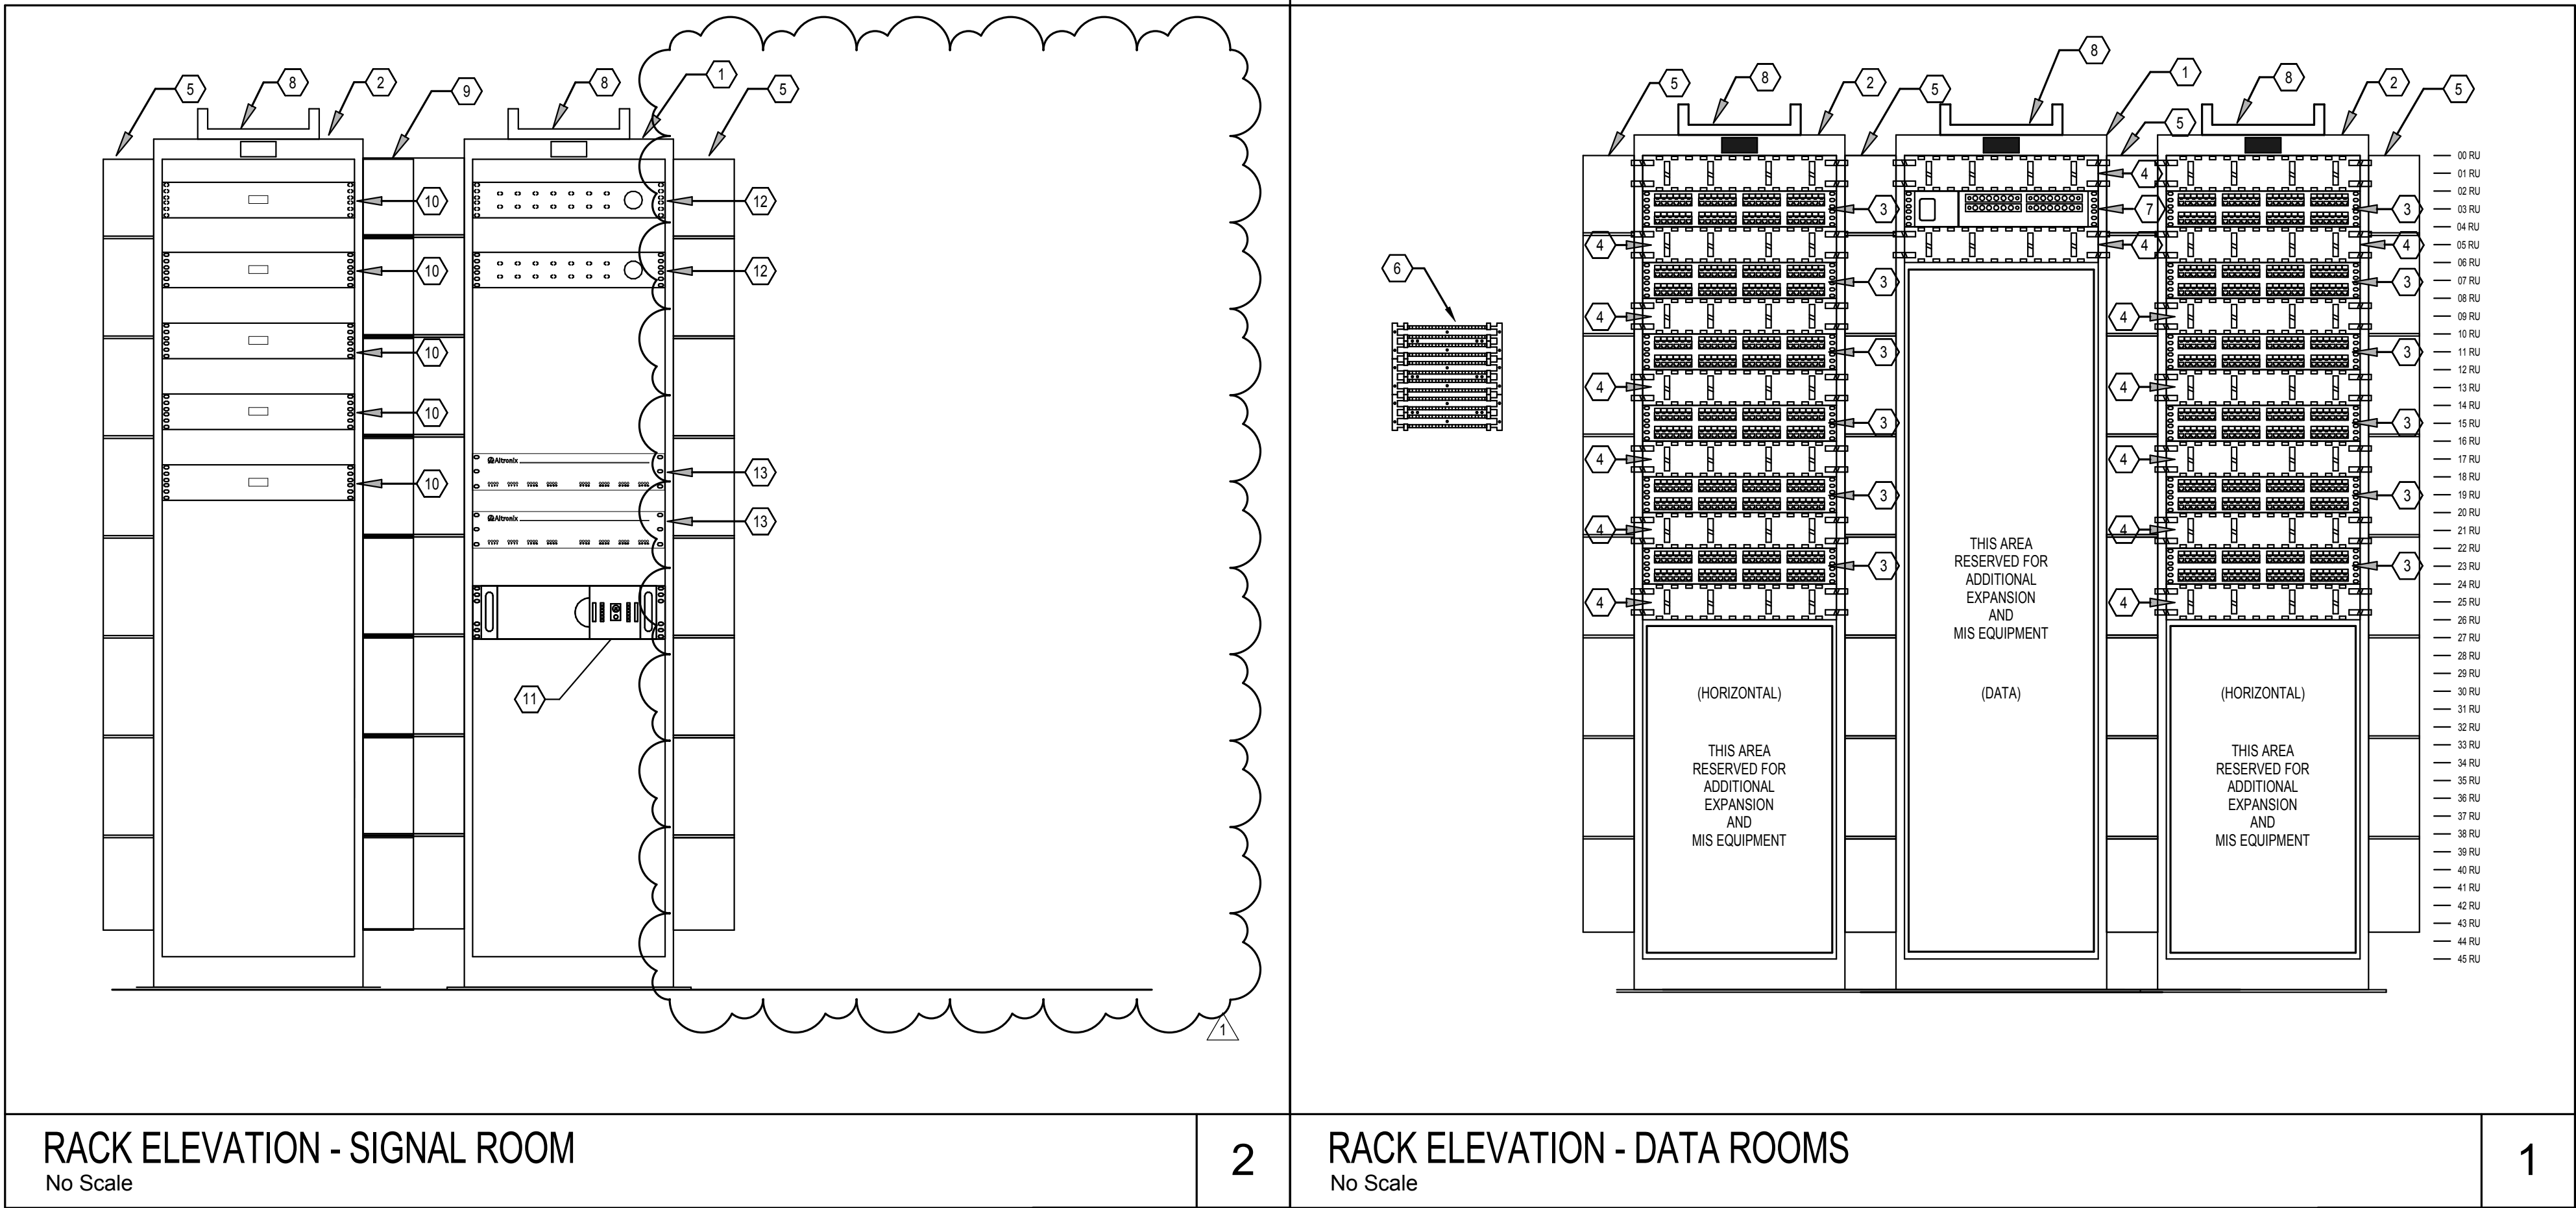

- RACK ELEVATION NOTES:**
- 1 PROVIDE EQUIPMENT 7' X 10' RACKS - BLACK FINISH (UL LISTED), CHATSWORTH #57003-703 6' DOUBLE SIDED GVCS.
 - 2 PROVIDE 7'X10' EQUIPMENT RACK - BLACK FINISH (UL LISTED), CHATSWORTH #30056-703.
 - 3 48 PORT PATCH PANEL - PROVIDE QUANTITY AS REQUIRED TO SUPPORT HORIZONTAL CABLE TERMINATIONS. ORTRONICS/OR-PHD58U48
 - 4 PROVIDE 2 RU HORIZONTAL WIRE MANAGER, CHATSWORTH #30530-719
 - 5 7' X 6' VERTICAL WIRE MANAGER, MCS-EFX 40066-703. PROVIDE WITH RACK.
 - 6 PROVIDE 3 ROWS OF WALL MOUNTED 66 BLOCKS (66-M SPLIT 25-PAIR PUNCH DOWN) VERTICALLY WITH 88 STAND OFF BRACKETS FOR COPPER RISER CABLE TERMINATION. LEVITON #44WJ2-100
 - 7 PROVIDE 3 RU RACK MOUNT FIBER PANEL (12) WITH POSITION ST BULKHEAD, LEVITON #50740-00N, (4) ST-MM #5F100-1ST AND (1) ST SM #5F100-2T.
 - 8 PROVIDE LADDER RACK 12" (TYPICAL AT EACH RACK), CHATSWORTH #11275-712
 - 9 7' X 10' VERTICAL WIRE MANAGER, MCS-EFX 40066-703.
 - 10 BOGEN BP460 POWER AMPLIFIER.
 - 11 UPS AS SPECIFIED. PROVIDE 2-POST MOUNTING KIT WHERE REQUIRED TO MOUNT THIS EQUIPMENT IN A 2-POST RACK.
 - 12 BOSCH DIGITAL VIDEO RECORDERS FOR CCTV SYSTEM. 30 DAY STORAGE, 15 FRAMES PER SEC. @ 4 CIF.
 - 13 RACK MOUNTED LOW VOLTAGE POWER SUPPLIES AS REQUIRED FOR THE CCTV SYSTEM.

Revisions	Date
1/ RESPONSE TO RFI #001	08-29-16

M. Moncef Hadji, P.E.
Florida License #48022

06/20/2016

TLC 874 Dixon Boulevard
Cocoa, FL 32922
Phone: 321-634-0274
Fax: 321-639-8786
ENGINEERING FOR ARCHITECTURE www.tlc-engineers.com
© Copyright 2016 TLC Engineering for Architecture, Inc.
COA #15 TLC NO: 515172

mri FL LIC # AA0002264
ARCHITECTURAL GROUP, INC.
5032 GODDARD AVENUE
ORLANDO, FLORIDA 32804
(407) 245-3660
ORLANDO@MRIARCHITECTS.COM
PETER M. IKEGAMI FL LIC #AR13065

Drawing Title
TECHNOLOGY ELEVATIONS

Project Title
**RENOVATE BUILDING 2
(Interiors and Systems)
RESEARCH (FCA-D)**

Approved: Project Section Chief
James Dahnke

Approved: Division Chief
James A. Blatchley

Approved: Facility Director
Joe D. Battle

Location **JAMES A. HALEY VETERANS' HOSPITAL
13000 BRUCE B. DOWNS BLVD.
TAMPA, FLORIDA 33612**

Drawn **DRS** Date **JUNE 23, 2016**

Checked **MMH** Project No. **673-11-114**

Bldg # **2** DRAWING NO. **2-T501**

VA File Number Dwg. **2-T501** Of

Office of Facilities
Department of Veterans Affairs