
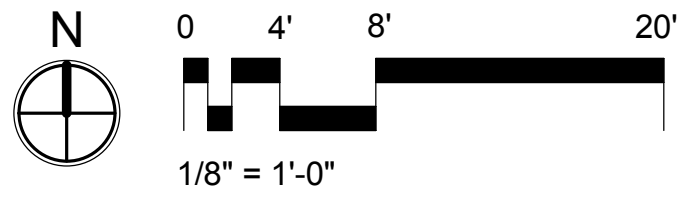


1 ELECTRICAL DEMOLITION – BASEMENT FLOOR PLAN
2-EP101 | 2-ED100 1/8" = 1'-0"

- GENERAL DEMOLITION NOTES**
- 1 UNLESS OTHERWISE NOTED, ALL ELECTRICAL EQUIPMENT, WIRING DEVICES, CONDUIT AND WIRES INSIDE, ON WALLS OR IN CEILING OF SPACES NOT BE DEMOLISHED SHALL REMAIN IN PLACE OR BE REWORKED AS NECESSARY.
 - 2 UNLESS OTHERWISE NOTED, ALL EQUIPMENT, WIRING DEVICES, LIGHT FIXTURES, CONDUIT AND WIRE IN THE LOCATIONS OF DEMOLITION SHALL BE REMOVED BACK TO THE SOURCE.
 - 3 ALL ITEMS REMOVED UNDER THIS PROJECT SHALL BE DISPOSED OF OR TURNED OVER TO THE OWNER AT THE OWNER'S DISCRETION.
 - 4 ALL CONDUITS SERVING OTHER SPACES OR FLOORS, THAT RUN THROUGH THE PROJECT AREA SHALL REMAIN ACTIVE DURING CONSTRUCTION, SO AS NOT TO CAUSE ANY DISRUPTION TO THESE OTHER SPACES. IT IS THE CONTRACTOR'S RESPONSIBILITY TO INSURE THAT ALL CONDUITS, NEW OR EXISTING, WITHIN THE PROJECT AREA ARE PROPERLY SUPPORTED AND PROVIDED W/ BONDING BUSHINGS IN ACCORDANCE WITH THE NATIONAL ELECTRIC CODE.
 - 5 THE DEMOLITION PLAN IS NOT INCLUSIVE OF ALL ELECTRICAL DEVICES WITHIN THE PROJECT AREA. IT IS INTENDED TO PROVIDE THE CONTRACTOR WITH A GENERAL KNOWLEDGE OF THE EXISTING CONDITIONS WITHIN THE PROJECT AREA. ANY DISCREPANCIES OR CONDITIONS NOT SHOWN ON THIS PLAN SHALL BE BROUGHT TO THE ATTENTION OF THE ENGINEER. THE CONTRACTOR IS RESPONSIBLE FOR ALL REQUIRED DEMOLITION WHETHER SHOWN ON THE PLANS OR NOT.
 - 6 UNLESS OTHERWISE NOTED, ALL ELECTRICAL EQUIPMENT, WIRING DEVICES, CONDUIT AND WIRES INSIDE, ON WALLS OR IN CEILING OF AREAS BEING RENOVATED/REMOVED SHALL BE REMOVED, RELOCATED OR DEMOLISHED AS NECESSARY. THE REUSE OF EXISTING RACEWAYS AND BACKBOXES WILL BE PERMITTED, IF REQUIREMENTS OF "RE-CIRCUITING" ON THE LEGEND SHEET ARE MET. THE CONTRACTOR SHALL INVESTIGATE THE PROJECT AREA PRIOR TO BID TO DETERMINE ALL REQUIRED DEMOLITION.
 - 7 "ETR" DENOTES EXISTING ELECTRICAL DEVICE TO REMAIN. THESE DEVICES SHOULD REMAIN IN THERE EXISTING LOCATION, BUT MAYBE SUBJECT TO RE-CIRCUITING AND POSSIBLE RELOCATION AND CONNECTION TO NEW CONTROL DEVICES (I.E. SWITCHES, MOTION SENSOR, ETC.). CONTROL DEVICES THAT ARE NOT SHOWN ON DRAWINGS SHOULD REMAIN AND FEED EXISTING/NEW DEVICES AS NECESSARY. EXISTING DEVICES MAY REQUIRE REMOVAL AND/OR REWORK OF EXISTING BACKBOXES FOR DEPTH REQUIREMENTS TO FINISH WALL. COORDINATE THIS ACTIVITY IN THE FIELD AND PROVIDE WORK AS REQUIRED.
 - 8 TEMPORARY HEAT DETECTORS SHALL BE INSTALLED THROUGHOUT THE FACILITY DURING CONSTRUCTION IN ACCORDANCE WITH NFPA 72.

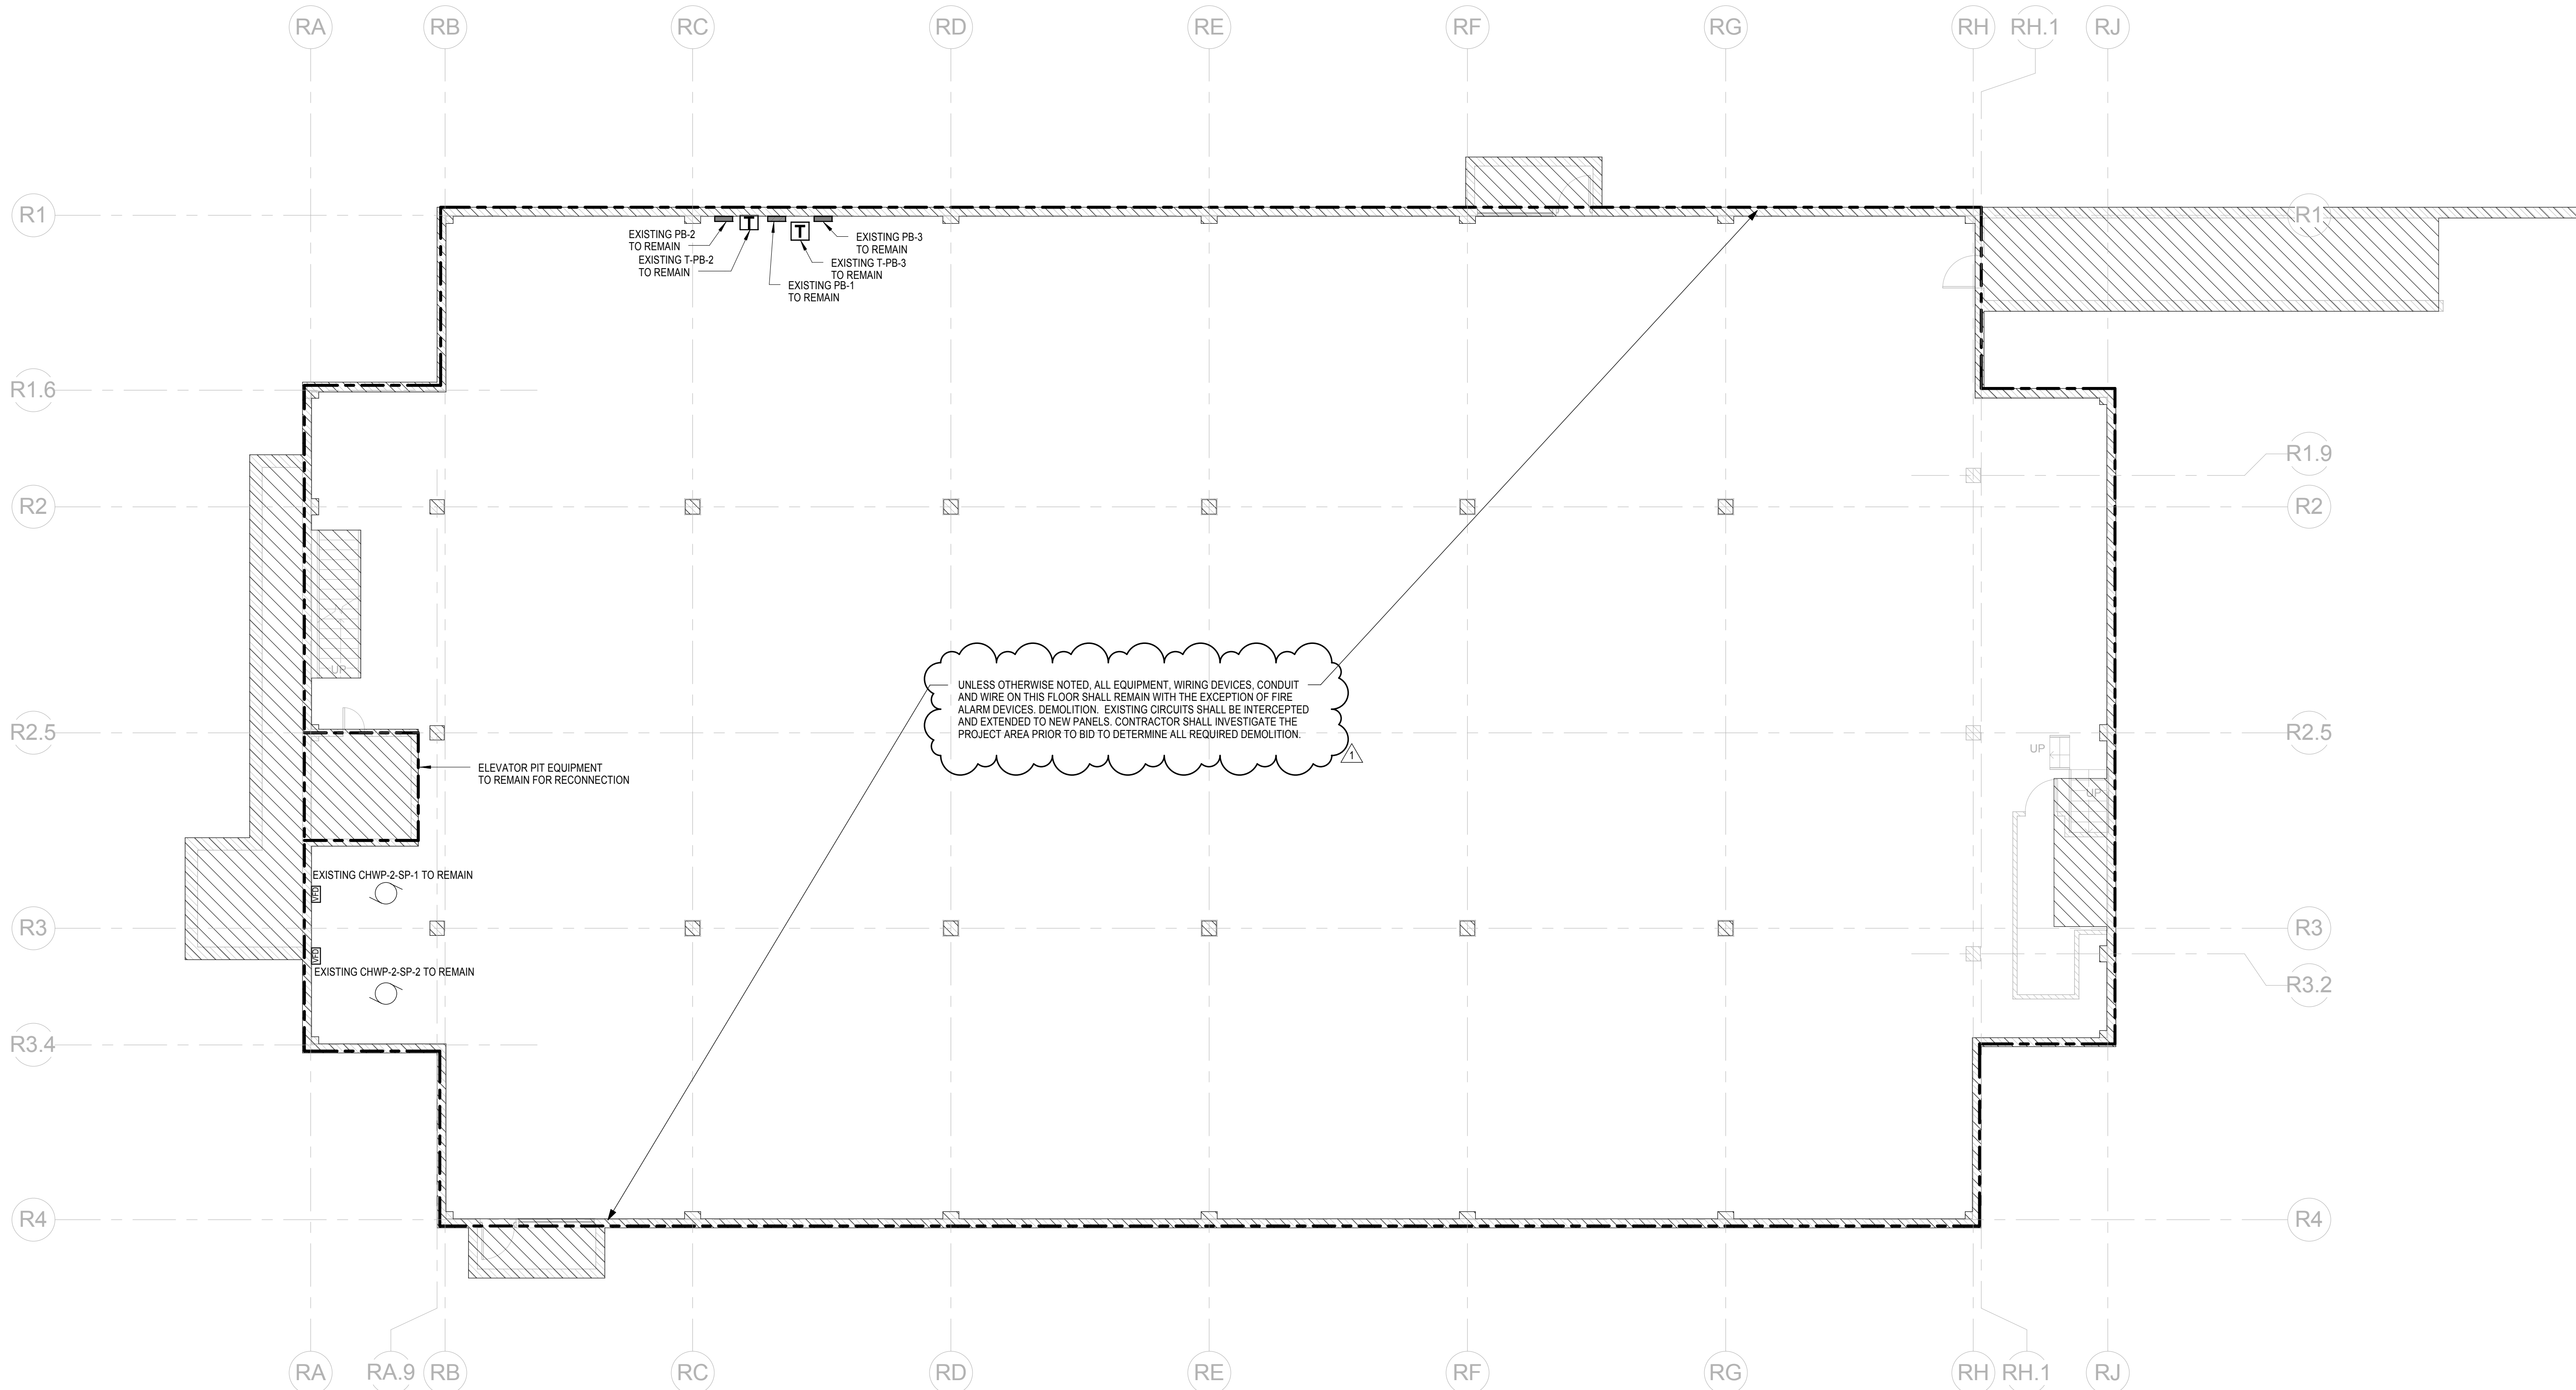

Revisions	Date
1 RESPONSE TO RFI #001	08-29-16

M. Moncef Hadji, P.E.
Florida License #48022

06/20/2016

TLC 874 Dixon Boulevard
Cocoa, FL 32922
Phone: 321-634-0274
Fax: 321-639-8986
www.tlc-engineers.com
© Copyright 2016 TLC Engineering for Architecture, Inc.
COA #15 TLC NO: 515172

mri FL LIC #AA000264
ARCHITECTURAL GROUP, INC.
5032 GODDARD AVENUE
ORLANDO, FLORIDA 32804
(407) 245-3660
ORLANDO@mriarchitects.com
PETER M. IKEGAMI FL LIC #AR13065

Drawing Title
**ELECTRICAL DEMOLITION -
BASEMENT FLOOR PLAN**

Project Title
**RENOVATE BUILDING 2
(Interiors and Systems)
RESEARCH (FCA-D)**

Approved: Project Section Chief
James Dahnke

Approved: Division Chief
James A. Blatchley

Approved: Facility Director
Joe D. Battle

Location **JAMES A. HALEY VETERANS' HOSPITAL
13000 BRUCE B. DOWNS BLVD.
TAMPA, FLORIDA 33612**

Drawn **DRS** Date **JUNE 23, 2016**

Checked **MMH** Project No. **673-11-114**

Bldg # **2** DRAWING NO. **2-ED100**

VA File Number Dwg. Of

