

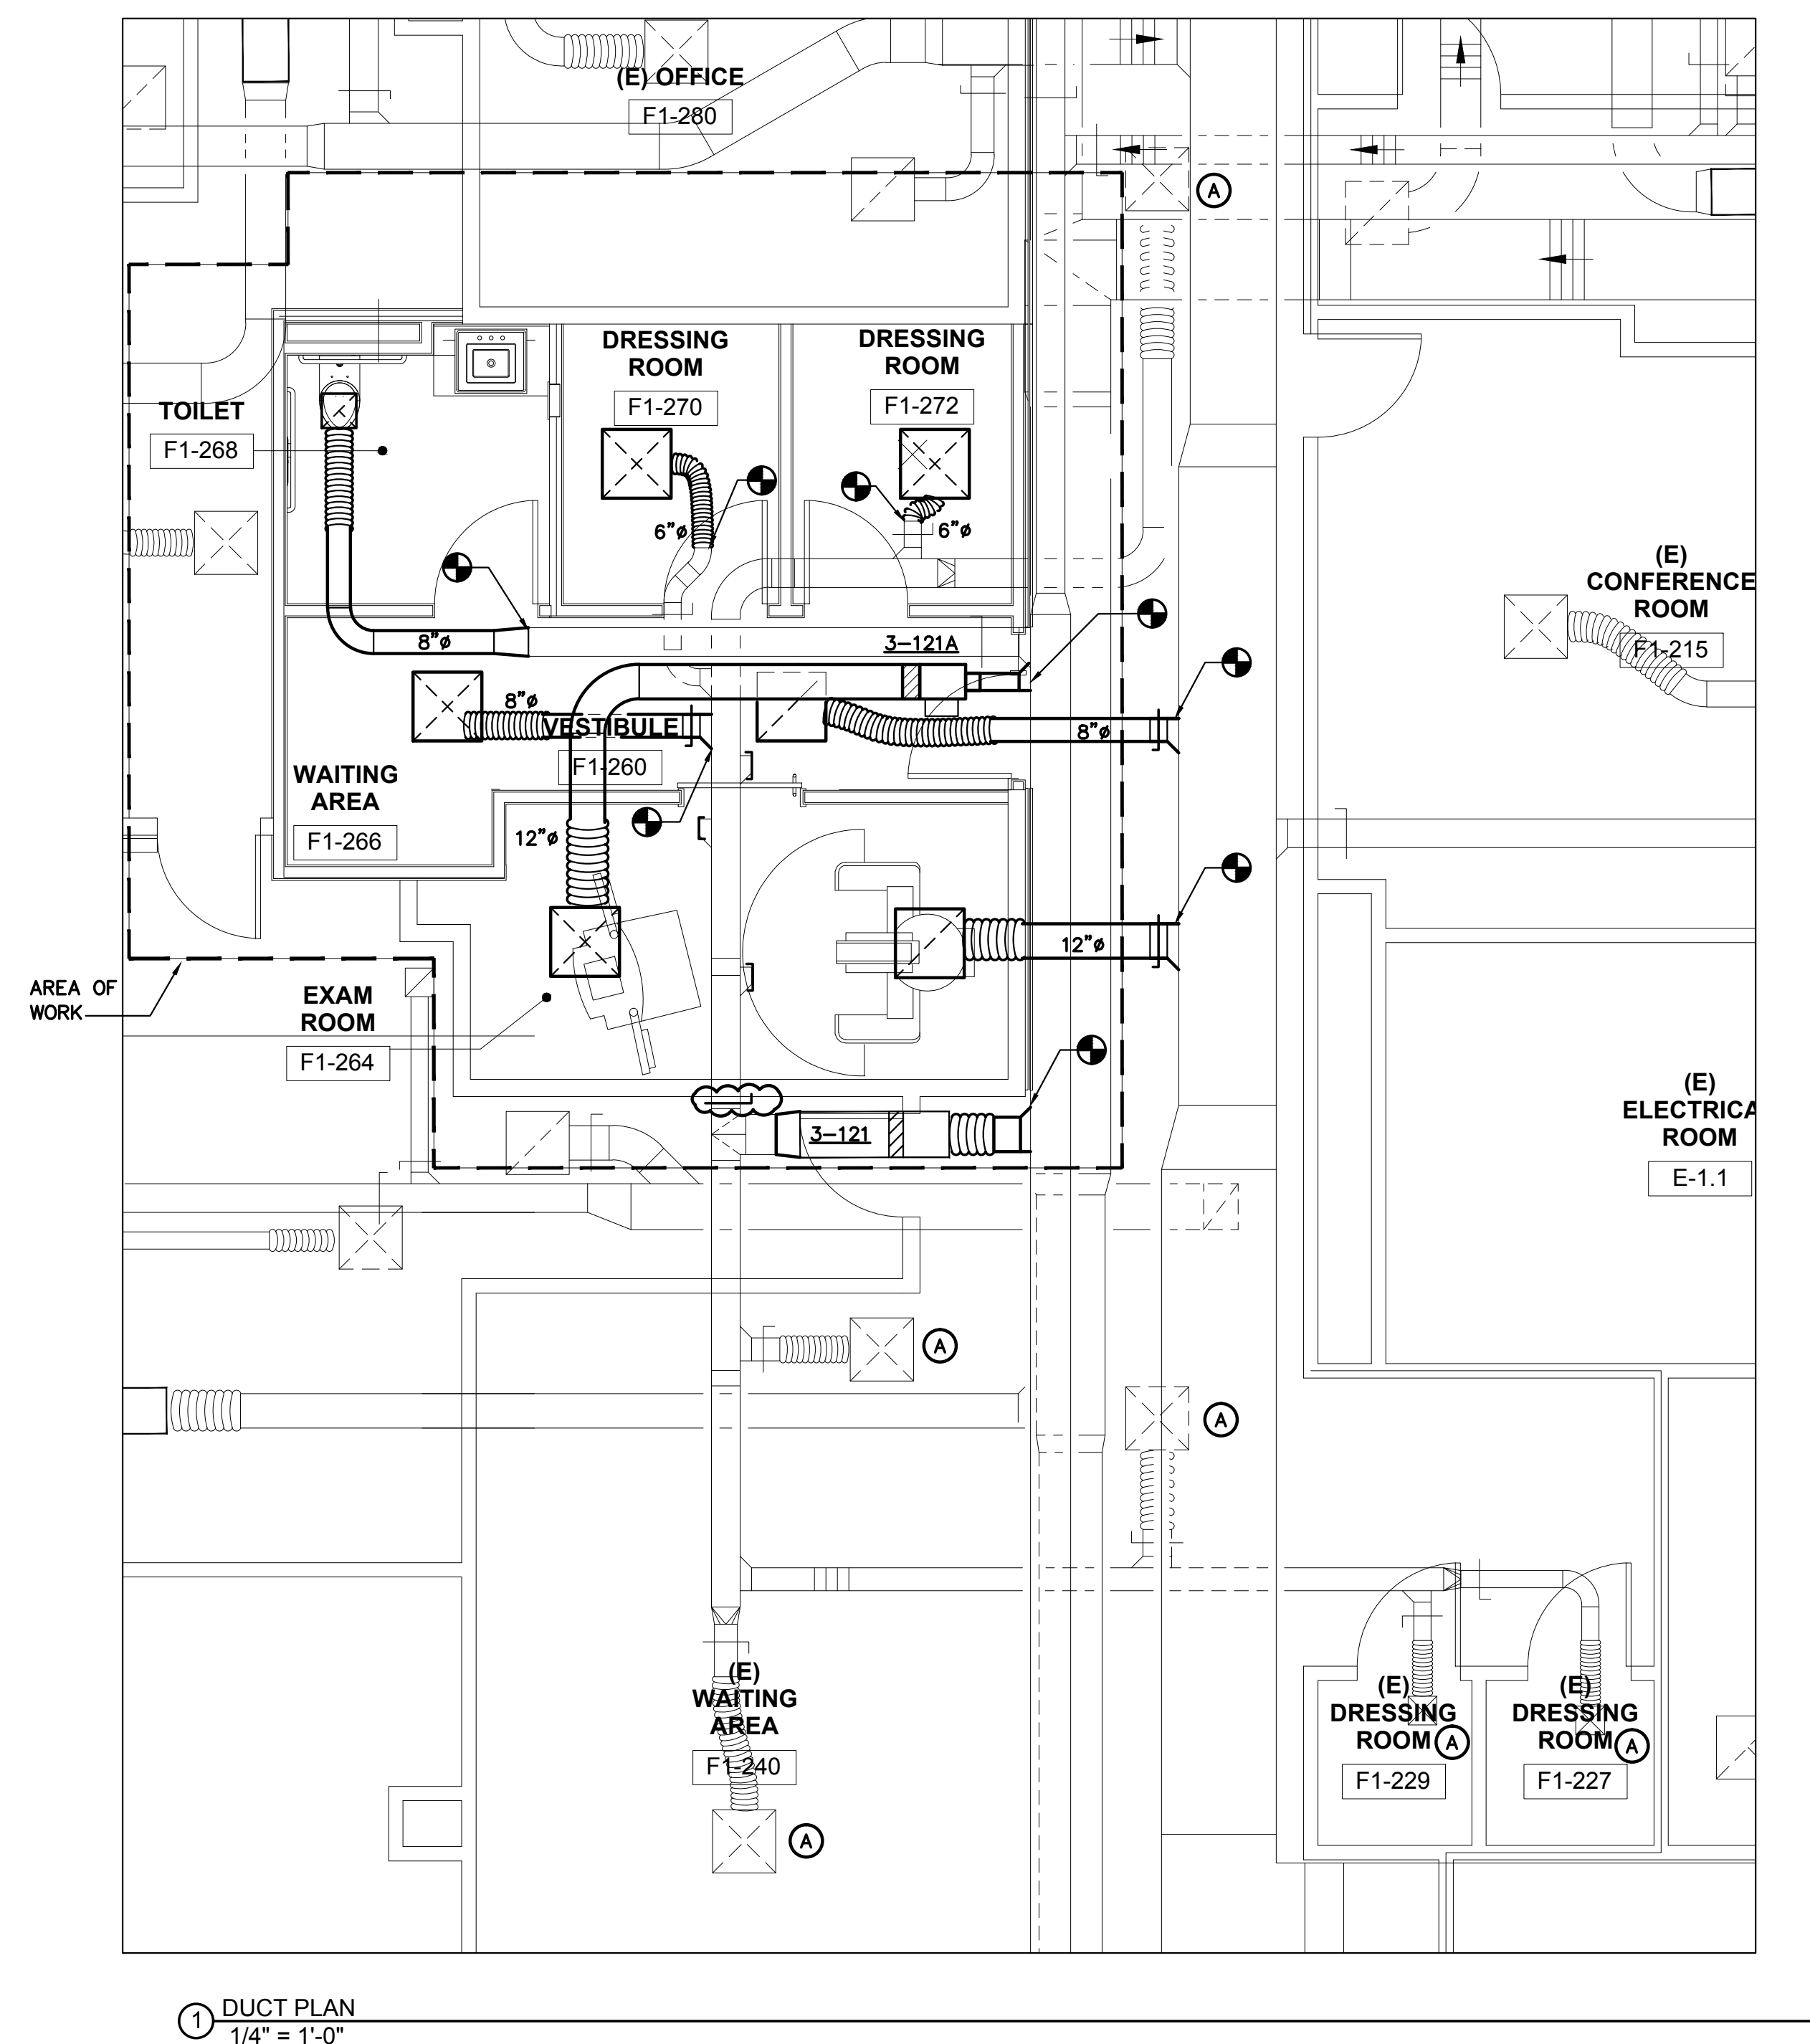


016\190115.04\1200 Drawings\1200 Autodesk Project Files\0031181 - August 50, 2018 - 48 - 9

<h2 style="margin: 0;">FLOOR PLAN KEYNOTES</h2>	
(A)	AT COMPLETION OF CONSTRUCTION TAKE READINGS OF AIRFLOWS AT OUTLETS INDICATED. PROVIDE A COPY OF THE REPORT TO THE ARCHITECT FOR REVIEW.
<h2 style="margin: 0;">FLOOR PLAN SHEET NOTES</h2>	
1.	EXISTING WORK SHOWN LIGHT, NEW WORK SHOWN IN BOLD.
2.	EXISTING TSTAT FOR TERMINAL UNIT 3-121 TO REMAIN.
<h2 style="margin: 0;">FLOOR PLAN LEGEND</h2>	
	POINT OF CONNECTION
ADDENDUM 1 08/29/16	
<div style="display: flex; justify-content: space-between;"><div style="width: 30%;"><div style="border: 1px solid black; padding: 5px; margin-bottom: 5px;">Renovation for mmography</div><div style="border: 1px solid black; padding: 5px; margin-bottom: 5px;">o Alto, CA</div><div style="display: flex; justify-content: space-between;"><div style="border: 1px solid black; padding: 5px; width: 45%;">Checked</div><div style="border: 1px solid black; padding: 5px; width: 45%;">Drawn</div></div></div><div style="width: 30%; border: 1px solid black; padding: 5px;"><div>Project Number</div><div style="text-align: center; font-weight: bold;">640-15-129</div><div>Building Number</div><div style="text-align: center; font-weight: bold;">100</div><div>Drawing Number</div><div style="text-align: center; font-weight: bold; font-size: 1.2em;">MH201</div><div style="display: flex; justify-content: space-between;"><div>Dwg.</div><div>of</div></div></div><div style="width: 30%; text-align: center; padding: 10px;"><div style="margin-bottom: 10px;">Office of Construction and Facilities Management</div><div style="display: flex; align-items: center; justify-content: center;"><div style="text-align: left; margin-right: 10px;">VA <small>Veterans Affairs</small></div><div style="text-align: center;"></div><div style="text-align: right; margin-left: 10px;">PAHCS <small>Palo Alto Health Care System</small></div></div></div></div>	

[illegible]