

REVISED GAS PLUMBING RISER DIAGRAM
BASEMENT FLOOR - BUILDING 90

N.T.S.

REVISED WATER AND GAS PLUMBING PLAN
BASEMENT FLOOR -
BUILDING 90

SCALE: 3/32"=1'-0"

REVISED PLUMBING PLAN - BUILDING 90

SCALE: 3/32"=1'-0"


WHORTON ENGINEERING, INC.

HVAC - PLUMBING - PROCESS CONTROL

RANDALL WHORTON, P.E.
PH 256/820-9897 FAX 256/820-9886

25 SUMMERALL GATE ROAD
ANNISTON, ALABAMA 36205

WHORTON ENGINEERING PROJECT NO. 10159

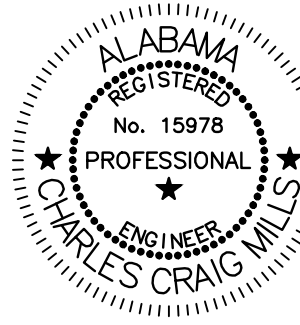

MCE MILLS-CONOLY
ENGINEERING, P.C.

8218 Old Federal Road
TELEPHONE: (334) 270-0010

Montgomery, AL 36117
FAX: (334) 270-0040



Central Alabama Veterans Health Care System

Approved:

Approved:

Approved:

Approved:

Approved:

Approved:

Approved:

Approved:

Drawing Title

REVISED PLUMBING PLAN - BUILDING 90

Safety Officer

Clinical Representative

Project Title

HVAC MODIFICATIONS TO
BUILDINGS 83, 90, & 93
TUSKEGEE, ALABAMA

Building Number

90

Checked

RDW

Drawn

JAD

Location

East Campus, Tuskegee, AL

Date

12/21/10

Project No.

619-10-445

Drawing No.

90P2.2

Page 42 of 59

Veterans
Administration