



STORM WATER GRADING
PROJ. # 542.15.115

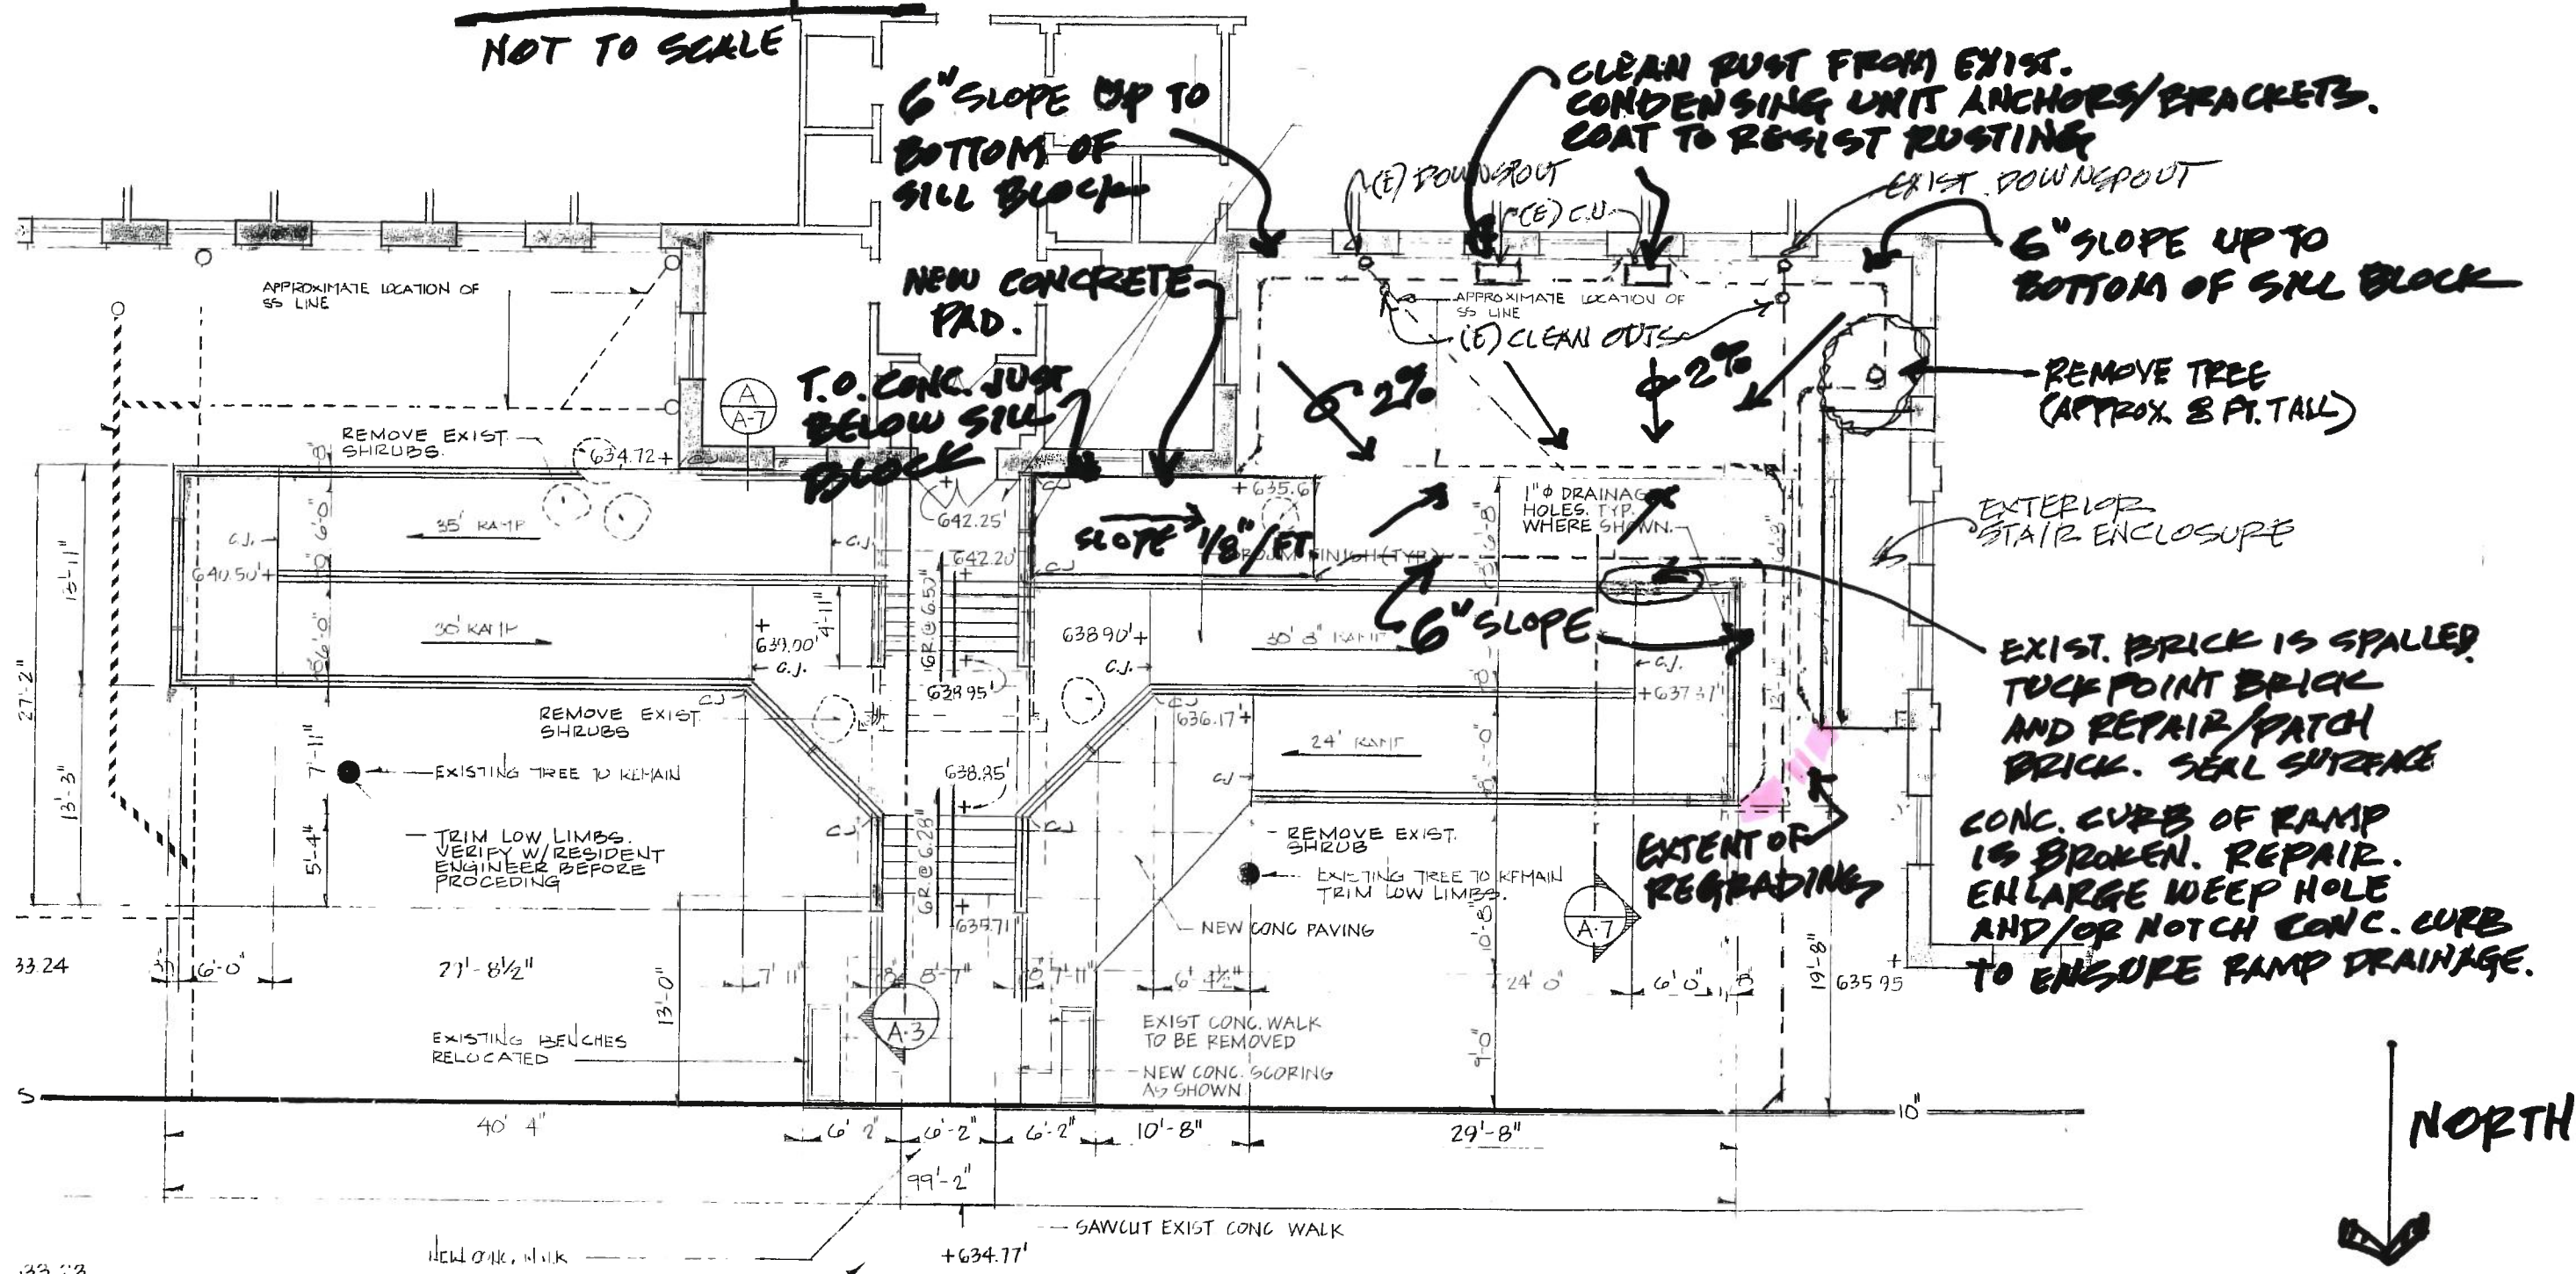

BUILDING 38
(NOT TO SCALE)

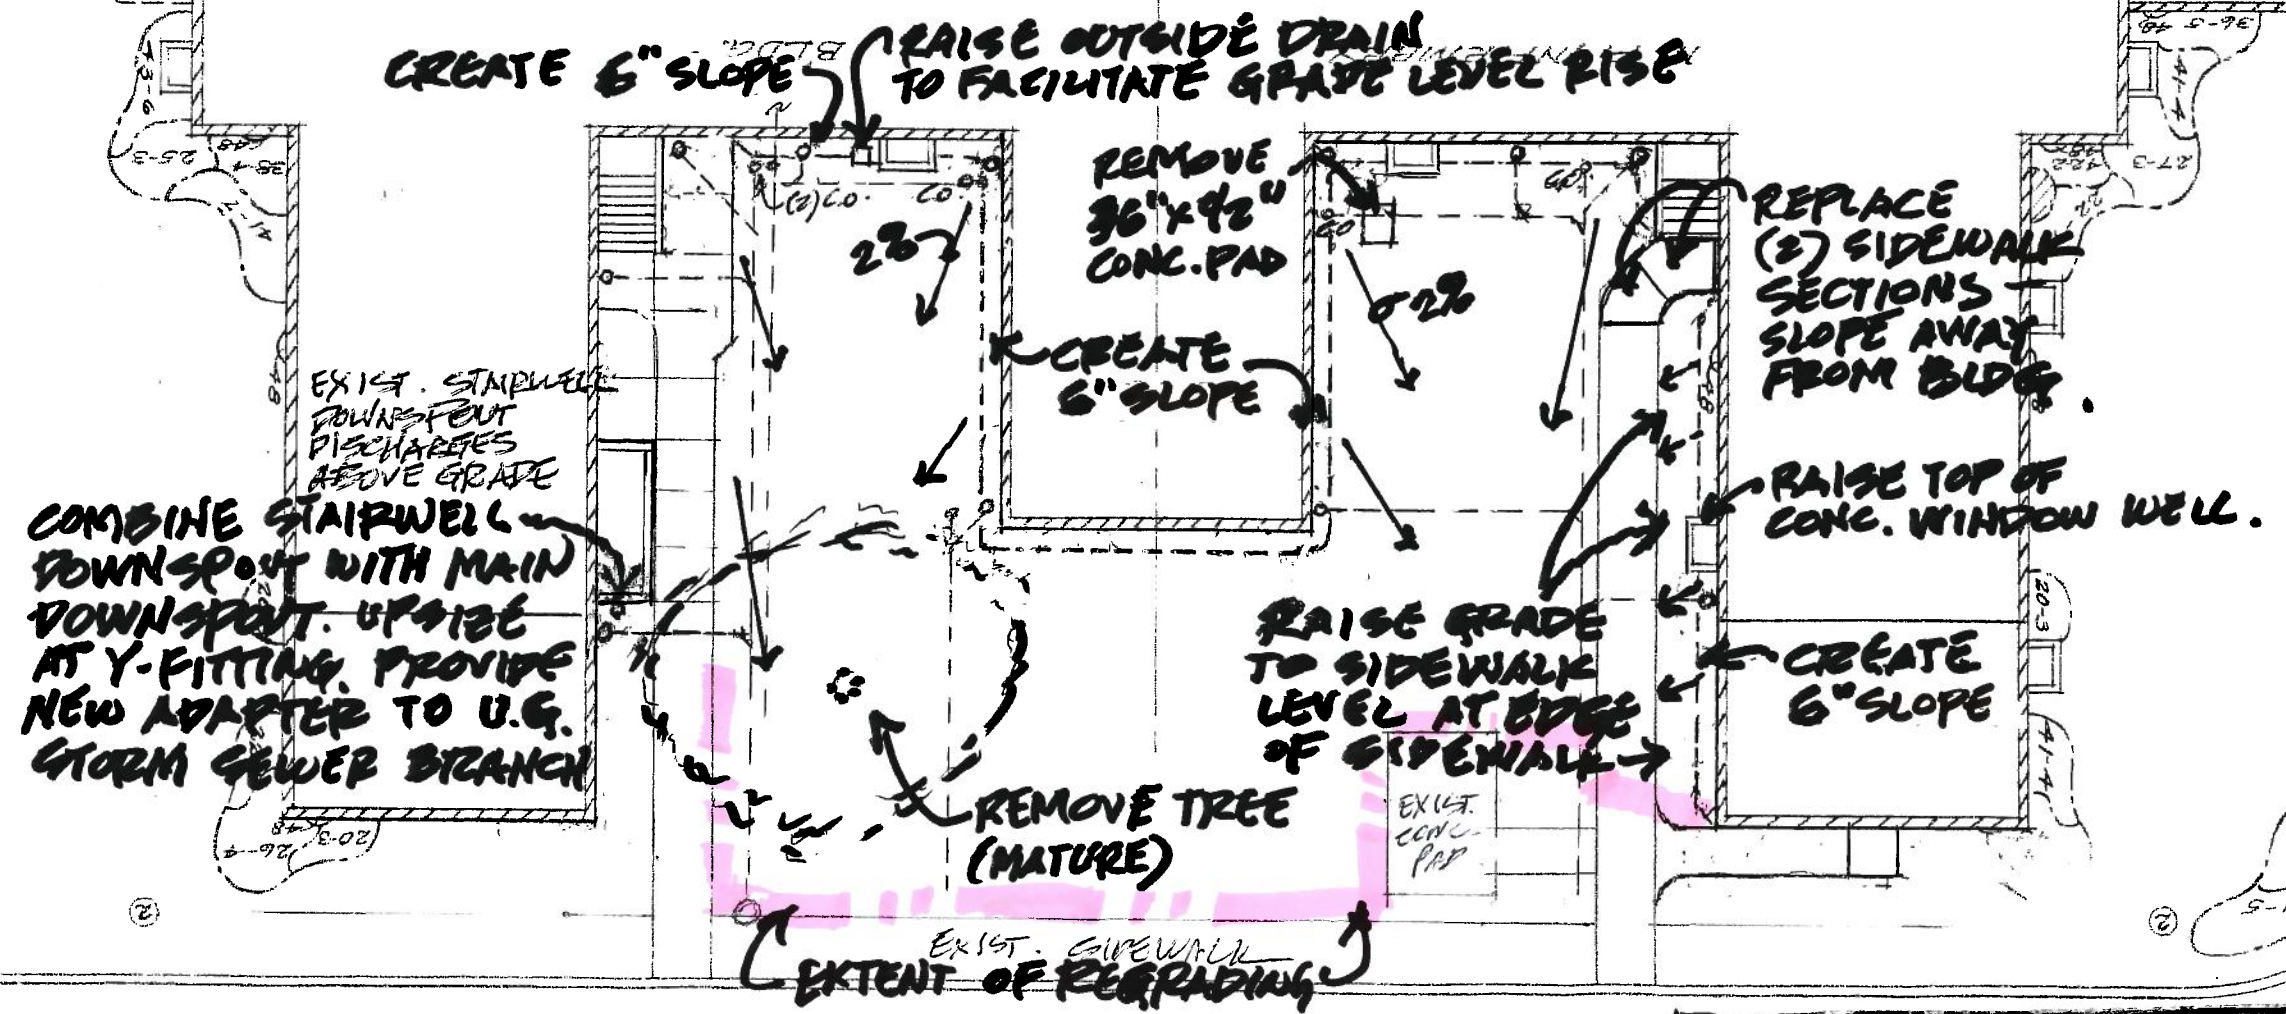

STORM WATER GRADING
PROJ # 542-15.115