




DATE	CHANGE	DESCRIPTION
2.12.12	△	ADDED NOTE
2.12.12	△	ADDED NOTE
2.12.12	△	ADDED NOTE
2.12.12	△	ADDED NOTE
2.12.12	△	DELETE NOTE
2.12.12	△	DELETE NOTE
2.12.12	△	NOTE CHANGE
2.12.12	△	NOTE CHANGE
2.12.12	△	DELETE NOTES
2.12.12	△	REMOVED FLOOR PATTERN

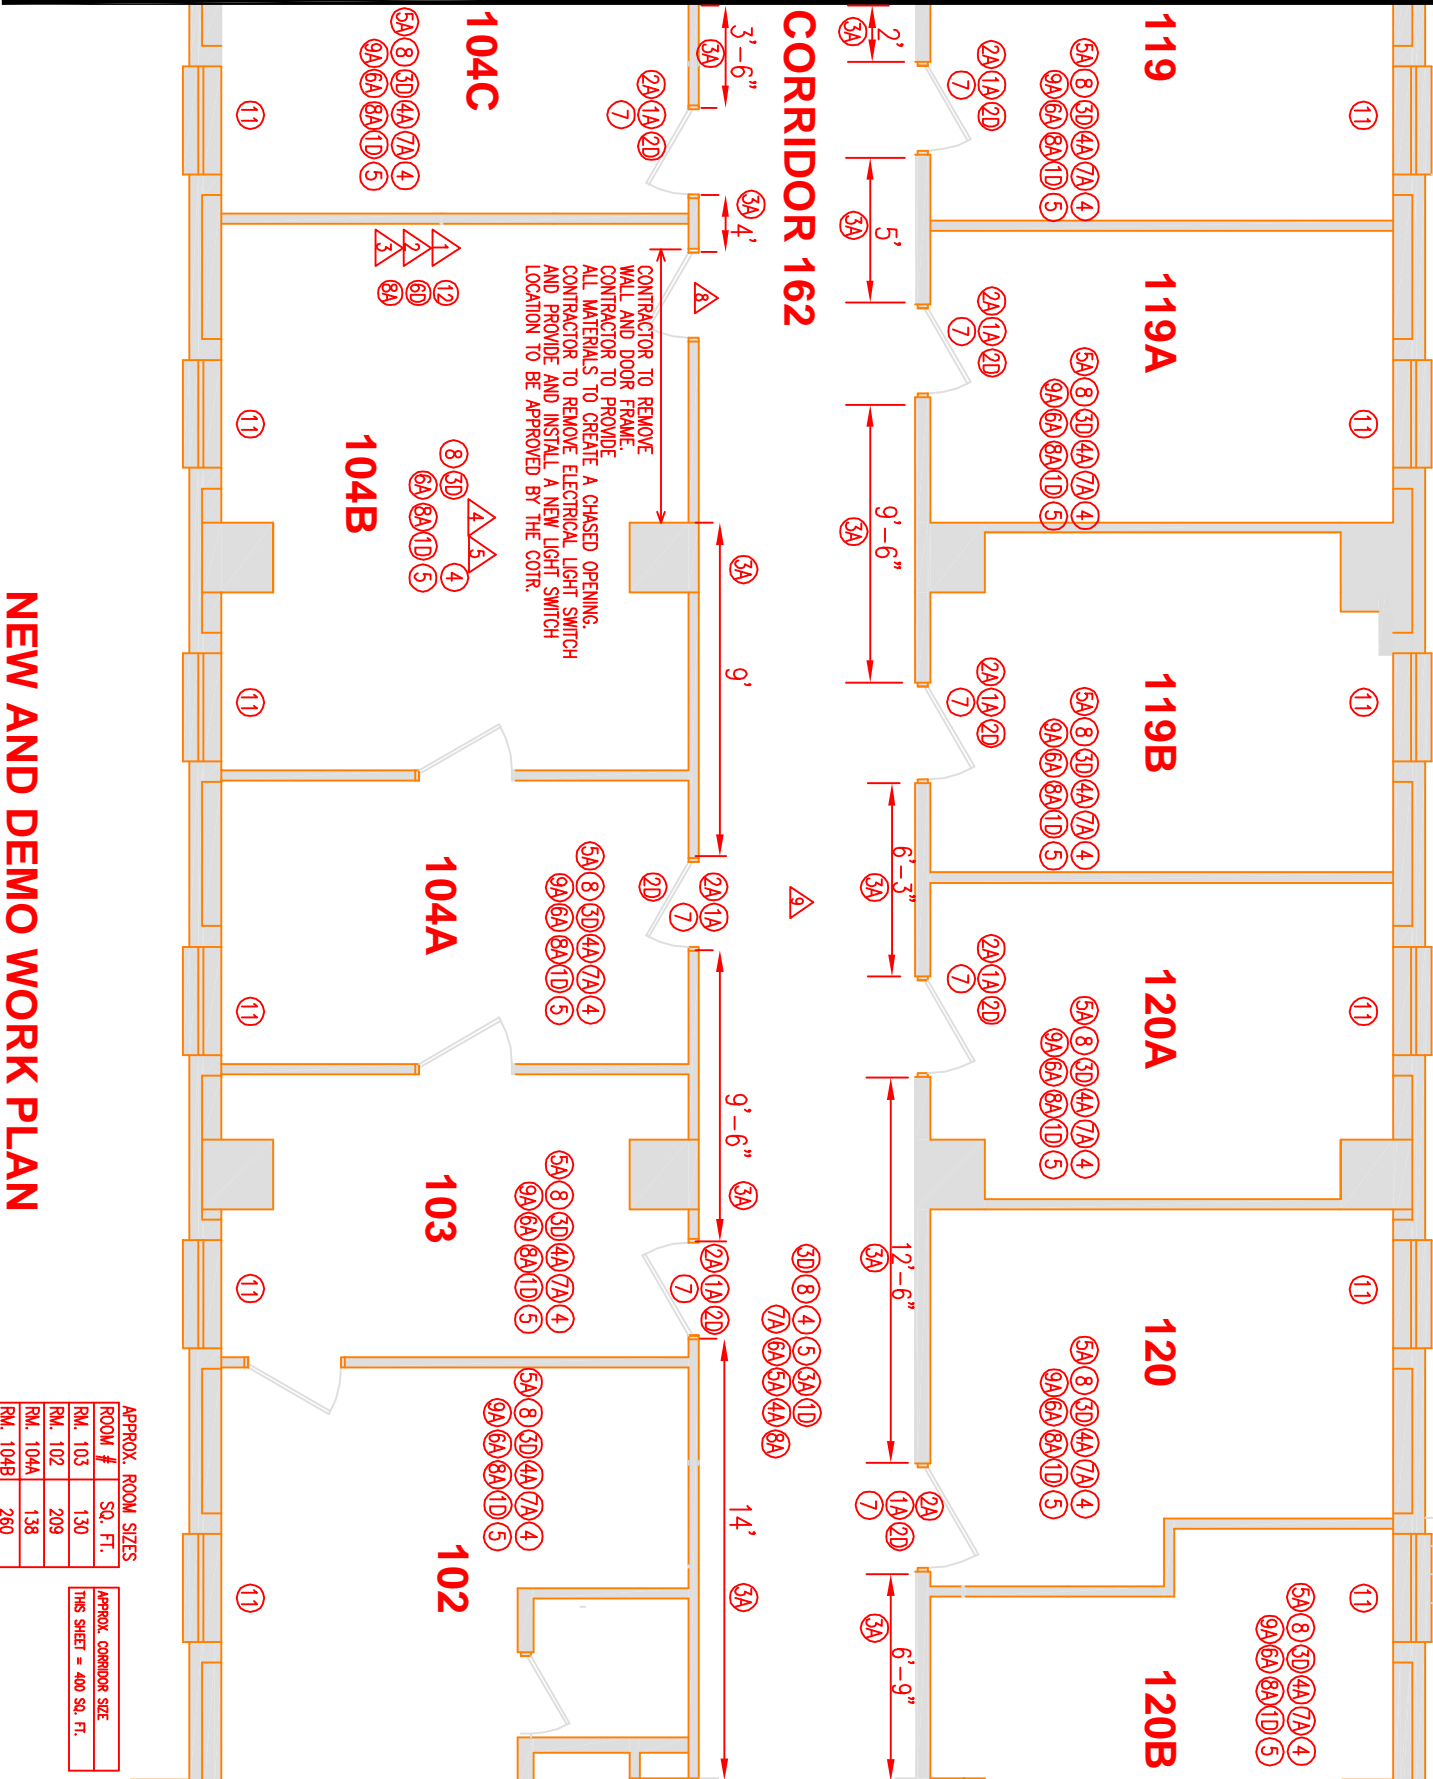

NEW AND DEMO WORK PLAN

PRIMARY CARE

ROOM #	SQ. FT.
RM. 103	130
RM. 102	209
RM. 104A	138
RM. 104B	260
RM. 104C	120
RM. 120B	130
RM. 120A	166
RM. 120	143
RM. 119B	155
RM. 119A	141
RM. 119	137

APPROX. CORRIDOR SIZE
THIS SHEET = 400 SQ. FT.

NEW WORK NOTES

- PROVIDE AND INSTALL INRPO DOOR FRAME GUARDS, TYPE: CUSTOM FORMED WITH MOP STOP
- PROVIDE AND INSTALL INRPO DOOR PROTECTION KICKPLATES, TYPE: MODEL 10, K41
- NOT USED
- SAND, PREP AND PAINT WALLS AND DOOR JAMBS 1-COAT PRIMER, 2-COATS SEMI-GLOSS SHERWIN WILLIAMS HARMONY PAINT, COLOR TO BE DETERMINED BY THE CORR.
- CONTRACTOR TO TEXTURE WALLS WITH KNOCK DOWN FINISH.
- PROVIDE AND INSTALL NEW WALL AS SHOWN ON PLANS, CEILING LEVELING OR ALUSE AS NEEDED.
- PROVIDE AND INSTALL NEW WOOD DOORS, "BEST" HARDWARE, QUALITY & FINISH TO MATCH EXISTING DOORS IN CORRIDOR 163, RM 109 OR RM 107
- PROVIDE AND INSTALL NEW CEILING TILES AND GRID THROUGHOUT, BRAND: BAROCUE, ITEM # BET-157, 24"x24"x5/8", TRIM EDGE, CUT-IN HOLES FOR FIRE SPRINKLERS, SPEAKERS, ETC.
- PROVIDE AND INSTALL NEW 4" CONE BASE, 1/8" THICK, 4" STRAIT PIECES
- PROVIDE AND INSTALL LAMINATE COUNTERTOPS, TYPE: WILSONART 182X-35 SEDONA SPIRIT
- PROVIDE AND INSTALL INRPO CORNER GUARD FROM FLOOR TO CEILING, TYPE: 1506N
- SAND, PREP & PAINT WINDOW SEAL 2-COATS SHERWIN WILLIAMS HARMONY SEMI-GLOSS PAINT
- PROVIDE AND INSTALL AMTICO AMERICAN CHERRY FLOORING THROUGHOUT

DEMO WORK NOTES

- REMOVE ALL VINYL WALL COVERING.
- REMOVE EXISTING DOORS AND HARDWARE.
- REMOVE EXISTING CEILING TILES THROUGHOUT.
- DEMO EXISTING WALL AS SHOWN ON PLANS.
- REMOVE ALL CERAMIC TILE FROM WALLS.
- REMOVE ASBESTOS CONTAINING FLOOR TILE LAYERS, MASTIC AND REMOVE ALL RESIDUE. PREP OR LEVEL FLOOR AS NEEDED FOR NEW FLOORING.
- DEMO EXISTING CABINET, PATCH OR REPAIR WALLS.
- REMOVE TERRAZO AT ALL WALLS TO A 90 DEGREE ANGLE TO ACCEPT THE NEW CONE BASE

ADD ALTERNATE #1

- REMOVE ASBESTOS CONTAINING FLOOR TILE LAYERS, MASTIC AND REMOVE ALL RESIDUE. PREP OR LEVEL FLOOR AS NEEDED FOR NEW FLOORING
- PROVIDE AND INSTALL AMTICO AMERICAN CHERRY FLOORING THROUGHOUT
- REMOVE TERRAZO AT ALL WALLS TO A 90 DEGREE ANGLE TO ACCEPT THE NEW CONE BASE
- PROVIDE AND INSTALL NEW 4" CONE BASE, 1/8" THICK, 4" STRAIT PIECES
- SAND, PREP & PAINT WINDOW SEAL 2-COATS SHERWIN WILLIAMS HARMONY SEMI-GLOSS PAINT
- REMOVE EXIST. CONE BASE.

ADD ALTERNATE #2

- PROVIDE AND INSTALL INRPO 3500 SERIES HANDRAIL, TYPE AND QUALITY TO MATCH EXISTING HANDRAIL ON CORRIDOR 163.

LEGEND

- NEW FULL HEIGHT WALL
- EXISTING TO REMAIN NOT IN CONTRACT
- EXISTING WALL TO BE REMOVED