


MATCHLINE F-F

DATE	CHANGE	DESCRIPTION
2.10.12	Δ	NOTE CHANGE
2.10.12	Δ	NOTE CHANGE
2.10.12	Δ	NOTE CHANGE
2.10.12	Δ	ADDED NOTE
2.10.12	Δ	REMOVED FLOOR PATTERN
2.10.12	Δ	ADDED NOTE

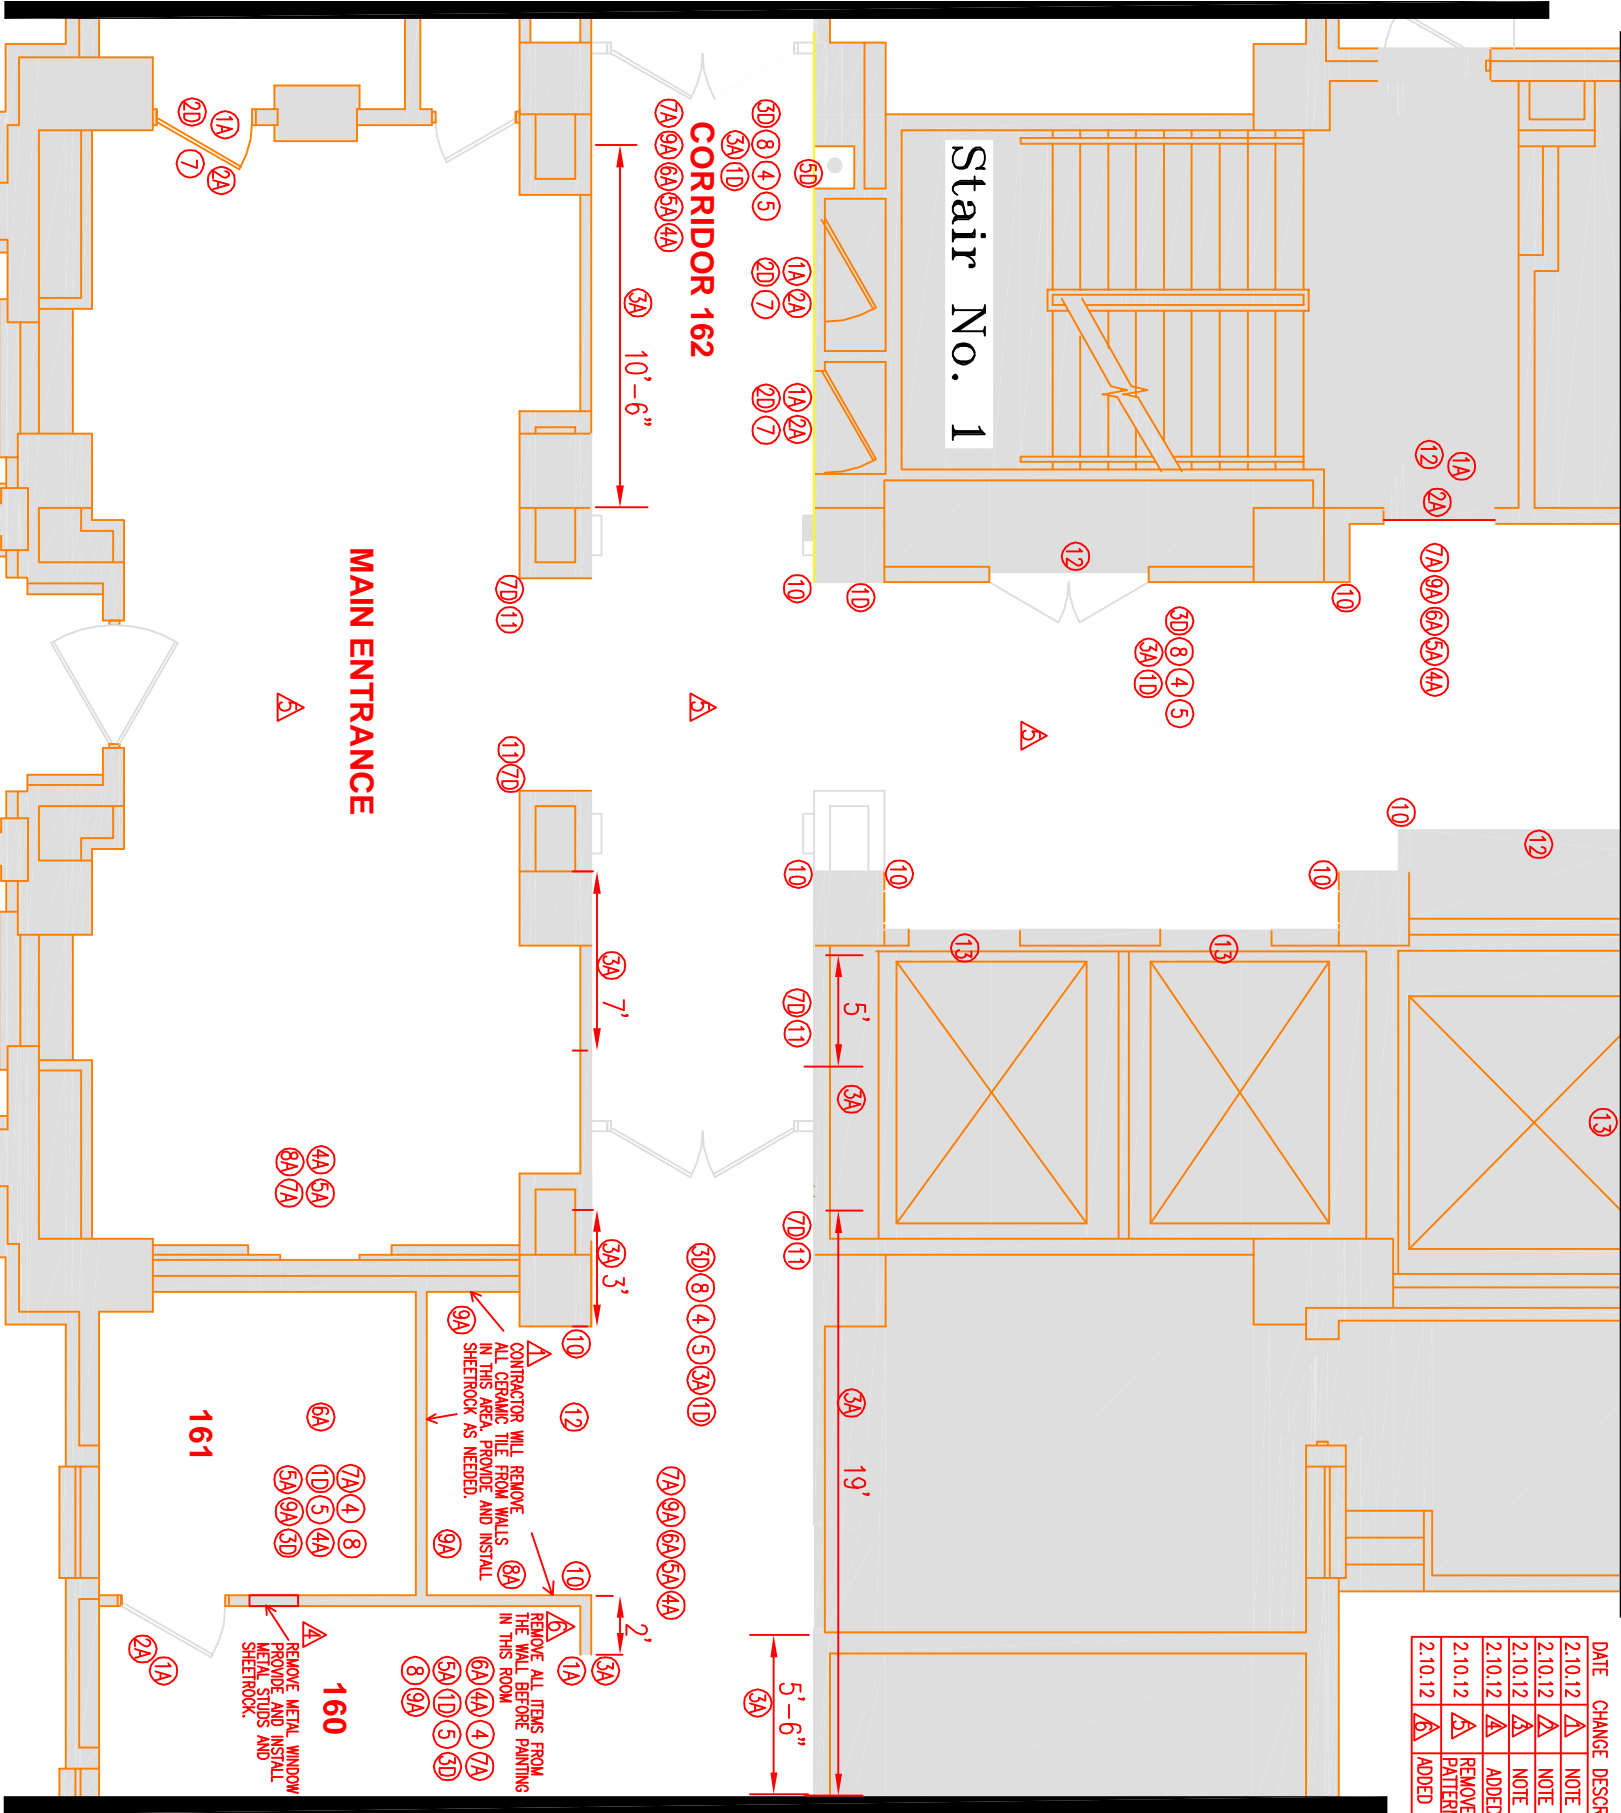

MATCHLINE D-D

MATCHLINE E-E

NEW WORK NOTES

1A	PROVIDE AND INSTALL INPRO DOOR FRAME GUARDS, TYPE: CUSTOM FORGED WITH MOP STOP
2A	PROVIDE AND INSTALL INPRO DOOR PROTECTION KICKPLATES, TYPE: MODEL 10, K41
3	NOT USED
4	SAND, PREP AND PAINT WALLS AND DOOR JAMBS 1-COAT PRIMER, 2-COATS SEMI-GLOSS
5	SHERWIN WILLIAMS HARMONY PAINT, COLOR TO BE DETERMINED BY THE COOR.
6	CONTRACTOR TO TEXTURE WALLS WITH KNOCK DOWN FINISH.
7	PROVIDE AND INSTALL NEW WALL AS SHOWN ON PLANS, CEILING LEVELING OR ALIGN AS NEEDED.
8	PROVIDE AND INSTALL NEW WOOD DOORS, "BEST" HARDWARE, QUALITY & FINISH TO MATCH
9	EXISTING DOORS IN CORRIDOR 163, RM 109 OR RM 107
10	BET-157, 24"x24"x5/8", TRIM EDGE, OUT-IN HOLES FOR FIRE SPRINKLERS, SPEAKERS, ETC.
11	PROVIDE AND INSTALL LAMINATE COUNTERTOPS, TYPE: WILSONART 182K-35 SEDONA SPRT
12	PROVIDE AND INSTALL INPRO CORNER GUARD FROM FLOOR TO CEILING, TYPE: 150BN
13	REPAIR WALL WITH METAL STUDS, 5/8" SHEETROCK, TEXTURE TO MATCH ADJACENT WALLS, PREP AND PAINT
14	SAND, PREP, PAINT DOOR AND/OR FRAME 2-COATS SHERWIN WILLIAMS HARMONY SEMI-GLOSS PAINT OR EQUIV.
15	SAND, PREP, PAINT ELEVATOR DOORS AND FRAME 2-COATS SHERWIN WILLIAMS LATEX EPOXY PAINT OR EQUIV.

DEMO WORK NOTES

1D	REMOVE ALL VINYL WALL COVERING.
2D	REMOVE EXISTING DOORS AND HARDWARE.
3D	REMOVE EXISTING CEILING TILES THROUGHOUT.
4D	DEMO EXISTING WALL AS SHOWN ON PLANS.
5D	REMOVE ALL CERAMIC TILE FROM WALLS.
6D	REMOVE ASBESTOS CONTAINING FLOOR TILE LAYERS, MASTIC AND REMOVE ALL RESIDUE, PREP OR LEVEL FLOOR AS NEEDED FOR NEW FLOORING.
7D	DEMO EXISTING CABINET, PATCH OR REPAIR WALLS.
8D	REMOVE TERRAZO AT ALL WALLS TO A 90 DEGREE ANGLE TO ACCEPT THE NEW COVE BASE
9D	REMOVE EXISTING CARPET, GLUE, AND PREP FLOOR FOR NEW VCT.

ADD ALTERNATE #1

4A	REMOVE ASBESTOS CONTAINING FLOOR TILE LAYERS, MASTIC AND REMOVE ALL RESIDUE, PREP OR LEVEL FLOOR AS NEEDED FOR NEW FLOORING
5A	PROVIDE AND INSTALL AUNTICO AMERICAN CHERRY FLOORING THROUGHOUT
6A	REMOVE TERRAZO AT ALL WALLS TO A 90 DEGREE ANGLE TO ACCEPT THE NEW COVE BASE
7A	PROVIDE AND INSTALL NEW 4" COVE BASE, 1/8" THICK, 4" STRAIT PIECES (6" in main entrance)
8A	REMOVE EXISTING CARPET, GLUE, AND PREP FLOOR FOR NEW VCT.
9A	REMOVE BILLINESE CERAMIC TILE FROM BASE OF WALLS OR COVE BASE.

ADD ALTERNATE # 2

2A	PROVIDE AND INSTALL INPRO 3500 SERIES HANDRAIL, TYPE AND QUALITY TO MATCH EXISTING HANDRAIL ON CORRIDOR 163. (SEE DIMENSIONS PROVIDED ON PLANS AS LOCATION OF HANDRAIL)
----	---

LEGEND

	NEW FULL HEIGHT WALL
	EXISTING TO REMAIN NOT IN CONTRACT
	EXISTING WALL TO BE REMOVED

APPROX. ROOM SIZES

ROOM #	SQ. FT.
RM. 161	115
RM. 160	167
MAIN ENTRANCE	600
CORRIDOR 162 & ELEVATOR LOBBY	850
THIS SHEET	

NEW AND DEMO WORK PLAN

MAIN ENTRANCE AND LOBBY

NOTE: MAIN ENTRANCE CONTRACTOR WILL SAND, PREP AND PAINT AND PAINT WALLS, WOOD TRIMMINGS AND CEILING 2-COATS SHERWIN WILLIAMS HARMONY SEMI-GLOSS PAINT.