
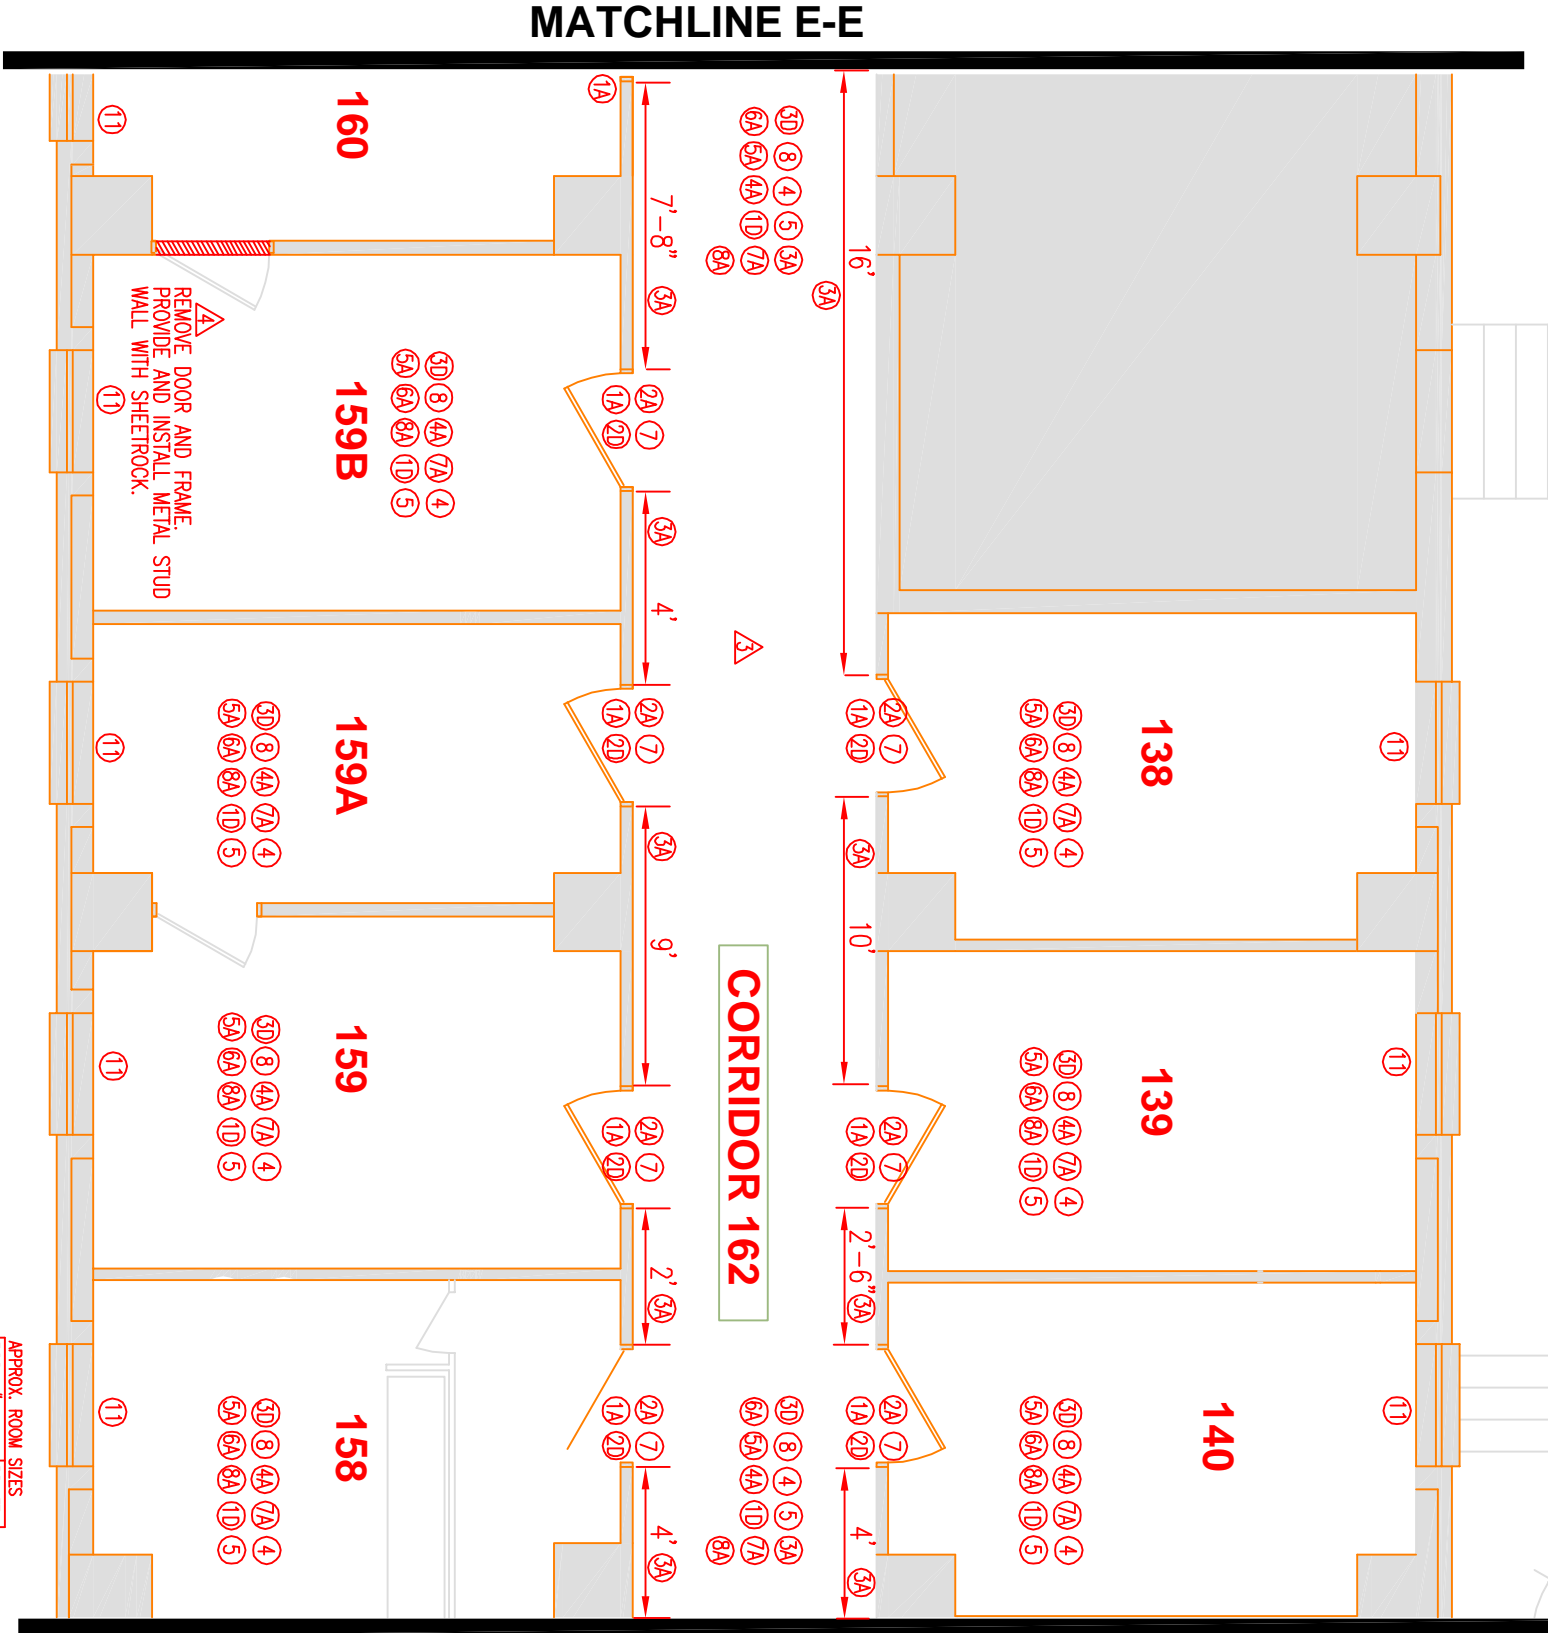


| DATE    | CHANGE | DESCRIPTION           |
|---------|--------|-----------------------|
| 2.13.12 | △      | NOTE CHANGE           |
| 2.13.12 | △      | NOTE CHANGE           |
| 2.13.12 | △      | REMOVED FLOOR PATTERN |
| 2.13.12 | △      | ADDED NOTE            |

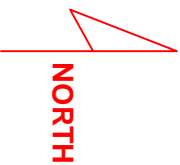

NEW AND DEMO WORK PLAN

PRIMARY CARE

| APPROX. ROOM SIZES |         |
|--------------------|---------|
| ROOM #             | SQ. FT. |
| RM. 159B           | 133     |
| RM. 159A           | 102     |
| RM. 159            | 130     |
| RM. 158            | 116     |
| RM. 138            | 116     |
| RM. 139            | 120     |
| RM. 140            | 120     |
| CORRIDOR 162       | 275     |

NEW WORK NOTES

- PROVIDE AND INSTALL INFRARED DOOR FRAME GUARDS, TYPE CUSTOM FORMED WITH MOP STOP
- PROVIDE AND INSTALL INFRARED DOOR PROTECTION KICKPLATES, TYPE: MODEL 10, K41
- NOT USED
- SAND, PREP AND PAINT WALLS AND DOOR JAMBS 1-COAT PRIMER, 2-COATS SEMI-GLOSS SHERWIN WILLIAMS HARMONY PAINT. COLOR TO BE DETERMINED BY THE CONTR.
- CONTRACTOR TO TEXTURE WALLS WITH KNOCK DOWN FINISH.
- PROVIDE AND INSTALL NEW WALL AS SHOWN ON PLANS, CEILING LEVELING OR ALIGN AS NEED.
- PROVIDE AND INSTALL NEW WOOD DOORS, "BEST" HARDWARE, QUALITY & FINISH TO MATCH EXISTING DOORS IN CORRIDOR 163, RM 109 OR RM 107
- PROVIDE AND INSTALL NEW CEILING TILES AND GRID THROUGHOUT. BRAND: BAROQUE, ITEM # BT-157, 24"x24"x5/8", TRIM EDGE. CUT-IN HOLES FOR FIRE SPRINKLERS, SPEAKERS, ETC.
- 
- PROVIDE AND INSTALL LAMINATE COUNTERTOPS, TYPE: WILSONART 182X-35 SEDONA SPIRIT
- PROVIDE AND INSTALL INFRARED CORNER GUARD FROM FLOOR TO CEILING, TYPE: 150BN
- SAND, PREP AND PAINT WINDOW SEAL, 2-COATS SHERWIN WILLIAMS HARMONY, SEMI-GLOSS PAINT

DEMO WORK NOTES

- REMOVE ALL VINYL WALL COVERING.
- REMOVE EXISTING DOORS AND HARDWARE.
- REMOVE EXISTING CEILING TILES THROUGHOUT.
- DEMO EXISTING WALL AS SHOWN ON PLANS.
- REMOVE ALL CERAMIC TILE FROM WALLS.
- REMOVE ASBESTOS CONTAINING FLOOR TILE LAYERS, MASTIC AND REMOVE ALL RESIDUE. PREP OR LEVEL FLOOR AS NEEDED FOR NEW FLOORING.
- DEMO EXISTING CABINET, PATCH OR REPAIR WALLS.
- REMOVE TERRAZO AT ALL WALLS TO A 90 DEGREE ANGLE TO ACCEPT THE NEW COVE BASE
- 
- 

ADD ALTERNATE # 1

- REMOVE ASBESTOS CONTAINING FLOOR TILE LAYERS, MASTIC AND REMOVE ALL RESIDUE. PREP OR LEVEL FLOOR AS NEEDED FOR NEW FLOORING
- PROVIDE AND INSTALL MANTO AMERICAN CHERRY FLOORING THROUGHOUT
- REMOVE TERRAZO AT ALL WALLS TO A 90 DEGREE ANGLE TO ACCEPT THE NEW COVE BASE
- PROVIDE AND INSTALL NEW 4" COVE BASE, 1/8" THICK, 4" STRAIT PIECES
- REMOVE BULLNOSE CERAMIC TILE FROM BASE OF WALLS OR COVE BASE.

ADD ALTERNATE # 2

- PROVIDE AND INSTALL INFRARED 3500 SERIES HANDRAIL, TYPE AND QUALITY TO MATCH EXISTING HANDRAIL ON CORRIDOR 163. (SEE DIMENSIONS PROVIDED ON PLANS AS LOCATION OF HANDRAIL)

LEGEND

- NEW FULL HEIGHT WALL
- EXISTING TO REMAIN NOT IN CONTRACT
- EXISTING WALL TO BE REMOVED