





DATE	CHANGE	DESCRIPTION
2.10.2012	1	ADD DETAIL
2.10.2012	2	DETAIL REMOVED

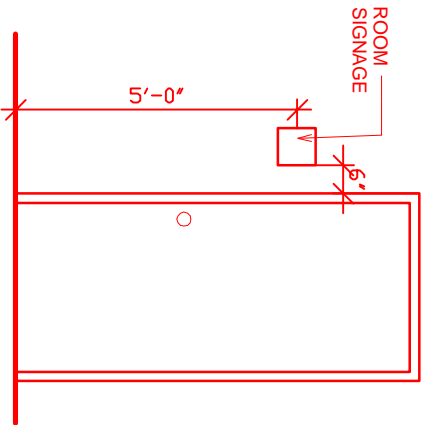

1 TYP. ROOM SIGNAGE AND MOUNTING HEIGHT

CONTRACTOR TO REMOVE EXISTING ROOM SIGNS  
CONTRACTOR TO PROVIDE AND INSTALL NEW ROOM SIGNS  
INCLUDE IN THE BASE BID

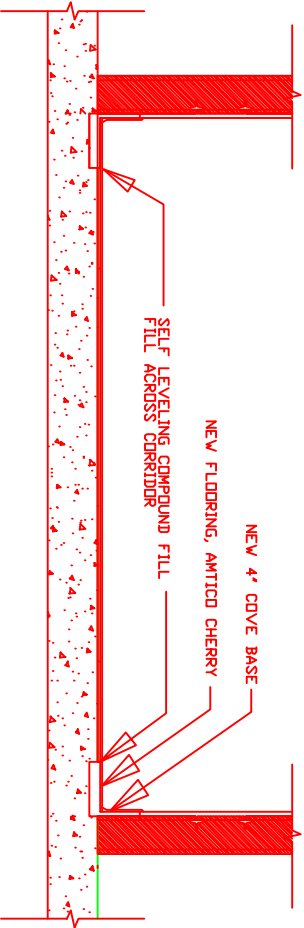

1 CORRIDOR WALL SECTION

DETAILS