




three inches = one foot  
 one and one half inches = one foot  
 one inch = one foot  
 three quarters inch = one foot  
 one half inch = one foot  
 three eighths inch = one foot  
 one quarter inch = one foot  
 one eighth inch = one foot

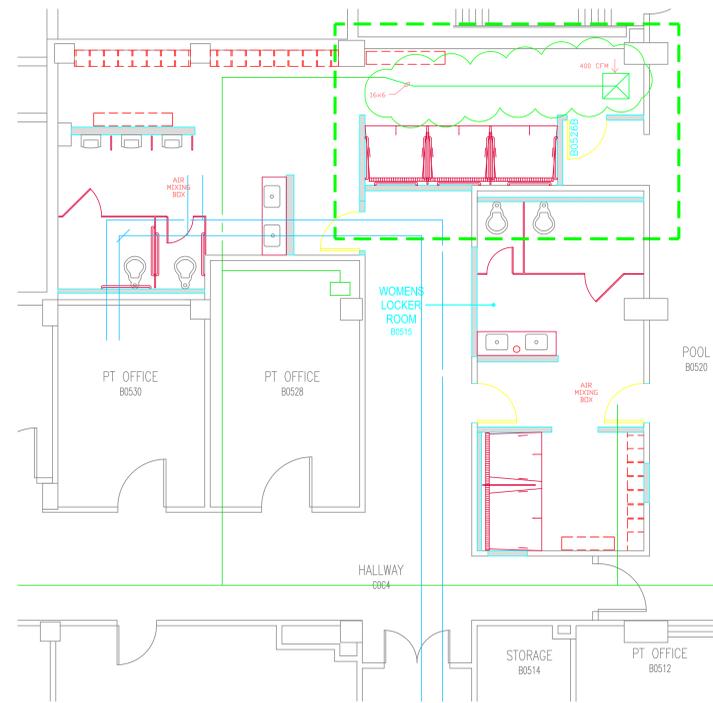

3 PLAN - PHASE 3  
 3/16" = 1'-0"

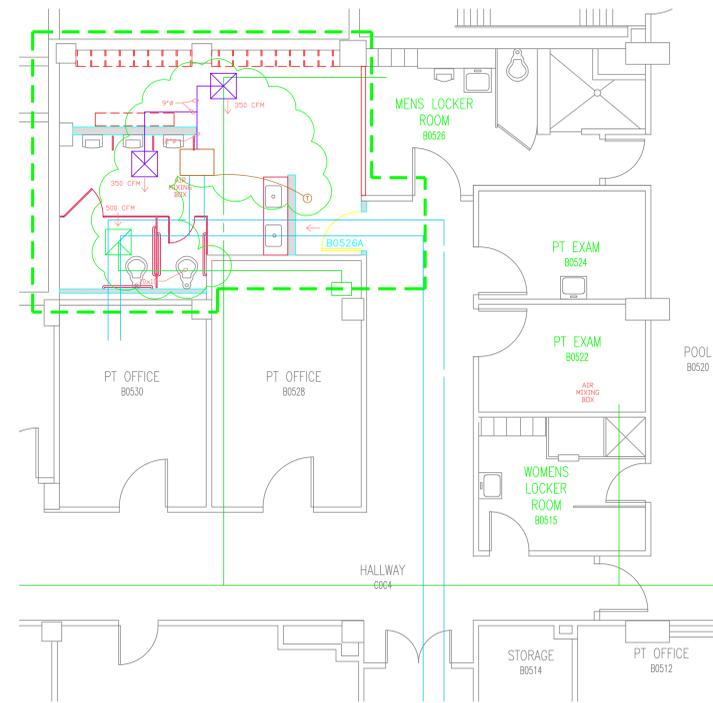

1 PLAN - PHASE 1  
 3/16" = 1'-0"

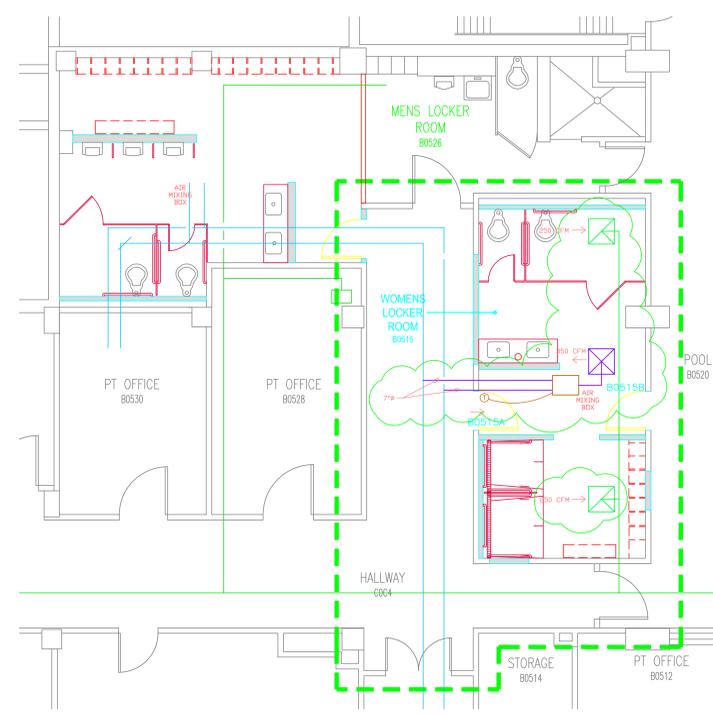

2 PLAN - PHASE 2  
 3/16" = 1'-0"


**GENERAL NOTES**

- REFER TO DETAIL PLANS FOR ADDITIONAL PARTITION INFORMATION, SEE SHEET A-000.
- INTERIOR DIMENSIONS ARE TO FINISH FACE TO FACE U.N.O.
- INSTALL 5/8" TYPE X GYPSUM WALL BOARD AND ACOUSTICAL INSULATION IN ALL ROOMS, FINISH TO GRADE #5.
- ALL SWITCHES, THERMOSTATS, AND OTHER ENVIRONMENTAL CONTROLS SHALL BE MOUNTED AT 40" AFF. TELEPHONE AND POWER OUTLETS SHALL BE AT 18" AFF. THESE CONTROLS SHALL BE LINED UP AT THE SAME HEIGHT AND WHERE MORE THAN ONE ARE ADJACENT, THEY SHALL BE EVENLY SPACED. GROUP MULTIPLE DEVICES IN A SINGLE COVER PLATE WHERE POSSIBLE.
- VERIFY ALL UTILITIES AND CONNECTION LOCATIONS.
- ALL PENETRATIONS IN RATED WALLS, SHALL BE RATED, TESTED ASSEMBLIES AS REQUIRED BY CODE.
- CONTRACTOR SHALL VERIFY ALL EXISTING CONDITIONS AND DIMENSIONS PRIOR TO BEGINNING CONSTRUCTION.
- CORNER GUARDS ARE REQUIRED AT ALL OUTSIDE CORNERS, SOME LOCATIONS MAY NOT BE INDICATED ON DRAWINGS. SEE SHEET ID-101.
- REPLACE DOORS, LOCKS, KICK PLATES, CLOSER, BUMPER GUARDS, DOOR STOPS, AND HARDWARE, SEE SHEET A-000. RESTORE DOOR FRAME TO SMOOTH FINISH AND REPAINT.
- ALL WALL HUNG CASEWORK, SHELVING AND EQUIPMENT ATTACHED TO WALLS SHALL BE ANCHORED BETWEEN STUDS.
- REFER TO INTERIOR FLOOR FINISH PLAN, SHEET ID-101.
- REFER TO INTERIOR WALL FINISH PLAN, SHEET ID-101.
- REFER TO INTERIOR SIGNAGE PLAN, SHEET A-000.
- VERIFY FIELD DIMENSIONS, COORDINATE ACTUAL DIMENSIONS WITH CONTRACTOR AND VA.
- SUBMIT CONCRETE AND STEEL SHOP DRAWINGS INDICATING ACTUAL FILED DIMENSIONS, CONTRACTOR RESPONSIBLE TO DIMENSION OF STRUCTURE TO FIT EXISTING CONDITIONS.
- WALL TYPES SEE A-000
- DIMENSIONS ON FLOOR PLAN ARE BASED ON FACE OF FINISHED WALL TO FACE OF FINISHED WALL (NOMINAL), U.N.O.
- VERIFY ALL DIMENSIONS AND CONDITIONS AT JOB SITE. PORTIONS OF EXISTING CONSTRUCTION MAY HAVE BEEN REMOVED BY OWNER.
- MAINTAIN CONTINUOUS UTILITY SERVICE TO ALL SPACES IN THE BUILDING NOT AFFECTED BY THIS WORK. COORDINATE WITH OWNER ANY DISRUPTION IN SERVICES REQUIRED TO PERFORM WORK OR TO MODIFY EXISTING PIPING, DUCTWORK OR ANY ASSOCIATED EQUIPMENT.
- REFER TO SHEET ID-101 AND ID-102 FOR FINISH SCHEDULE AND FINISH MATERIALS.
- REFER TO SHEET A-000 FOR DOOR SCHEDULE, DOOR TYPES, HARDWARE AND NOTES.

**GRAPHIC LEGEND**

- EXISTING WALL TO REMAIN
- EXISTING DOOR TO REMAIN
- INFECTION CONTROL/CONSTRUCTION BARRIER WALL (FC/CB)
- NEW WALL/PARTITION
- NEW WALL OR CEILING MOUNTED NURSE CALL BUTTON
- NEW SWITCH
- PLAN KEY NOTE
- PARTITION TYPE
- INTERIOR ELEVATION
- NEW DOOR
- NEW WALL MOUNTED ADA AUTOMATIC DOOR OPENER PUSH PLATE - EXACT LOCATION DURING MEP OUTLET BOX WALK-THROUGH
- NEW IVORY RECEPTACLE, DUPLEX WITH GROUND FAULT CIRCUIT INTERRUPTER, HOSPITAL GRADE

**KEY PLAN**

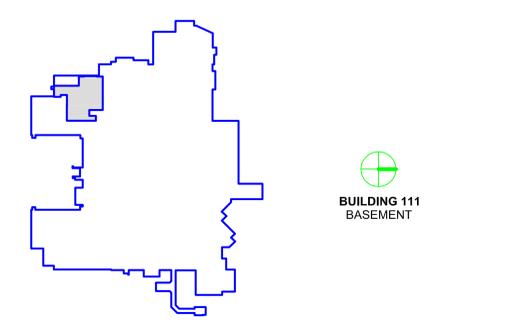

Revisions	Date

Dept. of Veterans Affairs  
 Medical Center  
 5000 W. National Avenue  
 Milwaukee, WI

→ ARCHITECT:  
 CLEMENT J. ZABLOCKI VA MEDICAL CENTER  
 OFFICE OF CONSTRUCTION AND FACILITIES MANAGEMENT

Drawing Title  
**PHASE 1 - 3:  
 MECHANICAL NEW WORK**

Approved: Project Director  
 Troy Martinson, PE

Project Title  
**111 Upgrade Pool Locker  
 Rooms**

Location  
 VA Medical Center, Milwaukee, WI

Date  
 August 28, 2015

Checked  
 Drawn  
 KJM

Project Number  
 695-14-114

Building Number  
 Building 111

Drawing Number  
**M-101**

Office of  
 Construction  
 and Facilities  
 Management

Department of  
 Veterans Affairs