


VA LOMA LINDA RISER DIAGRAM WITH CABLE LAYOUT

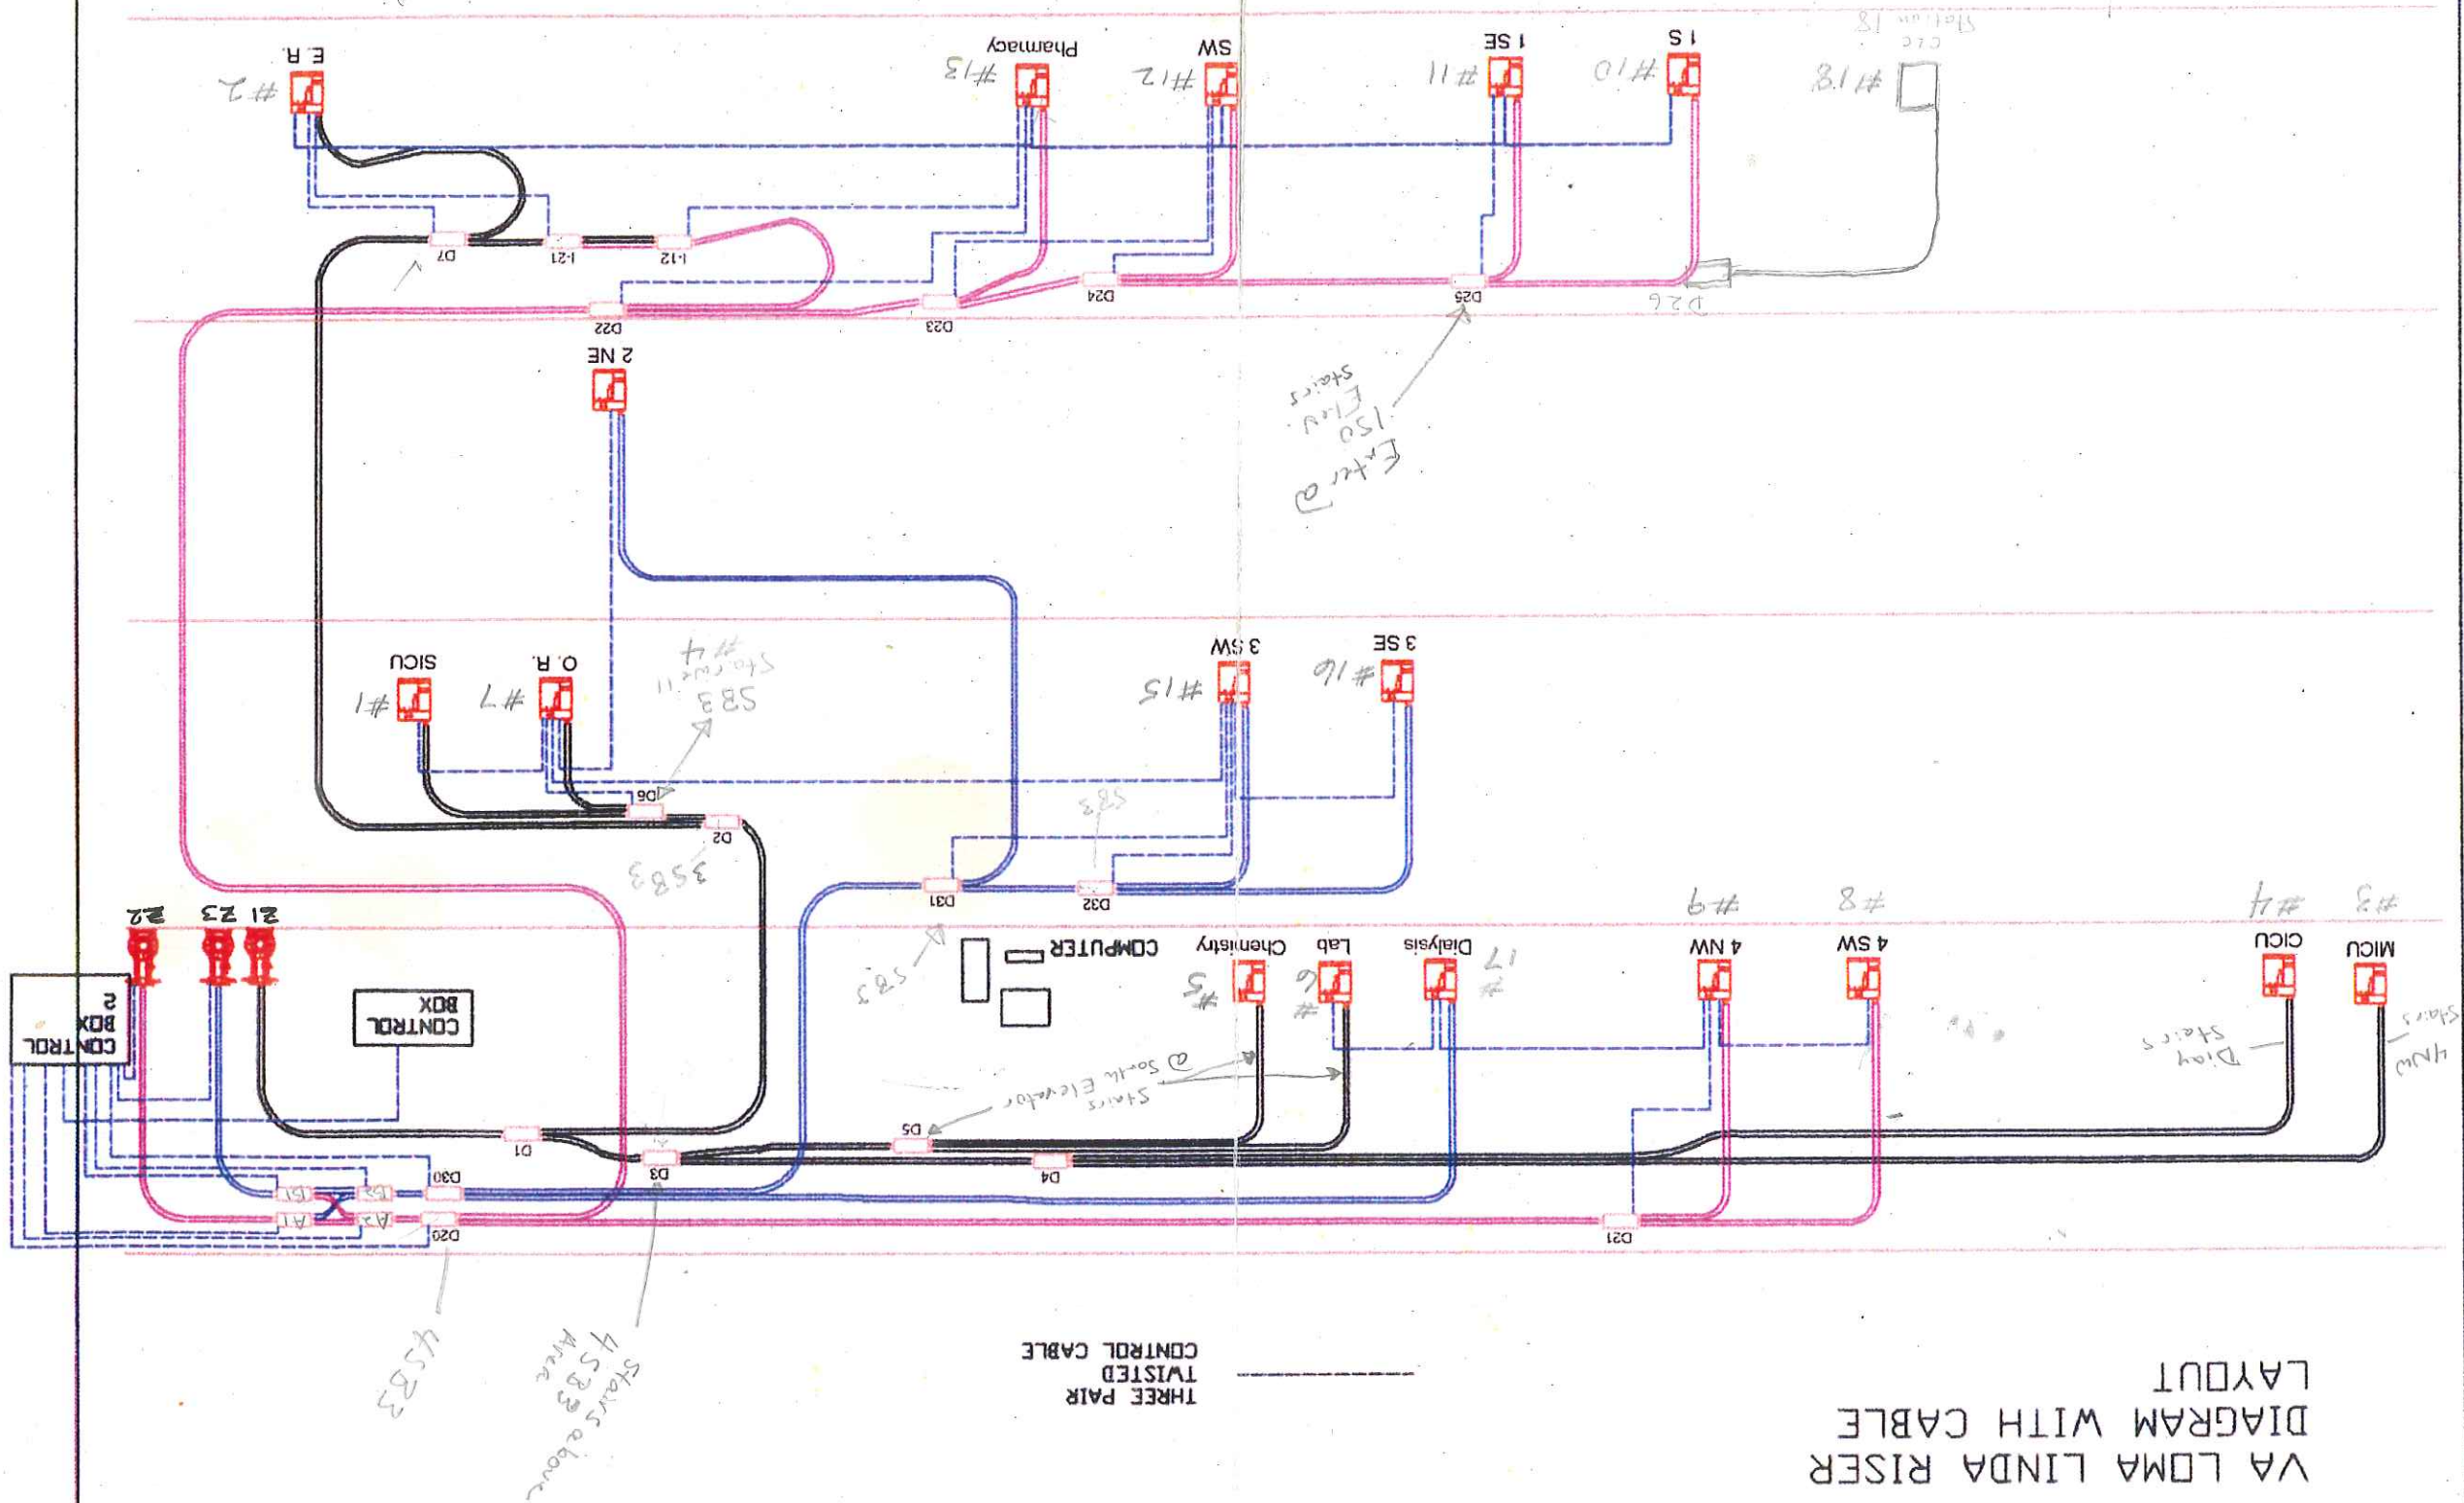

AIR LINK INTERNATIONAL
SCALE: NONE
DATE: 12-05-2007
DVG: VA LOMA LINDA RISER
DVG: BY: R.E.
VA LOMA LINDA HEALTHCARE
SYSTEM RISER DIAGRAM