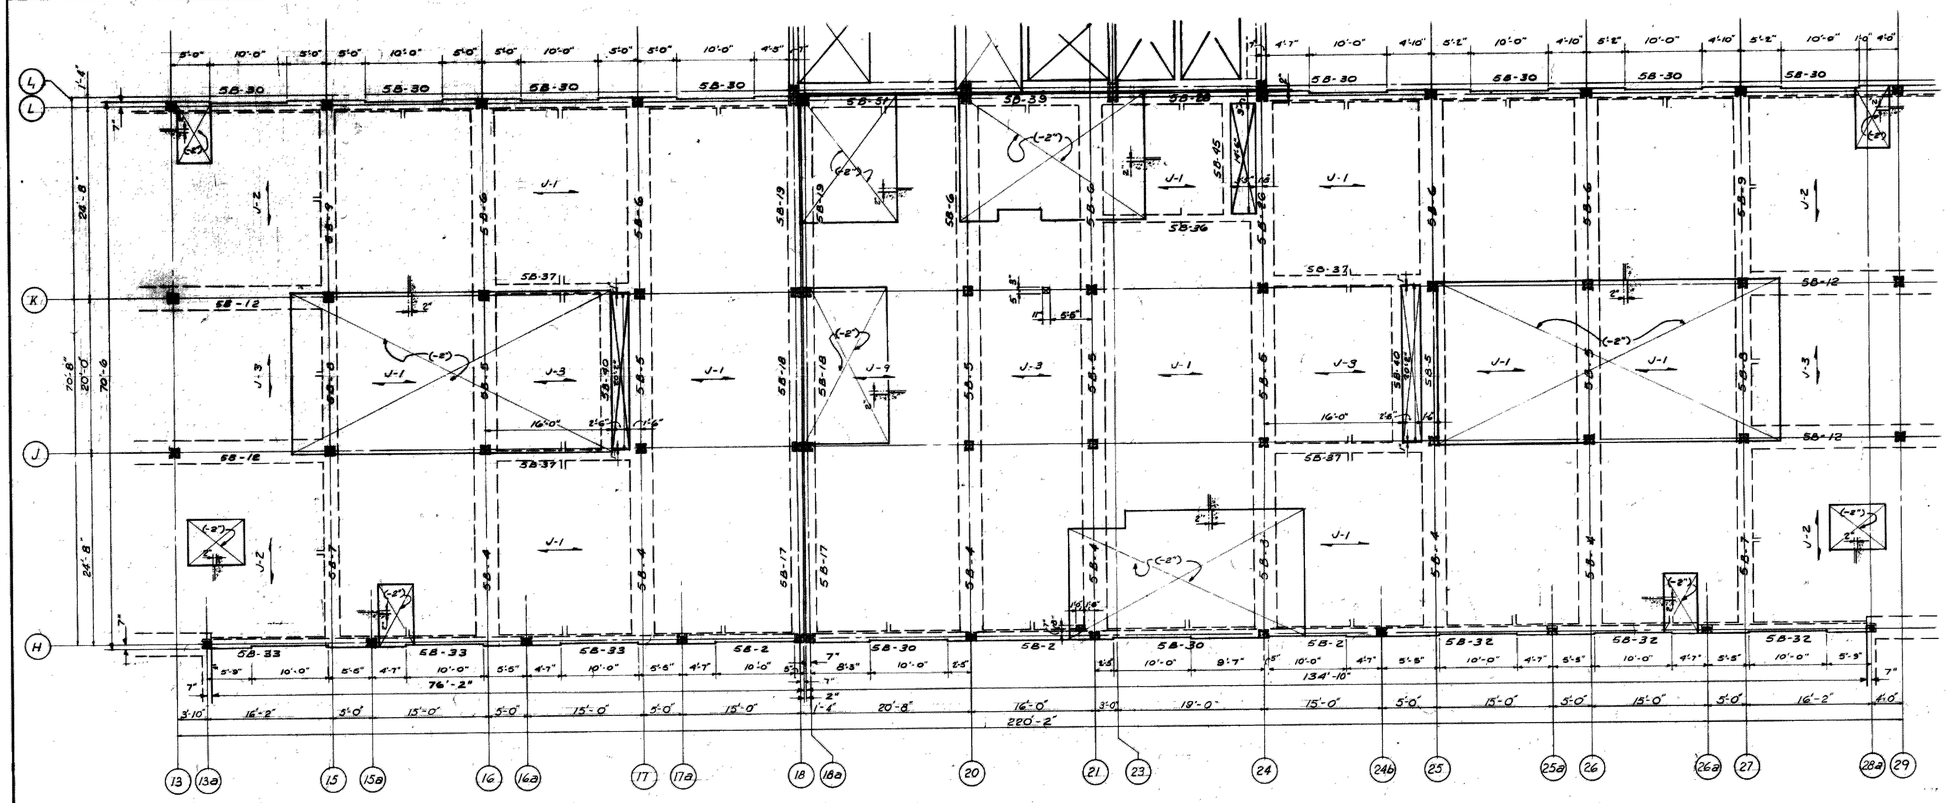

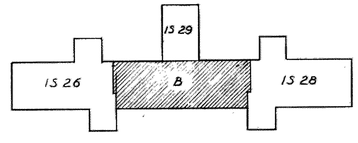

2-2-1-0418

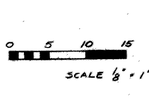

AS BUILT

FIFTH FLOOR FRAMING PLAN UNIT B

BUILDING NO. 1

800 BED GM&S HOSPITAL &
REGIONAL OFFICE MEDICAL CLINICS

VETERANS ADMINISTRATION
CLEVELAND (WADE PARK), OHIO

DRAWN R.W. SIMPKINS PROJ. MGR. [illegible]
CHECKED [illegible] DATE 2/1/61

REVISIONS

DALTON-DALTON ASSOCIATES
SMITH, HINCHMAN & GRYLLS ASSOC., INC.
ARCHITECTS-ENGINEERS
979 THE ARCADE
CLEVELAND 14, OHIO

DRAWING NUMBER
1-527
SHEET 27 OF 52

APPROVED DIRECTOR, DESIGN SERVICE

PROJ. NO. 6-4086

RETURN TRACINGS TO PLAN FILES

AS BUILT
FILE FOLDER NO. 2A