


2-2-1-0914

SCALE 1/8" = 1'-0"

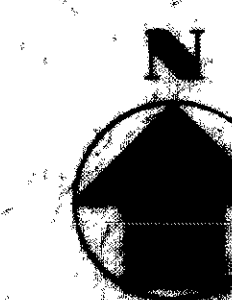

AS BUILT

FOURTH FLOOR PLAN UNITS

BUILDING NO. 1

800 BED GM&S HOSPITAL &  
REGIONAL OFFICE MEDICAL CLINICS

VETERANS ADMINISTRATION  
CLEVELAND (WADE PARK), OHIO

REVISIONS	DRAWING NUMBER
1-523	1-523

APPROVED: DIRECTOR, REGIONAL SERVICE

AS BUILT

FILE FOLDER NO. 2A

RETURN TRACINGS TO PLAN FILES