


0 5 10 15
SCALE 1/8" = 1'-0"

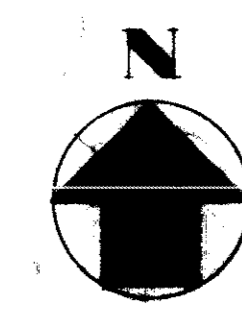

AS BUILT	
ROOF FLOOR PLAN, BUILDING NO. 1	
BUILDING NO. 1	
800 BED GM&S HOSPITAL & REGIONAL OFFICE MEDICAL CLINICS	
VETERANS ADMINISTRATION CLEVELAND (WADE PARK), OHIO	
DRAWN BY: <i>CHS/PALEY</i>	PROJ. NO.: <i>6-4086</i>
CHECKED BY: <i>CHS/PALEY</i>	DATE: <i>2/1/64</i>
DALTON-DALTON ASSOCIATES SMITH, HINCHMAN & GRYLLS ASSOC., INC. ARCHITECTS-ENGINEERS 275 THE ARCADE CLEVELAND 14, OHIO	
APPROVED DIRECTOR, DESIGN SERVICE	
REVISIONS	DRAWING NUMBER <i>1-535</i>
	SHEET <i>38</i> OF <i>52</i>
	PROJ. NO. 6-4086

RETURN DRAWINGS TO PLAN FILES

AS BUILT
FILED IN NO. 2A