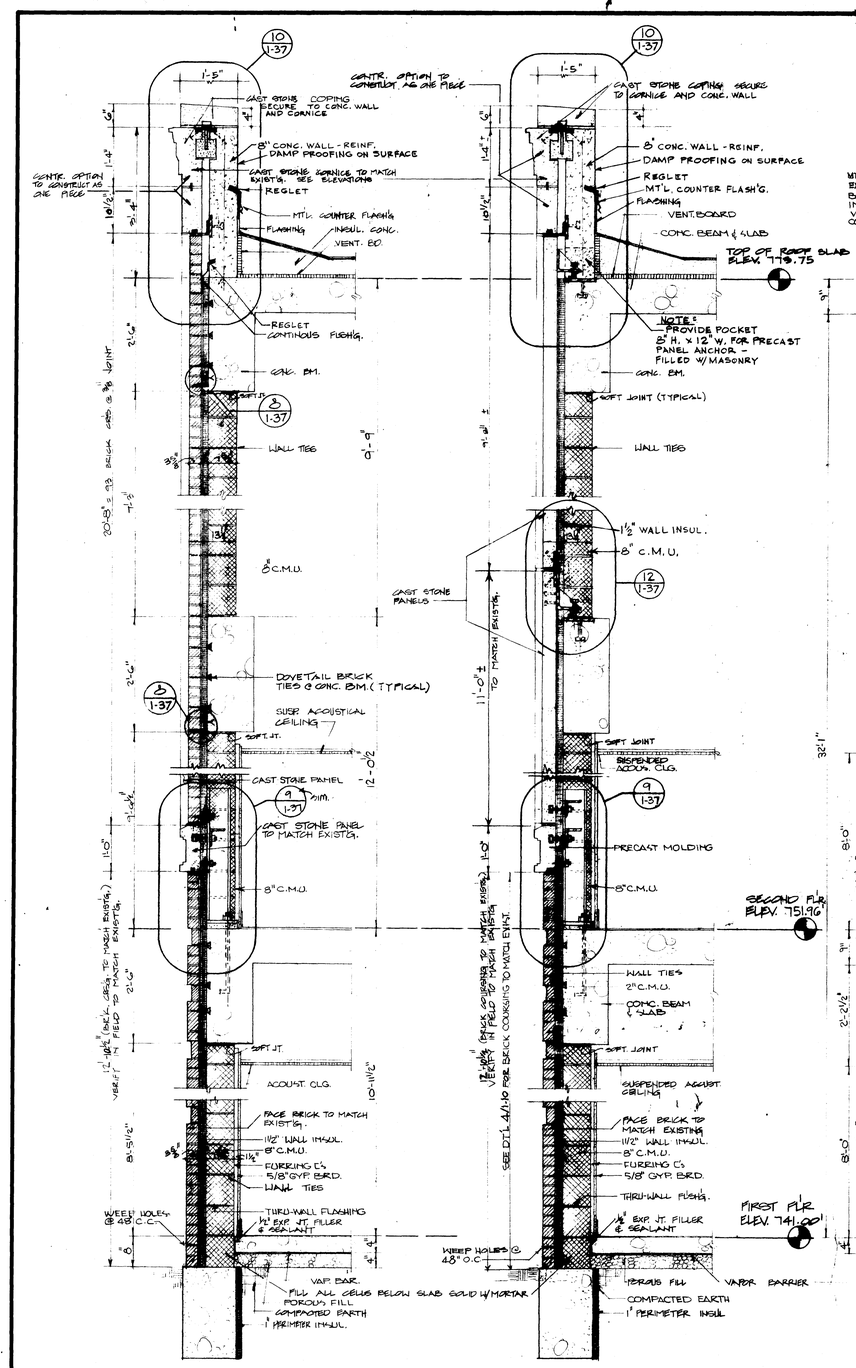

1 1-11 WALL SECTION 3/4"=1'-0"

2 1-11 WALL SECTION 3/4"=1'-0"

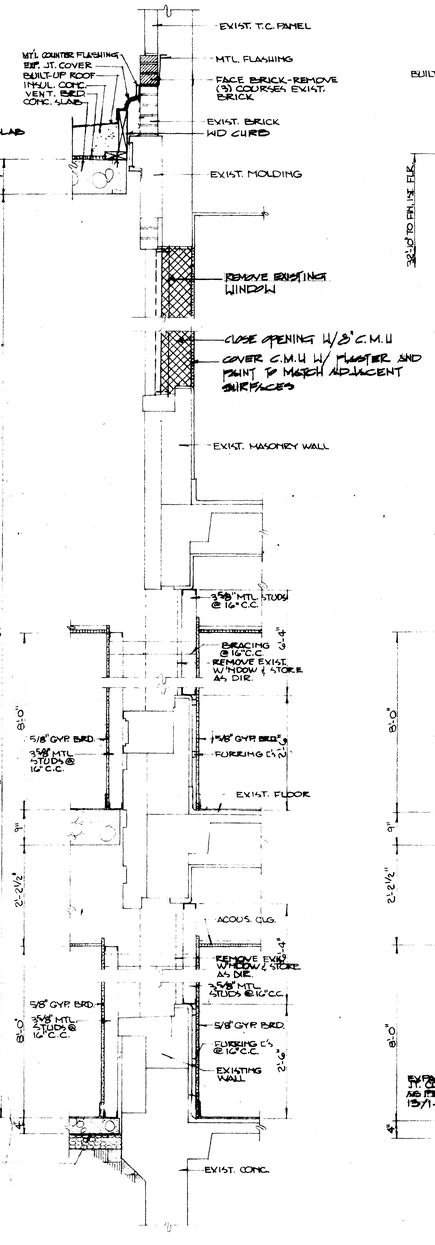

3 1-11 WALL SECTION

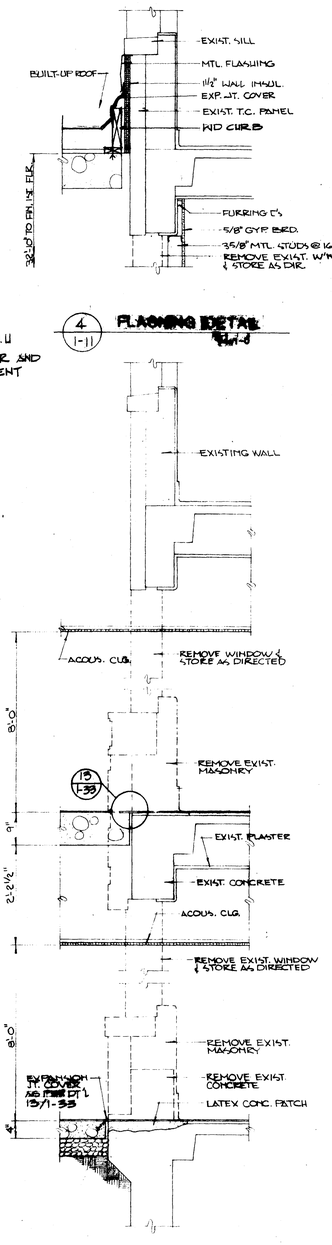

5 1-11 WALL SECTION 3/4"=1'-0"

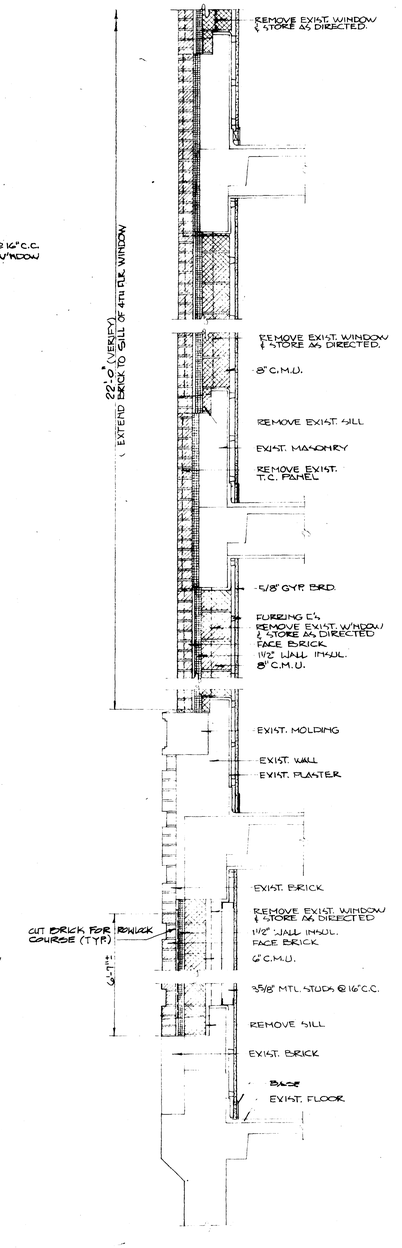

6 1-11 WALL SECTION 3/4"=1'-0"

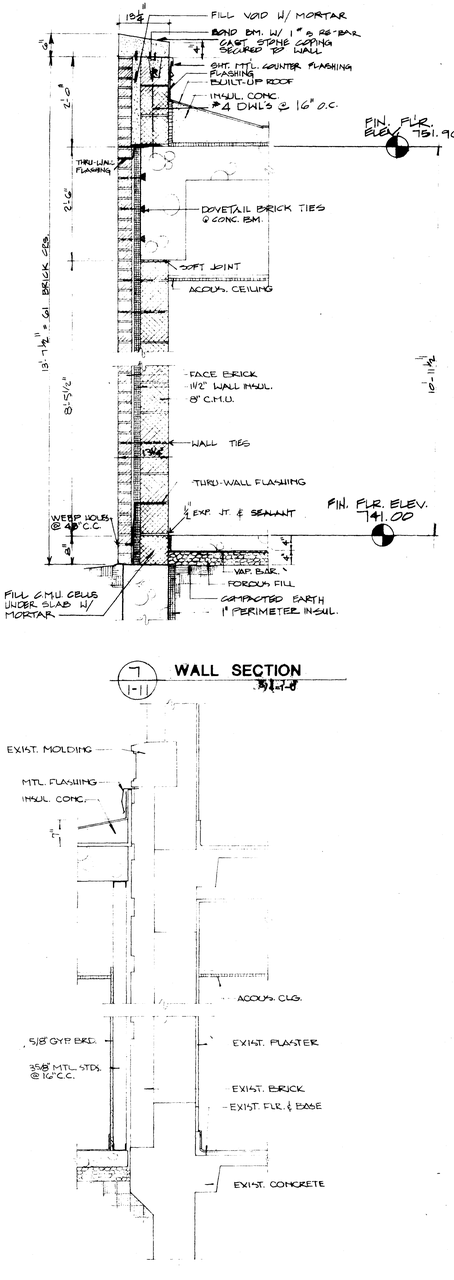

7 1-11 WALL SECTION 3/4"=1'-0"

8 1-11 WALL SECTION 3/4"=1'-0"

AS RECORDED 11.15.85

Revisions | Date

GENERAL NOTES :

[redacted]

HTB, Inc.
Architects · Engineers · Planners
717 South Houston Avenue
Box 3289 Tulsa, Oklahoma
Tel (918) 587-7828 74101

Drawing Title: WALL SECTIONS
Approved Project Director
Drawn: A.I., T.W.
Checked: A.I.
Project Title: CLINICAL ADDITION
Building Number: 1
Location: MUSKOGEE, OKLA.
Date: DEC 28 - 1982
Project No: 823 - 034
DRAWING No: 1-11
Dwg. Of

Veterans Administration

VA FORM 08-6231A, OCT 1978