three inches = one foot
one and one half inches = one foot
one inch = one foot
three quarters inch = one foot
one half inch = one foot
three eighths inch = one foot
one quarter inch = one foot
one eighth inch = one foot

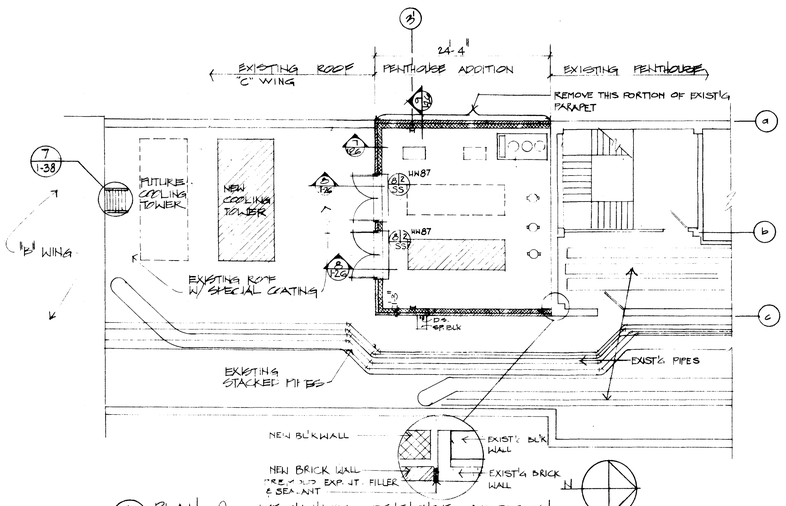

1 / 1-26 PLAN @ MECHANICAL PENTHOUSE ADDITION 1/8" = 1'-0"

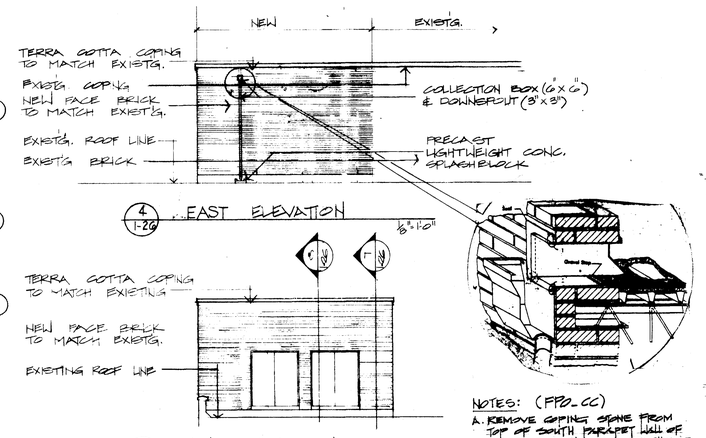

4 / 1-26 EAST ELEVATION 1/8" = 1'-0"

5 / 1-26 SOUTH ELEVATION 1/8" = 1'-0"

6 / 1-26 WEST ELEVATION 1/8" = 1'-0"

NOTES: (FPD_CC)

A. REMOVE COPING STONE FROM TOP OF SOUTH PARAPET WALL OF EXISTING MECHANICAL PENTHOUSE ON ROOF OF "C" WING.

B. EXTEND THE PARAPET WALL UPWARD TO THE ROOF ELEVATION OF NEW MECHANICAL PENTHOUSE ADDITION. NEW WALL EXTENSION SHALL BE CONSTRUCTED OF BLOCK AND BRICK TIED TOGETHER W/ DURAWALL AT EVERY HORIZONTAL JOINT. INSTALL THRU-WALL FLASHING AT CONNECTION POINT OF EXISTING PARAPET AND NEW WALL EXTENSION.

C. INSTALL A GRAVEL STOP ALONG THE NORTH SIDE OF THE NEW MECH. PENTHOUSE ROOF.

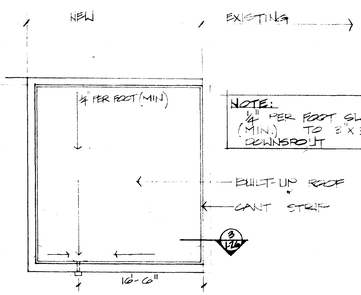

2 / 1-26 PENTHOUSE ROOF PLAN 1/8" = 1'-0"

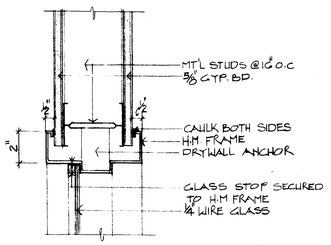

10 / 1-26 HEAD, JAMB & SILL DT'L 3" = 1'-0"

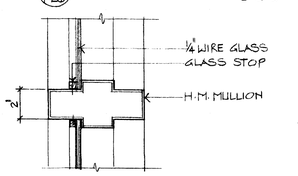

11 / 1-26 MULLION DT'L 3" = 1'-0"

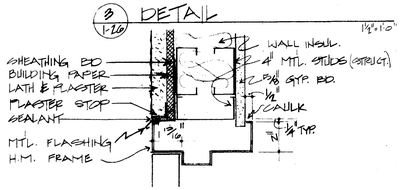

HEAD

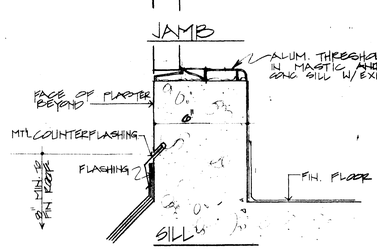

JAMB

8 / 1-26 DETAIL 1 1/2" = 1'-0"

12 / 1-26 DOOR @ KITCHEN CORRIDOR 3'-0" x 7'-0"
FRAME TYPE NO. 10

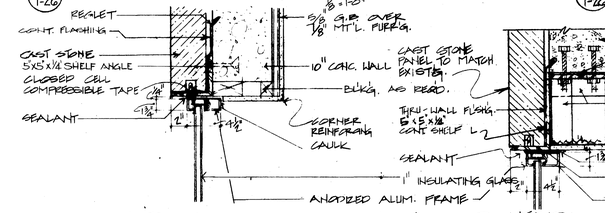

7 / 1-26 WALL SECTION 1/2" = 1'-0"

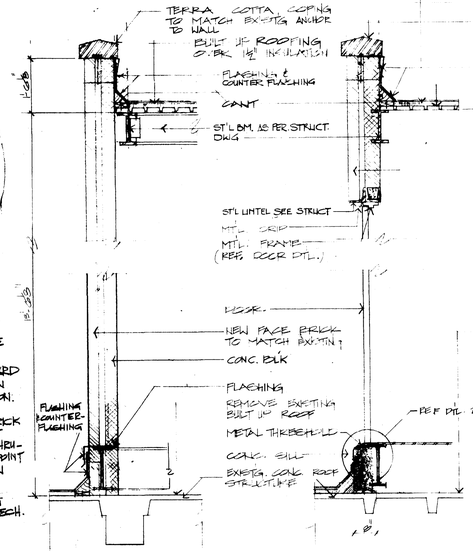

8 / 1-26 WALL SECTION 1/2" = 1'-0"

9 / 1-26 WALL SECTION 1/2" = 1'-0"

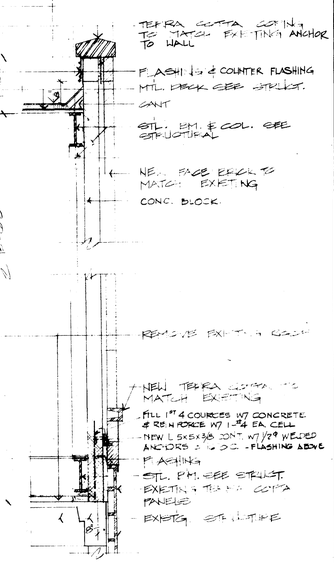

13 / 1-26 HEAD 1 1/2" = 1'-0"

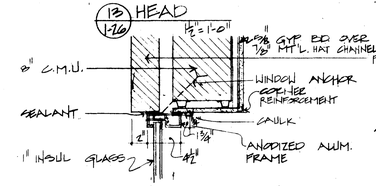

10 / 1-26 HEAD 1 1/2" = 1'-0"

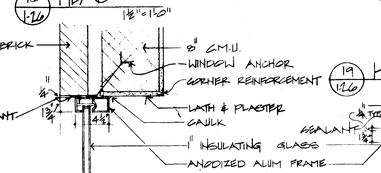

19 / 1-26 HEAD

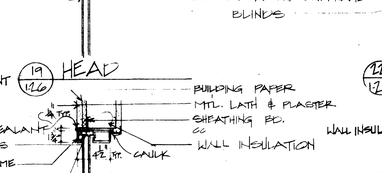


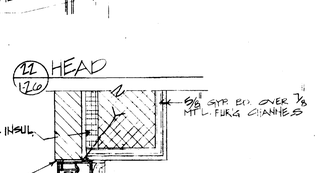

14 / 1-26 JAMB 1 1/2" = 1'-0"

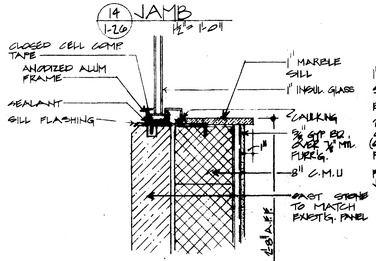

15 / 1-26 JAMB

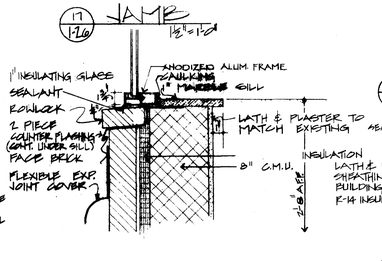

20 / 1-26 JAMB

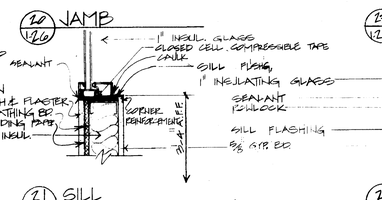


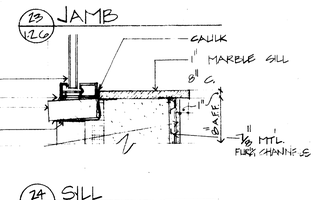

21 / 1-26 SILL 1 1/2" = 1'-0"

24 / 1-26 SILL 1 1/2" = 1'-0"

18 / 1-26 SILL 1 1/2" = 1'-0"

16 / 1-26 SILL 1 1/2" = 1'-0"

AS RECORDED 11.15.85

Revisions	Date

GENERAL NOTES : Based on the Project Documents, including the drawings and specifications dated 8/82/85, together with all written modifications thereto, and the recommendation of the Veterans Administration's Resident Engineer, Staff Inc. construction in accordance with the Project Documents, or where deviations exist, the contractor certifies that the following described work represents the as-installed construction as known on 11/15/85.

HTB, Inc.
Architects · Engineers · Planners
717 South Houston Avenue
Box 3289 Tulsa, Oklahoma
Tel: (918) 587-7283 74101

Drawing Title	PENTHOUSE EXPANSION
Project Title	CLINICAL ADDITION
Date	DEC.18-1982
Project No	623 - 034
Approved Project Director	
Drawn	I.V.B.
Checked	A.I.
Building Number	1
Location	MUSKOGEE, OKLA.
DRAWING NO	1-26
Dwg.	00

Veterans Administration

VA FORM 08-6231A, OCT 1978

N13377