


three inches = one foot  
one and one half inches = one foot  
one inch = one foot  
three quarters inch = one foot  
one half inch = one foot  
three eighths inch = one foot  
one quarter inch = one foot  
one eighth inch = one foot

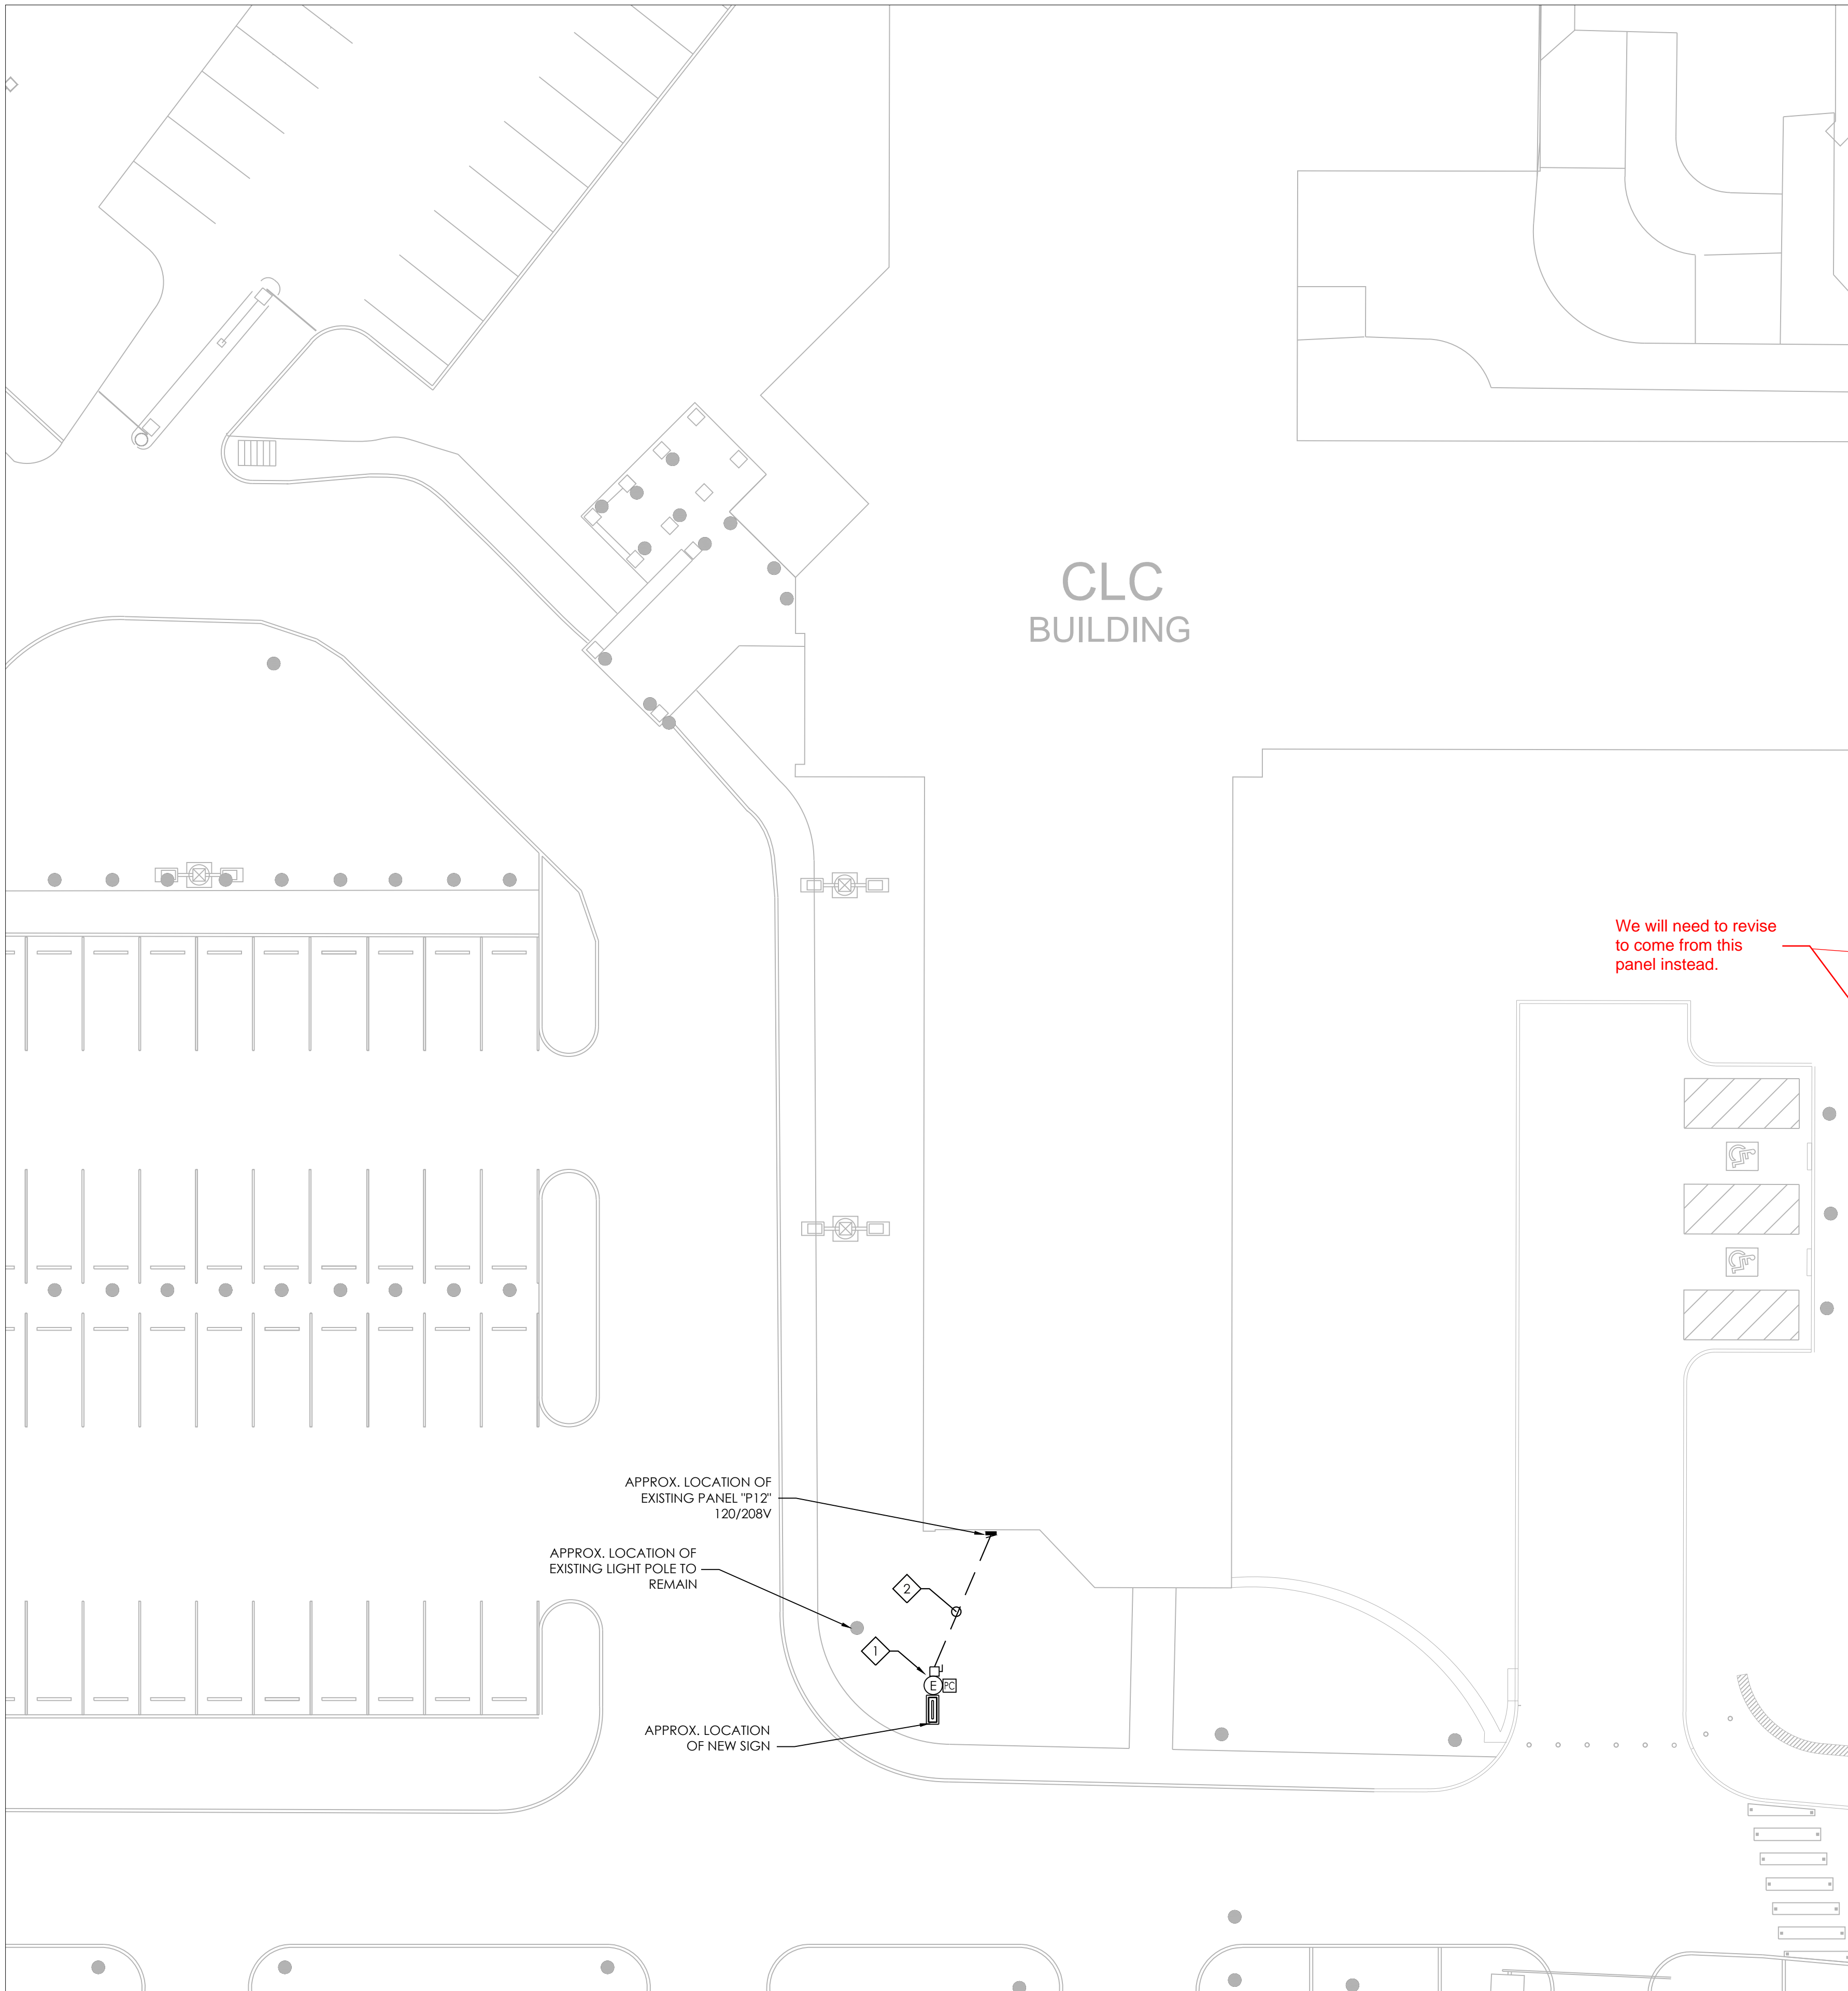

### 1 ENLARGED SITE PLAN - CLC BLDG - ELECTRICAL

SCALE: 1/16"=1'-0" 0 8' 16' 32'


#### GENERAL NOTES:

- REFERENCE SHEET ES0.1 FOR LEGEND, ABBREVIATIONS AND FURTHER GENERAL NOTES.

#### KEYED NOTES:

- FURNISH AND INSTALL A 20A/240V/2P/2W/NEMA 3R DISCONNECT SWITCH TO SERVE THE NEW SIGN. MOUNT THE DISCONNECT ON THE SIGN NEAR THE ELECTRICAL CONNECTION BOX. FURNISH AND INSTALL A NEW 120V BRANCH CIRCUIT TO THE NEW SIGN VIA A NEW 20A/120V PHOTOCELL; 2#10, #10 GND, 3/4"C. MOUNT THE PHOTOCELL TO A JUNCTION BOX NEAR THE ELECTRICAL CONNECTION TO THE SIGN OR TO THE ADJACENT ROCK COLUMN OF THE FENCE APPROX. 18'AFG.
- APPROXIMATE ROUTING OF THE UNDERGROUND CIRCUIT TO THE NEW SIGN. EXCAVATE AND BACKFILL THE GRASSY AREA TO FACILITATE THE INSTALLATION OF THE NEW CIRCUIT. CIRCUIT THE NEW SIGN TO THE EXISTING 120V CIRCUIT SERVING THE CONVENIENCE RECEPTACLE; 2#12, #12 GND, 3/4"C.
- FURNISH AND INSTALL A 20A/240V/2P/2W/NEMA 3R DISCONNECT SWITCH TO SERVE THE NEW SIGN. MOUNT THE DISCONNECT ON THE SIGN NEAR THE ELECTRICAL CONNECTION BOX. CONNECT THE EXISTING BRANCH CIRCUIT TO THE NEW SIGN VIA A NEW 20A/120V PHOTOCELL. MOUNT THE PHOTOCELL A JUNCTION BOX NEAR THE SIGN ELECTRICAL CONNECTION.
- FURNISH AND INSTALL A NEW 20A/240V/2P/2W/NEMA 3R DISCONNECT SWITCH AND 120V BRANCH CIRCUIT TO THE NEW SIGN FROM THE EXISTING PANEL "GLB". FURNISH AND INSTALL A NEW 20A/120V CIRCUIT BREAKER IN THE EXISTING PANEL "GLB" TO SERVE THE NEW SIGN. FURNISH AND INSTALL A NEW 20A/1P CIRCUIT BREAKER IN PANEL "GLB" TO SERVE THE NEW SIGN. CIRCUIT THE NEW SIGN'S LED DISPLAY TO THE UNSWITCHED CIRCUIT AND CIRCUIT THE SIGN'S INTERNAL LIGHTING VIA A NEW 20A/120V PHOTOCELL; 2#10, #10 GND, 3/4"C. MOUNT THE PHOTOCELL TO A JUNCTION BOX NEAR THE ELECTRICAL CONNECTION TO THE SIGN.

- APPROXIMATE ROUTING OF THE NEW UNDERGROUND CIRCUIT. FURNISH AND INSTALL A NEW CIRCUIT FROM THE OUTPUT OF THE PHOTOCELL TO SERVE THE NEW SIGN. REMOVE AND SALVAGE THE EXISTING BRICK WALKWAY TO FACILITATE THE INSTALLATION OF THE NEW UNDERGROUND CIRCUIT. REINSTALL AND GROUT THE EXISTING SQUARE D QO LOAD CENTER.
- FURNISH AND INSTALL A NEW 20A/120V CIRCUIT BREAKER IN THE EXISTING LOAD CENTER TO SERVE THE NEW SIGN. THE NEW CIRCUIT BREAKER SHALL BE RATED FOR 10 KAIC AND SHALL BE COMPATIBLE WITH THE EXISTING SQUARE D QO LOAD CENTER.
- APPROXIMATE ROUTING OF THE UNDERGROUND CIRCUIT SERVING THE TWO SIGNS SHOWN ON SHEET ES1.4.
- FURNISH AND INSTALL A NEW 20A/277V CIRCUIT BREAKER IN THE EXISTING PANEL "GLA" TO SERVE THE TWO NEW SIGNS (REF. SHEET ES1.4 FOR THE SIGN LOCATIONS). THE NEW CIRCUIT BREAKER SHALL BE RATED FOR 35 KAIC (CUTLER HAMMER FD35K) AND SHALL BE COMPATIBLE WITH THE EXISTING CUTLER HAMMER PRL3A PANEL.
- FURNISH AND INSTALL A 20A/120V, GFI DUPLEX RECEPTACLE IN A WEATHERPROOF JUNCTION BOX WITH A METALLIC IN USE COVER. MOUNT THE RECEPTACLE NEAR THE BASE OF THE SIGN OR INSIDE THE SIGN PROVIDED THERE IS AN ACCESS PANEL TO MAINTAIN ACCESSIBILITY TO THE RECEPTACLE. CIRCUIT THE RECEPTACLE TO THE UNSWITCHED CIRCUIT SERVING THE SIGN LED DISPLAY.
- CUT AND PATCH THE ASPHALT DRIVE TO ROUTE THE CIRCUIT FROM PANEL "GLB" TO THE NEW SIGN. OBTAIN AN APPROVAL FROM THE VA PROJECT MANAGER PRIOR TO SHUTTING DOWN THE DRIVE.
- CIRCUIT THE NEW SIGN TO THE OUTPUT OF THE PHOTOCELL SERVING THE ADJACENT SIGN FOR DUSK TO DAWN CONTROL.

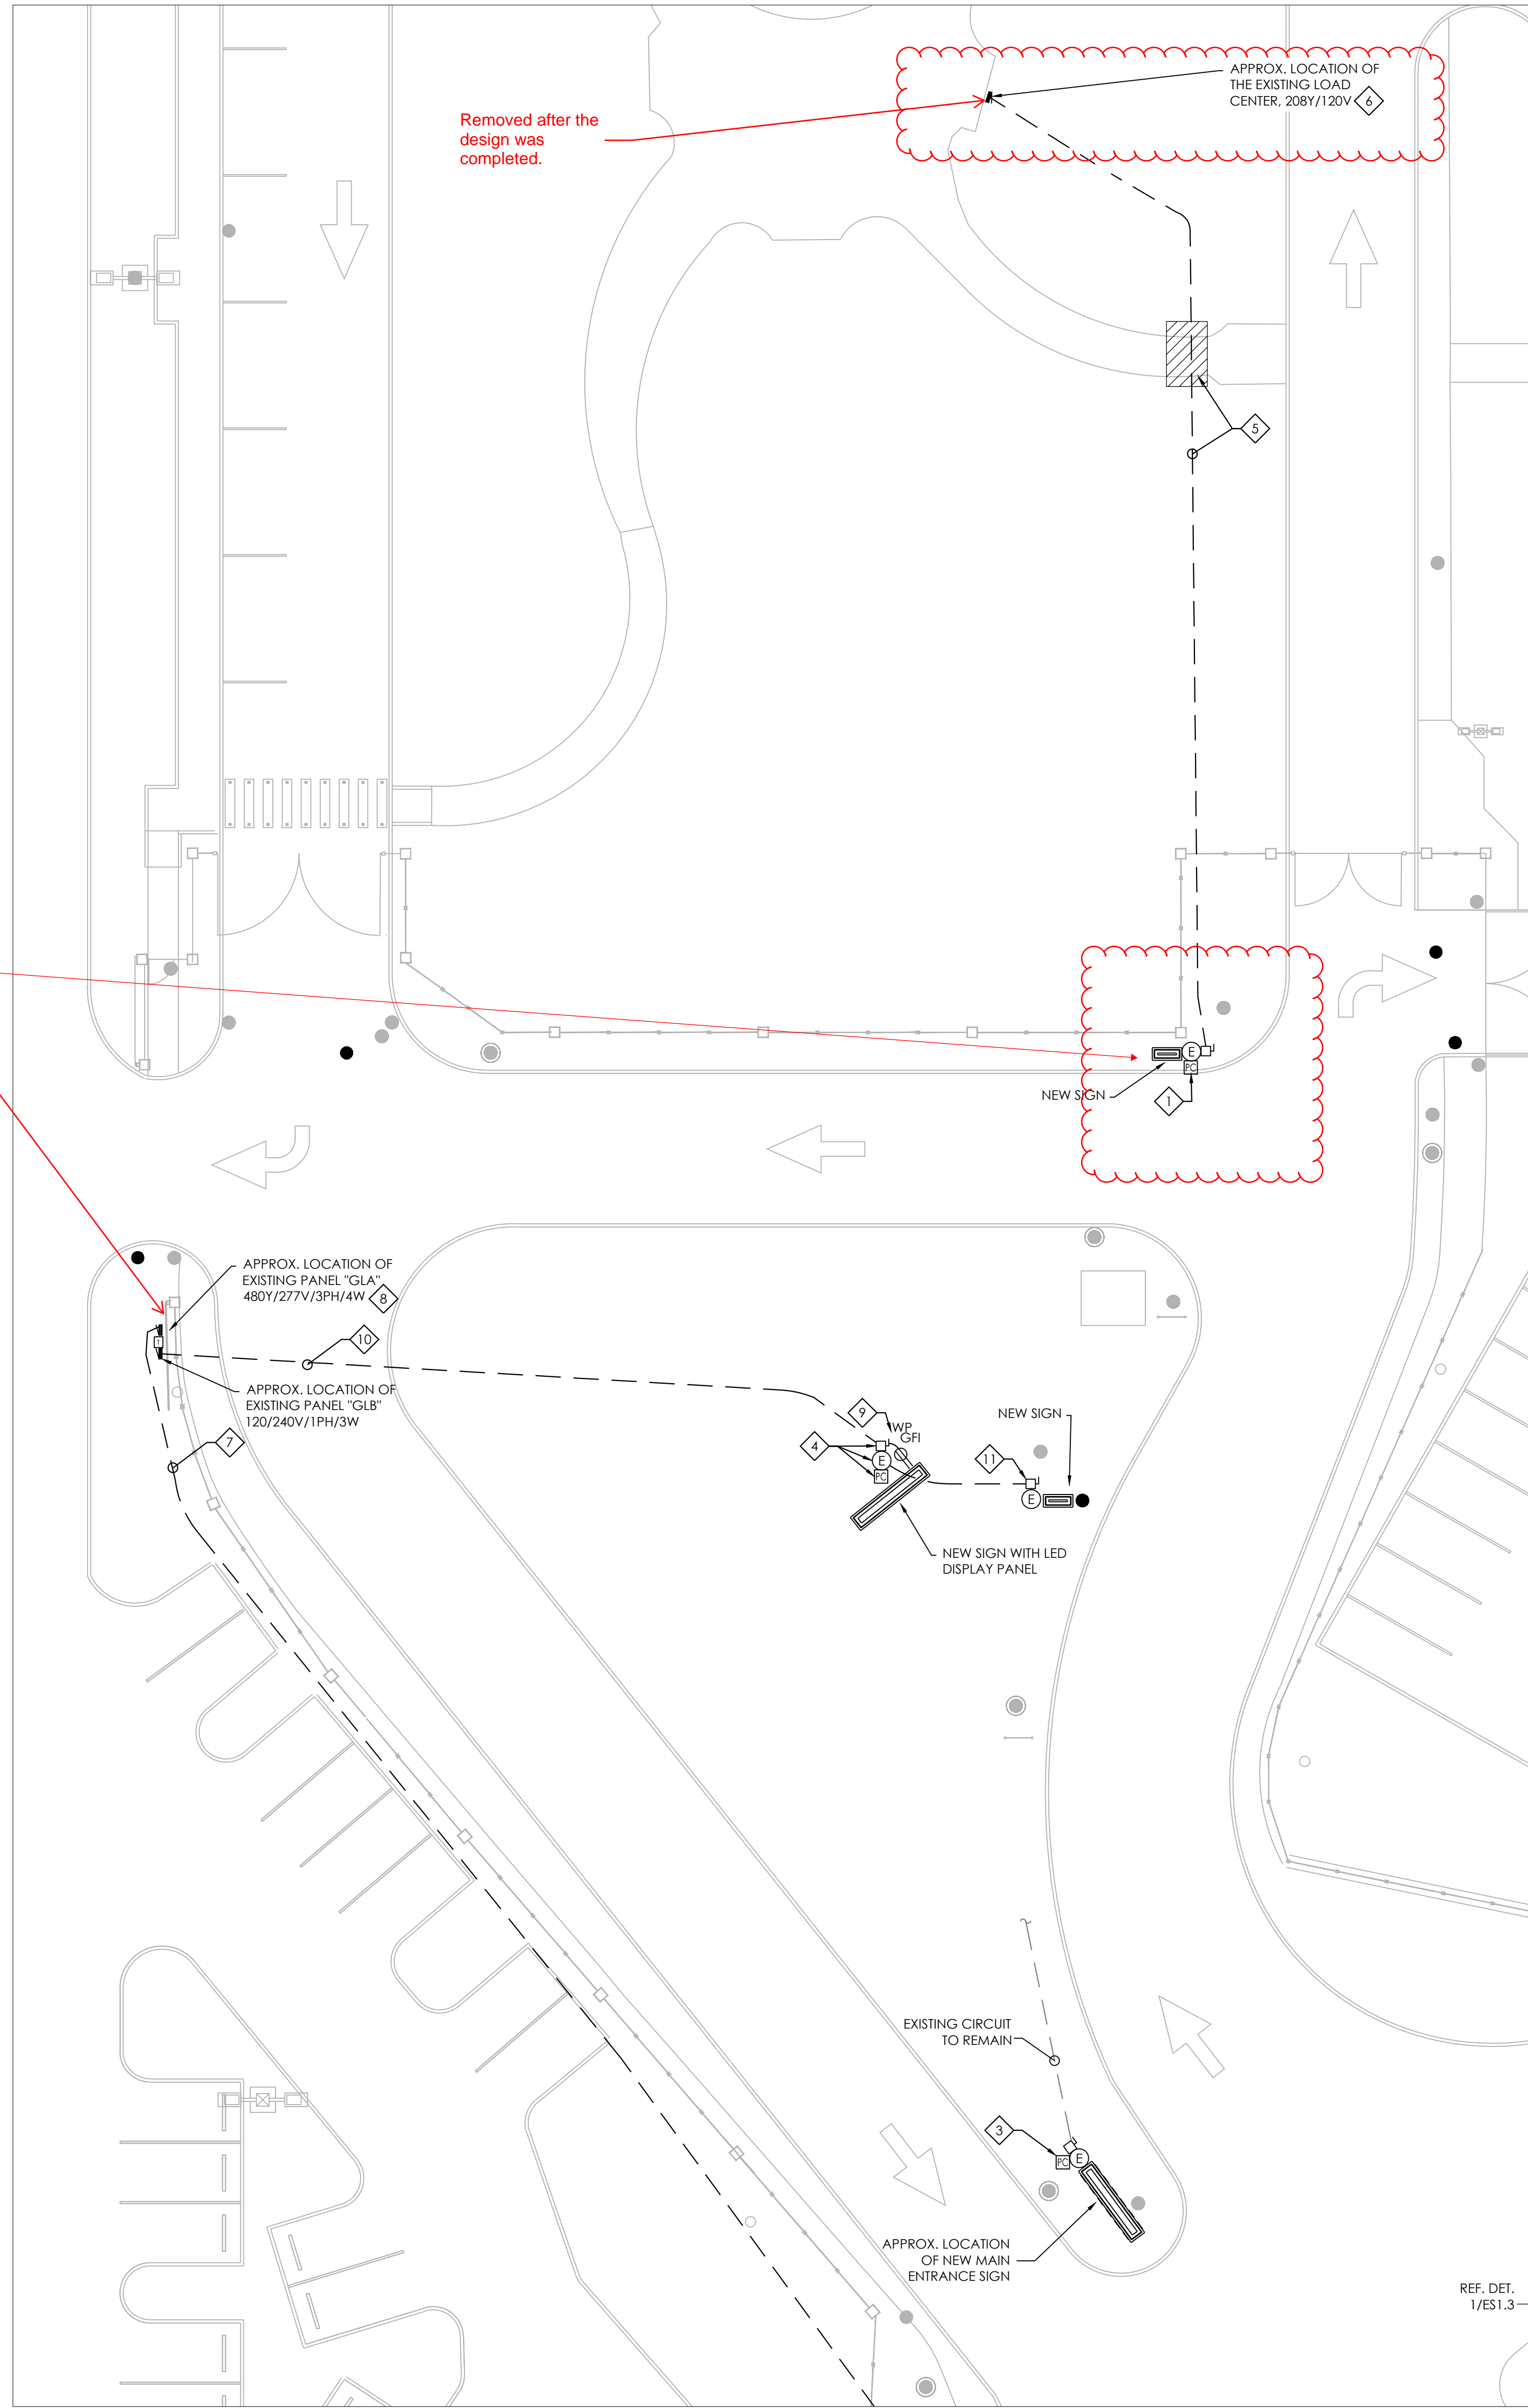

### 2 ENLARGED SITE PLAN - MAIN ENTRANCE - ELECTRICAL

SCALE: 1/16"=1'-0" 0 8' 16' 32'

REF. DET. 1/ES1.3

REF. DET. 2/ES1.3

#### KEY PLAN

<b>CONSULTANTS:</b>  <b>Barker &amp; Associates, Inc.</b> Consulting Engineers Firm Registration No. F-9213 824 Broadway St., Suite 201 San Antonio, Texas 78215 Phone: (210) 326-1191 Fax: (210) 223-9194 Email: barkerassociates@barker-sa.com		Concur M & O Approved: Service Chief	Approved: Service Chief	<b>FINAL SET</b> 	<b>ARCHITECT:</b> <b>WESTEAST DESIGN GROUP</b>  200 E. GRAYSON ST., SUITE 207, SAN ANTONIO, TEXAS 78215 USA 210.530.0755 FAX: 210.293.1018 These documents can not be copied or reproduced without written consent from WestEast Design Group	Drawing Title <b>ENLARGED SITE PLAN - ELECTRICAL</b>		Project Title Replace Exterior Site Signage	Project Number 671-14-118 Building Number
Revisions:		Concur Bio-Med Approved: Service Chief	Approved: Service Chief			Approved: Project Director		Location Audie L. Murphy Memorial Veterans Hospital San Antonio, Texas	Drawing Number <b>ES1.3</b> Dwg. 44 of 48
Date		Concur Safety Approved: Service Chief	Approved: Service Chief			Date NOV. 19, 2015		Checked DB	Drawn JS
		Approved: Service Chief	Approved: Chief of Staff					Department of Veterans Affairs	