

RFI 07212.1: All exterior walls where J-4 walls were deleted and more than 3/4" of fire safing is exposed to be handled per RFI.

FLOOR PLAN LEGEND

NOT ALL SYMBOLS/NOTES APPEAR ON EVERY SHEET
WHERE SYMBOL REFERENCES ANOTHER DRAWING, SERIES
SYMBOL, IS SHOWN FOR BOUNDARY/REGIONAL COORDINATION
ONLY. REFERENCE THE DIMENSIONING DRAWINGS FOR FULL
SCOPE OF SYMBOL LOCATIONS & ASSOCIATED SPECIFICATIONS

GENERAL FLOOR PLAN NOTES

FLOOR PLAN SHEET NOTES


FLOOR PLAN SHEET NOTES

[illegible]

12 MAY 02 14:50:00 07004

[illegible]

KEY PLAN

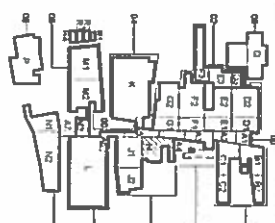

**CONSTRUCTION DOCUMENTS 1
FULLY SPRINKLERED**

OFFICE OF
CONSTRUCTION

MANAGEMENT

3
 VOLUME 15

10

REVISIONS:	DATE
01 BILLING	10/15/03
02 BILLING	10/15/04
03 BILLING	10/15/04
CONSULTANTS:
DESIGN ASSOCIATES / PARKING
CODE CONSULTANTS, INC. / CODE CONSULTANTS
THE SERGANT GROUP / AN & ACOSTA
HAMMER DESIGN ASSOCIATES / FOOD SERVICE
PYPBURN & ODOM / ABATEMENT
TATA & HOWARD / TASK CONSULTANT
I.S.C. GROUP, INC. / IRRIGATION
DAN EUSER WATER ARCHITECTURE, INC. / WATER

TERMINAL

ARCHITECT/JEN

studios NOVA


SCHREINK & PETERSON CO.
KORDANEMETH ENGINEER
BR-A CONSULTING ENGINEER
ARCHITECTURAL ENGINEER
SCALES ASSOCIATES / FRI

4

ENGINEERS:
CONSULTING ENGINEERS / CIVIL
ENGINEERING / STRUCTURAL
ENGINEERS / MECH. ELECT.
PLUMBING, LOW VOLTAGE
WIRING / PLUMBING
FIRE PROTECTION

BLDG 3 FIRST FLOOR PLAN - AREA 1

PROJECT TITLE	SLIVICS REPLACEMENT MEDICAL CENTER PROJECT		
LOCATION	NEW ORLEANS, LOUISIANA		
DATE	February 29, 2012	DIRECTED BY	ML
		DESIGNED BY	ADD/MDM

PROJECT NUMBER 629-HSZ-401	BUILDING NUMBER 03	DOCUMENT REFERENCE WPA-08	DRAWING NUMBER 3A1101-H	 Department of Virginia

OF
ACTION
ILITIES
EMENT



CONSULTANTS:	
DESIGN ASSOCIATES / PARKING	
CODE CONSULTANTS, INC. / CODE CONSULTANT	
THE SEXTANT GROUP / AV & ACUSTICAL	
HAMMER DESIGN ASSOCIATES / FOOD SERVICE	
RYBURN & ODOM / ABATEMENT	
TATY & HOWARD / TANK CONSULTANT	
U.S.C. GROUP, INC. / IRRIGATION	
DAW EUBER WATER ARCHITECTURE, INC. / WATER FEATURE	
10/19/2013	DATE
10	BUL 015C VE
REVISIONS:	



ARCHITECT/ENGINEERS:	
NOVA	
SCHRECK & PETERSON CONSULTING ENGINEERS / CIVIL	
KORDANEMETH ENGINEERING / STRUCTURAL	
BRYAN CONSULTING ENGINEERS / MECH. ELECT. PLUMBING, LOW VOLTAGE	
ARCHITECTURAL ENGINEERING / PLUMBING	
SCALES ASSOCIATES / FIRE PROTECTION	

BLDG 3 OVERALL SIXTH FLOOR PLAN	
APPROVED PROJECT DIRECTOR	

PROJ. CT. TITL.	
SERVICES REPLACEMENT MEDICAL CENTER PROJECT	
DATE	CHECKED
February 29, 2012	ML
NEW ORLEANS, LOUISIANA	AG/OMK


PROJECT NUMBER	
029-HS2-401	03
DOCUMENT SET PACKAGE	
WP_08	
DRAWING NUMBER	
3A1106	

OFFICE OF CONSTRUCTION AND FACILITIES MANAGEMENT	
Department of Veterans Affairs	



CONSTRUCTION DOCUMENTS I

F

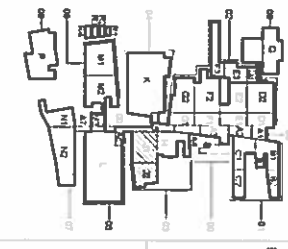



Scale: 1" = 45'

0' 45' 90'

1 BLDG 3 OVERALL SIXTH FLOOR PLAN

REFER TO THE FOLLOWING SKETCH FOR CHANGES
SK-8-4-NJ 3A1106

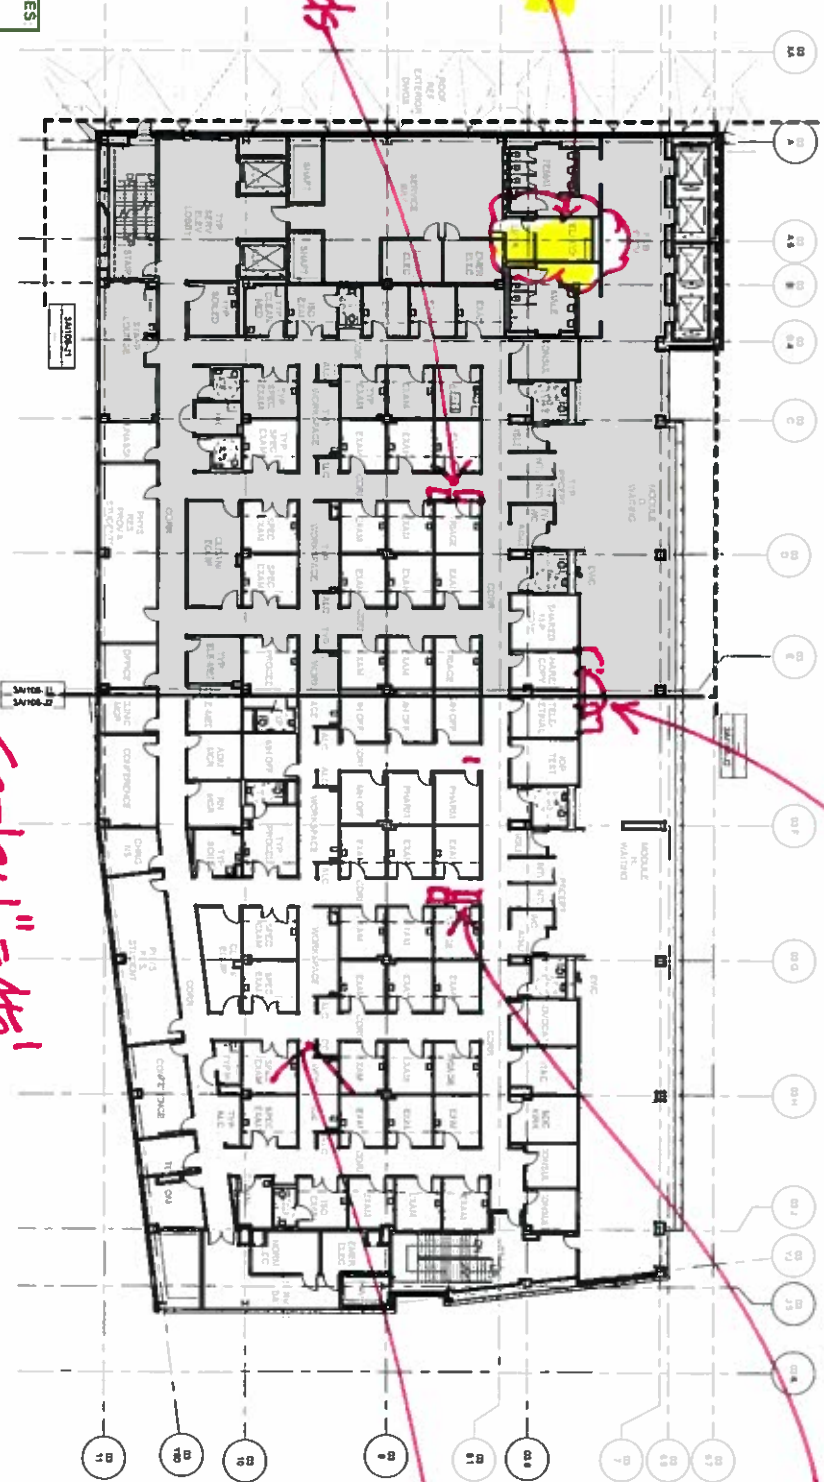

R-13538 Location of Control No nls


queuing monitor
+ 2 floor stand kiosks

2 display boards

Primary Care

2 display boards

closets

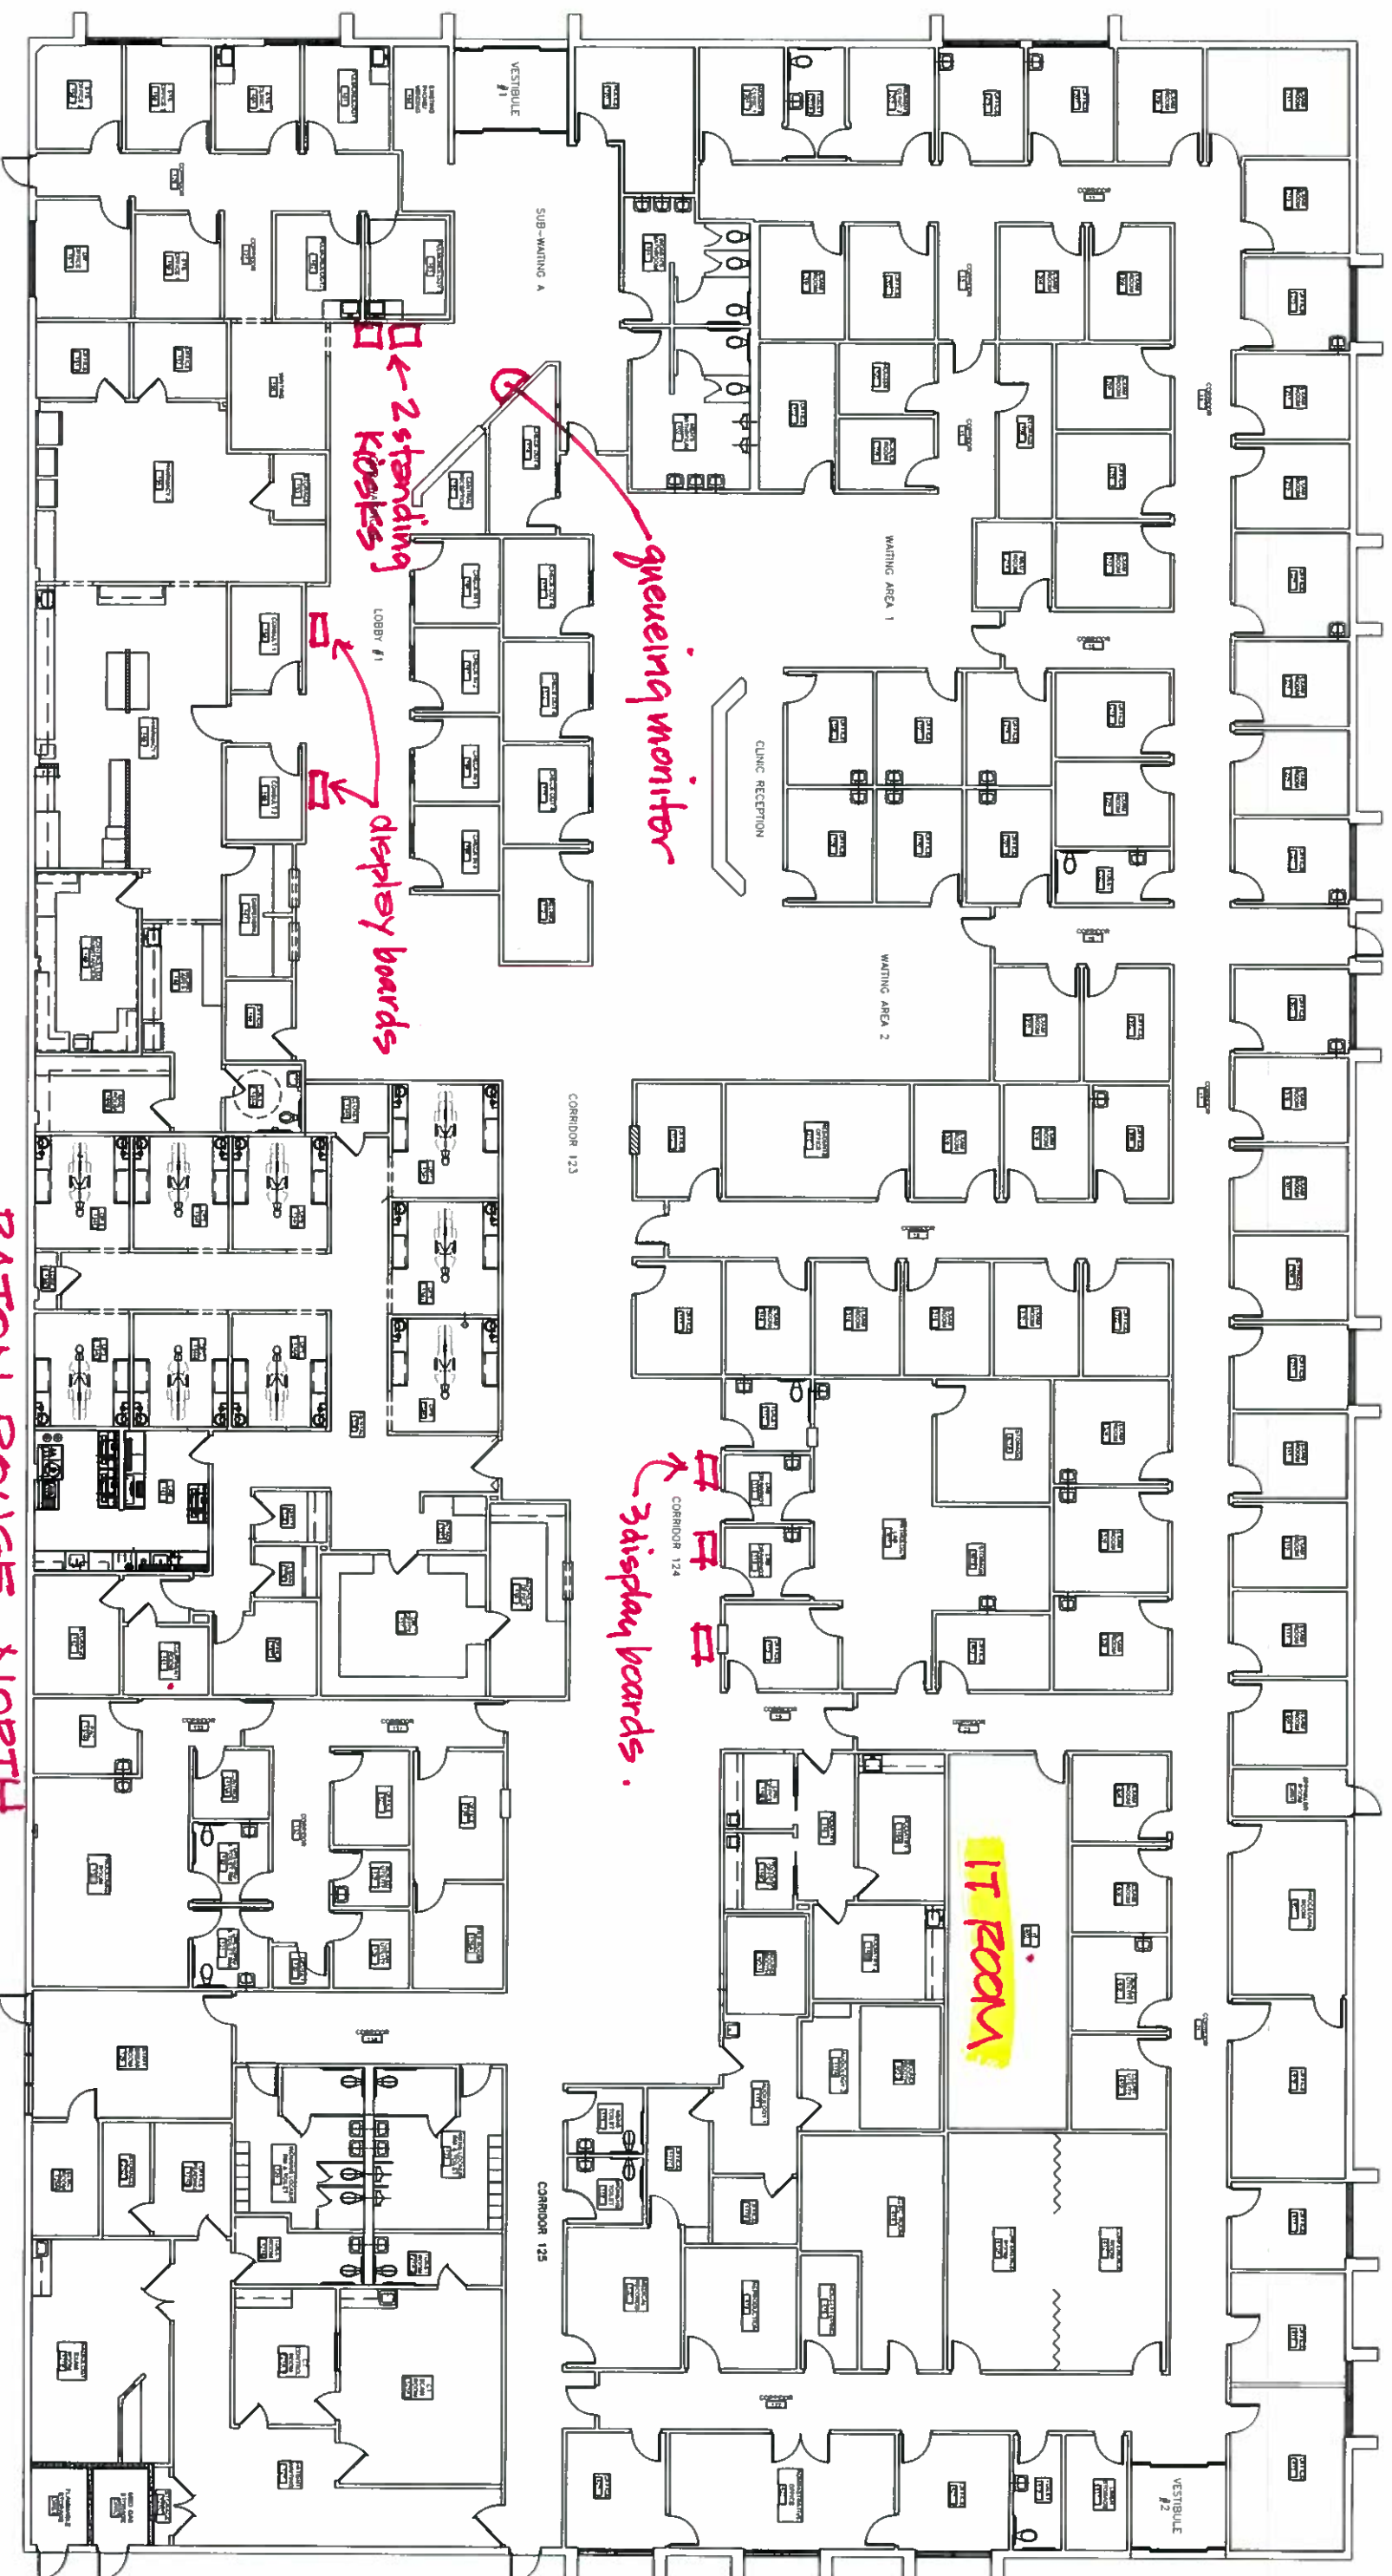

BATON ROUGE - NORTH

Scale: 1"=16'

0' 16' 32' 48'